



Mr. John Schueler, R.A.
Senior Building Plans Examiner
Buildings and Inspections
City of Cincinnati
Two Centennial Plaza, 805 Central Ave, Suite 500
Cincinnati, OH 45202

RE: Permit 2022P03573 R _ Engineering Change EC#1

Dear John,

We've uploaded Revisions for Engineering Change 01. These have the Delta of #3. We have addressed these below. We also are submitting changes to Two apartments with this revision. The Apartment count stays the same.

Review Comments


1. Clarify Kitchen Hood: See Drawing A203, General Note M stating ALL kitchen hoods are recirculating.
2. Trash Chute: See Drawing A502. This eliminates the Trash Chute from the engineering change. The 2-hr rated shaft will remain.
3. Clarify Laundry Dryers: See Drawing A203, General Note N stating ALL Laundry Dryers are electric and ventless.
4. Additional Changes:
 - a. See Sheet A203: We removed Apartments A.1 & C and replaced these with Apartments G.1 & Q.
 - b. New Drawings added for enlarged apartment plans include: A316.1, A316.2, & A317.
 - c. The above changes affected drawings:
 - TS: Drawing Index
 - Removed A301.1
 - Removed A302
 - Added A316(1) Apartment G.1
 - Added A316(2) Apartment G.1
 - Added A317 Apartment Q
 - & LS-103: Updated 1/LS-103 for new apartment layouts.

Please let us know if there is anything else you need.


Sincerely,
The Model Group

A handwritten signature in blue ink, appearing to read 'Joseph A. Bodkin'.

Joseph A. Bodkin, RA
The Model Group

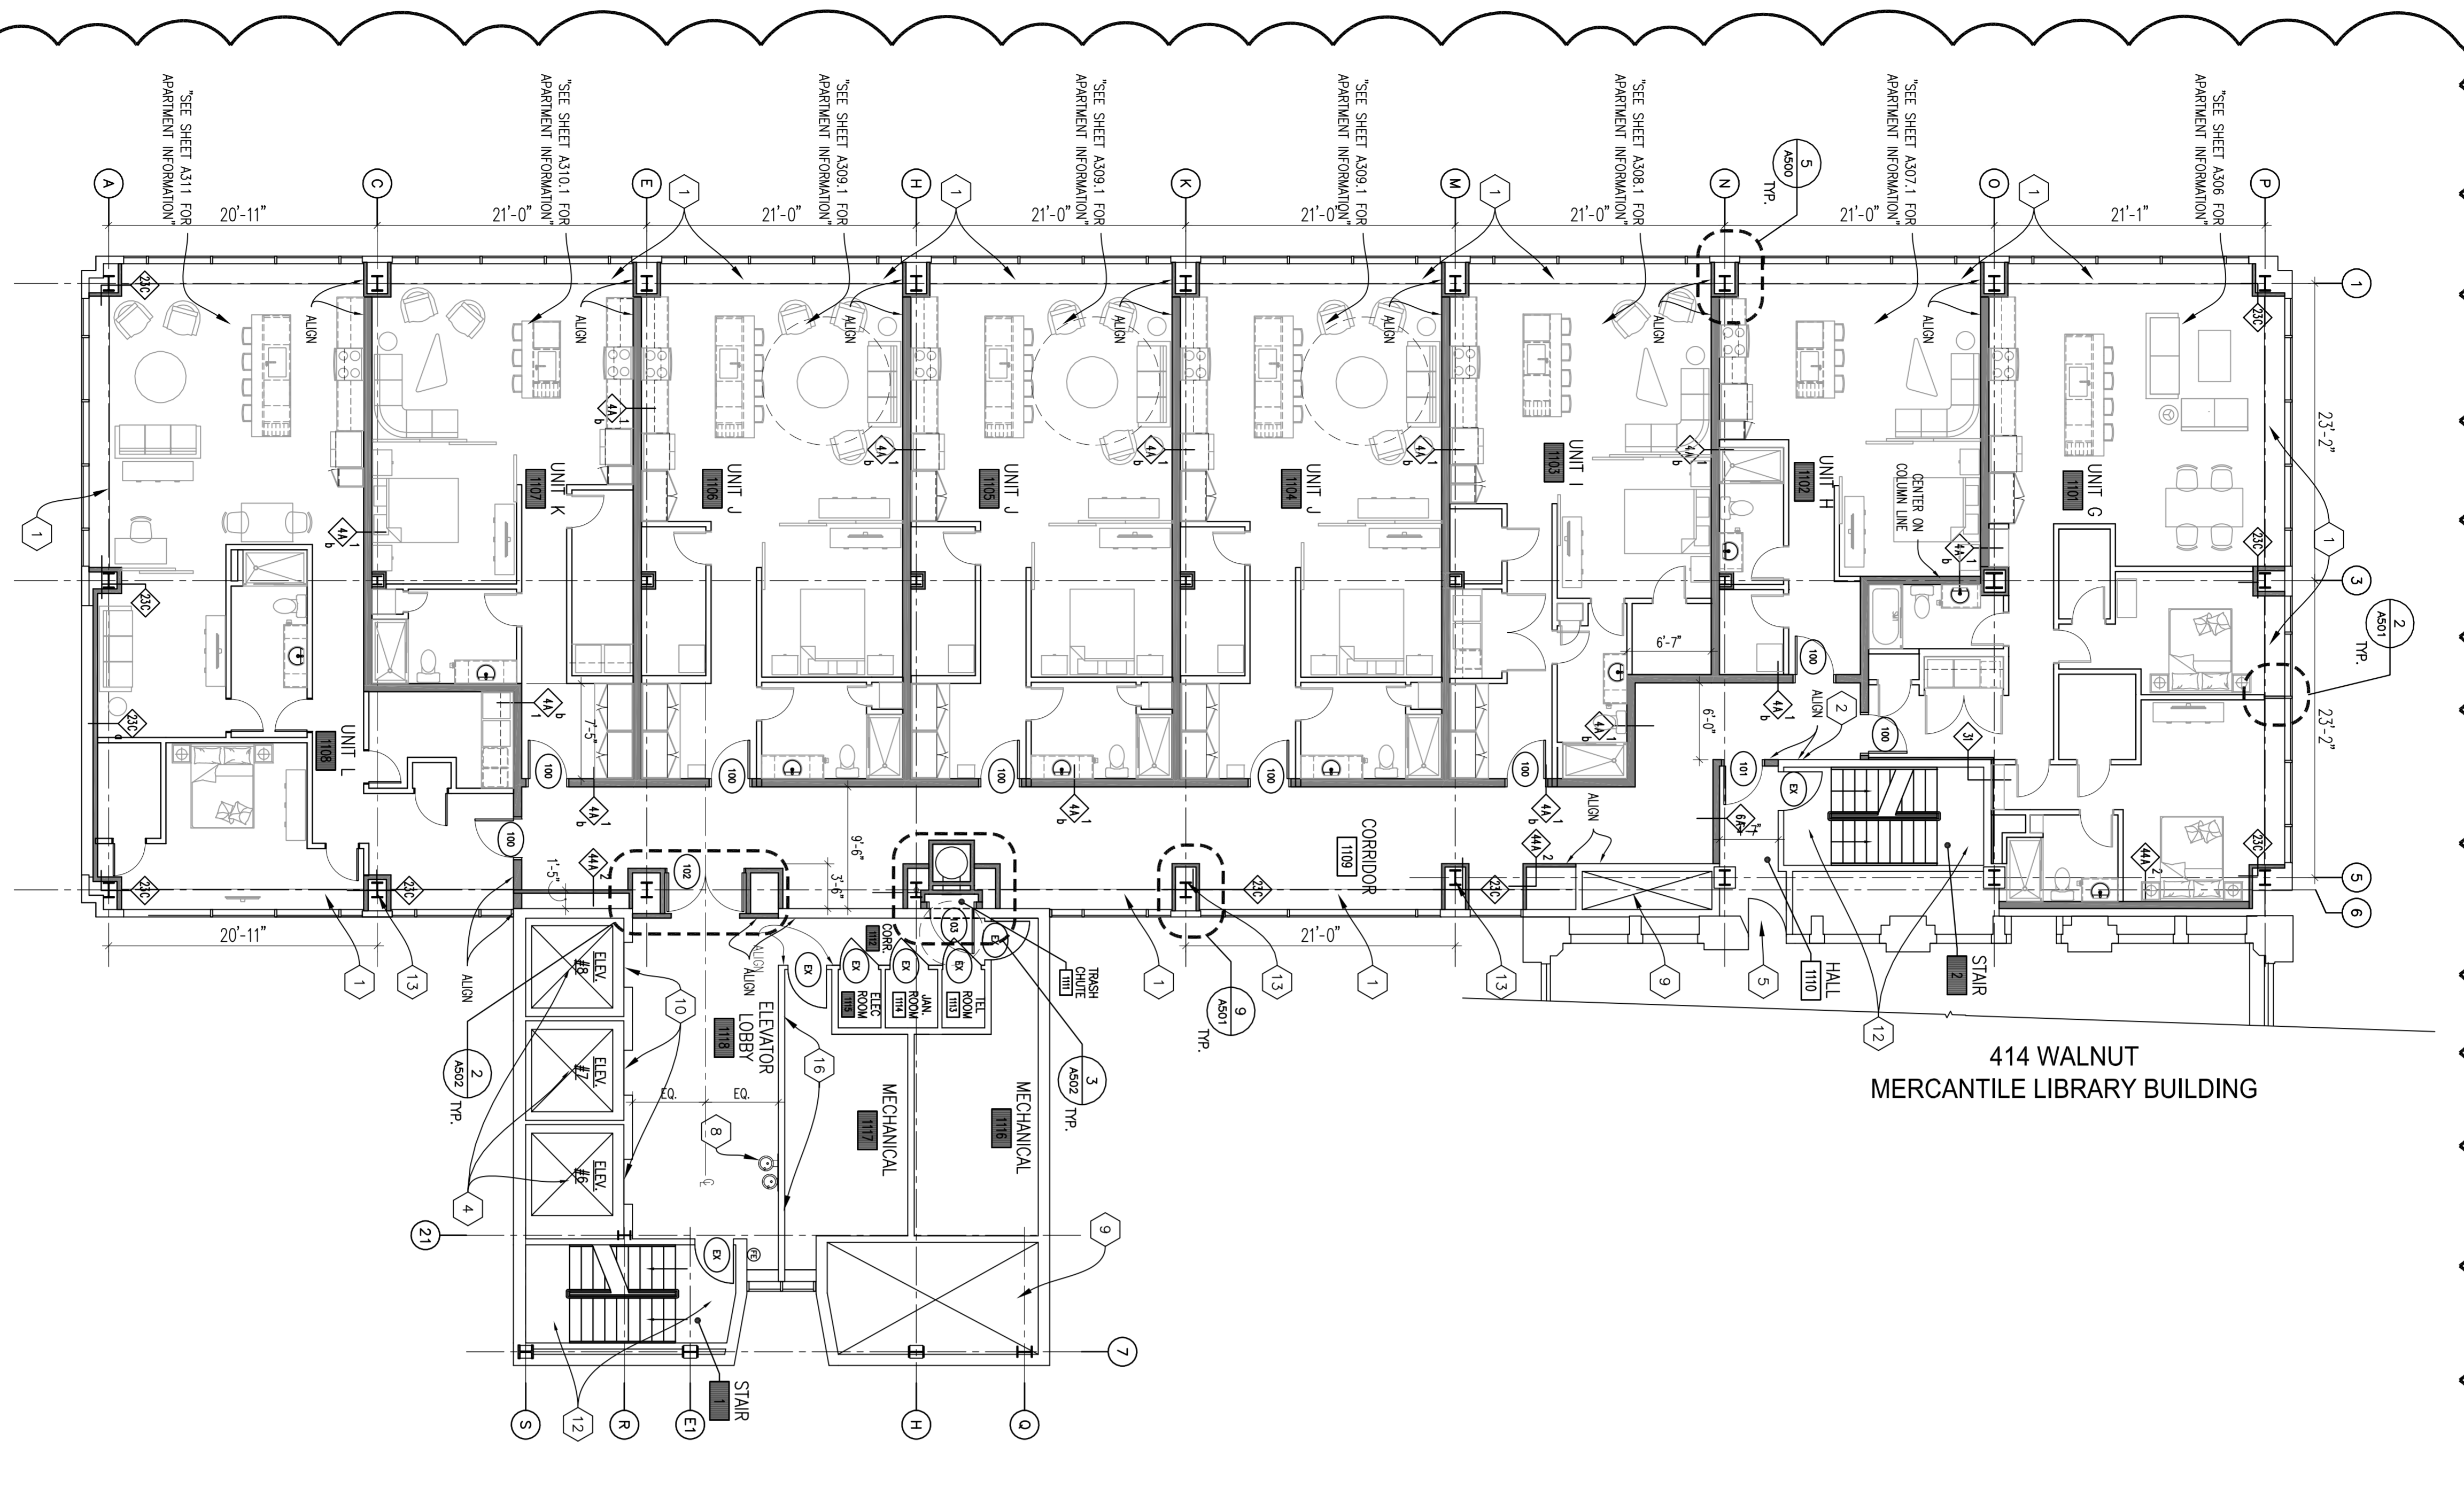

CONSTRUCTION
TYPICAL RESIDENTIAL FLOOR PLAN - FLOOR 11th
 SCALE: 1/8" = 1'-0"

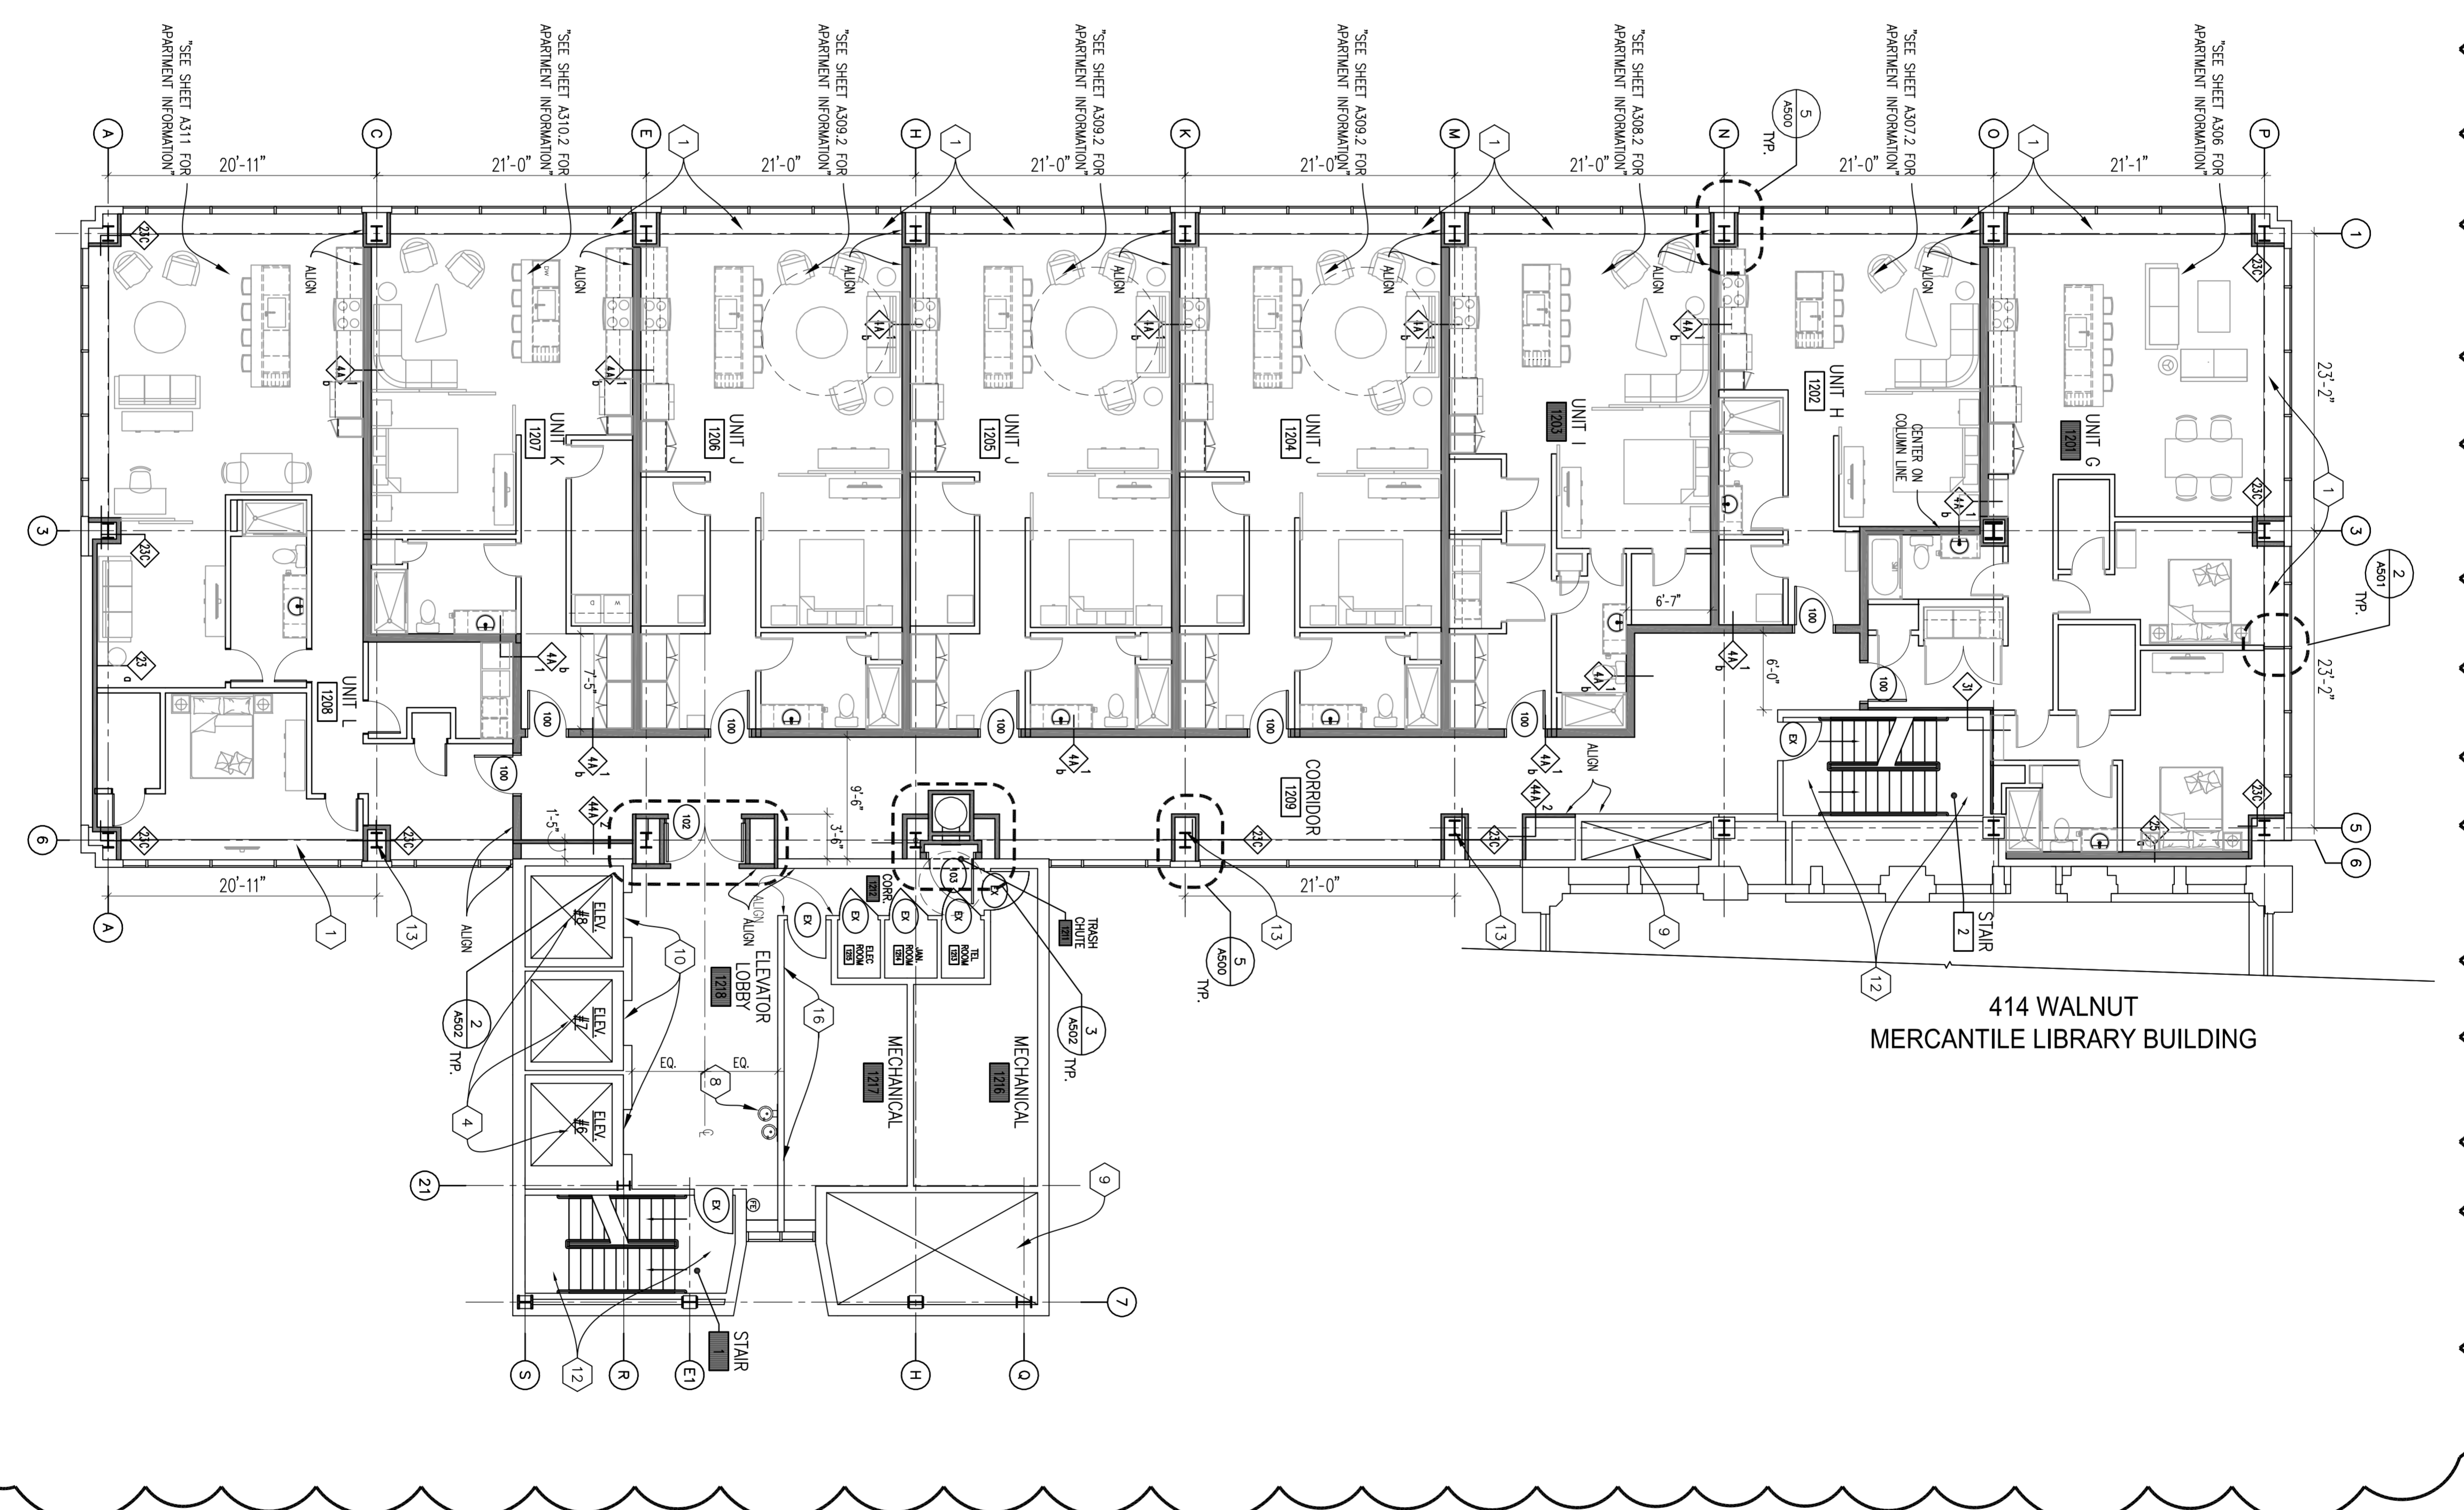

CONSTRUCTION
RESIDENTIAL FLOOR PLAN - FLOOR 12th
 SCALE: 1/8" = 1'-0"

GENERAL CONSTRUCTION NOTES:

- A. ALL WALLS ARE TYPE 3 U.I.O.
- B. ALL EXISTING METAL STUDS, CHANGERS AND HANGERS, METAL DOOR FRAMES ON FLOORS 3-13 ARE TO BE REPAIRED, CLEANED, REFINISHED, PRIME & PAINTED. INSTALL ALL NEW HARDWARE EXCEPT DOORS.
- C. ALL PAINTED SURFACES ARE TO BE CLEANED, PATCHED, PREPARED, PRIME & PAINTED. TYPE OF ALL.
- D. ALL PAINTED SURFACES ARE TO BE CLEANED, PATCHED, PREPARED, PRIME & PAINTED. U.I.O.
- E. ALL EXISTING CONCRETE FLOORS ARE TO BE CLEANED OF ALL OIL, GREASE, AND ANY OTHER CONTAMINANTS. REPAIR ANY DAMAGE DONE TO THE WALLS THAT REFLECT ITS FINISH. REPAIRING IS TO BE REPAIRED/REPLACED TO AN EQUIVALENT.
- F. ALL WINDOWS AND FRAMES ARE TO REMAIN. PROTECT DURING CONSTRUCTION. HANGERS ARE FOR REFERENCE ONLY; THEY HAVE NOT BEEN FIELD VERIFIED.

CONSTRUCTION PLAN NOTES:

1. ALL EXISTING METAL HANGERS TO REMAIN. PROTECT DURING CONSTRUCTION. ALL ARE TO BE REPAIRED, PRIME & REFINISHED.
2. NEW WALL FINISH TO MATCH ADJACENT FINISHES. U.I.O.
3. NEW RATED RECESSED FIRE EXTINGUISHER CABINET. TYPE OF ALL.
4. PROVIDE & INSTALL NEW ELEVATOR FINISHES.
5. EXISTING RATED DOOR TO ADJACENT BUILDING TO REMAIN. THIS DOOR IS TO BE REPAIRED, CLEANED AT ALL TIMES.
6. MECHANICAL ROOM ROOF. PROVIDE NEW ROOF.
7. MECHANICAL ROOM ROOF. PROVIDE NEW ROOF.
8. MECHANICAL ROOM ROOF. PROVIDE NEW ROOF.
9. MECHANICAL ROOM ROOF. PROVIDE NEW ROOF.
10. PROTECT ELEVATOR CASES, FINISHES & DOORS DURING CONSTRUCTION.
11. ALL BATHROOM FINISHES ARE TO REMAIN. PROTECT DURING CONSTRUCTION. FLOOR TYPICAL OF ALL U.I.O.
12. GYP. BR. WRAP SEE DETAIL.
13. REMOVE AND REPLACE ROOF DRAIN COVERS.
14. REMOVE AND REPLACE ROOF DRAIN COVERS.
15. REMOVE AND REPLACE ROOF DRAIN COVERS.
16. NEW NON-WALLED GYP. BR. WALLS TO MATCH ADJACENT FINISH.
17. REMOVE EXISTING DOOR.
18. EXISTING ROOF WHICH TO REMAIN.
19. REMOVE EXISTING HANG CABINET THIS LOCATION ONLY.
20. REMOVE EXISTING HANG CABINET THIS LOCATION ONLY.

A204	Project		
	Formica Building	No. Revisions	Date
	115 E 5th Street	ENG CHG #1	11.14.2022
	Cincinnati, Ohio 45202		
Sheet Title			
TYPICAL RESIDENTIAL FLOOR PLAN			
Project No. 2022_259 Issue Date			
Scale: As Noted Drawn Checked			





Formica Building

Office/Apartments

Auditor Address: 115 E. 5th Street, Actual Address: 120 E. 4th Street
 Cincinnati OH 45202

modelgroup
 DEVELOPMENT • CONSTRUCTION • MANAGEMENT

1826 Race Street
 Cincinnati, Ohio 45202
 513.559.0048

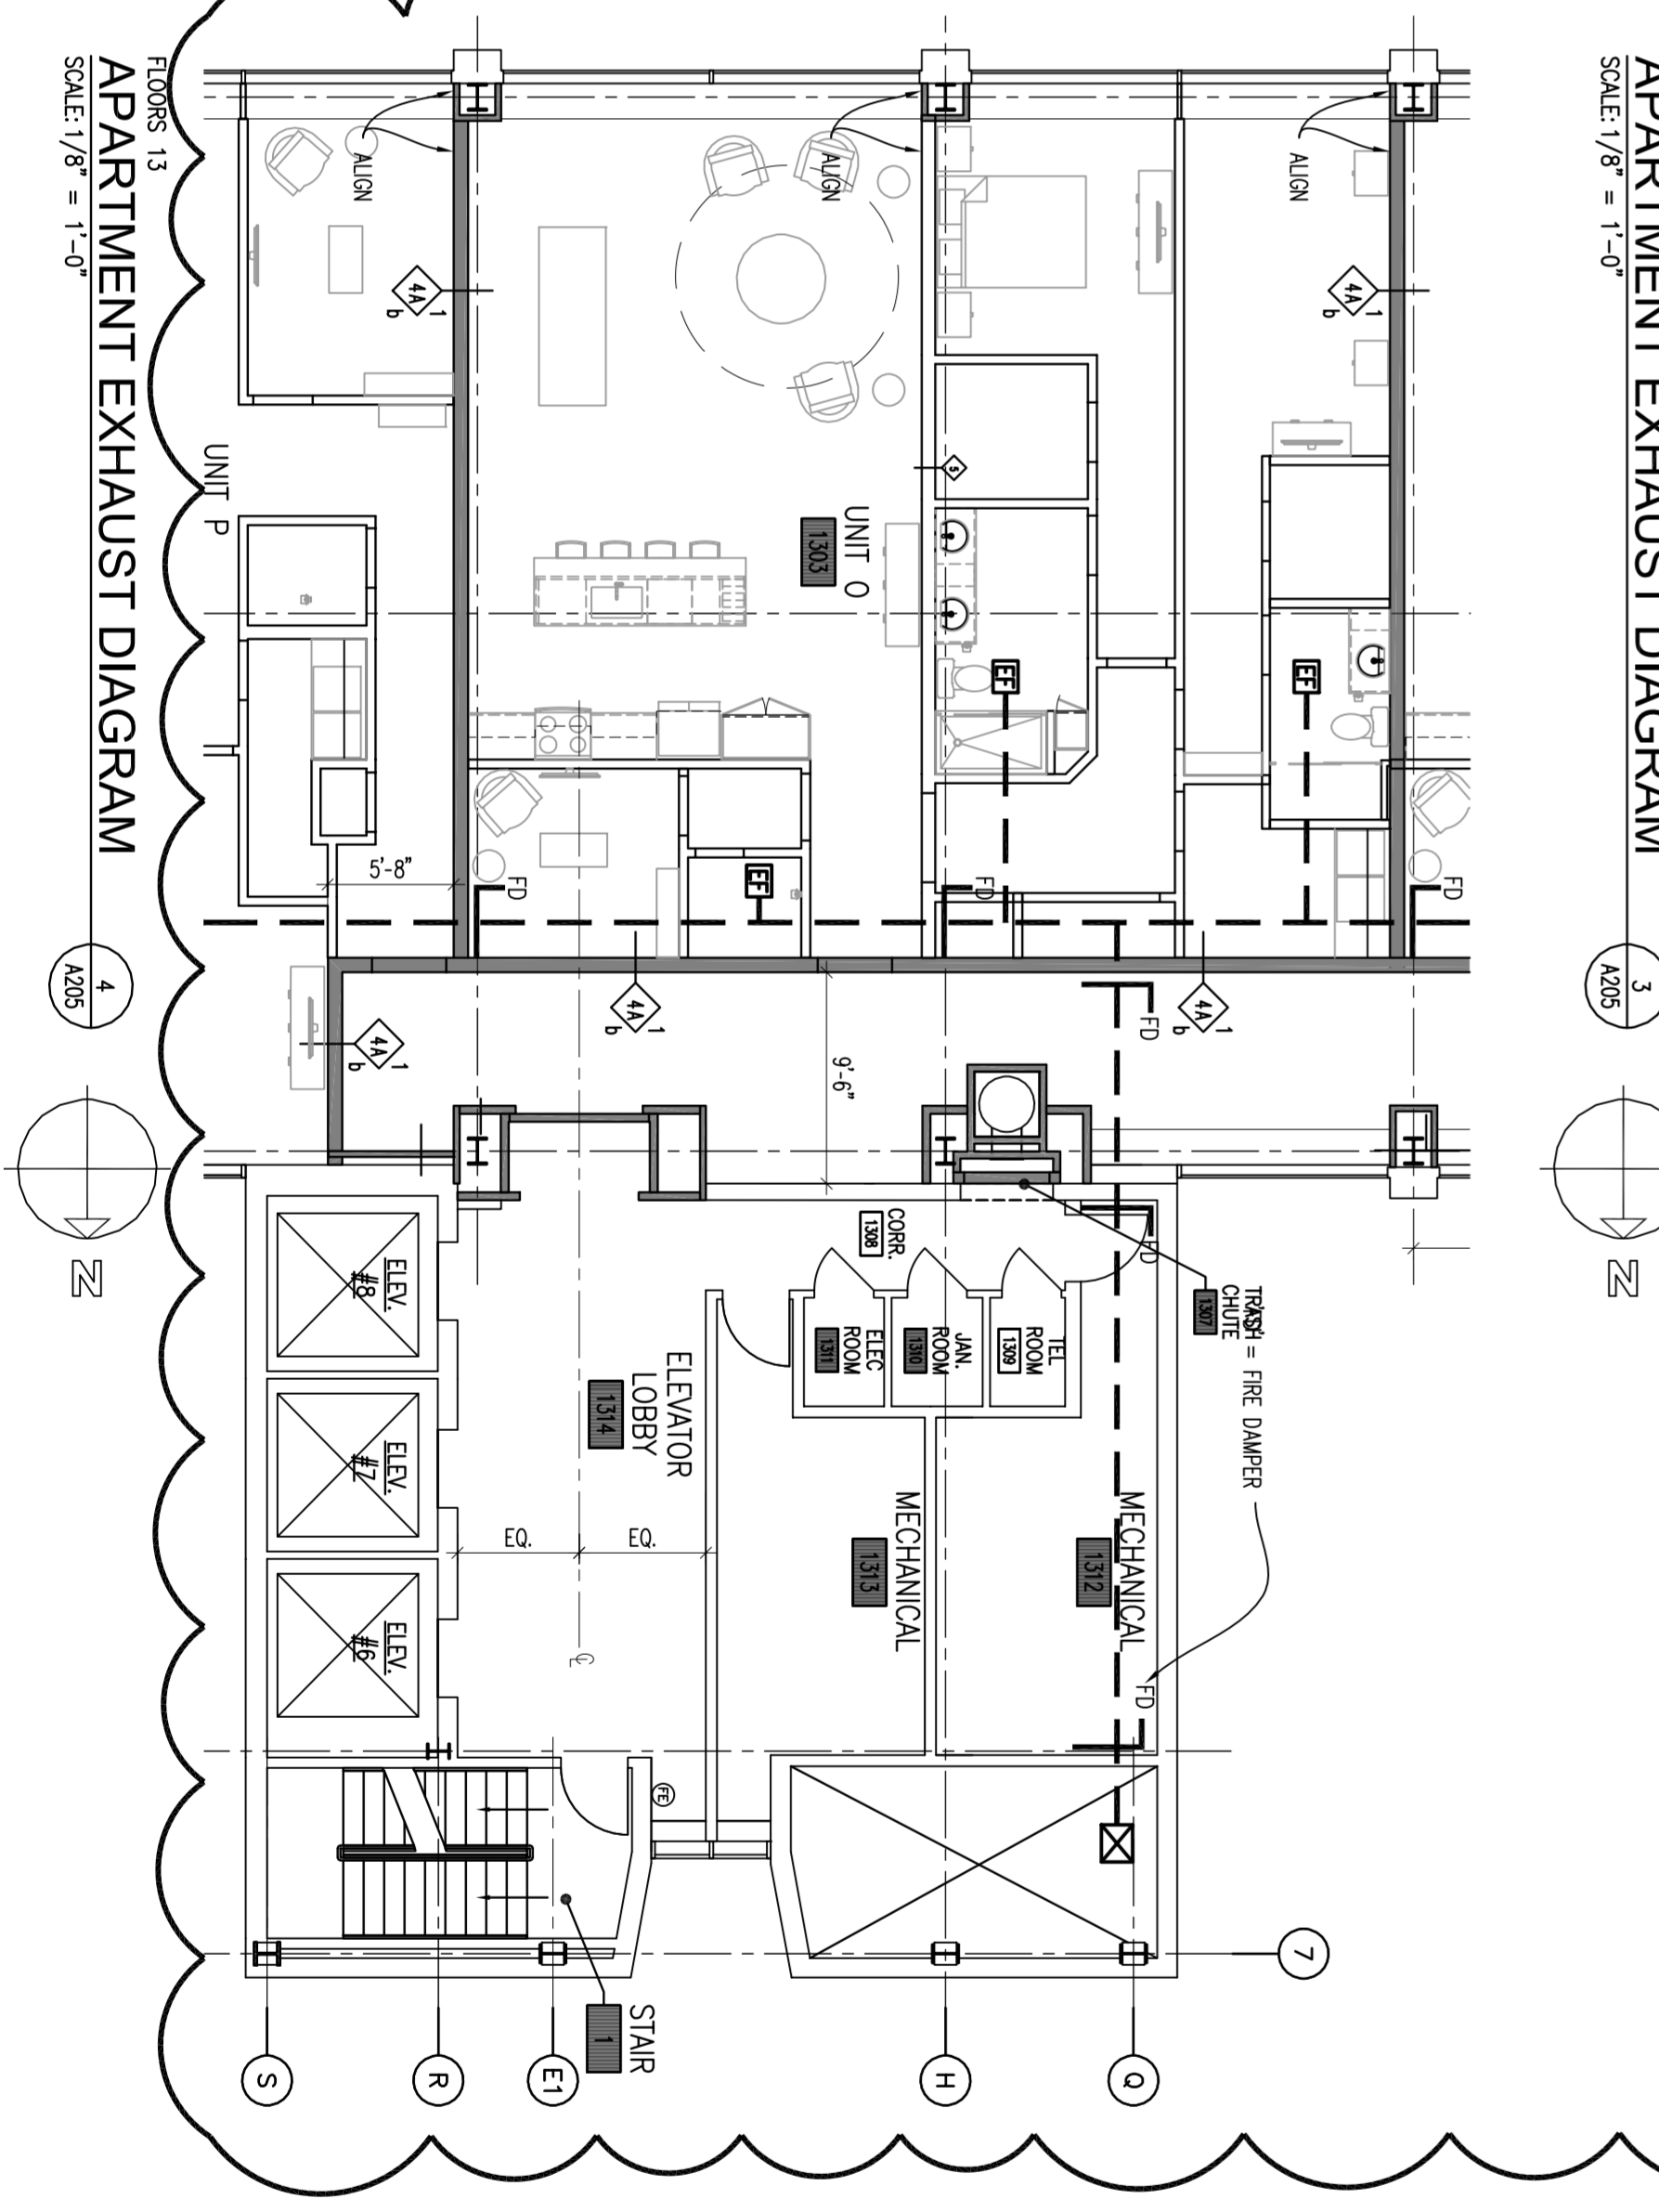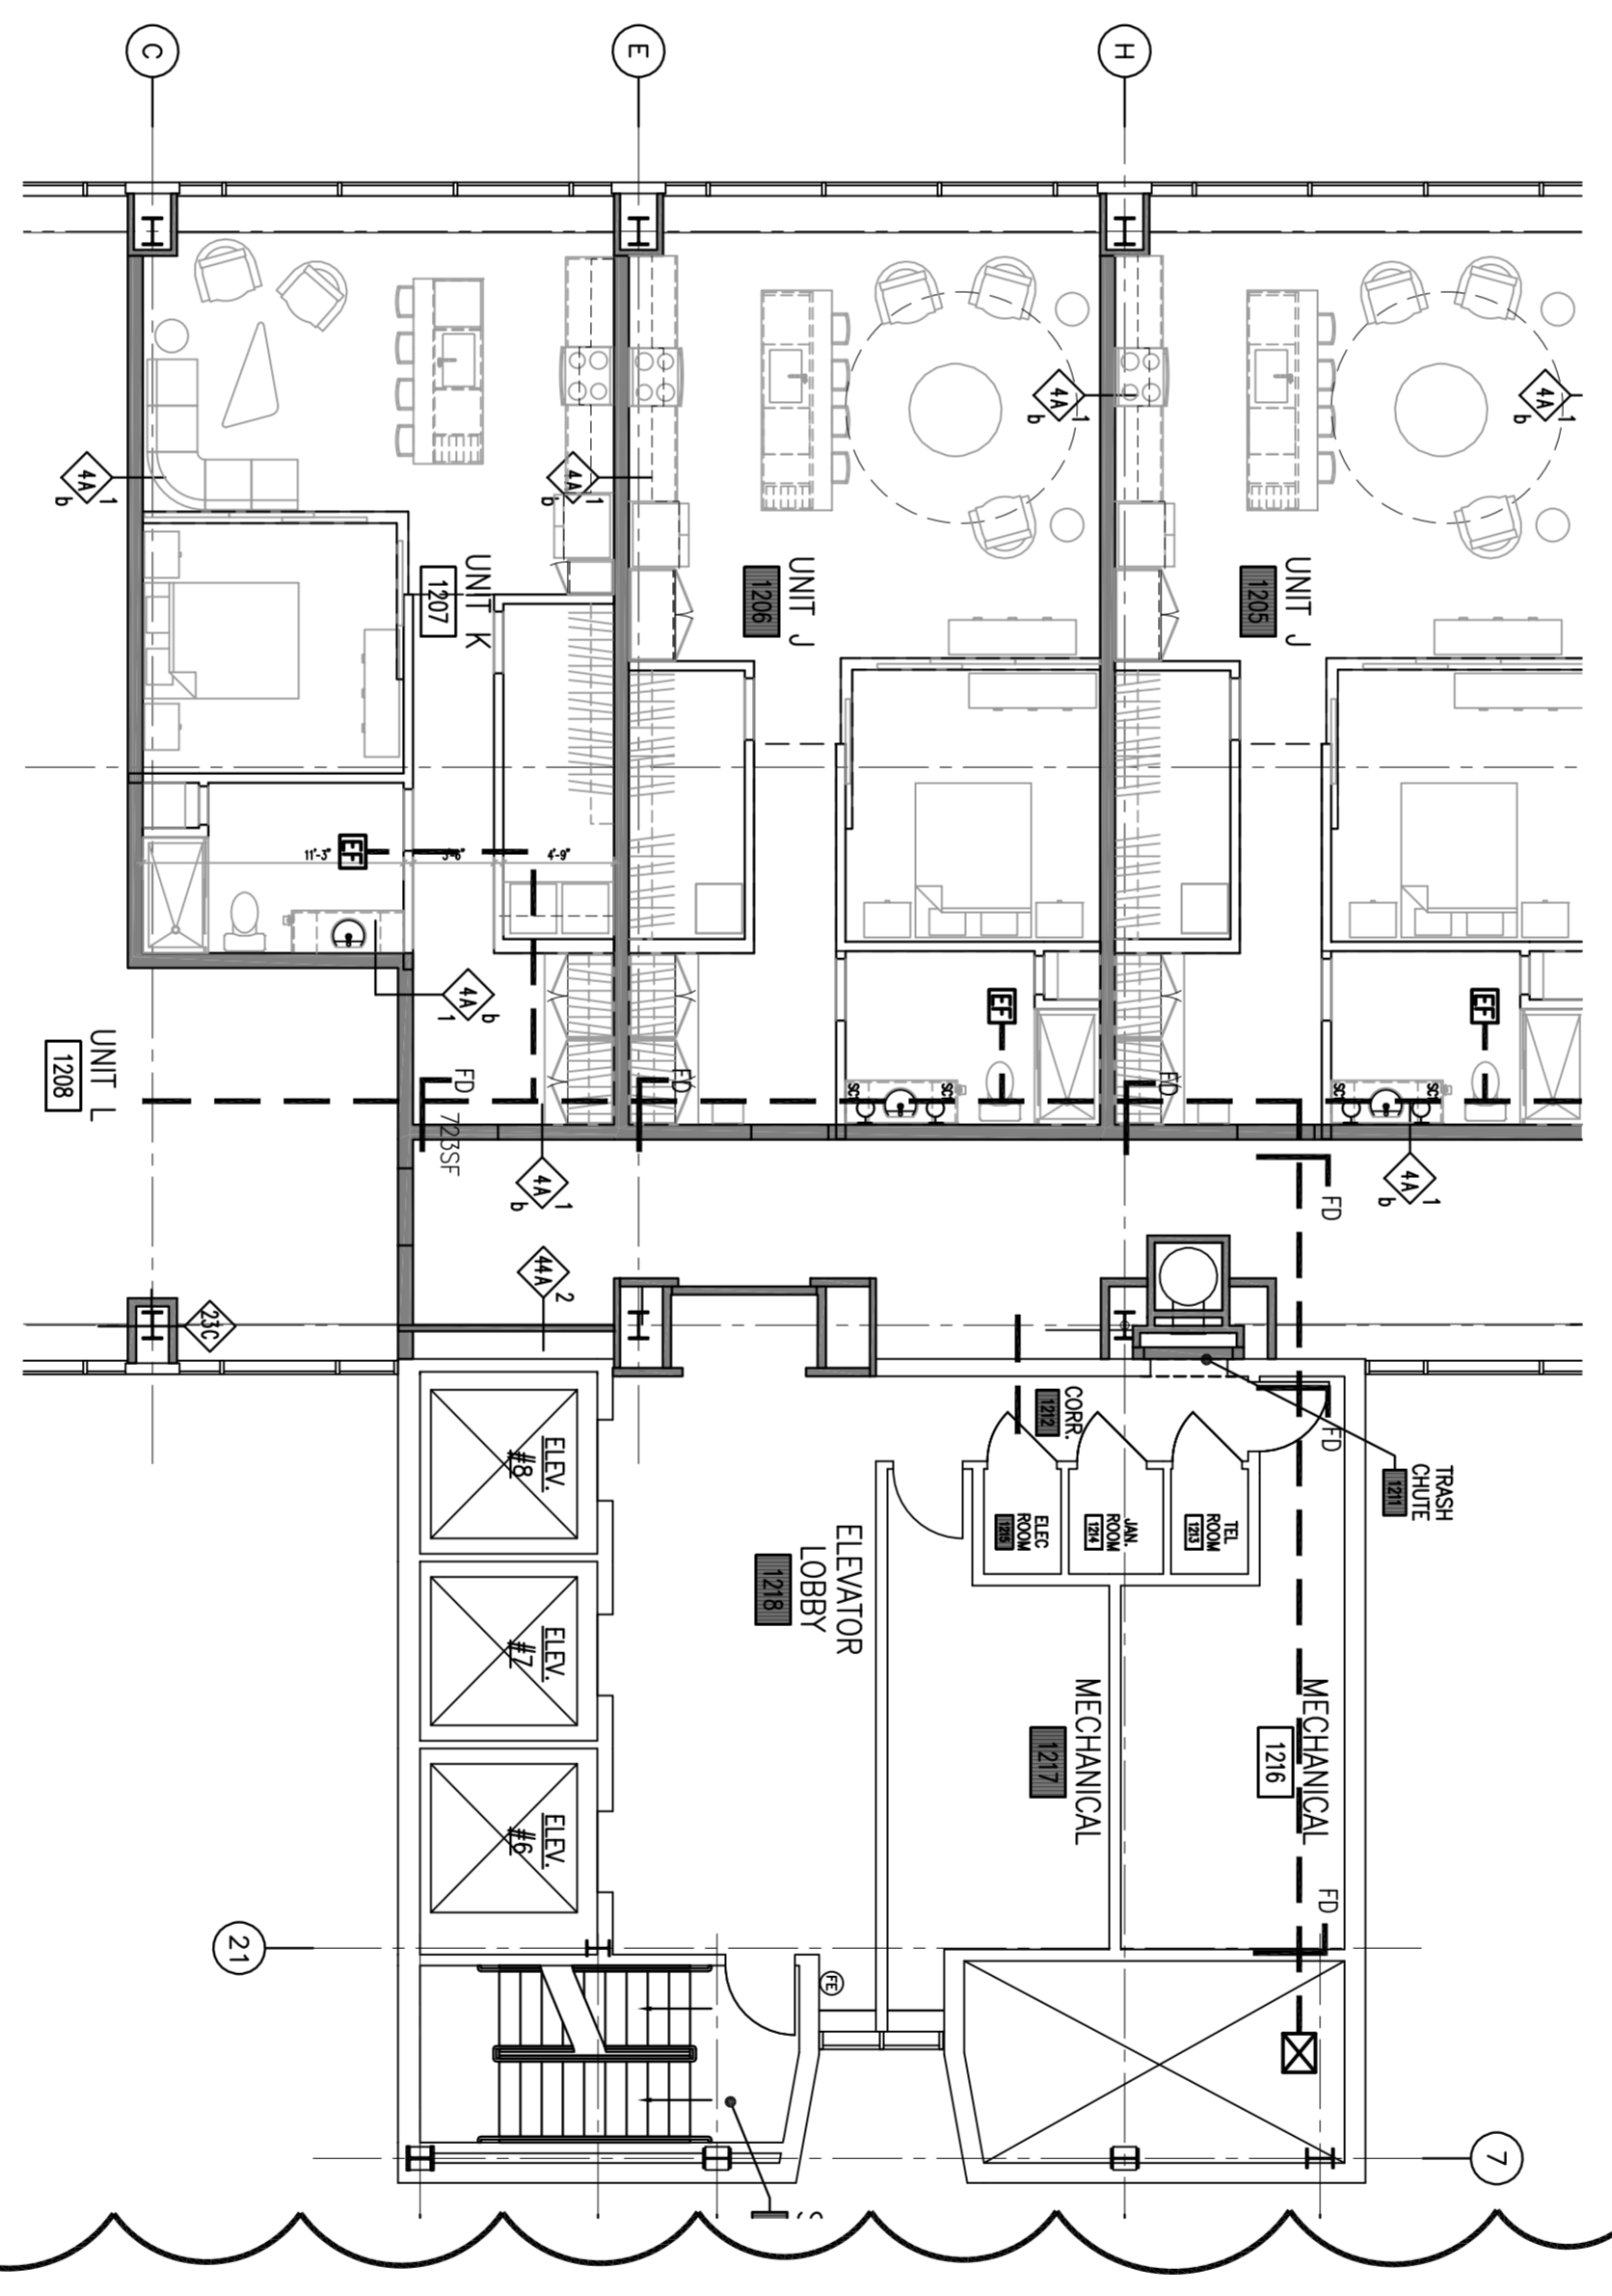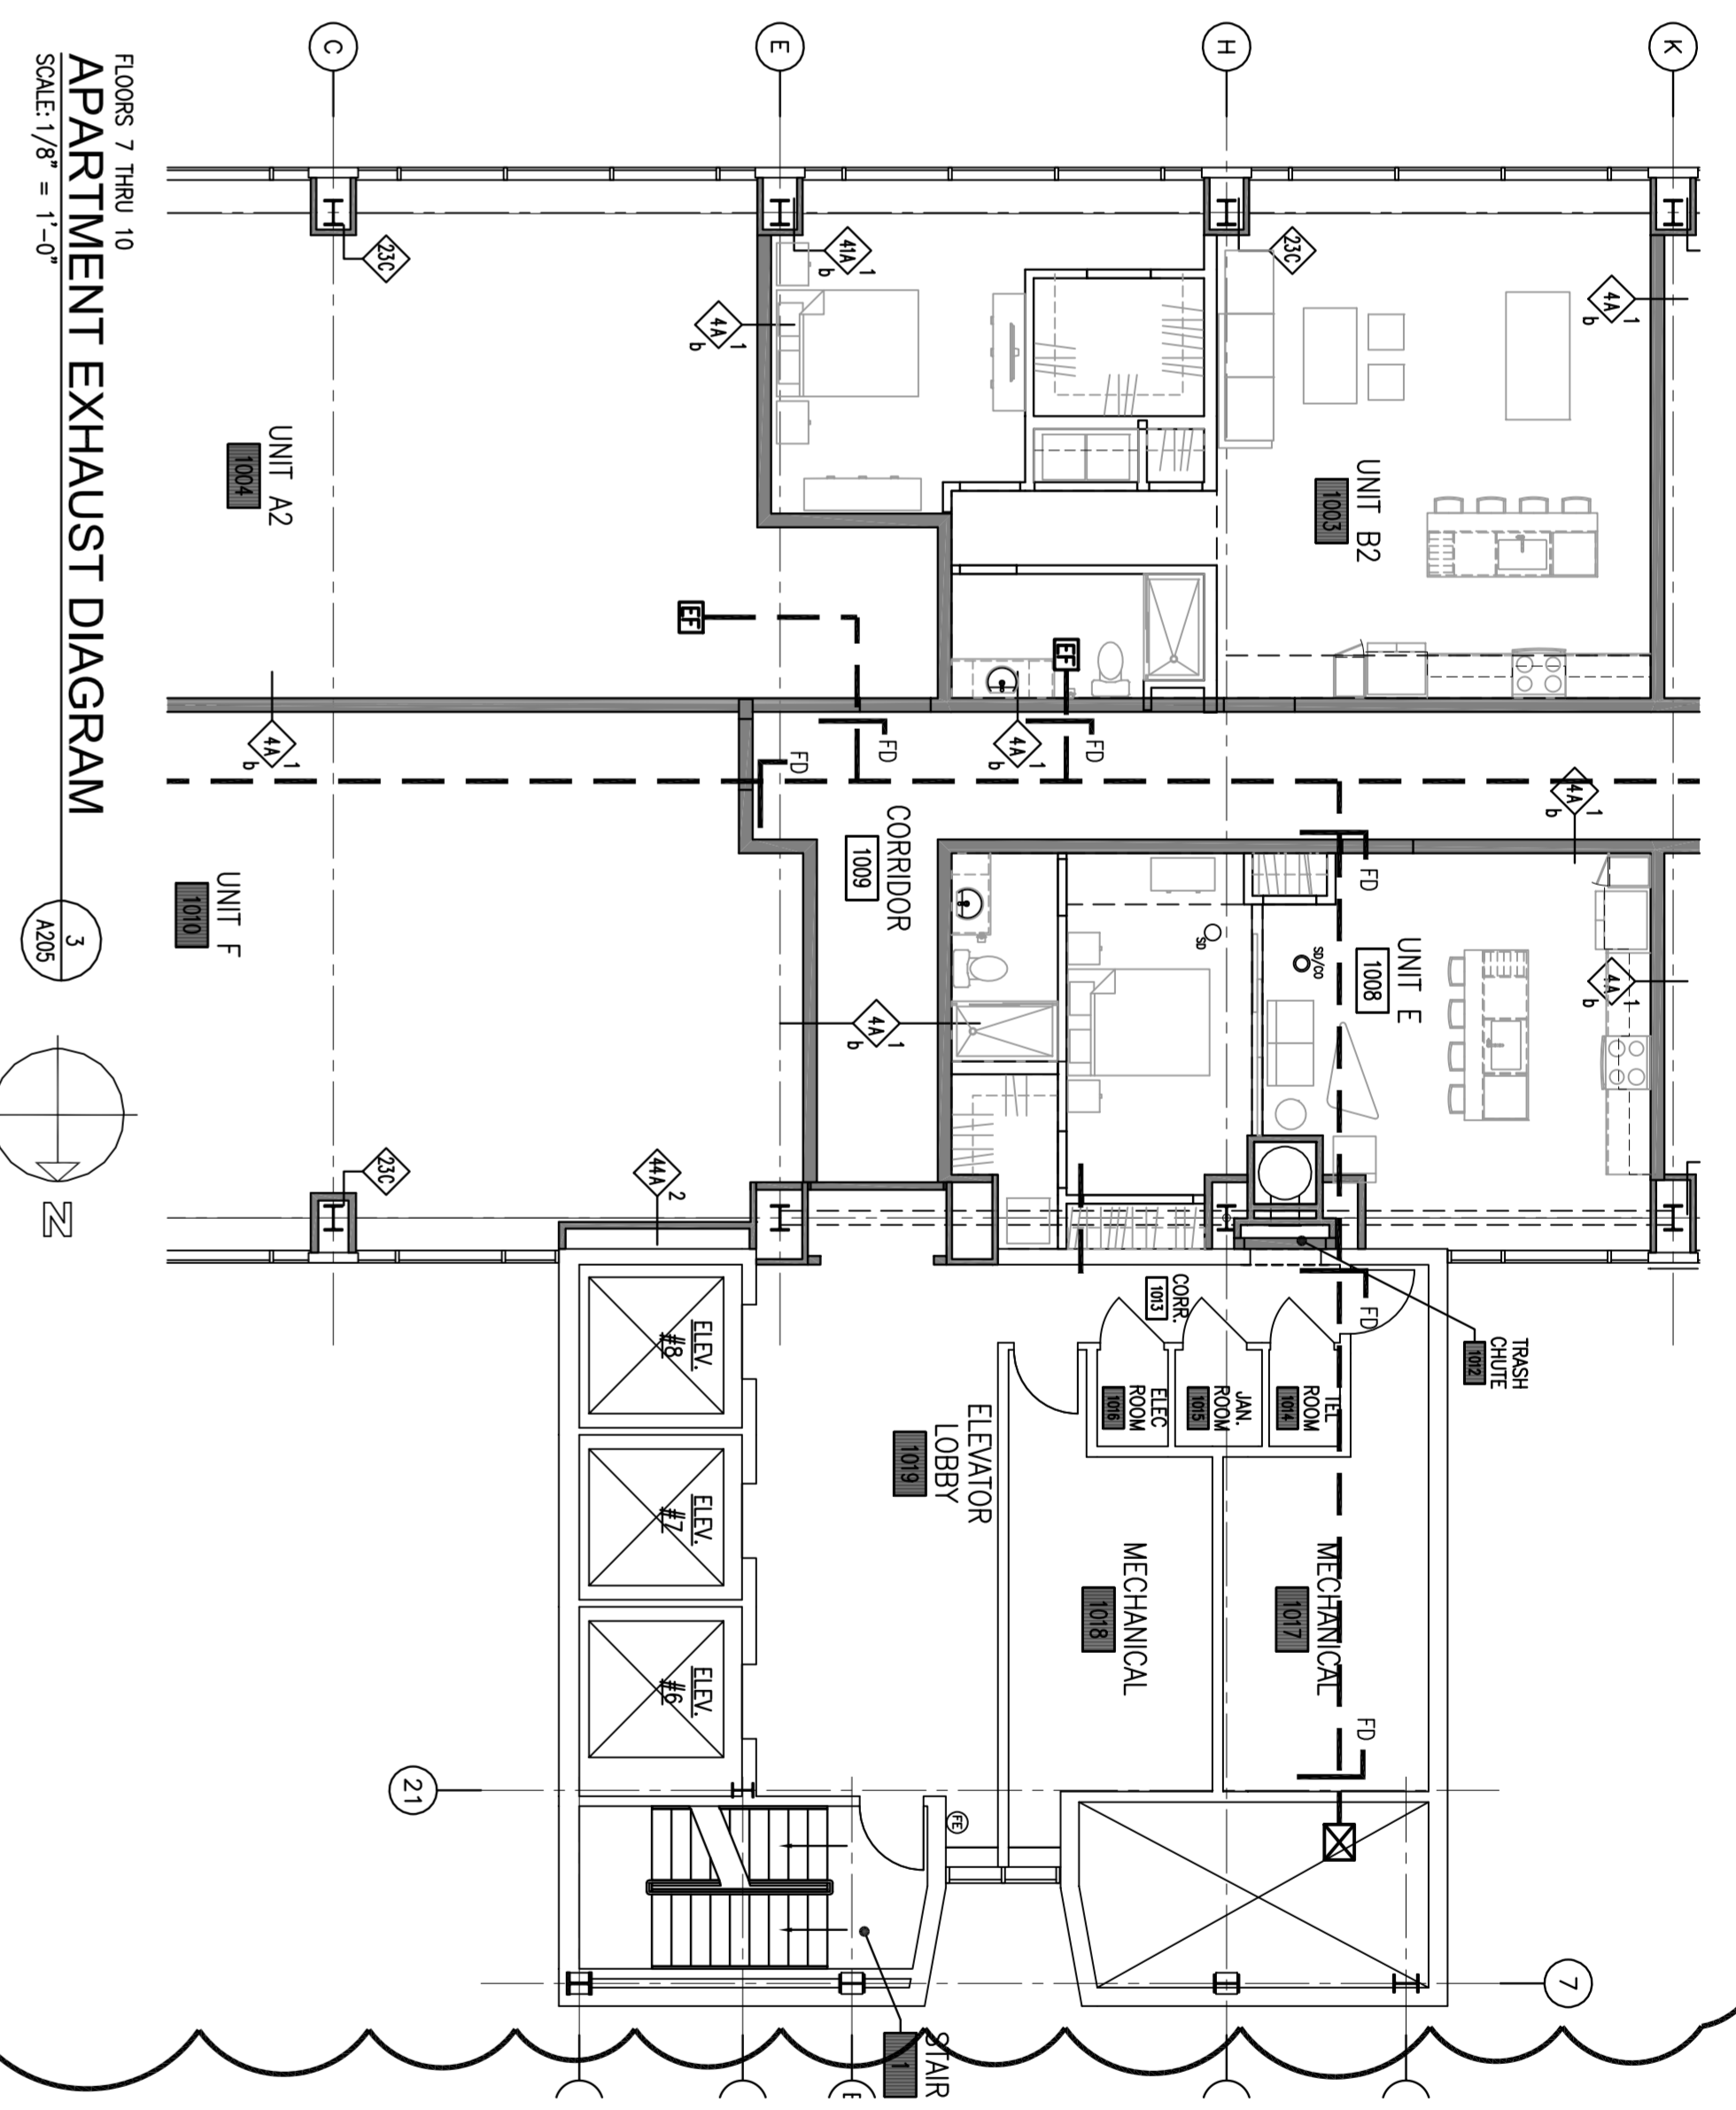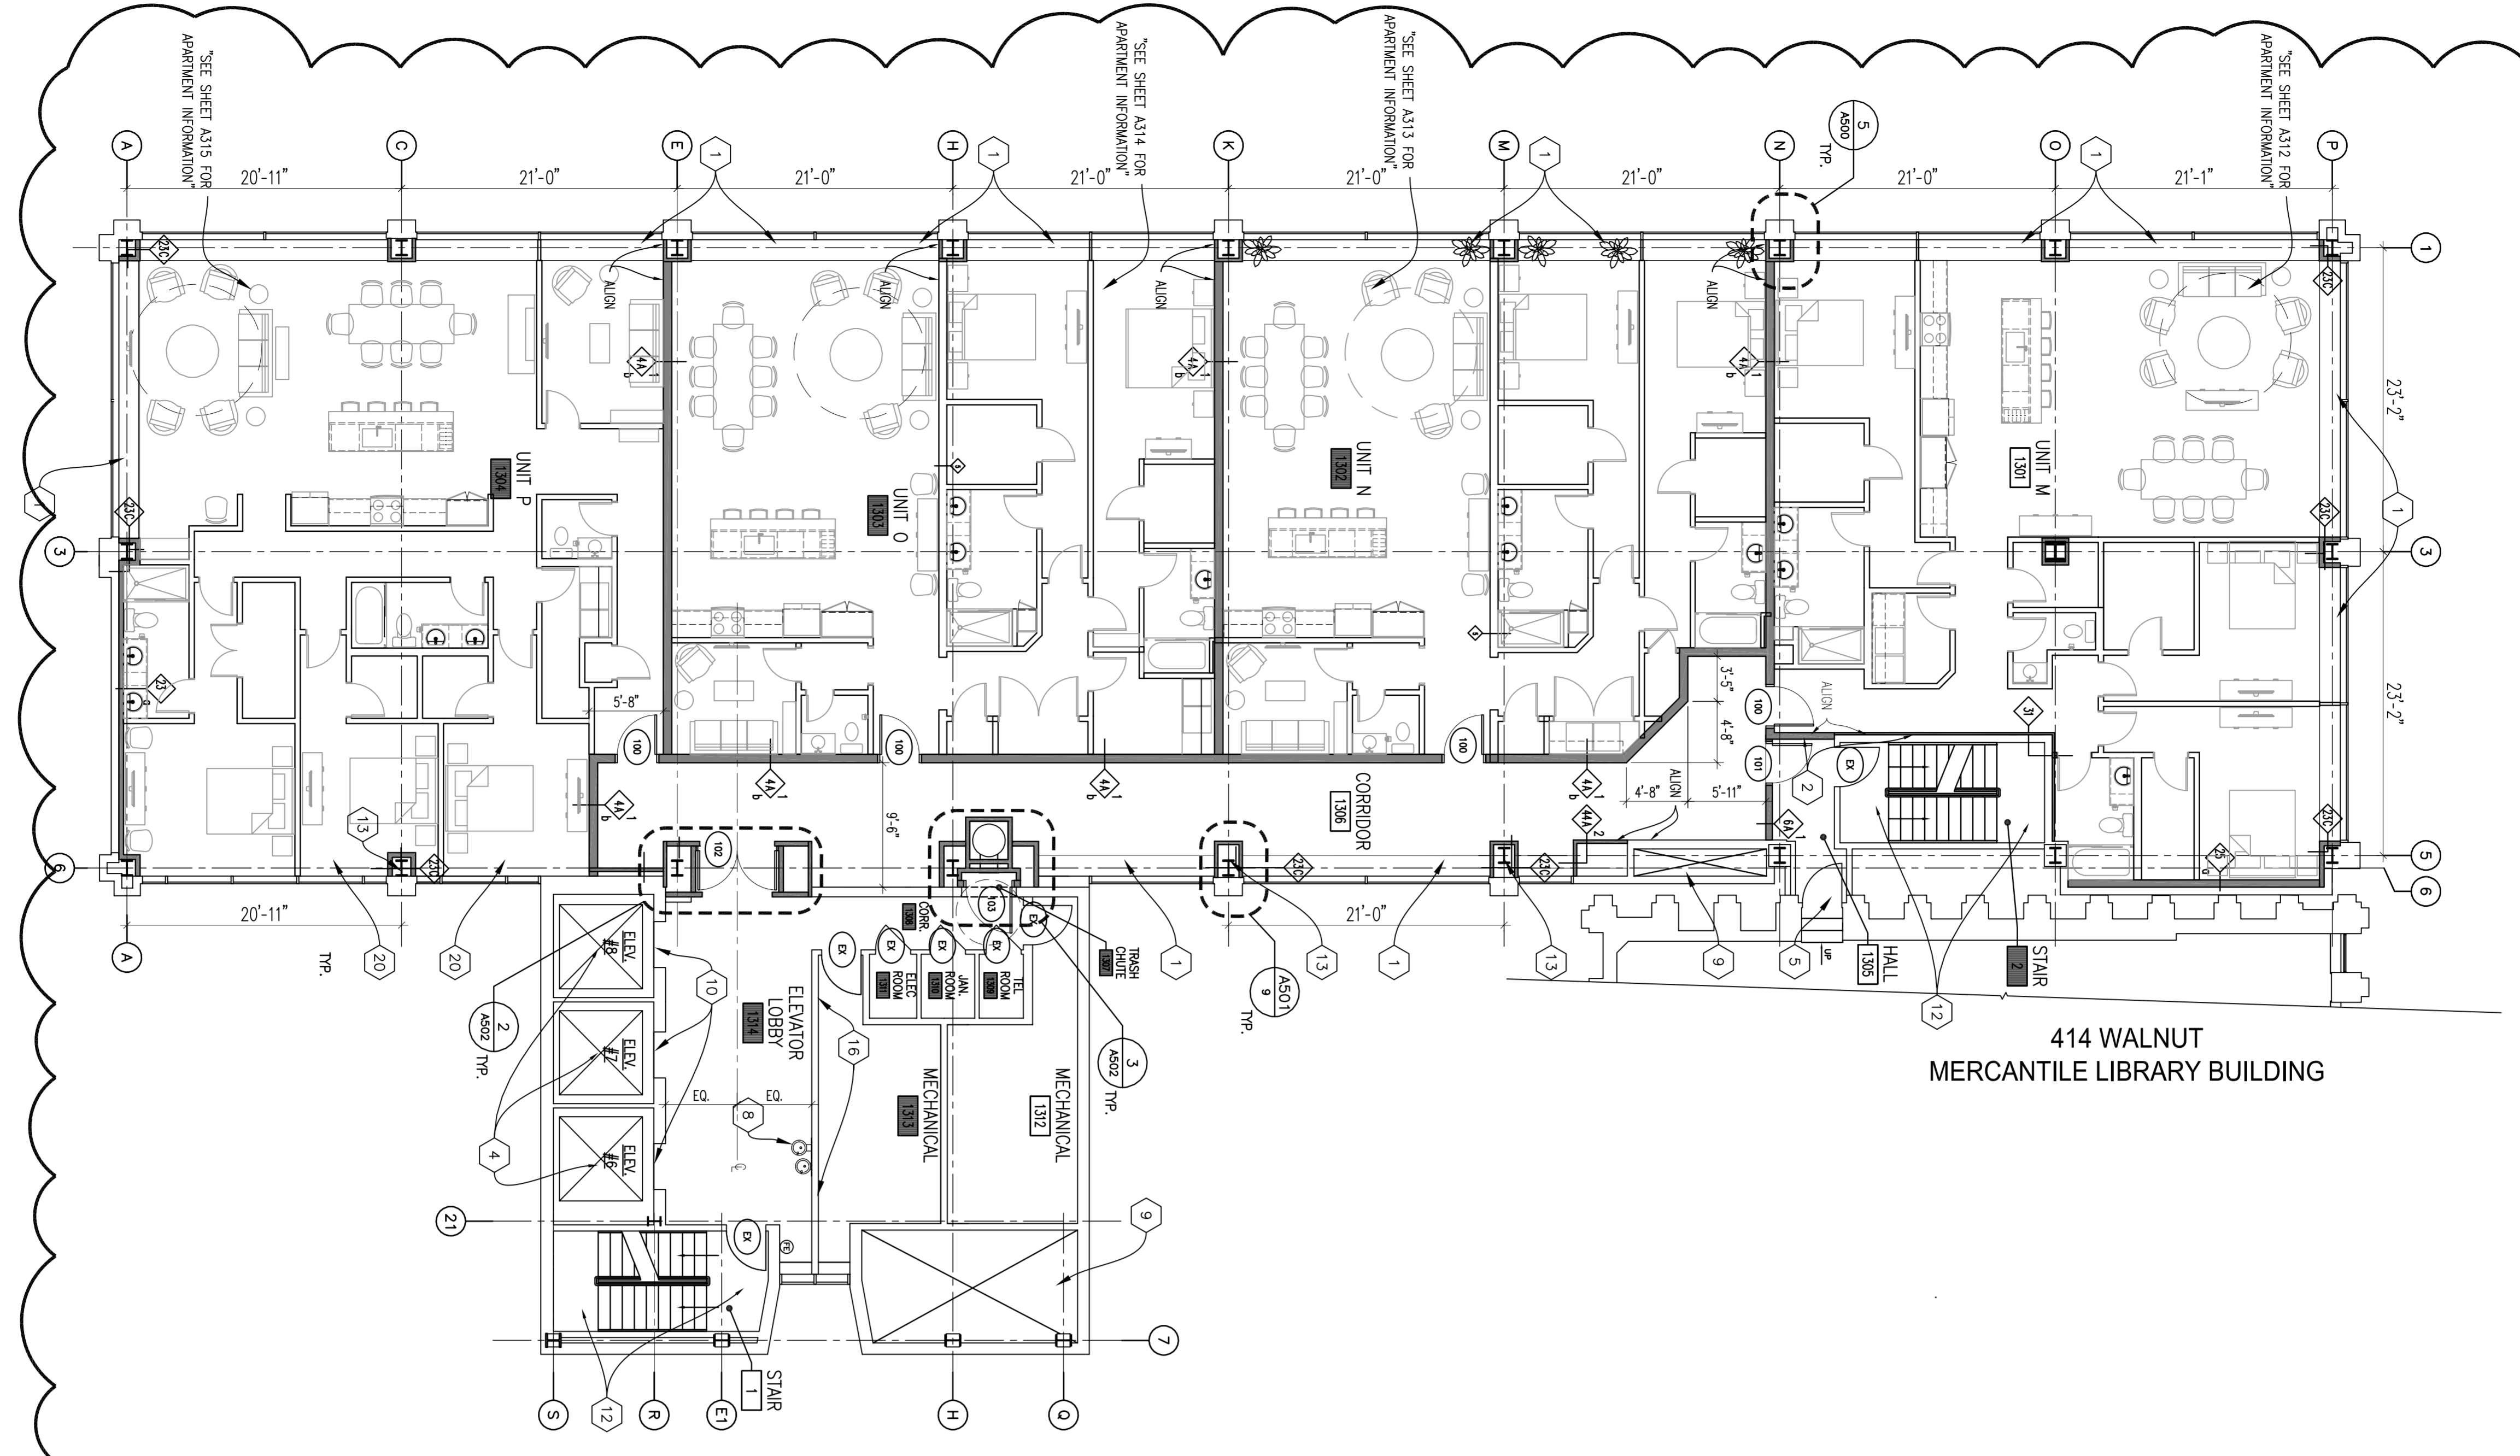

- GENERAL CONSTRUCTION NOTES:**
- A. ALL WALLS ARE TYPE 3 U.I.O.
 - B. ALL EXISTING METAL STUDS, CHANGERS AND HANGERS, METAL DOOR FRAMES ON FLOORS 3-13 ARE TO BE REPAIRED, CLEANED, REPAINTED, PRIMED & PAINTED. INSTALL ALL NEW HARDWARE EXCEPT BATH & KITCHEN CUPB. ALL PAINTED SURFACES ARE TO BE REPAIRED, CLEANED, REPAIRED & PAINTED. TYPE OF ALL.
 - C. ALL PAINTED SURFACES ARE TO BE REPAIRED, CLEANED, REPAIRED, PRIMED & PAINTED. U.I.O.
 - D. ALL FLOOR BY OWNER.
 - E. ALL EXPOSED CONCRETE FLOORS ARE TO BE CLEANED OF ALL OIL, GREASE, AND OTHER CONTAMINANTS. REPAIR ALL CRACKS, REPAIR ANY DAMAGE DONE TO THE WALLS THAT AFFECT IT'S FINISH. REPAIRING IS TO BE REPAIRED/REPLACED TO AN EQUIVALENT.
 - F. ALL WINDOWS AND FRAMES ARE TO REMAIN. PROTECT DURING CONSTRUCTION. HANGERS ARE FOR REFERENCE ONLY; THEY HAVE NOT BEEN FIELD VERIFIED.

- CONSTRUCTION PLAN NOTES:**
1. ALL EXISTING METAL HANGERS TO REMAIN. PROTECT DURING CONSTRUCTION. ALL ARE TO BE REPAIRED, PRIMED & REPAINTED.
 2. NEW WALL FINISH TO MATCH ADJACENT FINISHES. U.I.O.
 3. NEW RATED RECESSED FIRE EXTINGUISHER CABINET. TOP OF ALL.
 4. PROVIDE & INSTALL NEW ELEVATOR FINISHES.
 5. EXISTING RATED DOOR TO ADJACENT BUILDING TO REMAIN. THIS DOOR IS TO BE REPAIRED, CLEANED AT ALL TIMES.
 6. MECHANICAL ROOM ROOF. PROVIDE NEW ROOF.
 7. MECHANICAL ROOM ROOF. PROVIDE NEW ROOF.
 8. MECHANICAL ROOM ROOF. PROVIDE NEW ROOF.
 9. MECHANICAL ROOM ROOF. PROVIDE NEW ROOF.
 10. MECHANICAL ROOM ROOF. PROVIDE NEW ROOF.
 11. ALL BATHROOM FINISHES ARE TO REMAIN. PROTECT DURING CONSTRUCTION. FLOOR FINISH TYPICAL OF ALL U.I.O.
 12. GYP. BO. WRAP SEE DETAIL.
 13. REMOVE AND REPLACE ROOF DRAIN COVERS.
 14. REMOVE AND REPLACE ROOF DRAIN COVERS.
 15. REMOVE AND REPLACE ROOF DRAIN COVERS.
 16. NEW NON-WALLED GYP. BO. WALLS TO MATCH ADJACENT FINISH.
 17. EXISTING ROOF FINISH TO REMAIN.
 18. EXISTING ROOF FINISH TO REMAIN.
 19. EXISTING ROOF FINISH TO REMAIN.
 20. REMOVED EXISTING HANGERS THIS LOCATION ONLY.

A205	Project	Formica Building	No. Revisions	Date
		115 E 5th Street	ENG CHG #1	11.11.2022
	Sheet Title	TYPICAL RESIDENTIAL FLOOR CONSTRUCTION PLAN		
	Project No.	2022_259	Issue Date	
	Scale	As Noted	Drawn	Checked

Formica Building

Office/Apartments


Auditor Address: 115 E. 5th Street, Actual Address: 120 E. 4th Street
 Cincinnati OH 45202

modelgroup
 DEVELOPMENT • CONSTRUCTION • MANAGEMENT


1826 Race Street
 Cincinnati, Ohio 45202
 513.559.0048

STATE OF OHIO
 JOSEPH A. BODKIN
 313367
 REGISTERED ARCHITECT


Joseph A. Bodkin, License #313367
 Expiration Date: 12-31-2023

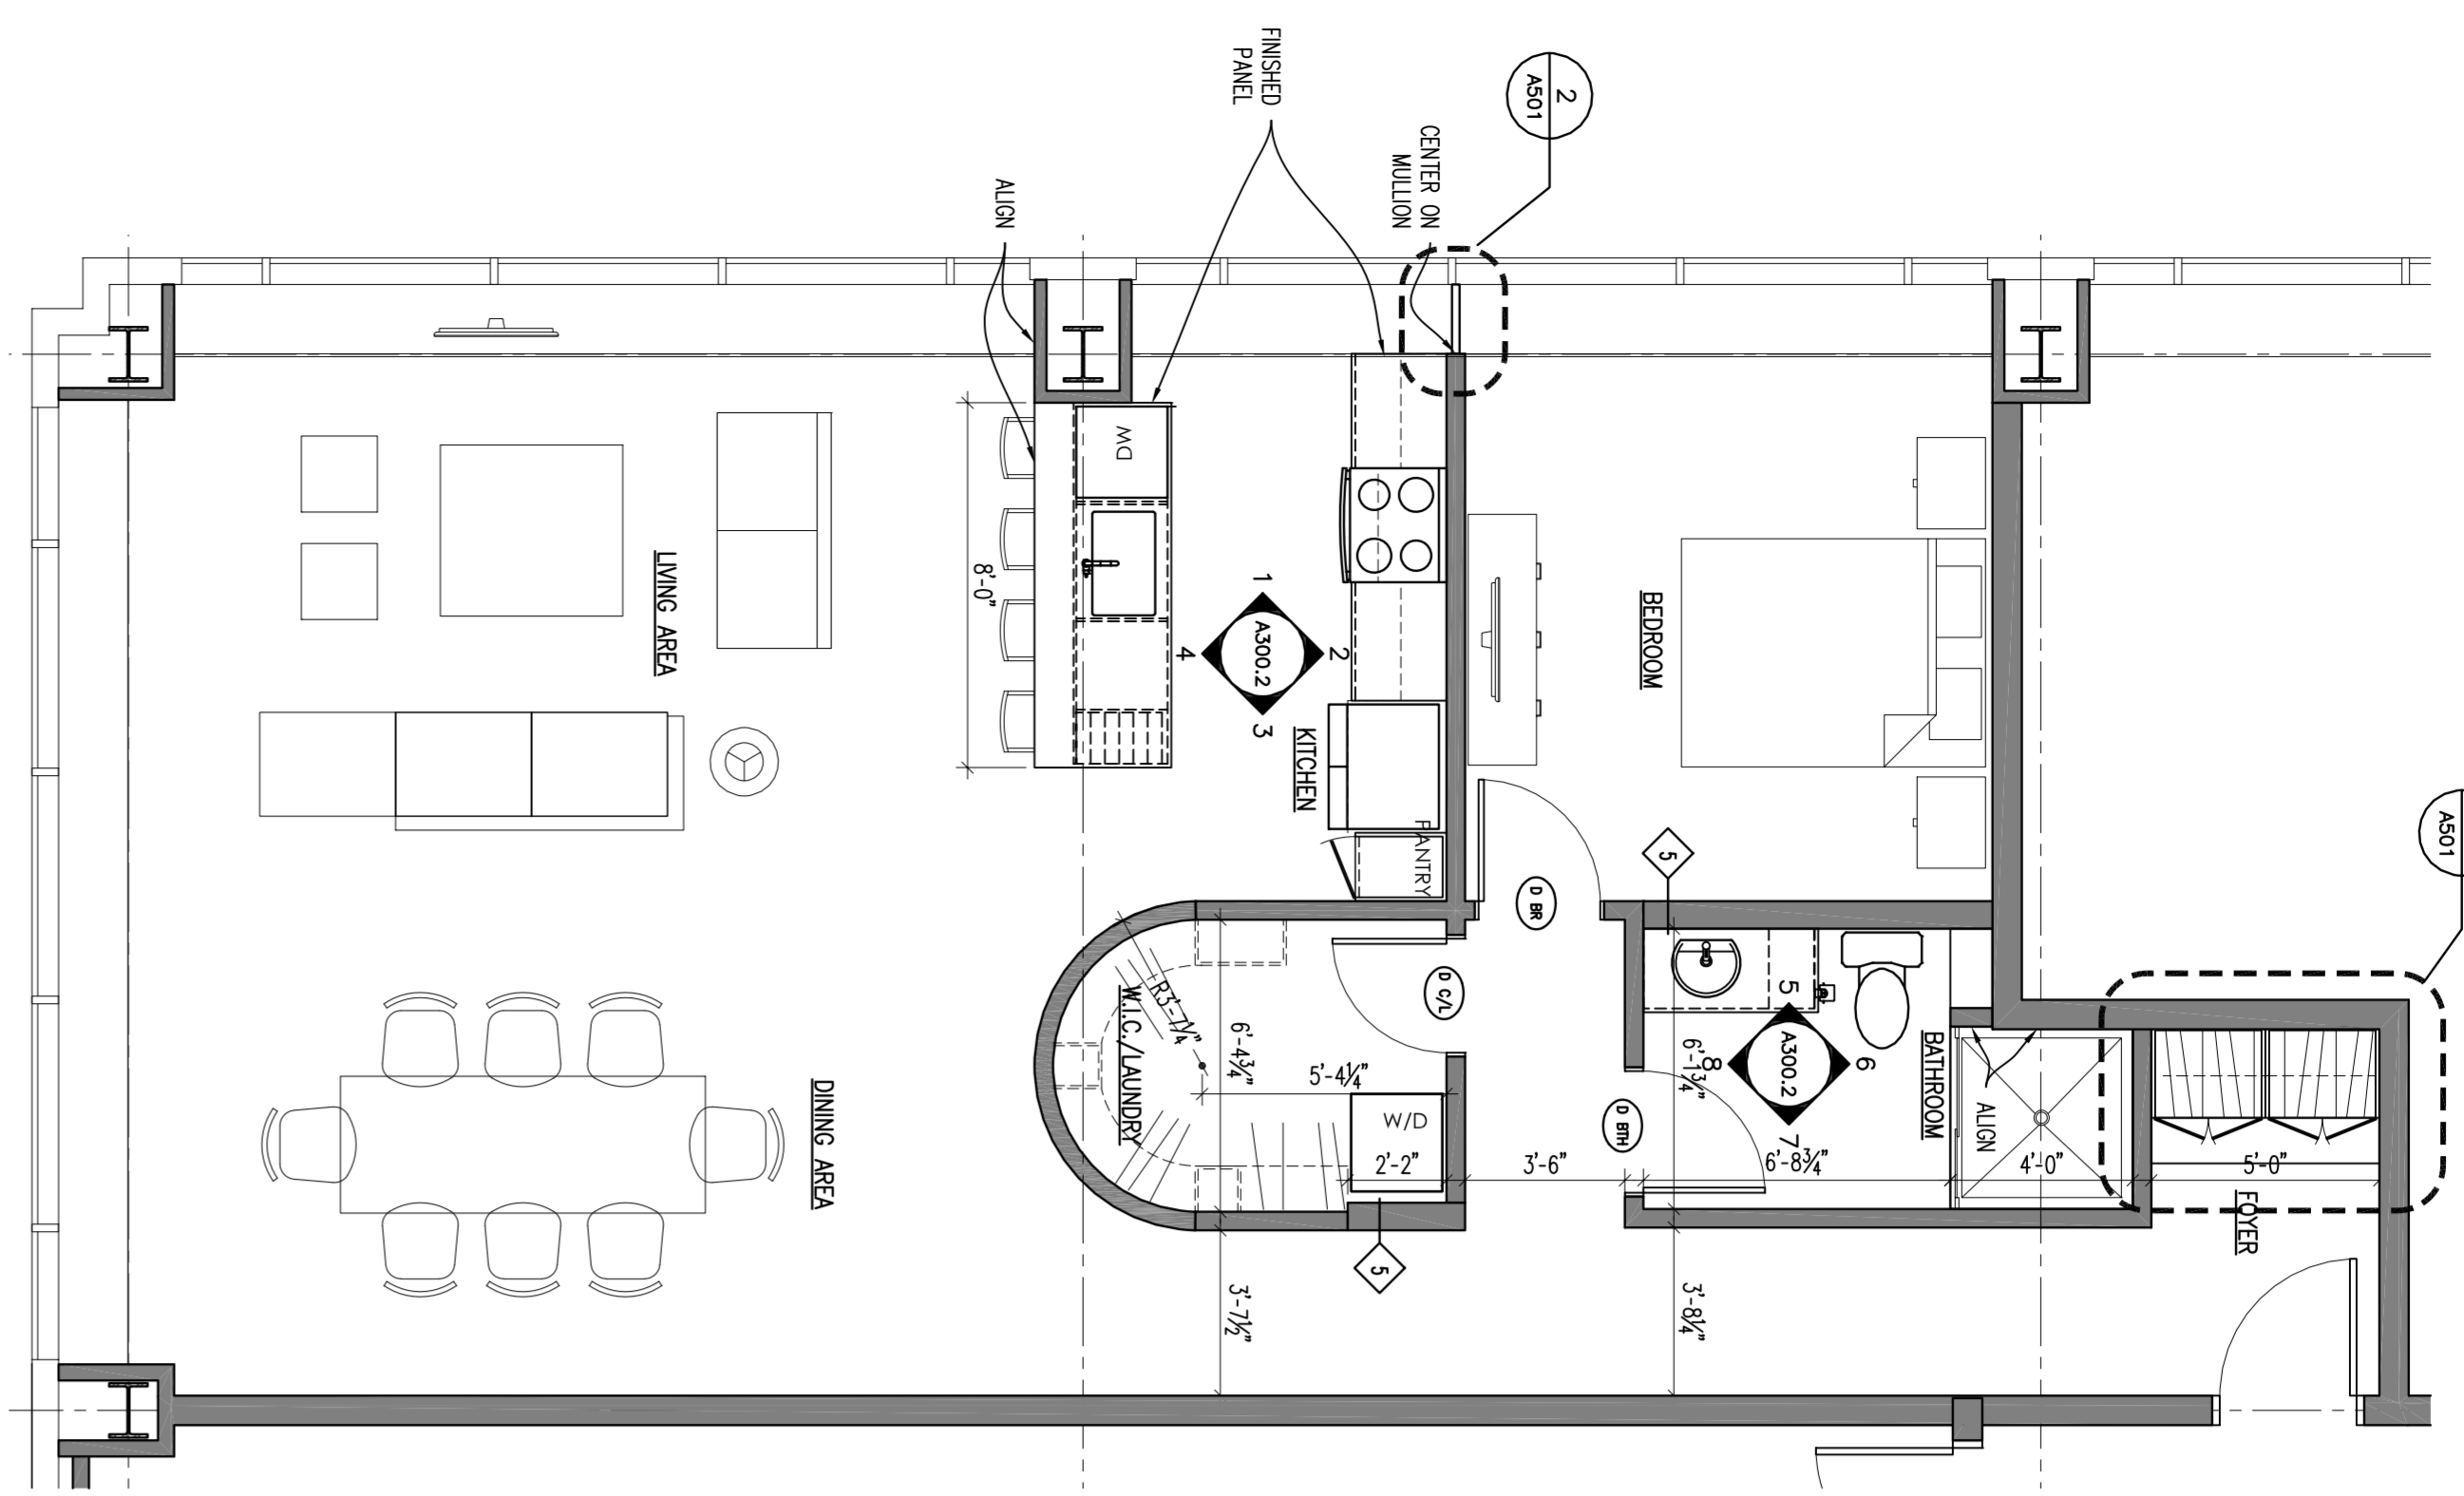


APARTMENT FLOOR PLAN
 SCALE: 1/4" = 1'-0"

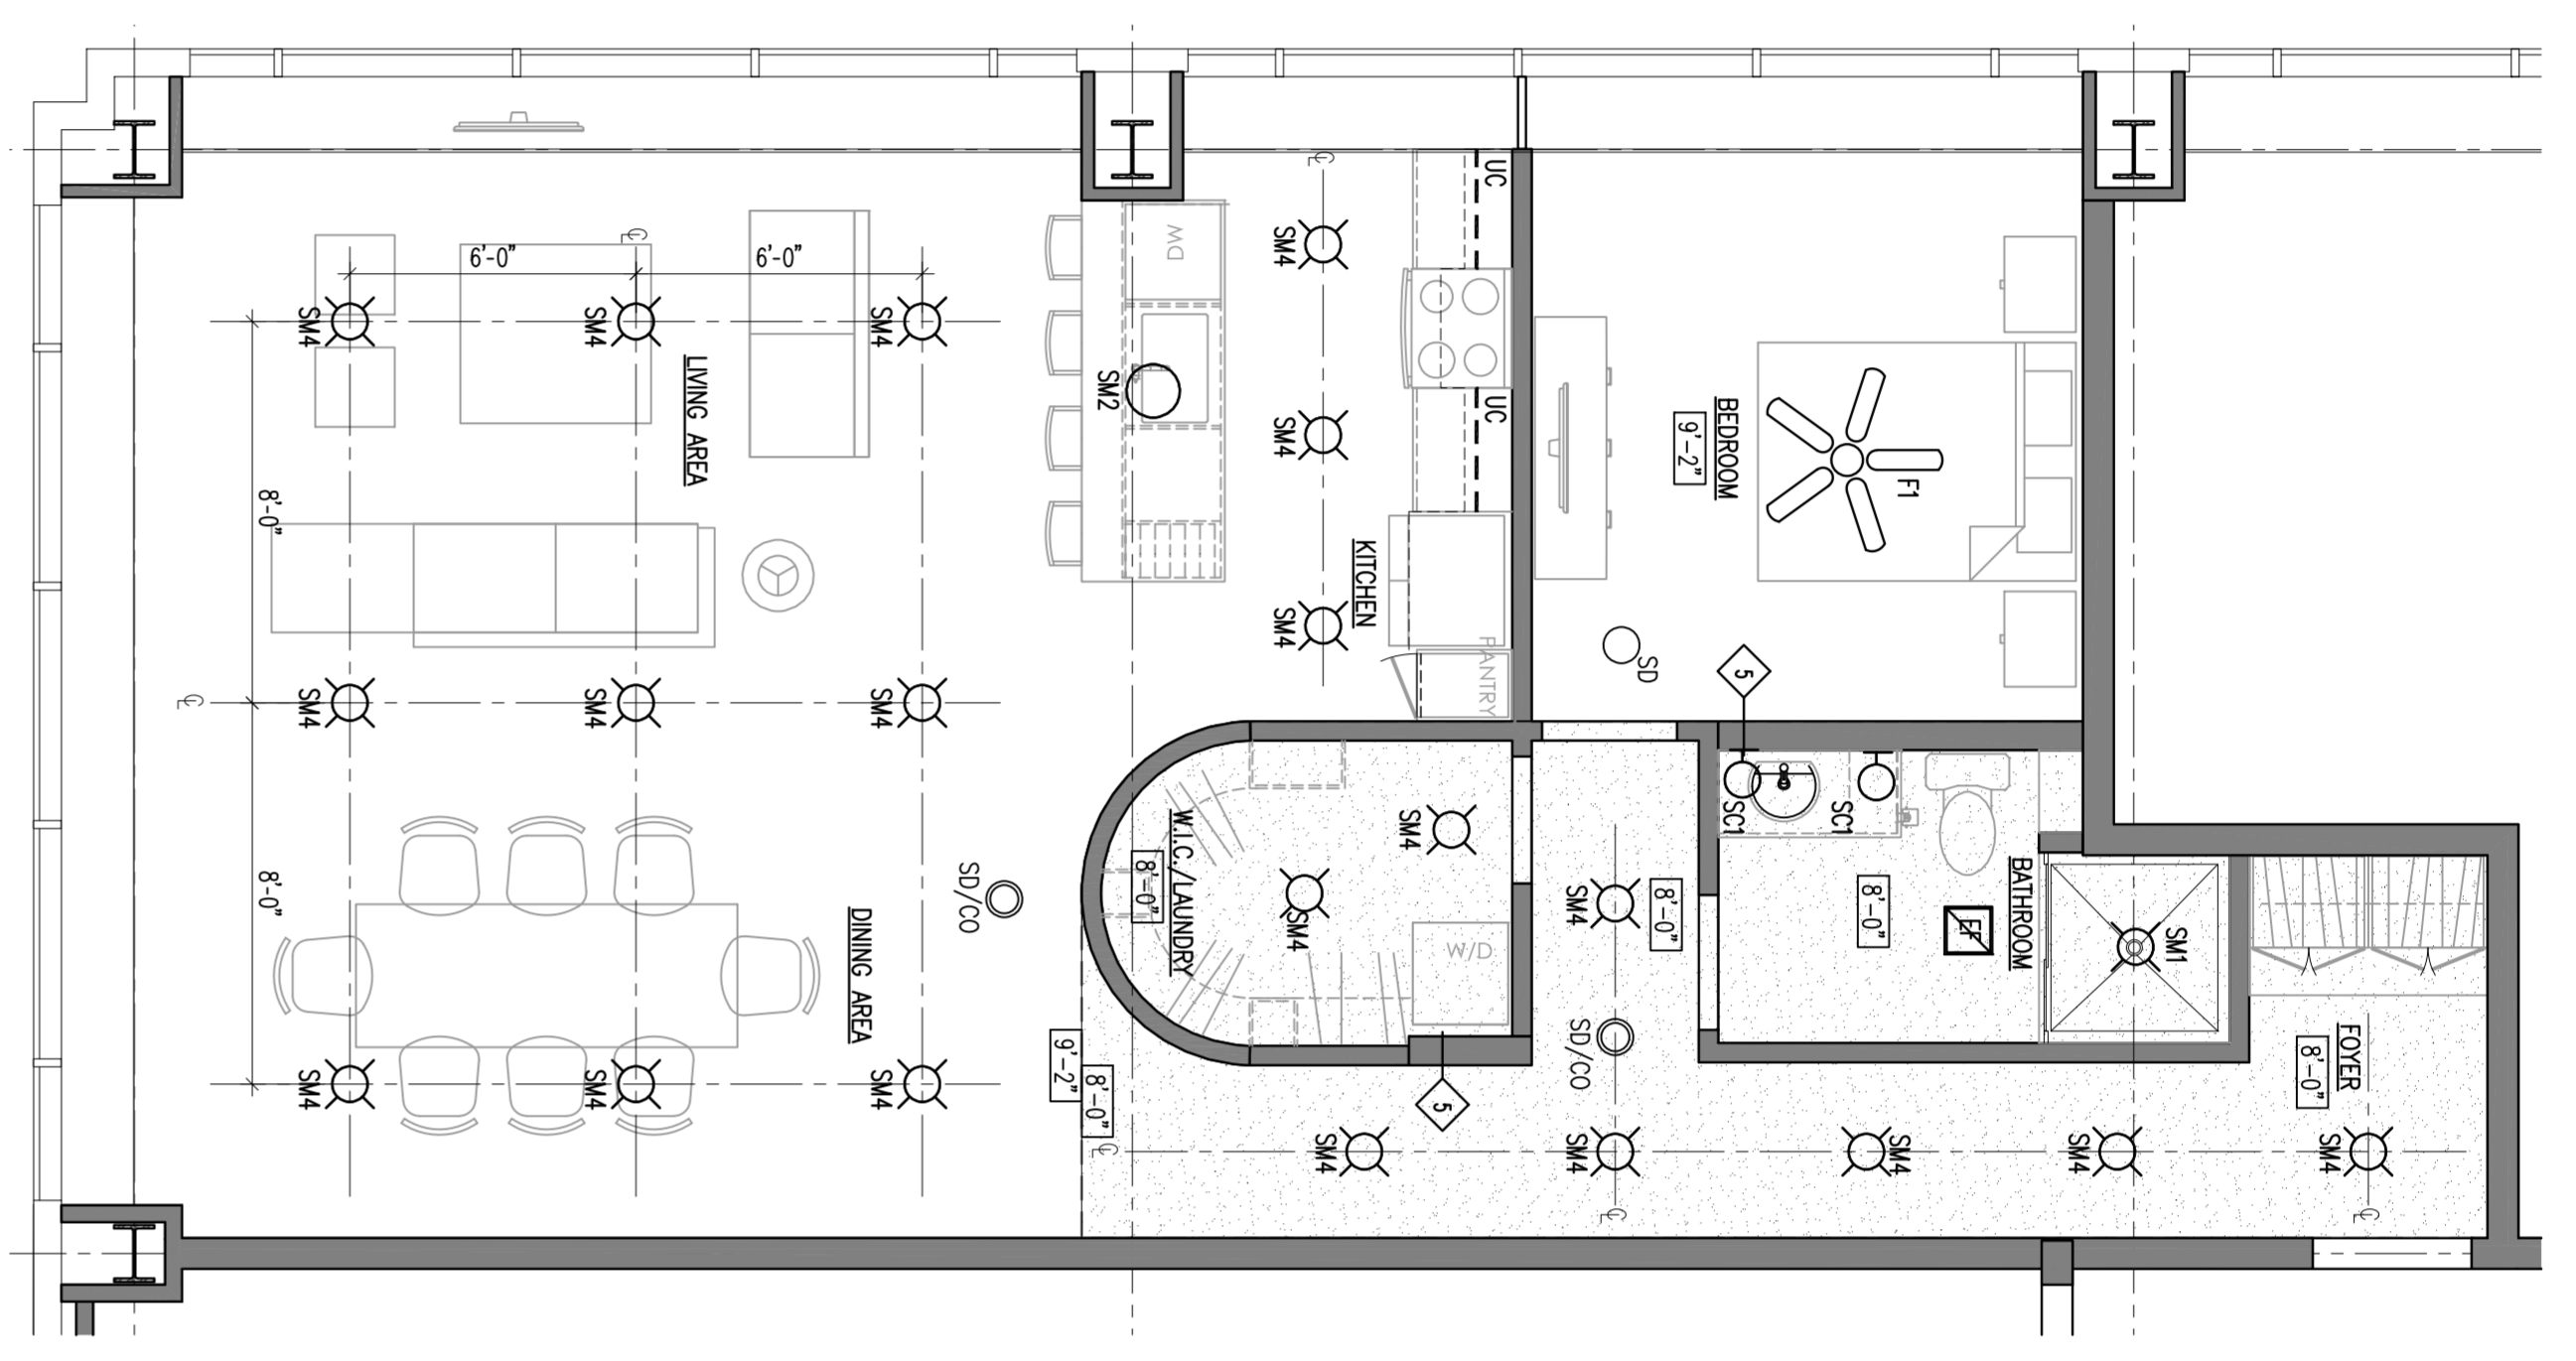


APARTMENT REFLECTED CEILING PLAN
 SCALE: 1/4" = 1'-0"

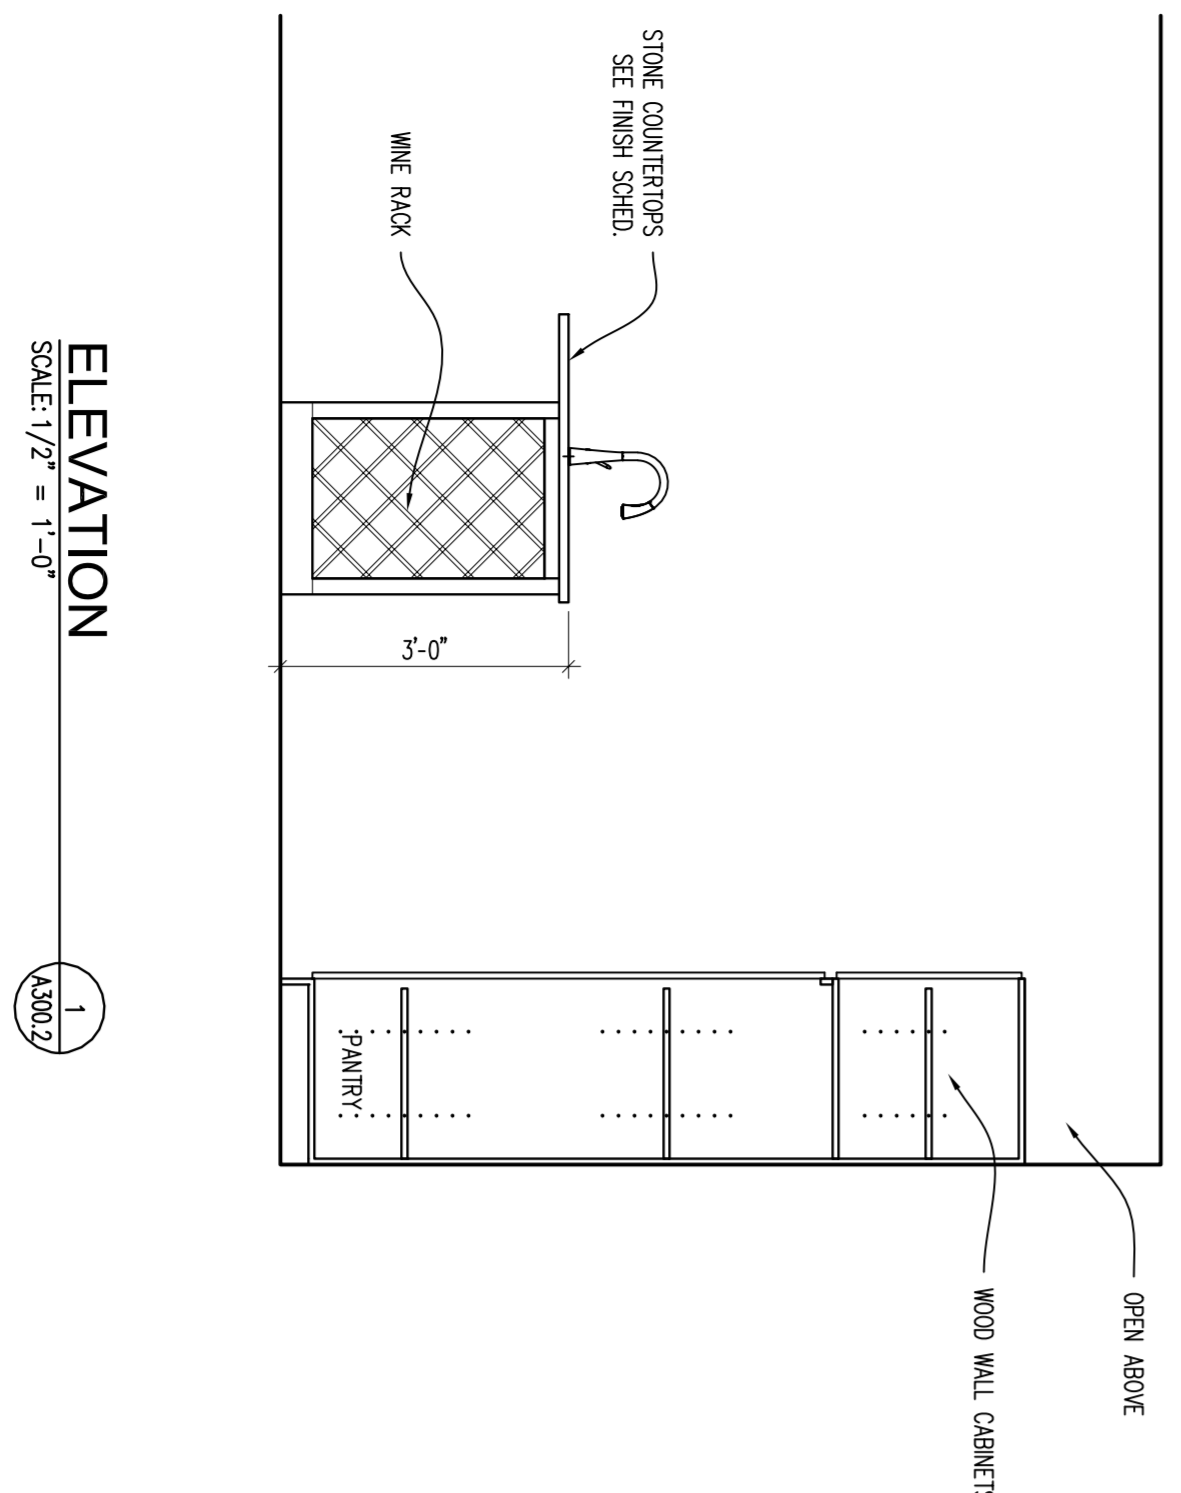


ELEVATION
 SCALE: 1/2" = 1'-0"

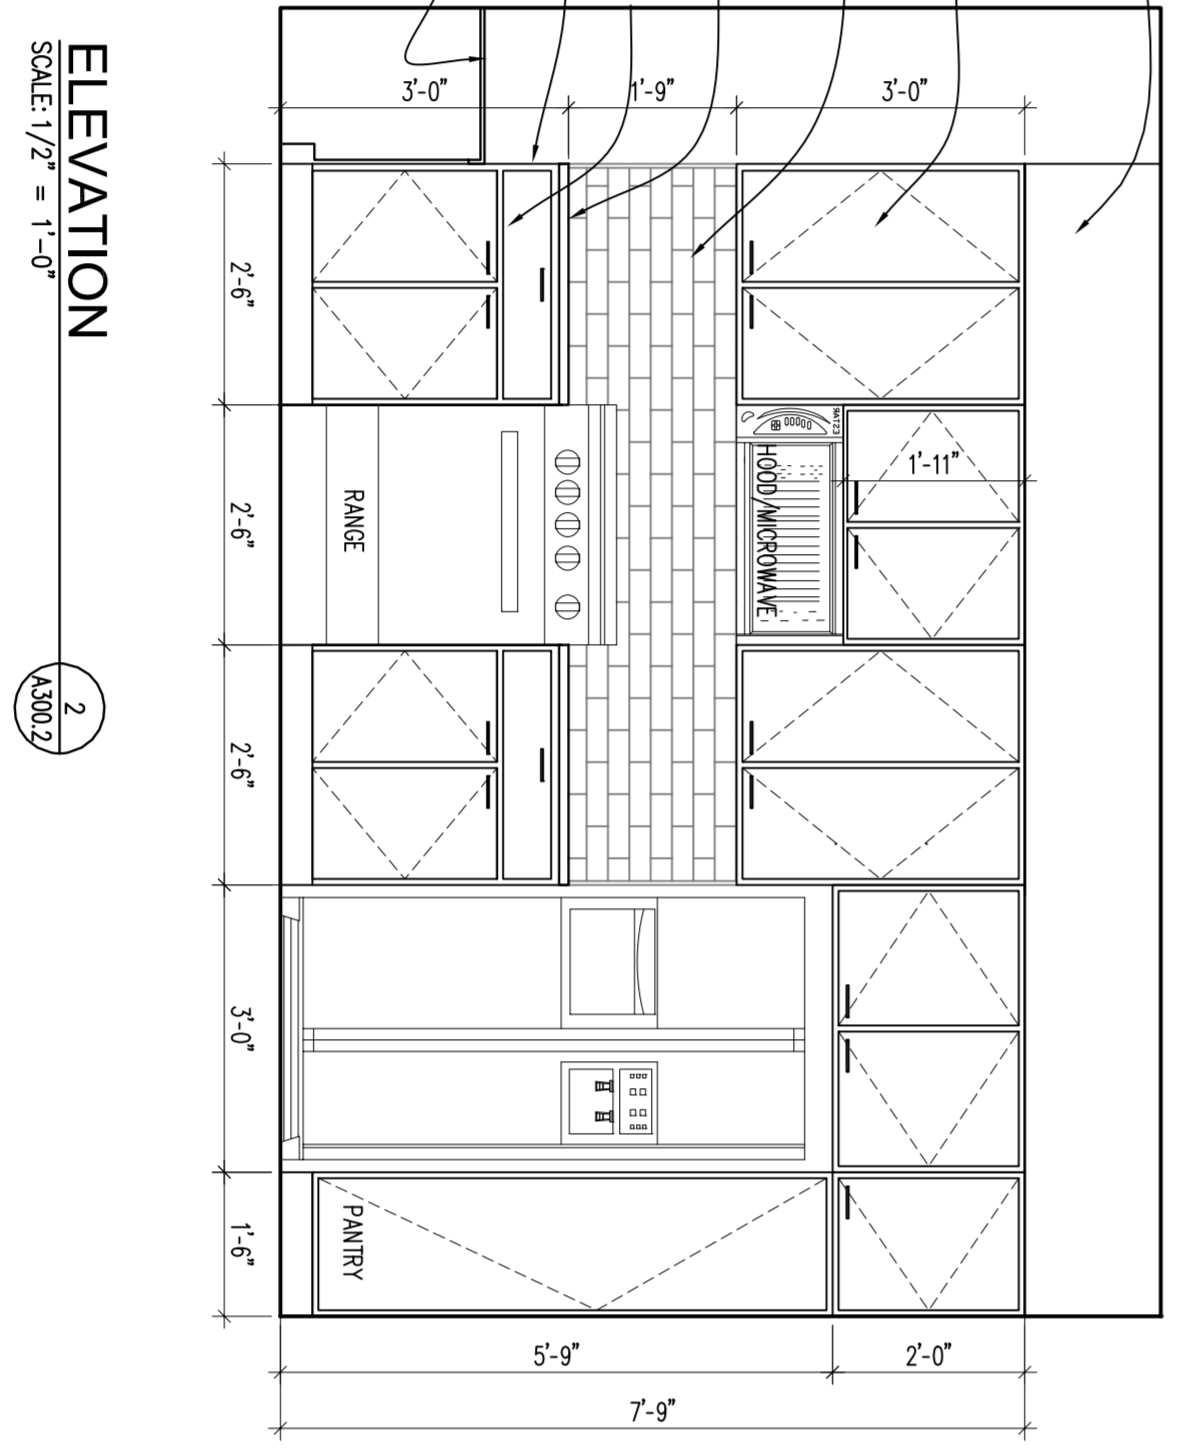

ELEVATION
 SCALE: 1/2" = 1'-0"

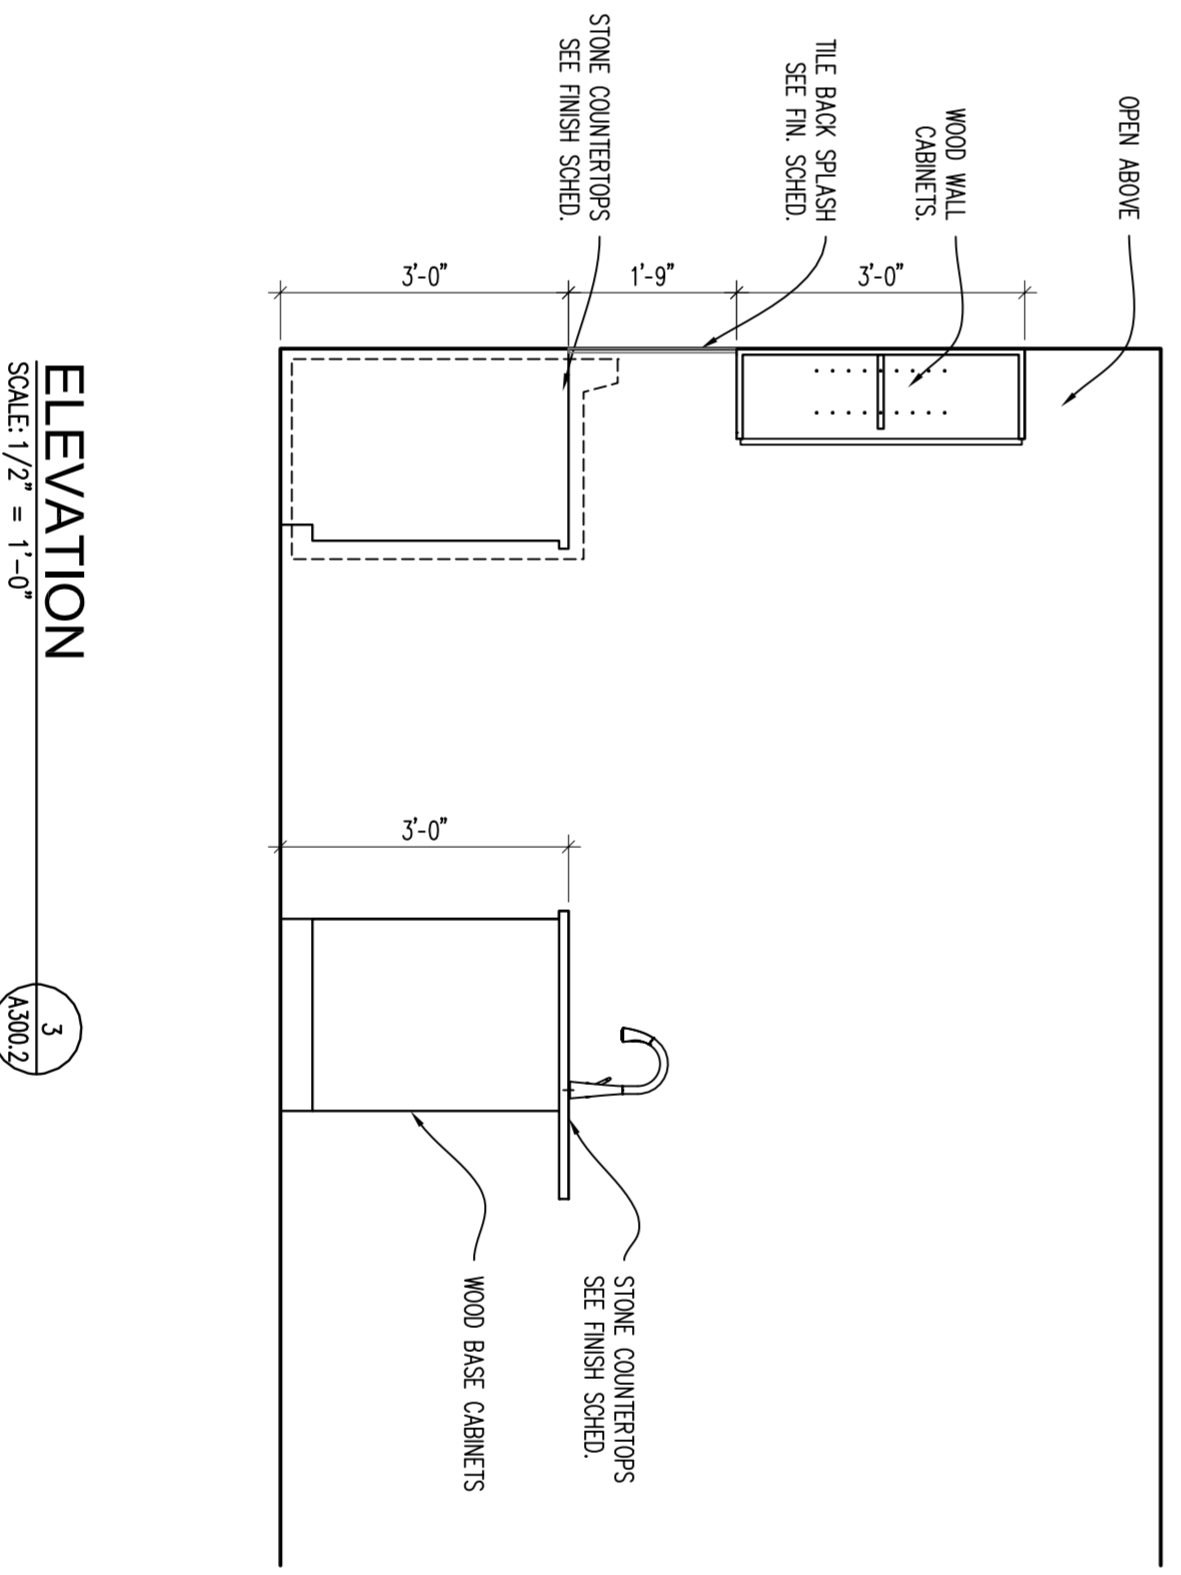


ELEVATION
 SCALE: 1/2" = 1'-0"

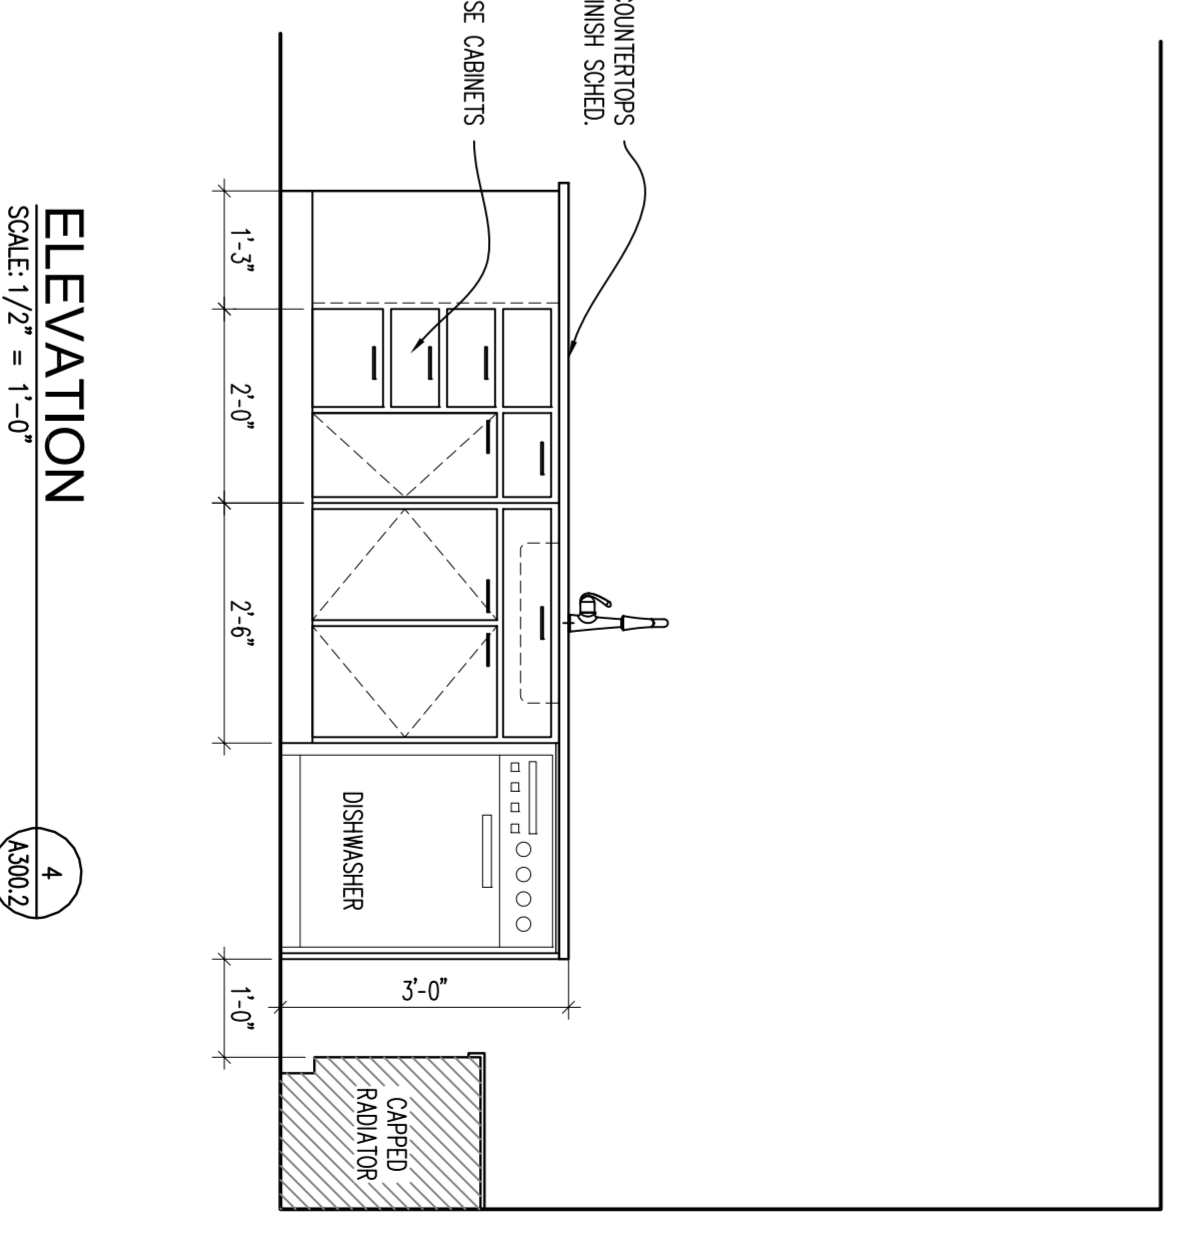


ELEVATION
 SCALE: 1/2" = 1'-0"

APARTMENT ROOM FINISH SCHEDULE					
ROOM NAME	FLOOR	WALLS			REMARKS
		BASE	NORTH	SOUTH	
LIVING AREA	VP-1	RB-3	PT-1	PT-1	NOTES: A
DINING AREA	VP-1	RB-3	PT-1	PT-1	NOTES: A
KITCHEN	VP-1	RB-3	PT-1	PT-1	NOTES: A
WALK-IN CLOSET / LAUNDRY	VP-1	RB-3	PT-1	PT-1	NOTES: A
BEDROOM	VP-1	RB-3	PT-1	PT-1	NOTES: A
BEDROOM	VP-1	RB-3	PT-1	PT-1	NOTES: A
BATHROOM	VP-1	RB-3	PT-1	PT-1	NOTES: A
FOYER / CORRIDOR	VP-1	RB-3	PT-1	PT-1	NOTES: A


APARTMENT DOOR SCHEDULE						
DOOR MARK	DOOR LOCATION	DOOR INFORMATION		FRAME INFORMATION		REMARKS
		SIZE	THICK STYLE	DETAIL	OTHER	
0 BR	BEDROOM	2'-6"	1-3/8"	2	OK	PRE-HANG STAINED
0 BR	BEDROOM	2'-6"	1-3/8"	2	OK	PRE-HANG STAINED
0 C/L	CLOSET / LAUNDRY	2'-6"	1-3/8"	2	OK	PRE-HANG STAINED

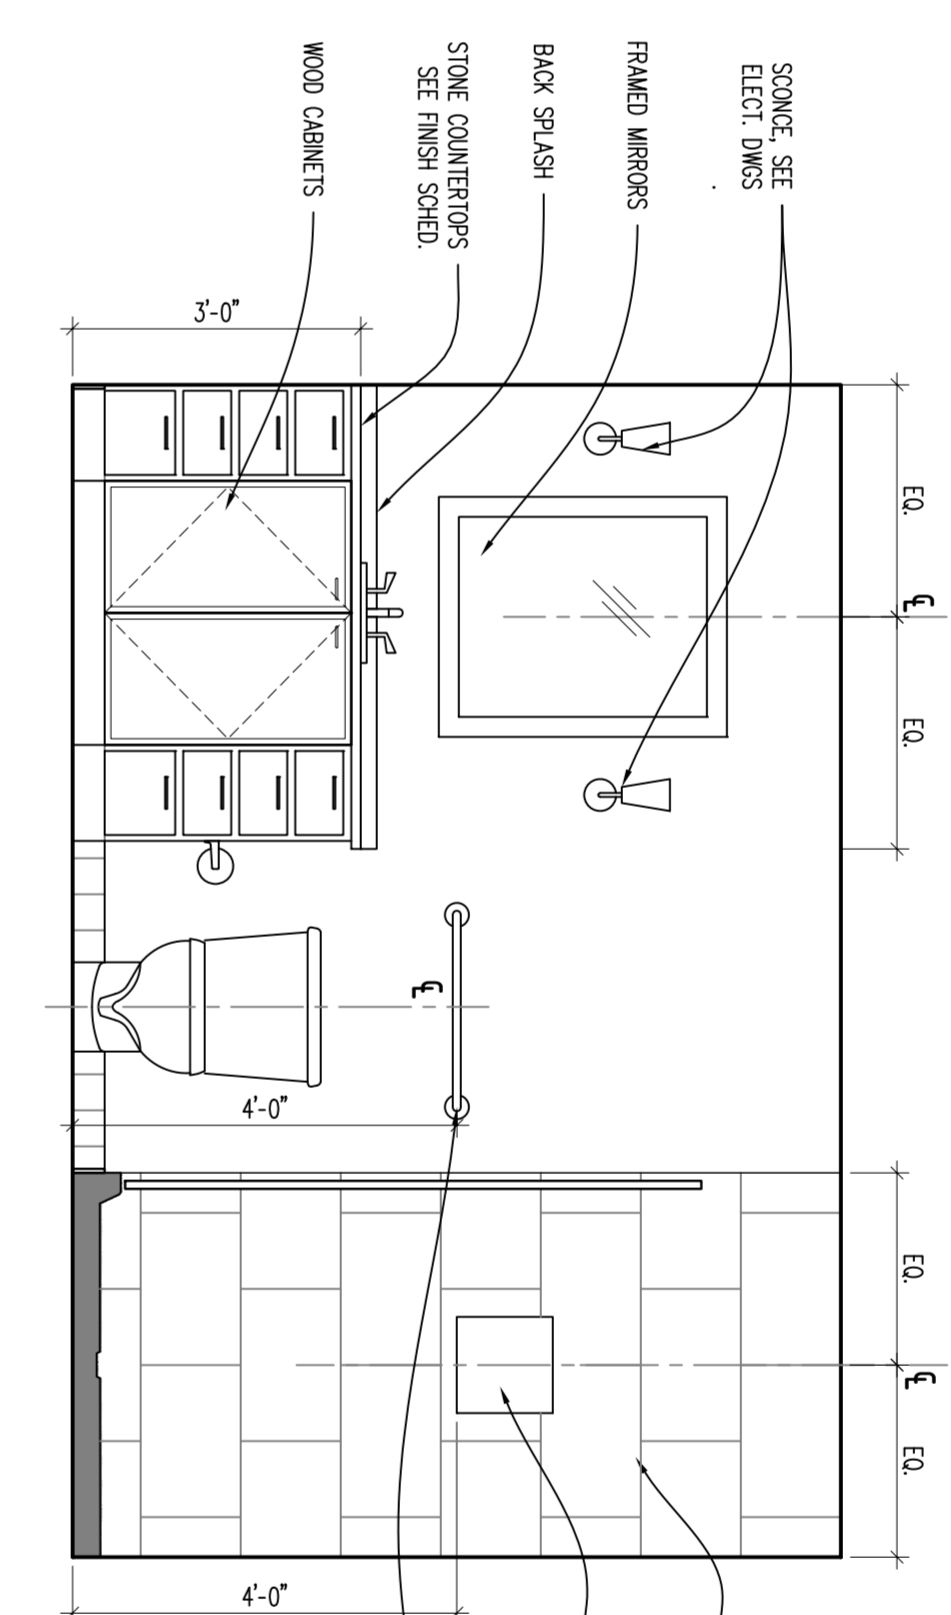


ELEVATION
 SCALE: 1/2" = 1'-0"

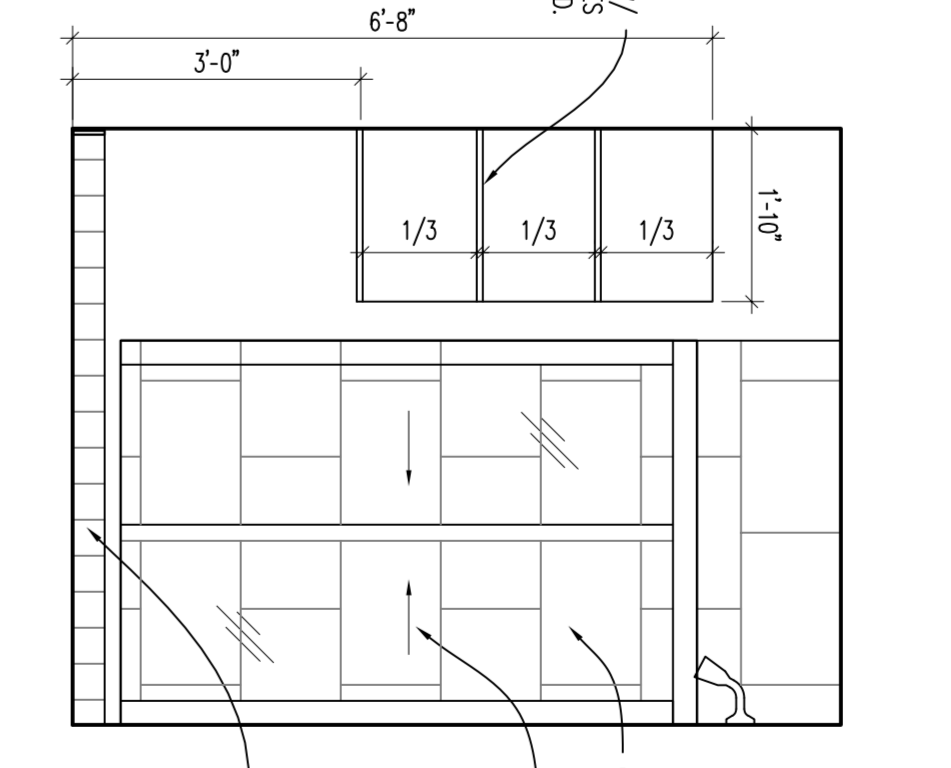

ELEVATION
 SCALE: 1/2" = 1'-0"

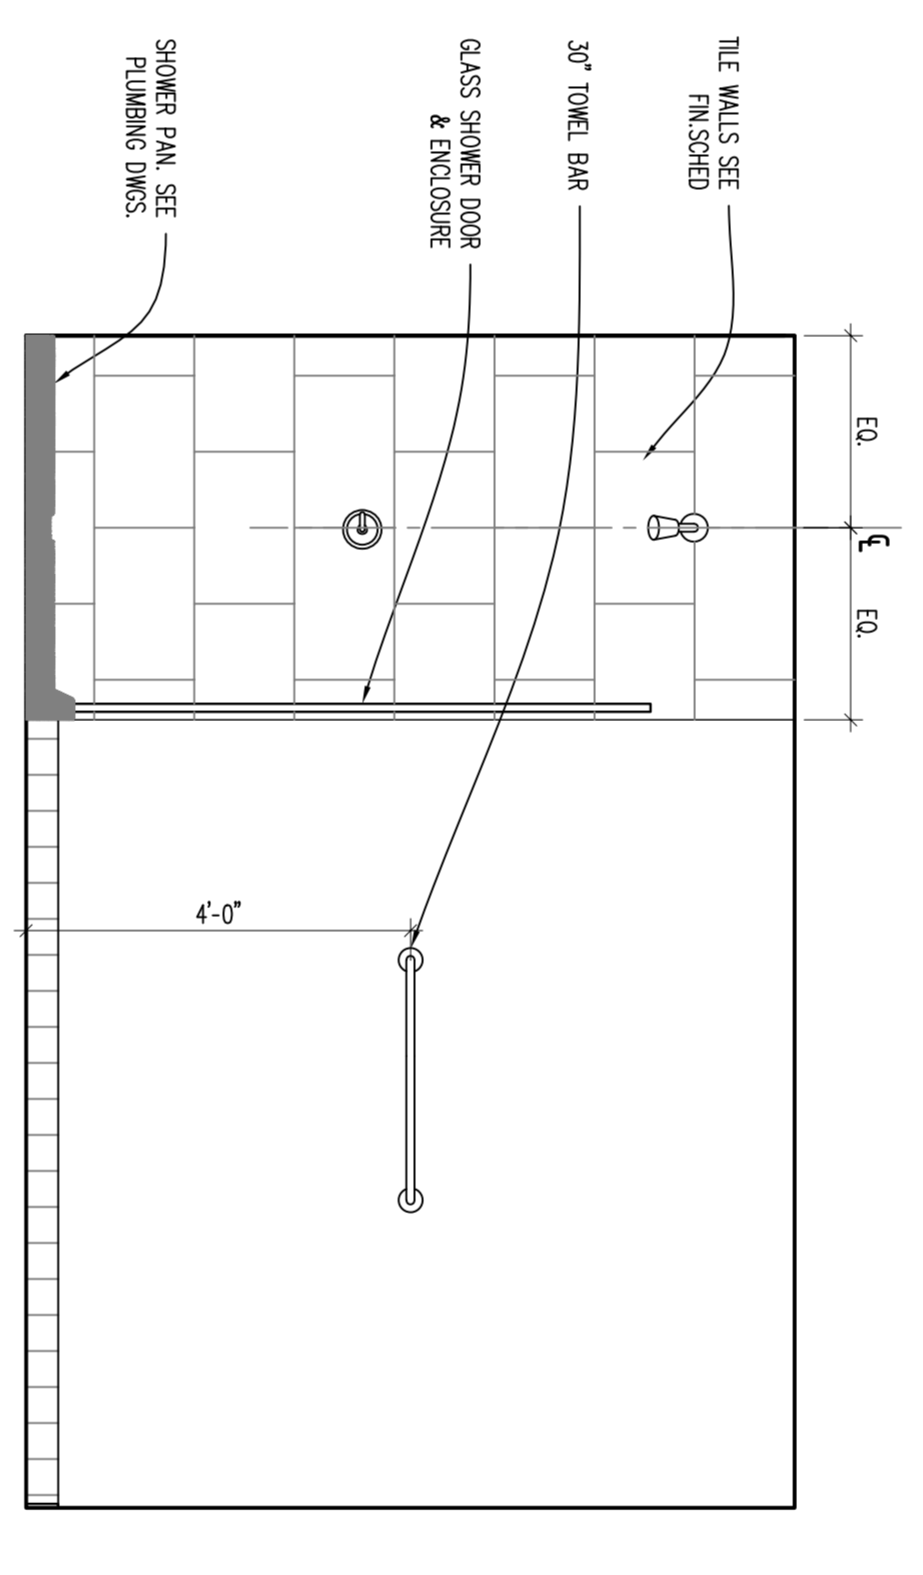

ELEVATION
 SCALE: 1/2" = 1'-0"

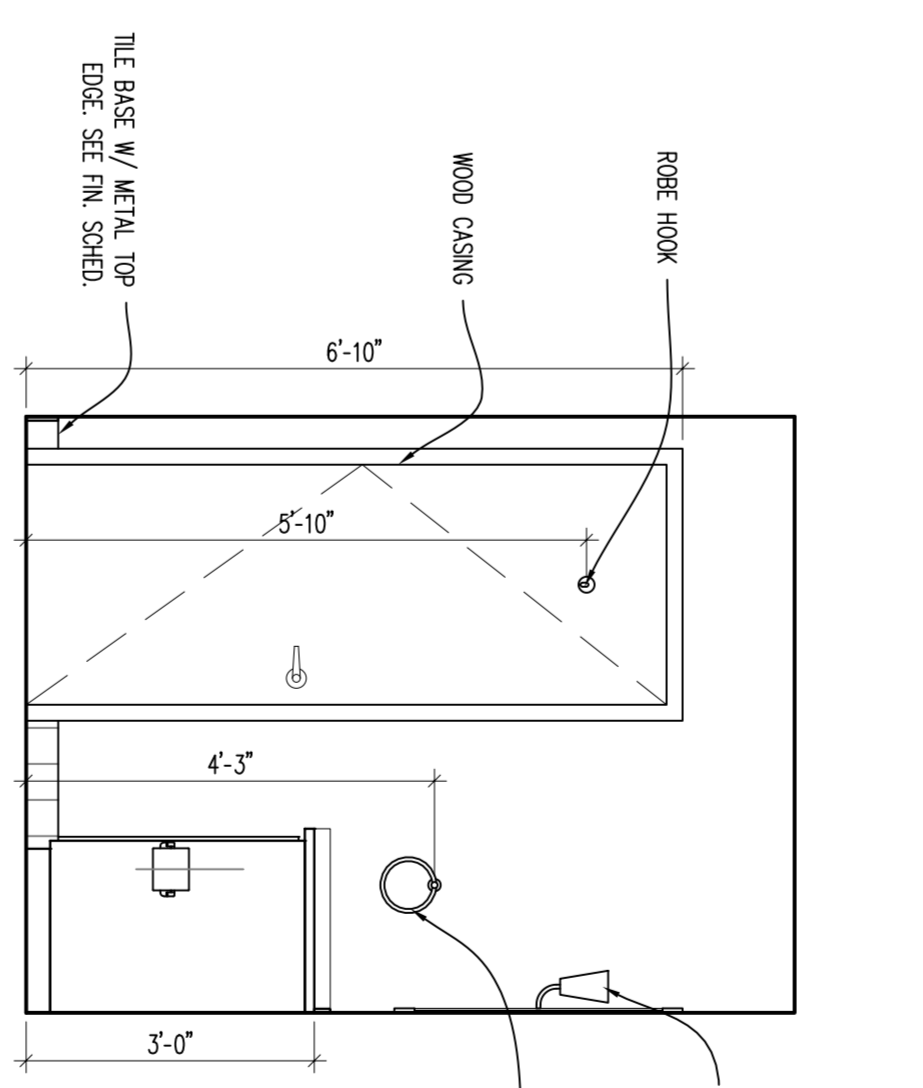

ELEVATION
 SCALE: 1/2" = 1'-0"

- GENERAL APARTMENT NOTES**
- DOOR FRAME SHALL BE 4" FROM FACE OF WALL TO BACKSIDE OF FRAME (UNLESS NOTED OTHERWISE).
 - DOOR DIMENSIONS ARE FROM FINISH FACE OF WALL TO FINISH FACE OF WALL UNLESS NOTED OTHERWISE.
 - FACE OF WALL UNLESS NOTED OTHERWISE.
 - ALL LIGHTING FOR REFERENCE ONLY.
 - ALL CABINET DRAWINGS ARE FOR DESIGN INTENT ONLY. REVISIONS SHALL BE PROVIDED TO THE ARCHITECT FOR ALL VISIBLE PARTS OF CABINETS AND TO RECEIVE A REVISION BASIS OF DESIGN ARE SHOWN CABINETS INCLUDES CABINETS THAT ARE UP AGAINST THE WINDOWS AND/OR FACING THE WINDOWS. TOP OF ALL ENERGY STAR APPLIANCES (REFRIGERATOR, DISHWASHER, RANGE) SHALL BE NEW PROVIDE BACKING FOR FUTURE CABINETS IN ALL UNIT ALL PAINTY AND LINEN CLOSETS TO RECEIVE ONE (1) ADJUSTABLE MEANIE SHELVES. ALL CABINETS SHALL BE PROVIDED WITH GLASS SHOWER DOOR AND EACH SHOWER TO BE PROVIDED WITH GLASS SHOWER DOOR. (1) TOILET PAPER HOLDER (1) ROBE HOOK.

A300.2

Project: Formica Building
 115 E 5th Street
 Cincinnati, Ohio 45202

Sheet Title: Unit A.2 Construction

Project No: 2022_259 Issue Date: 11.14.2022

Scale: As Noted

No.	Revisions	Date
1	ENG CHG #1	11.14.2022

Formica Building

Office/Apartments


Auditor Address: 115 E. 5th Street, Actual Address: 120 E. 4th Street
 Cincinnati OH 45202

modelgroup
 DEVELOPMENT • CONSTRUCTION • MANAGEMENT


1826 Race Street
 Cincinnati, Ohio 45202
 513.559.0048

STATE OF OHIO
 JOSEPH A. BODKIN
 313367
 REGISTERED ARCHITECT


Joseph A. Bodkin, License #313367
 Expiration Date: 12-31-2023

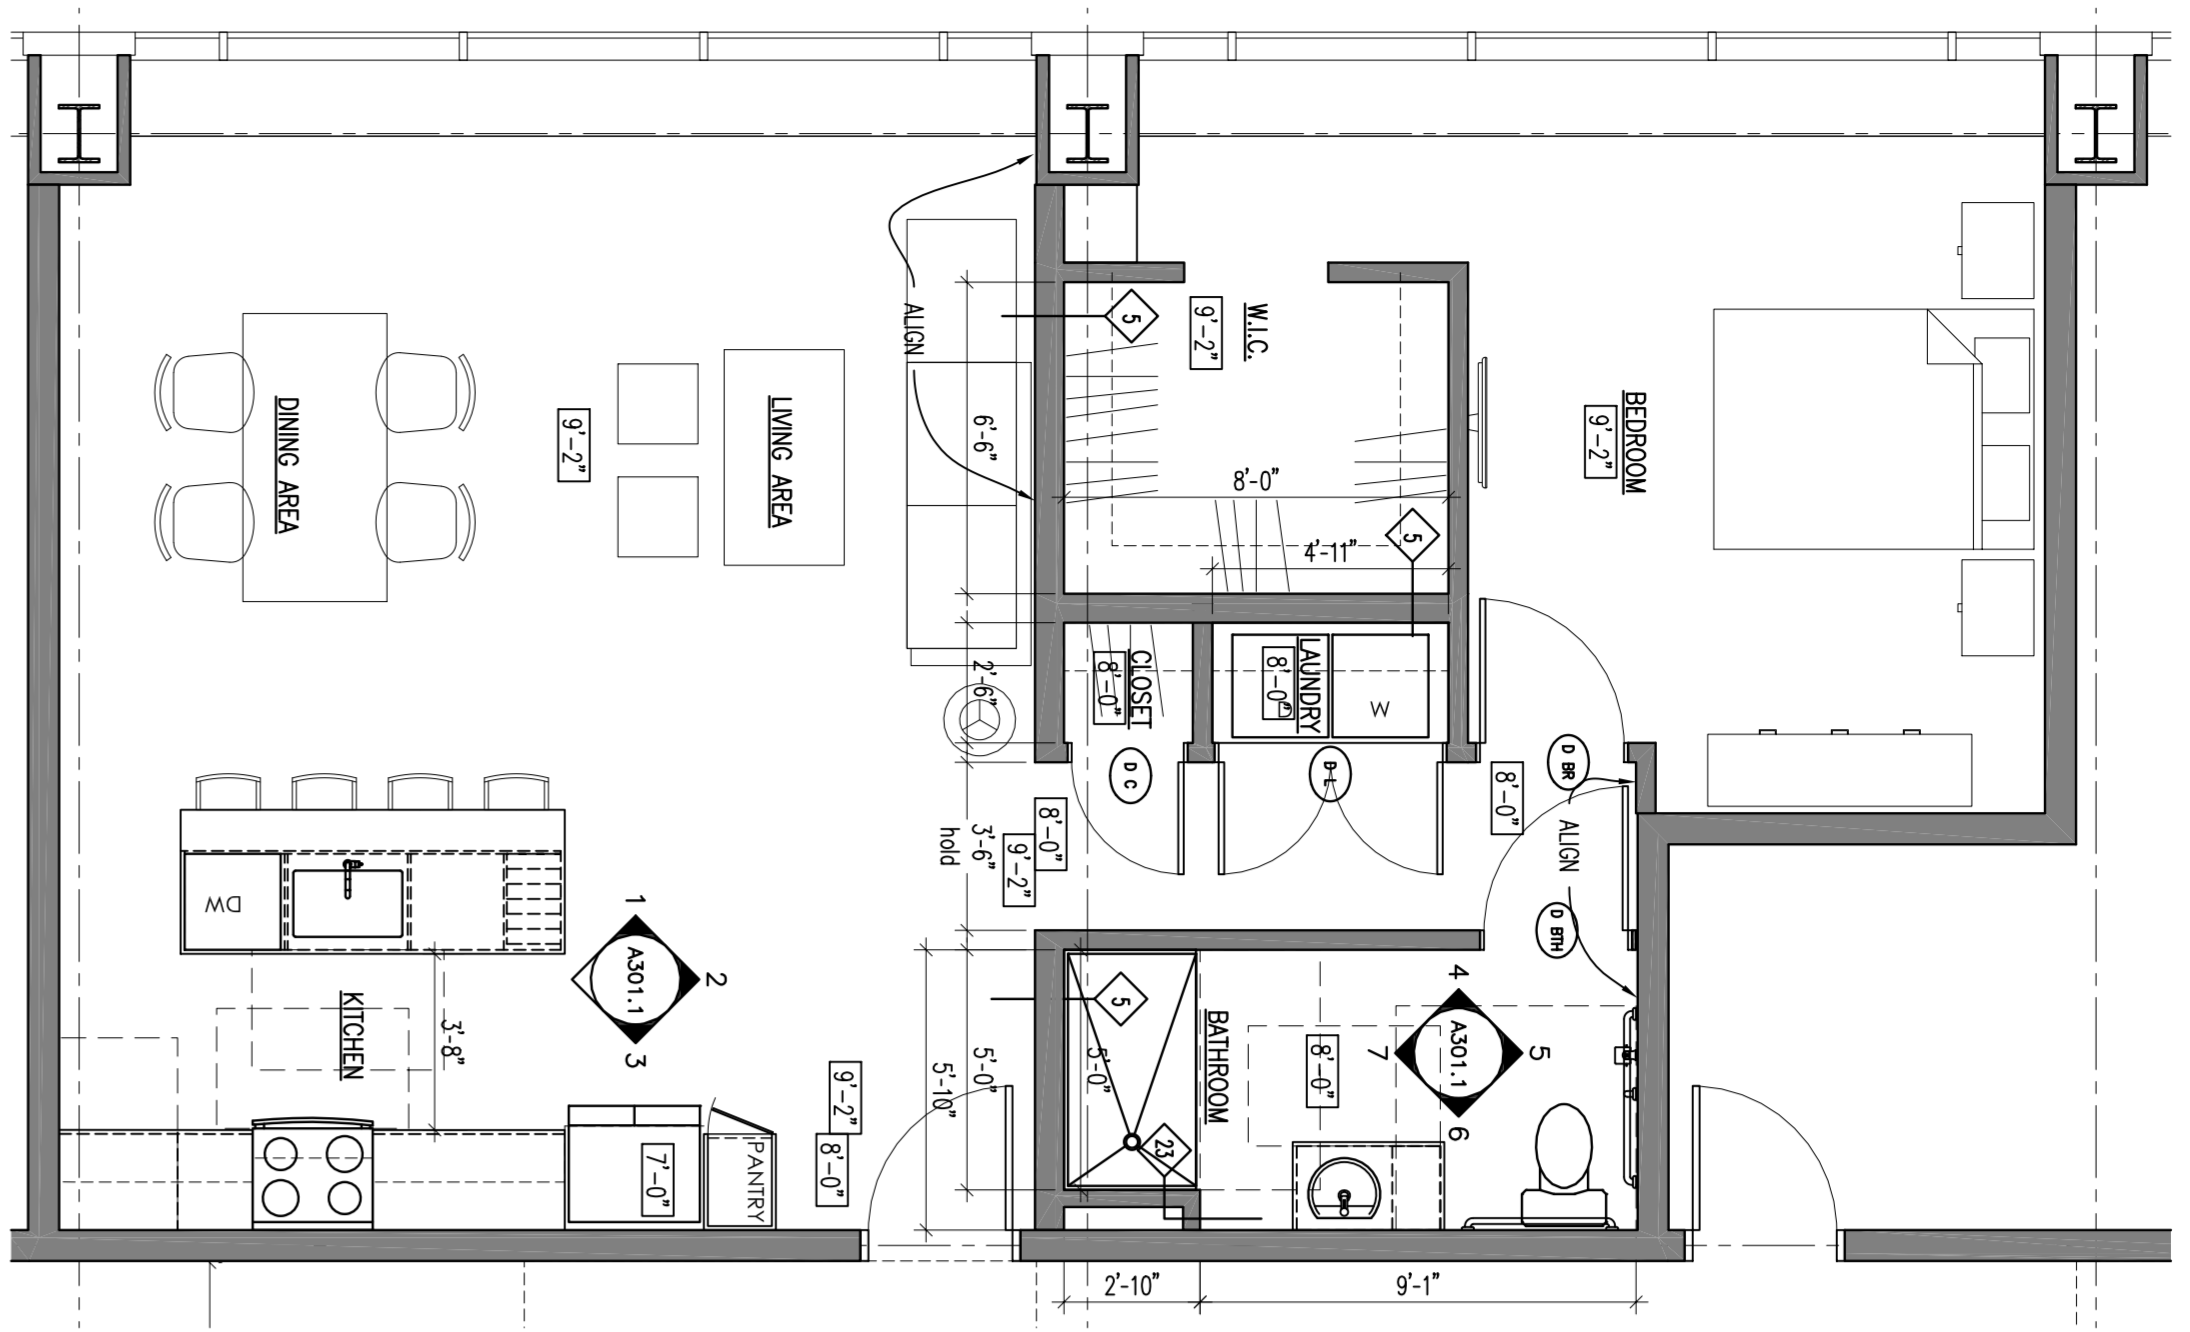


APARTMENT FLOOR PLAN - ADA
 SCALE: 1/8" = 1'-0"

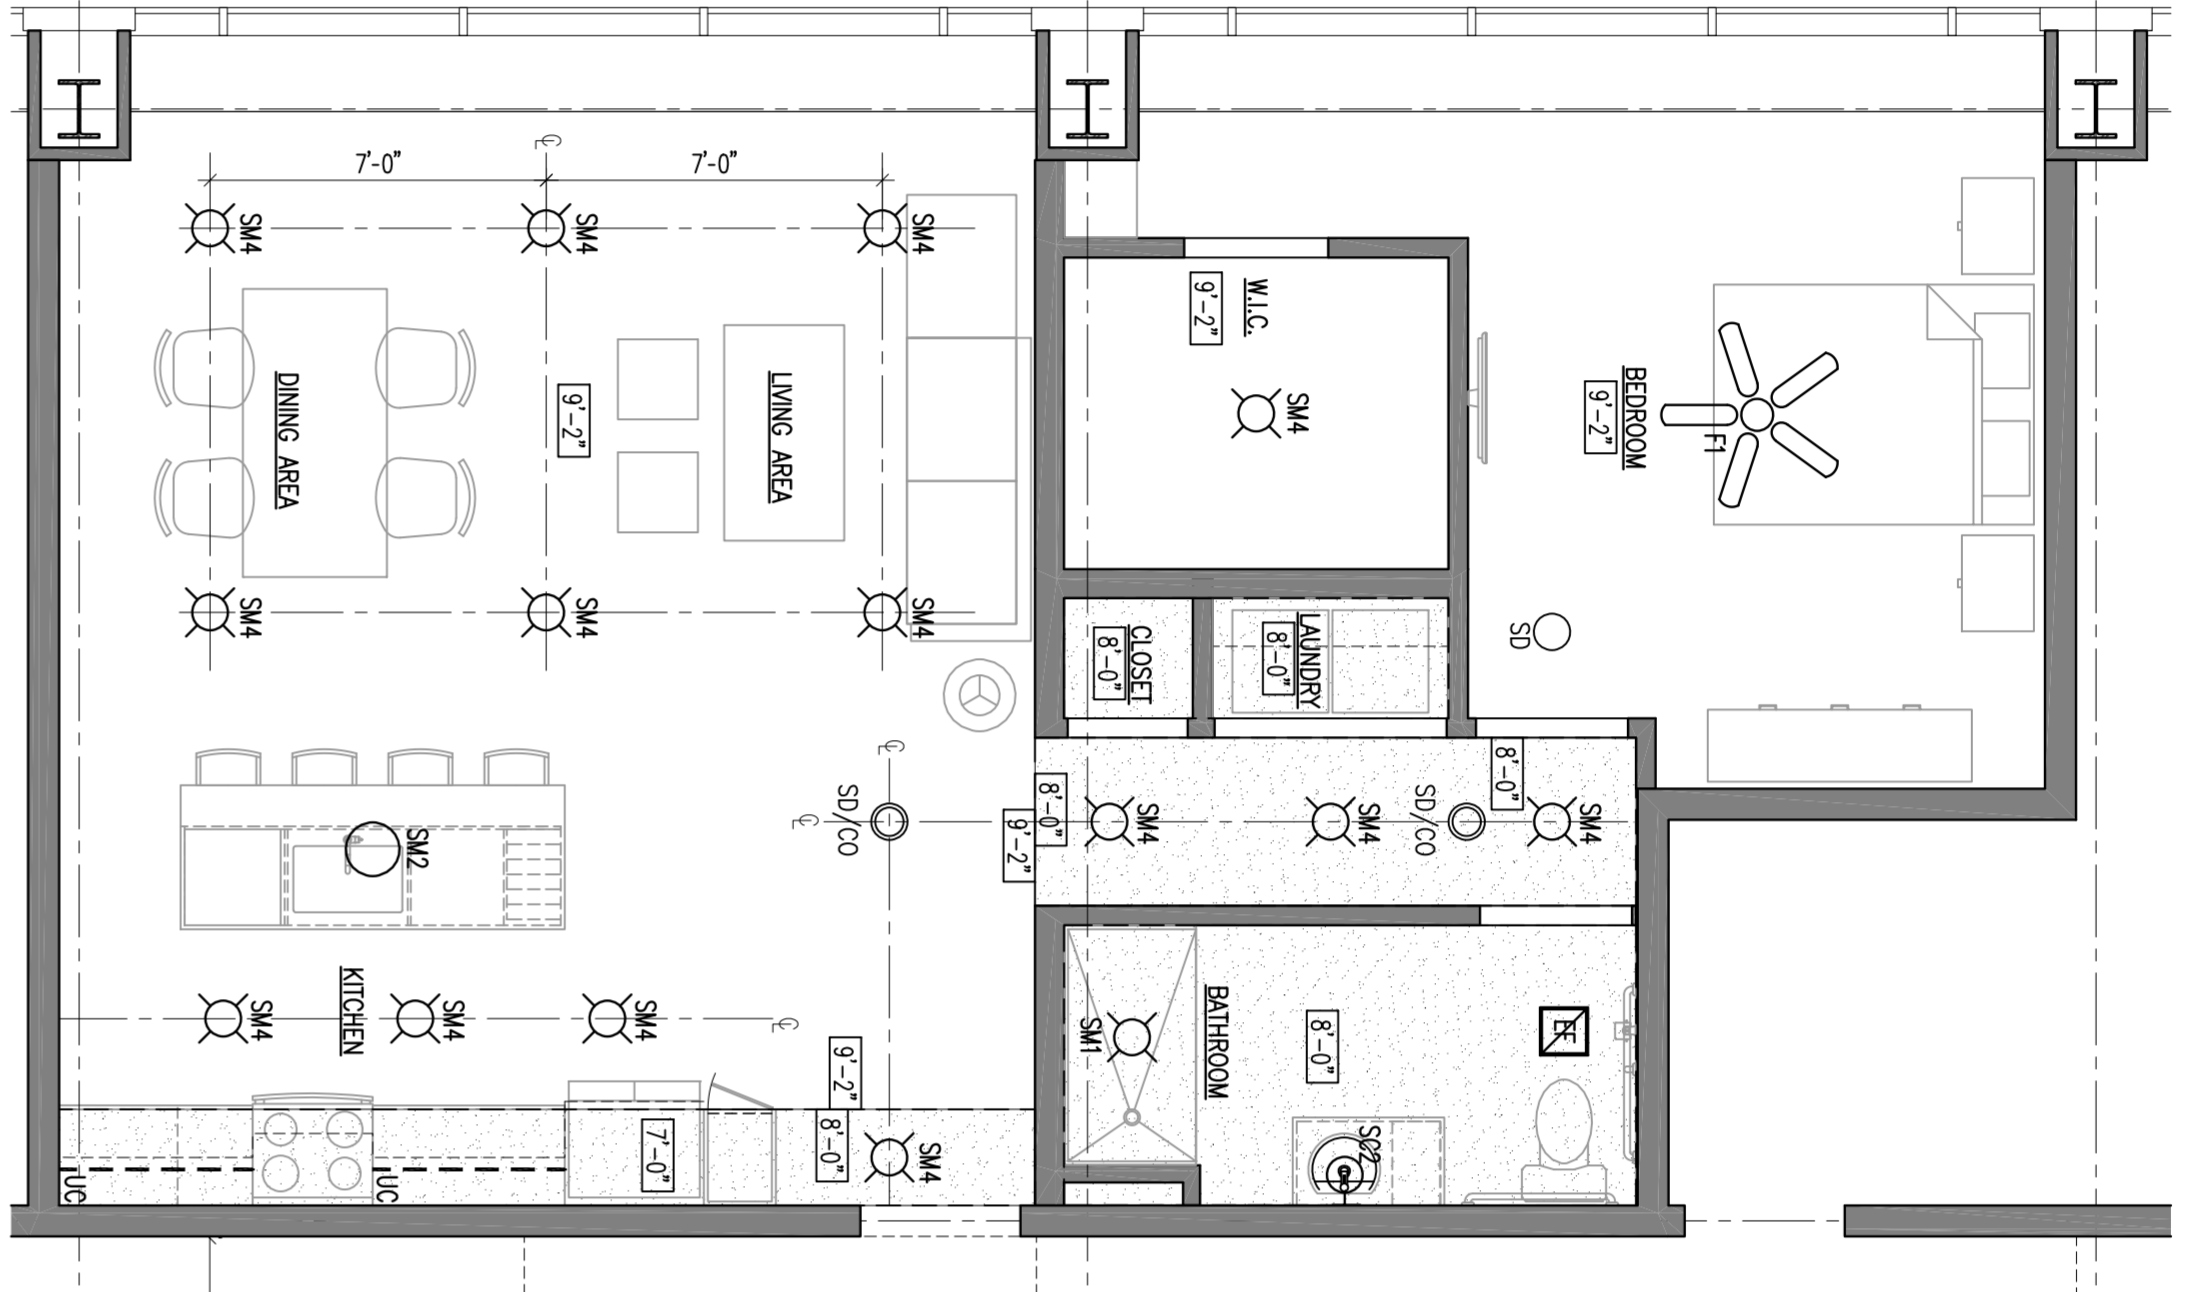

APARTMENT REFLECTED CEILING PLAN
 SCALE: 1/8" = 1'-0"

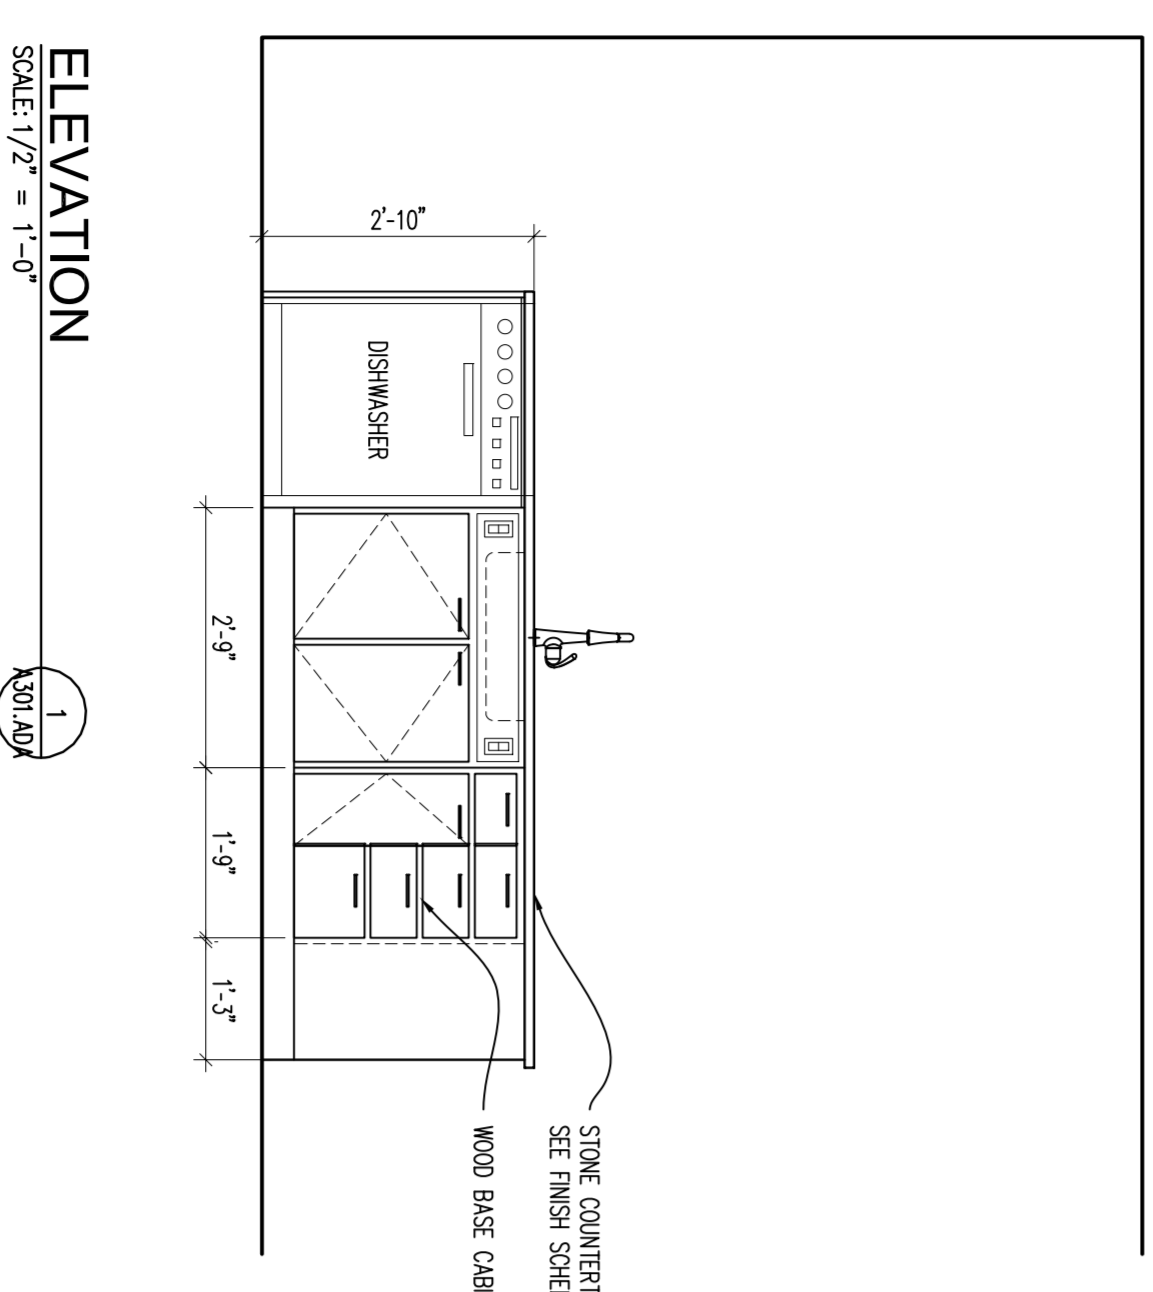

ELEVATION
 SCALE: 1/2" = 1'-0"

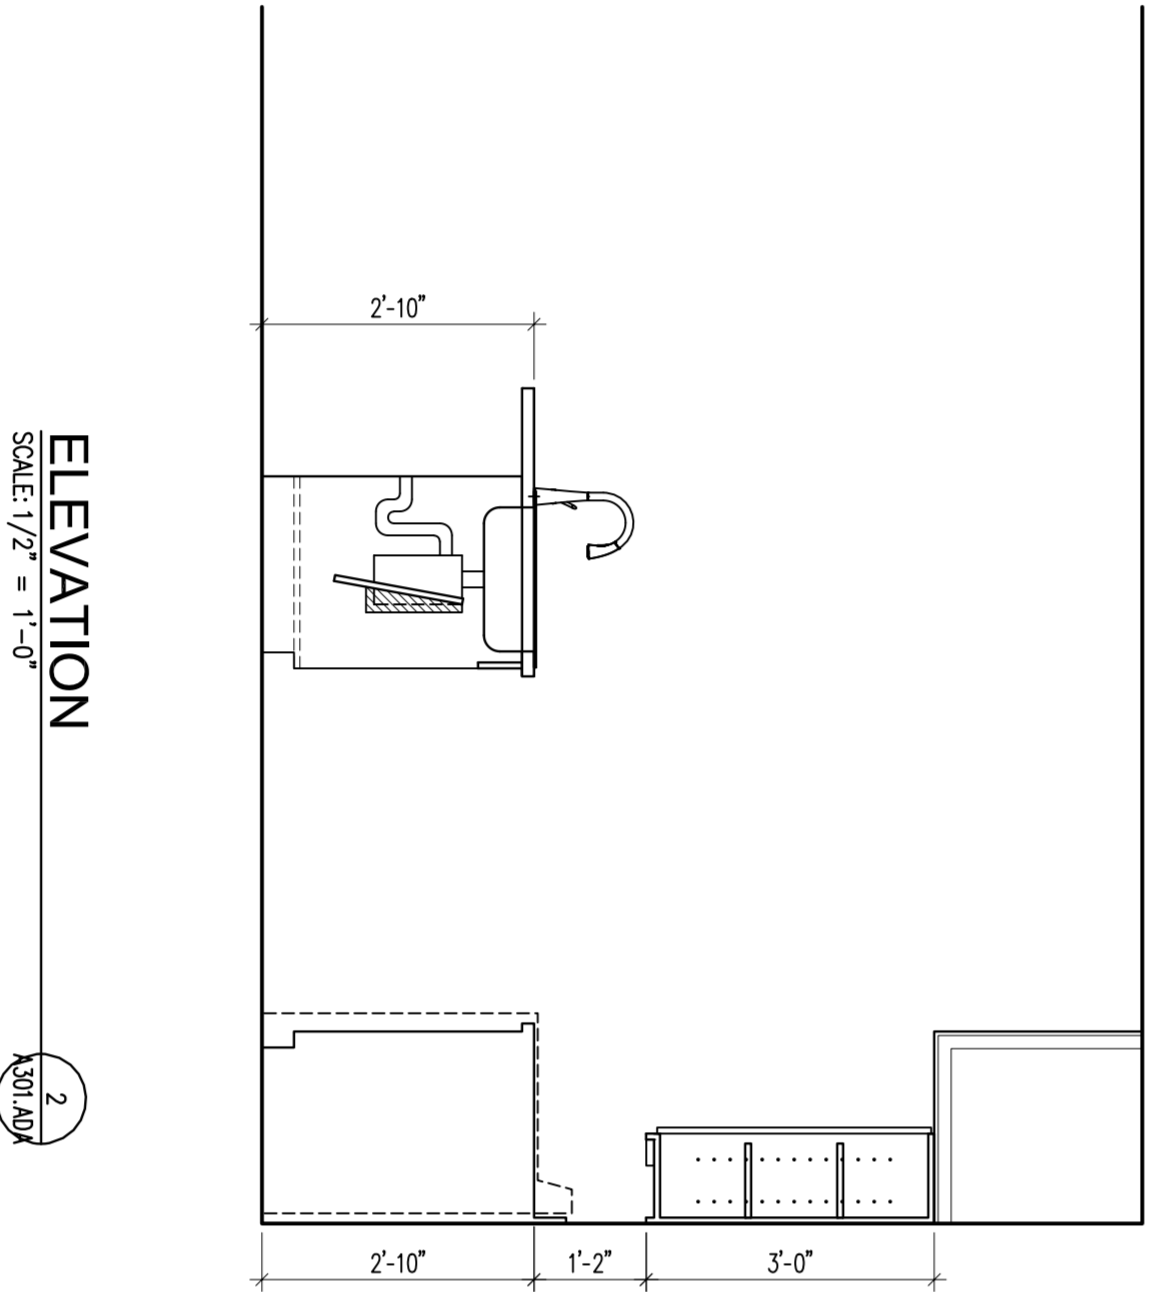


ELEVATION
 SCALE: 1/2" = 1'-0"


APARTMENT ROOM FINISH SCHEDULE						
ROOM NAME	FLOOR	BASE	WALLS			REMARKS
			NORTH	SOUTH	EAST	
LIVING AREA	VP-1	RB-3	PT-1	PT-1	PT-1	NOTES A
DINING AREA	VP-1	RB-3	PT-1	PT-1	PT-1	NOTES A
KITCHEN	VP-1	RB-3	PT-1	PT-1	PT-1	NOTES A
CLOSET	VP-1	RB-3	PT-1	PT-1	PT-1	NOTES A
BEDROOM	VP-1	RB-3	PT-1	PT-1	PT-1	NOTES A
BATHROOM	VP-1	RB-3	PT-1	PT-1	PT-1	NOTES A
LAUNDRY	VP-1	RB-3	PT-1	PT-1	PT-1	NOTES A
WALK-IN CLOSET	VP-1	RB-3	PT-1	PT-1	PT-1	NOTES A
BATHROOM	VP-1	RB-3	PT-1	PT-1	PT-1	NOTES A
FOYER / CORRIDOR	VP-1	RB-3	PT-1	PT-1	PT-1	NOTES A

NOTES:
 A. ALL TRIM, CASINGS, DOORS, ETC ARE TO BE PAINTED COLOR & SHEEN TBD.


APARTMENT DOOR SCHEDULE										
DOOR MARK	DOOR LOCATION	DOOR INFORMATION			FRAME INFORMATION			HDW. SET	FIRE RATING	REMARKS
		SIZE	THICK	STYLE	DOOR MATERIAL	TYPE	FRAME MATERIAL			
D BR	BEDROOM	3'-0"	1 3/8"	2	OK	A	WD 5/6000	6/6000	2	PRE-FINISH STAINED
D BH	BEDROOM	3'-0"	1 3/8"	2	OK	A	WD 5/6000	6/6000	2	PRE-FINISH STAINED
D C	CLOSET	2'-4"	1 3/8"	2	OK	A	WD 5/6000	6/6000	3	PRE-FINISH STAINED
D L	LAUNDRY	2'-4"	1 3/8"	2	OK	A	WD 5/6000	6/6000	4	PRE-FINISH STAINED

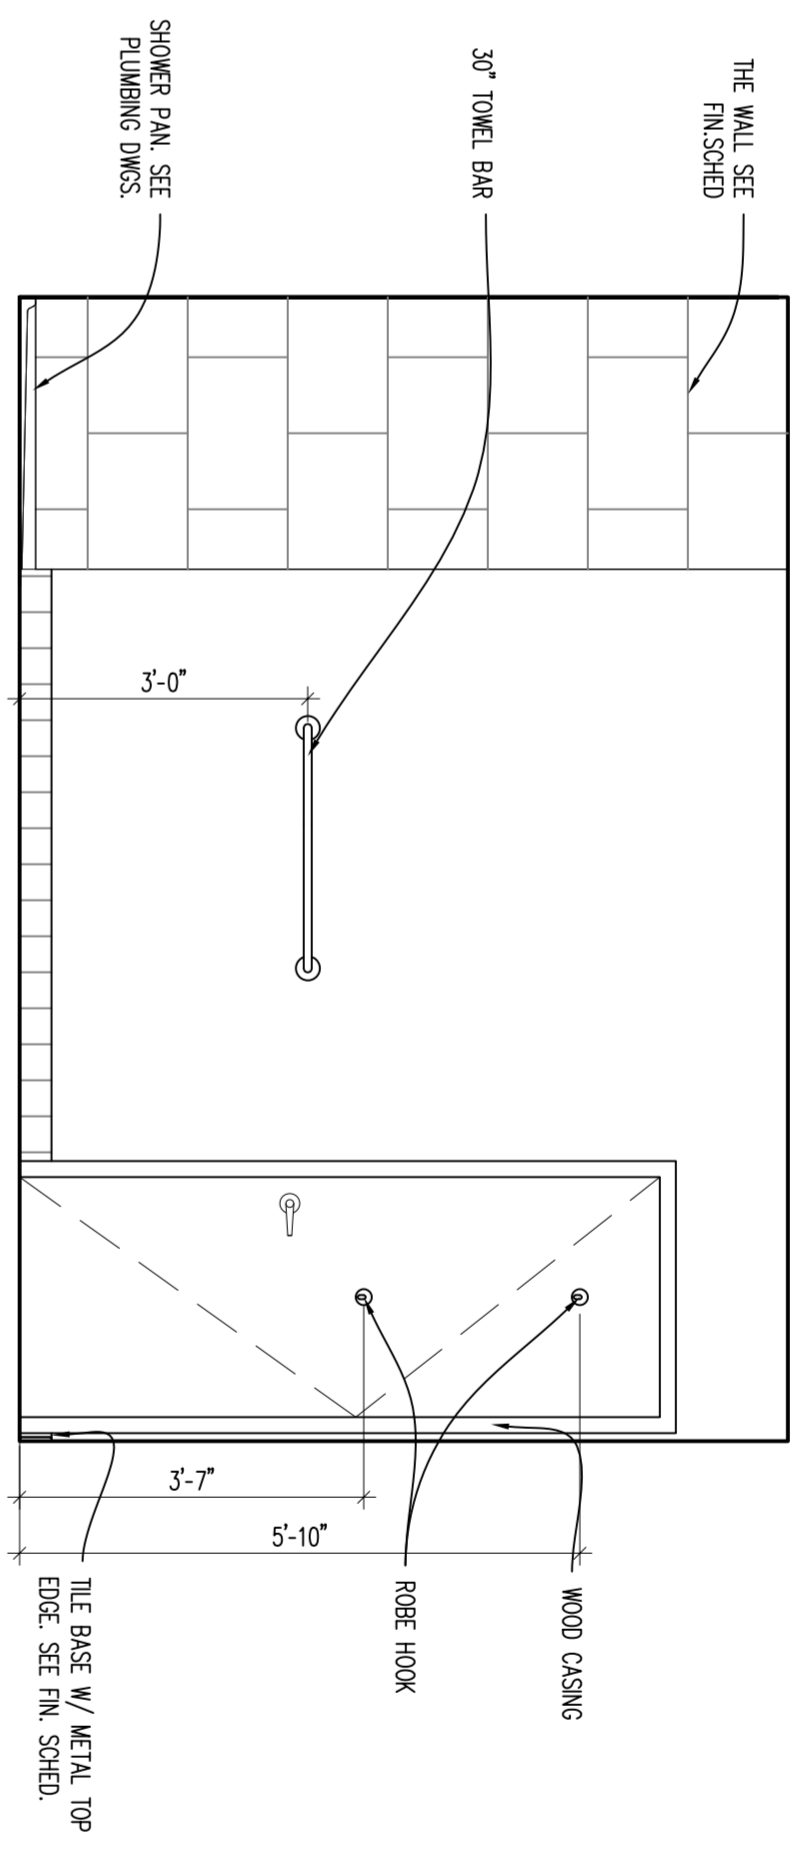


ELEVATION
 SCALE: 1/2" = 1'-0"

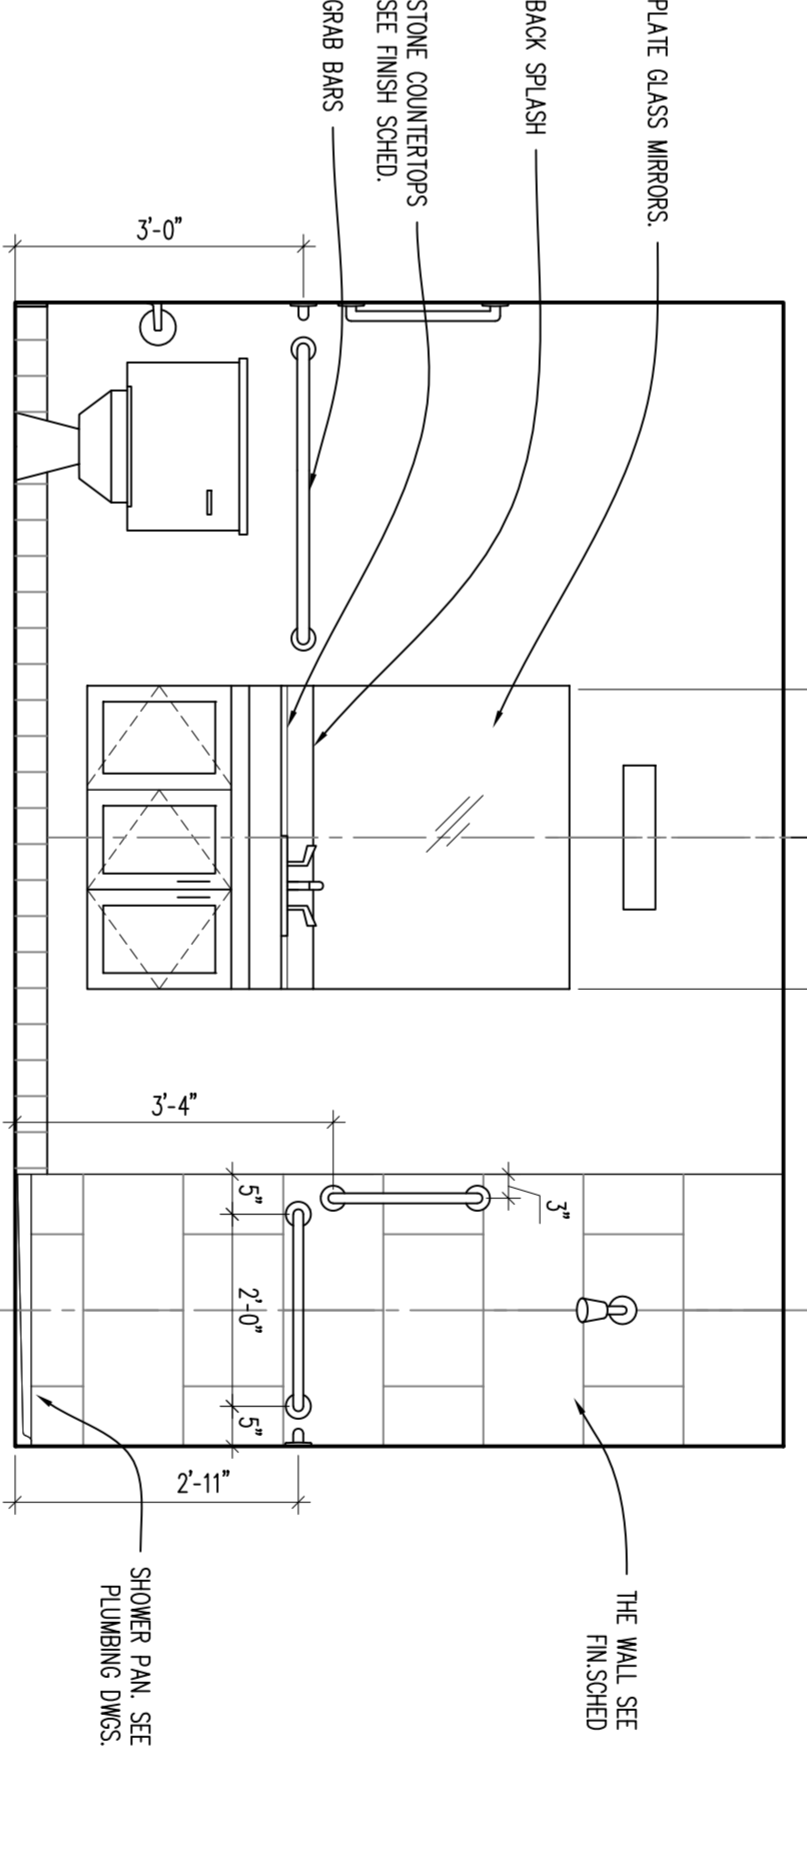


ELEVATION
 SCALE: 1/2" = 1'-0"

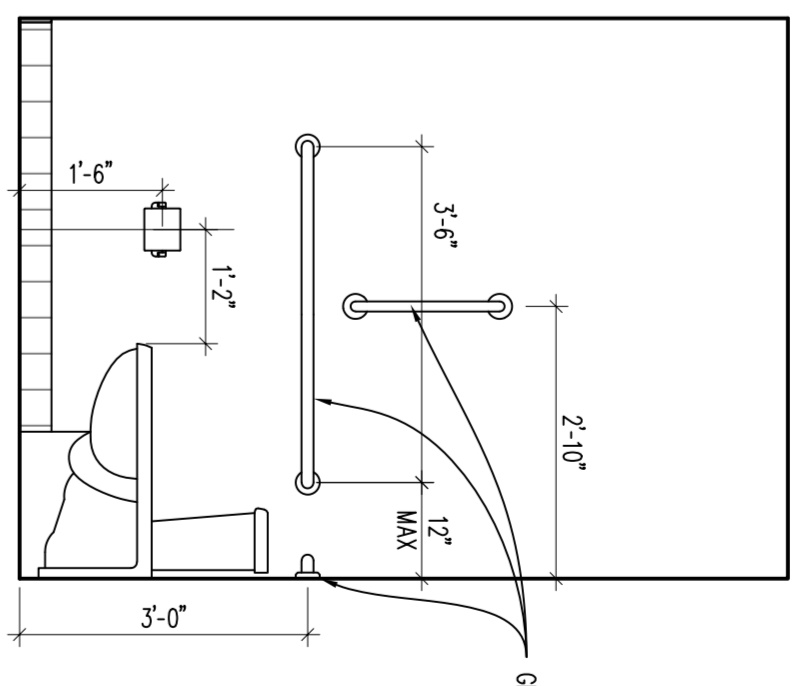

ELEVATION
 SCALE: 1/2" = 1'-0"

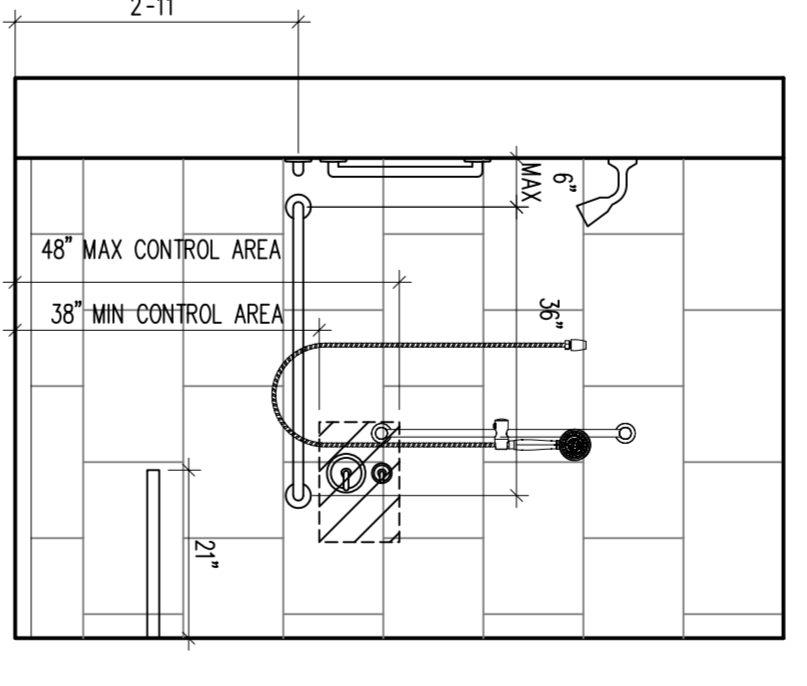

ELEVATION
 SCALE: 1/2" = 1'-0"

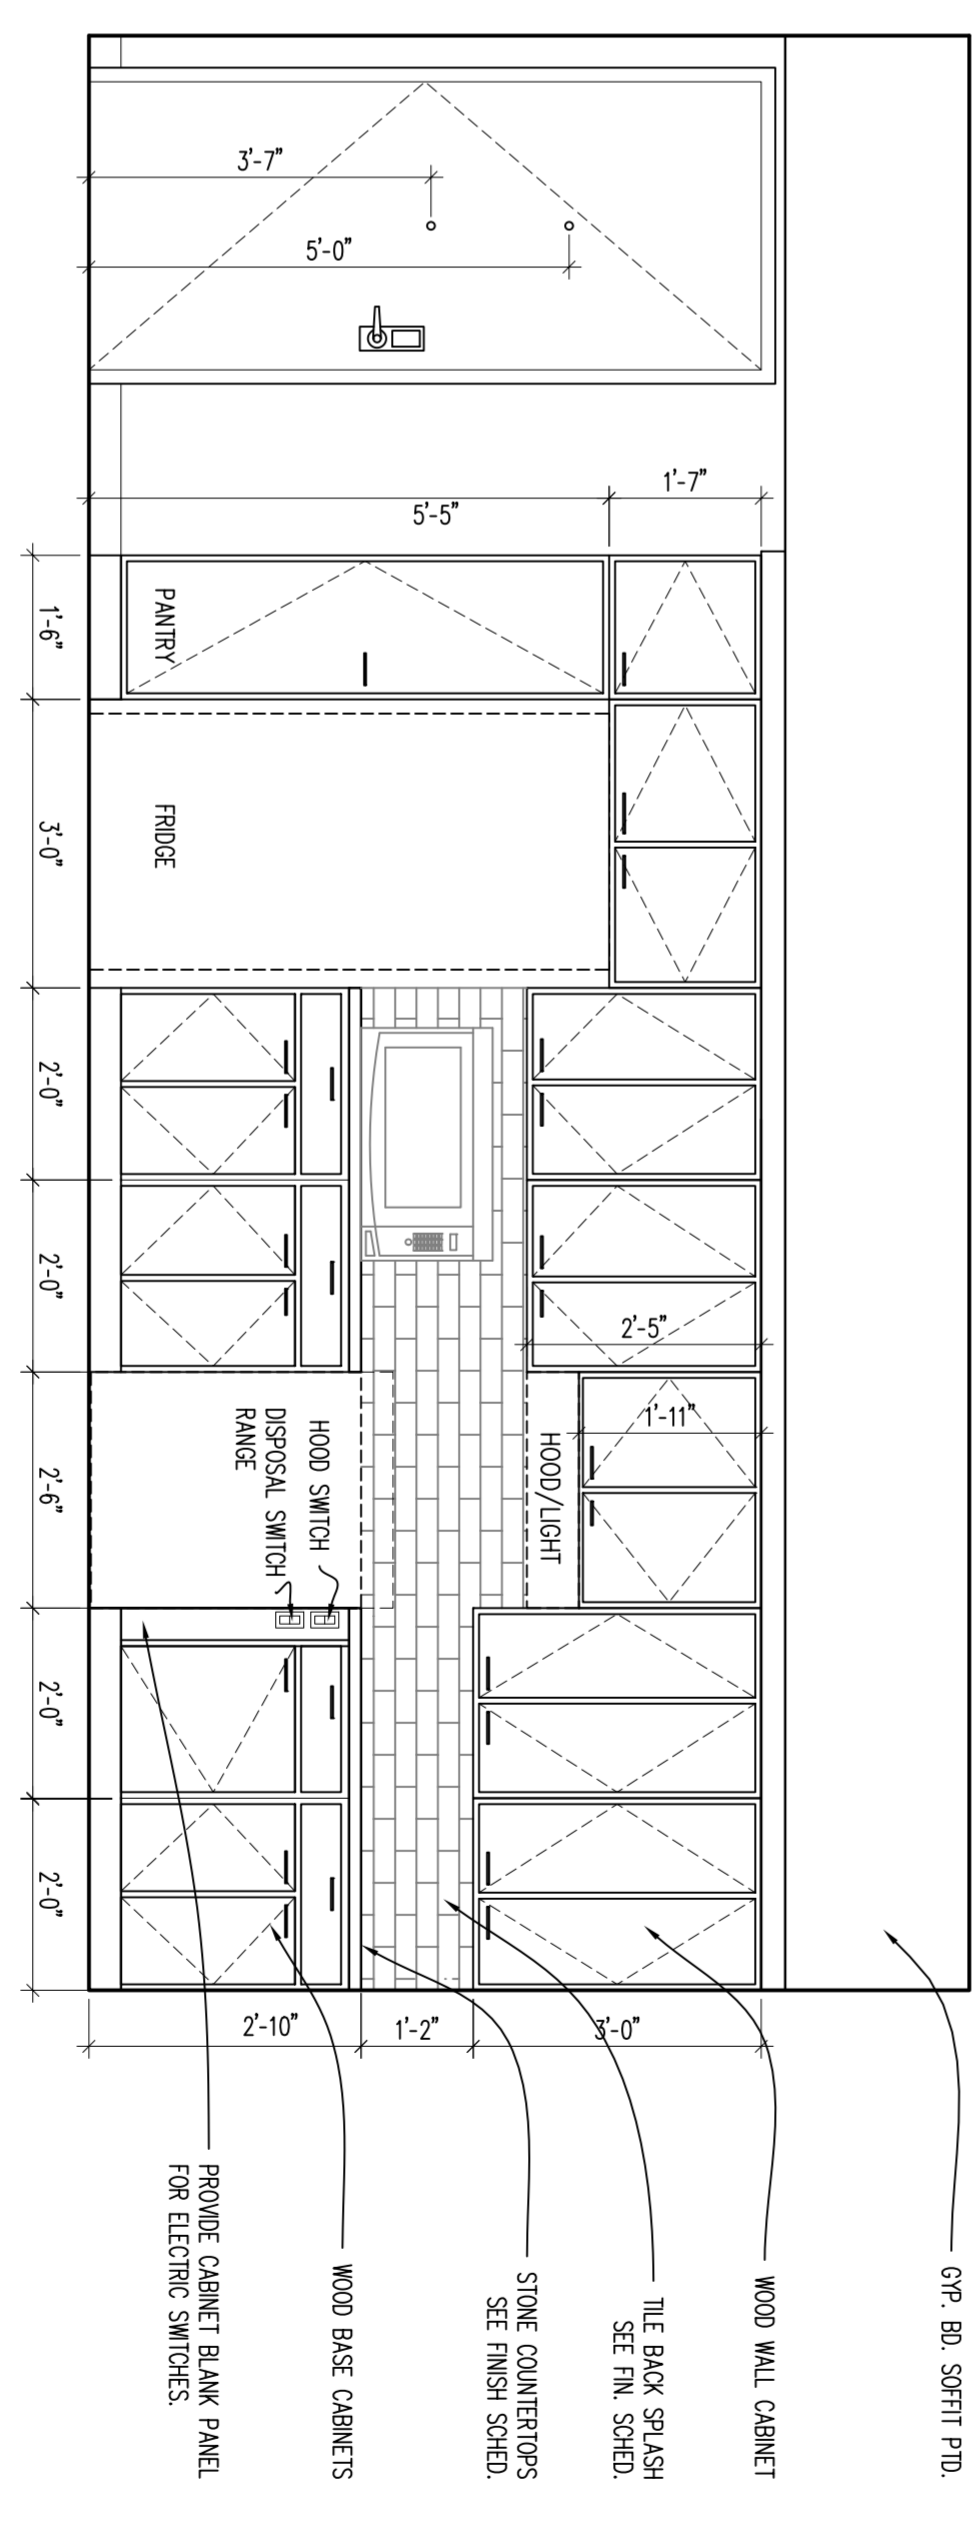

ELEVATION
 SCALE: 1/2" = 1'-0"

- GENERAL APARTMENT NOTES**
- DOOR FRAME SHALL BE 4" FROM FACE OF WALL TO BACKSIDE OF FRAME UNLESS NOTED OTHERWISE.
 - DIMENSIONS ARE FROM FINISH FACE OF WALL TO FINISH FACE OF WALL UNLESS NOTED OTHERWISE.
 - FACE OF WALL UNLESS NOTED OTHERWISE.
 - ALL LIGHTING FOR REFERENCE ONLY.
 - ALL CABINET DRAWINGS ARE FOR DESIGN INTENT ONLY. ALL VISIBLE SIZES OF CABINETS ARE TO RECEIVE A REVISION BASED ON DESIGN INTENT ONLY.
 - INCLUDES CABINETS THAT ARE UP AGAINST THE INDUSTRY AND/OR FACING THE WINDOWS, TOP OF ALL ENERGY STAR APPLIANCES (REFRIGERATORS, DISHWASHERS, RANGE) SHALL BE NEW.
 - PROVIDE REWORKING FOR FUTURE OVEN BARS IN ALL UNIT ALL PAINTRY AND LINEN CLOSETS TO RECEIVE ONE (1) ADJUSTABLE MEGALINE SHELVES.
 - ADJUSTABLE MEGALINE SHELVES.
 - COMBINATION LOCK SHALL BE PROVIDED ON EACH SHOWER DOOR.
 - PROVIDE AND INSTALL IN EACH APARTMENT (2) TOILET BARS, (1) TOILET PAPER HOLDER, (1) ROBE HOOK.

Project: Formica Building
 115 E 5th Street
 Cincinnati, Ohio 45202
 Unit: B ADA
 Construction
 Project No: 2022_259
 Issue Date: _____
 Scale: _____
 Drawn: _____
 Checked: _____

Revisions: _____
 Date: 11.14.2022
 ENG CHG #1

A301 ADA

Formica Building

Office/Apartments


Auditor Address: 115 E. 5th Street, Actual Address: 120 E. 4th Street
 Cincinnati OH 45202

modelgroup
 DEVELOPMENT • CONSTRUCTION • MANAGEMENT


1826 Race Street
 Cincinnati, Ohio 45202
 513.559.0048

STATE OF OHIO
JOSEPH A. BODKIN
 318367
 REGISTERED ARCHITECT





Joseph A. Bodkin, License #313367
 Expiration Date: 12-31-2023

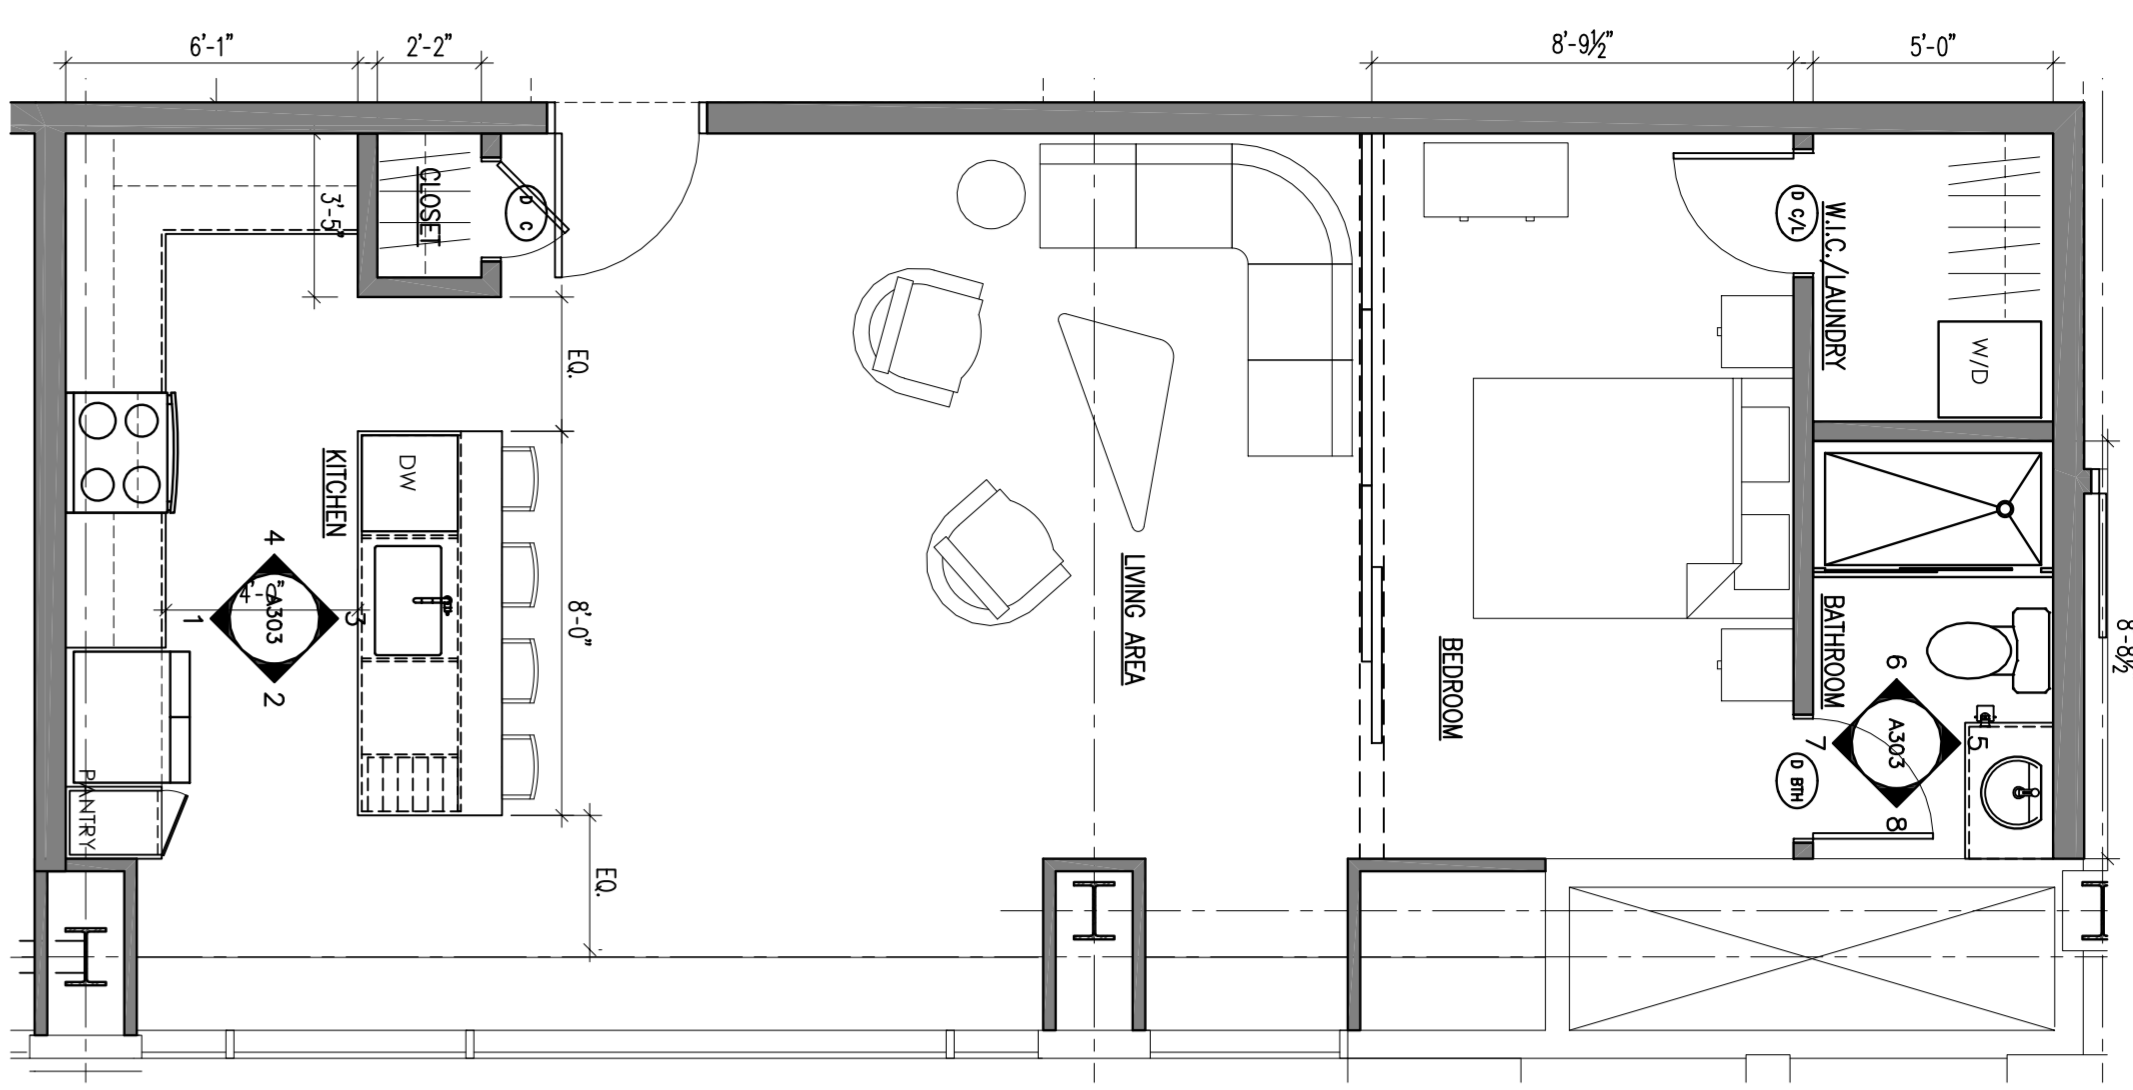



APARTMENT FLOOR PLAN
 SCALE: 1/4" = 1'-0"

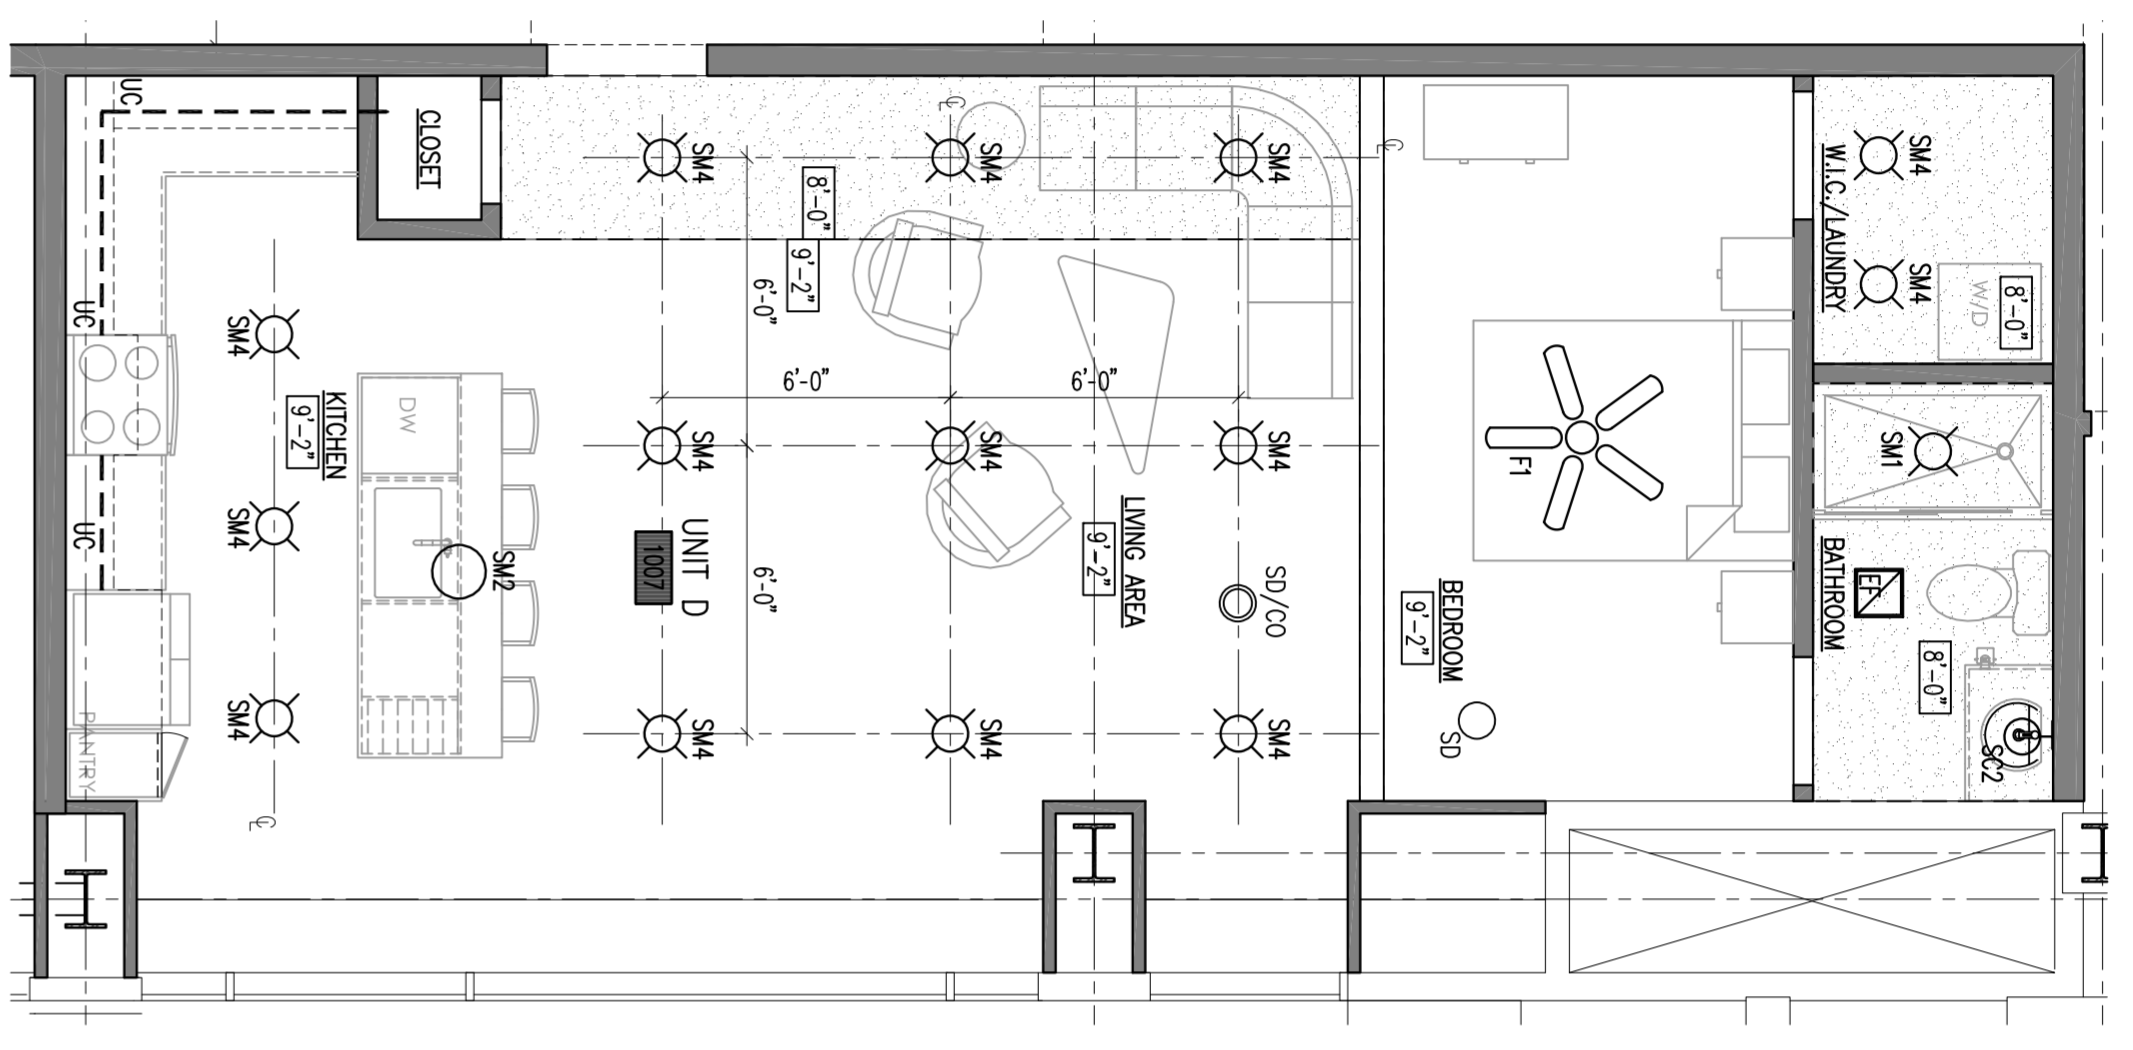



APARTMENT REFLECTED CEILING PLAN
 SCALE: 1/4" = 1'-0"

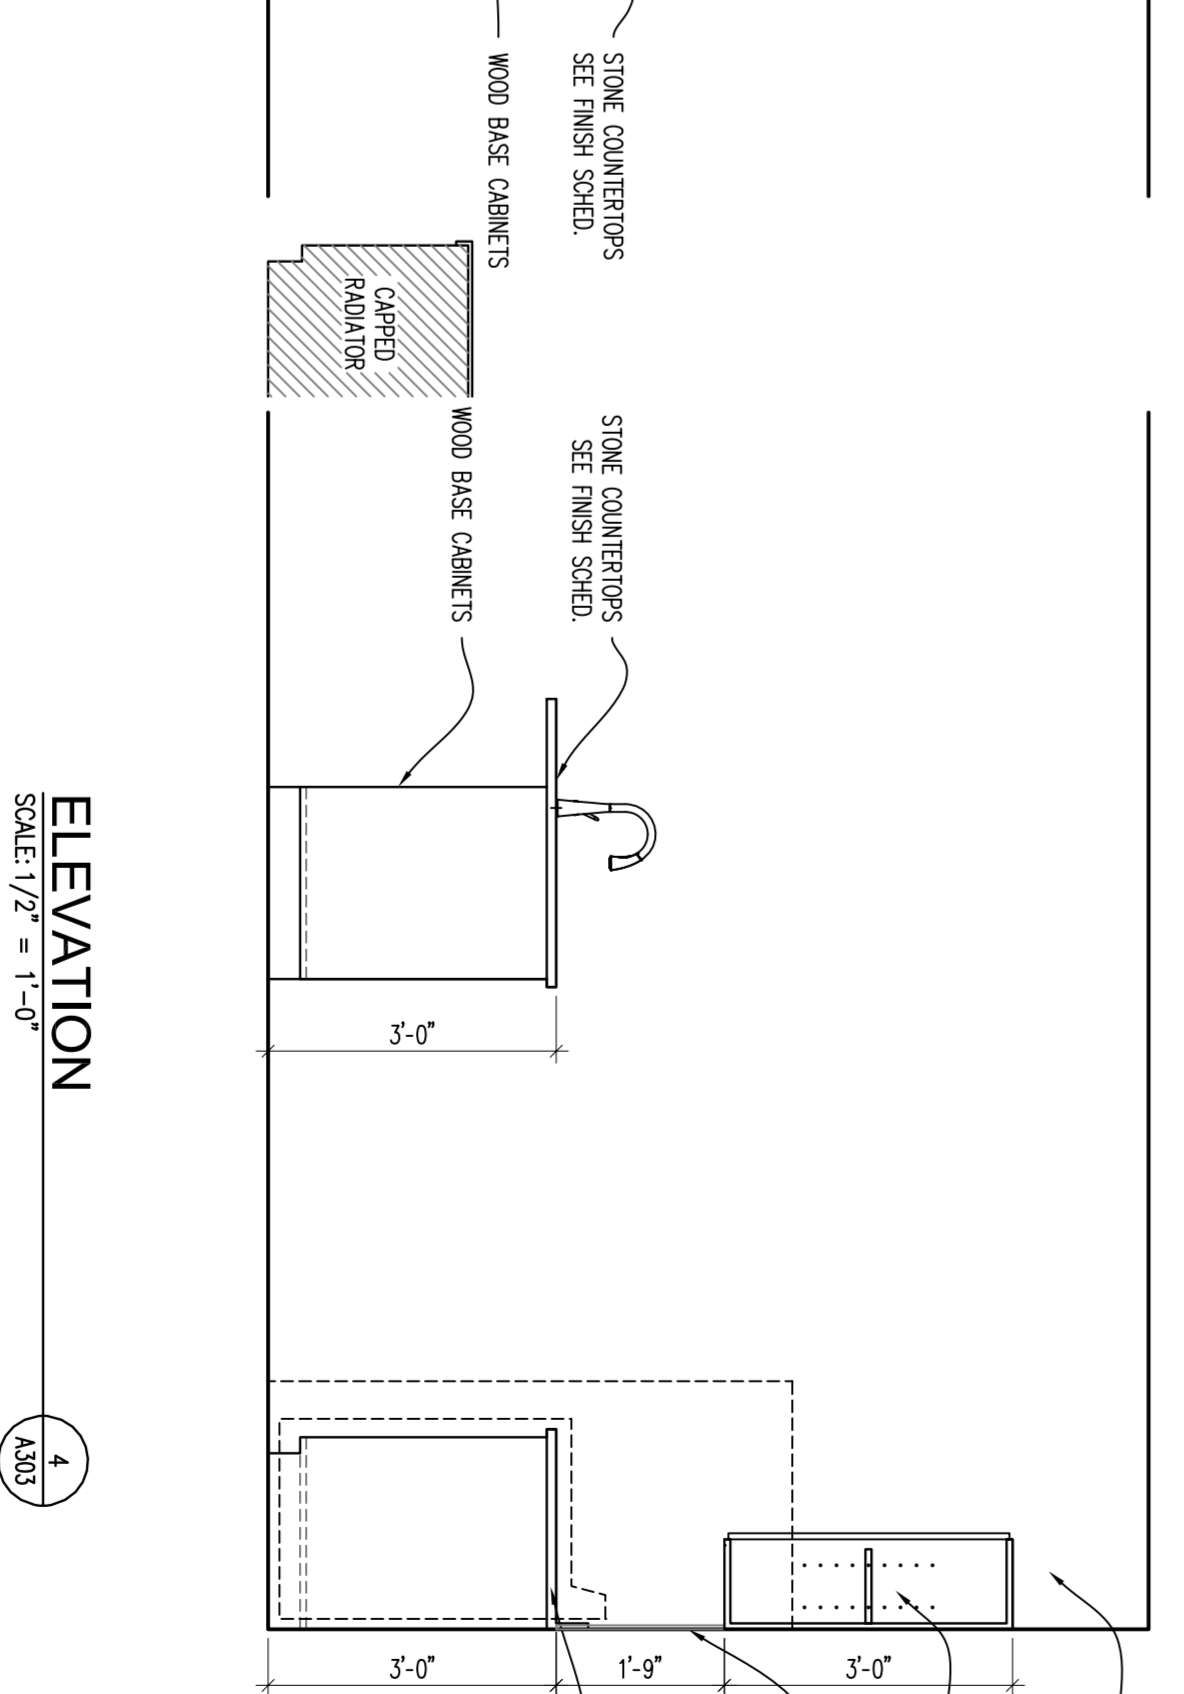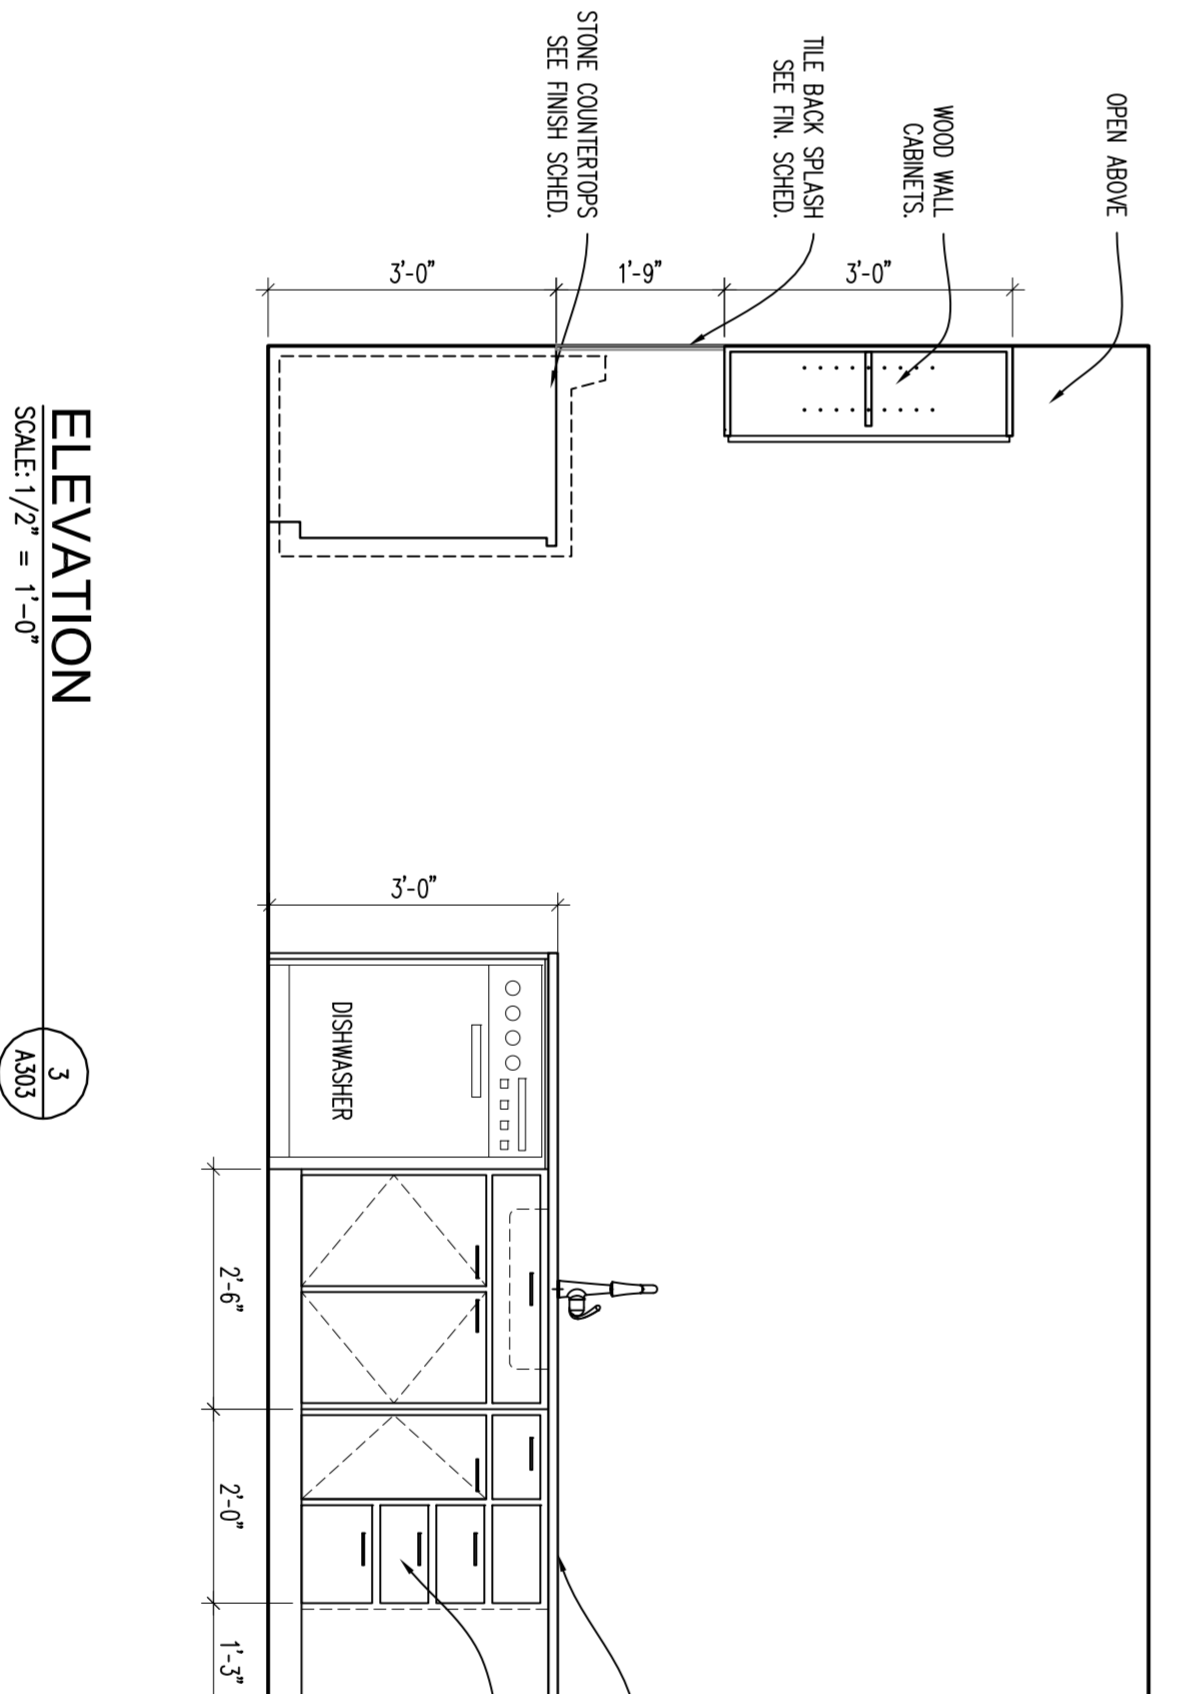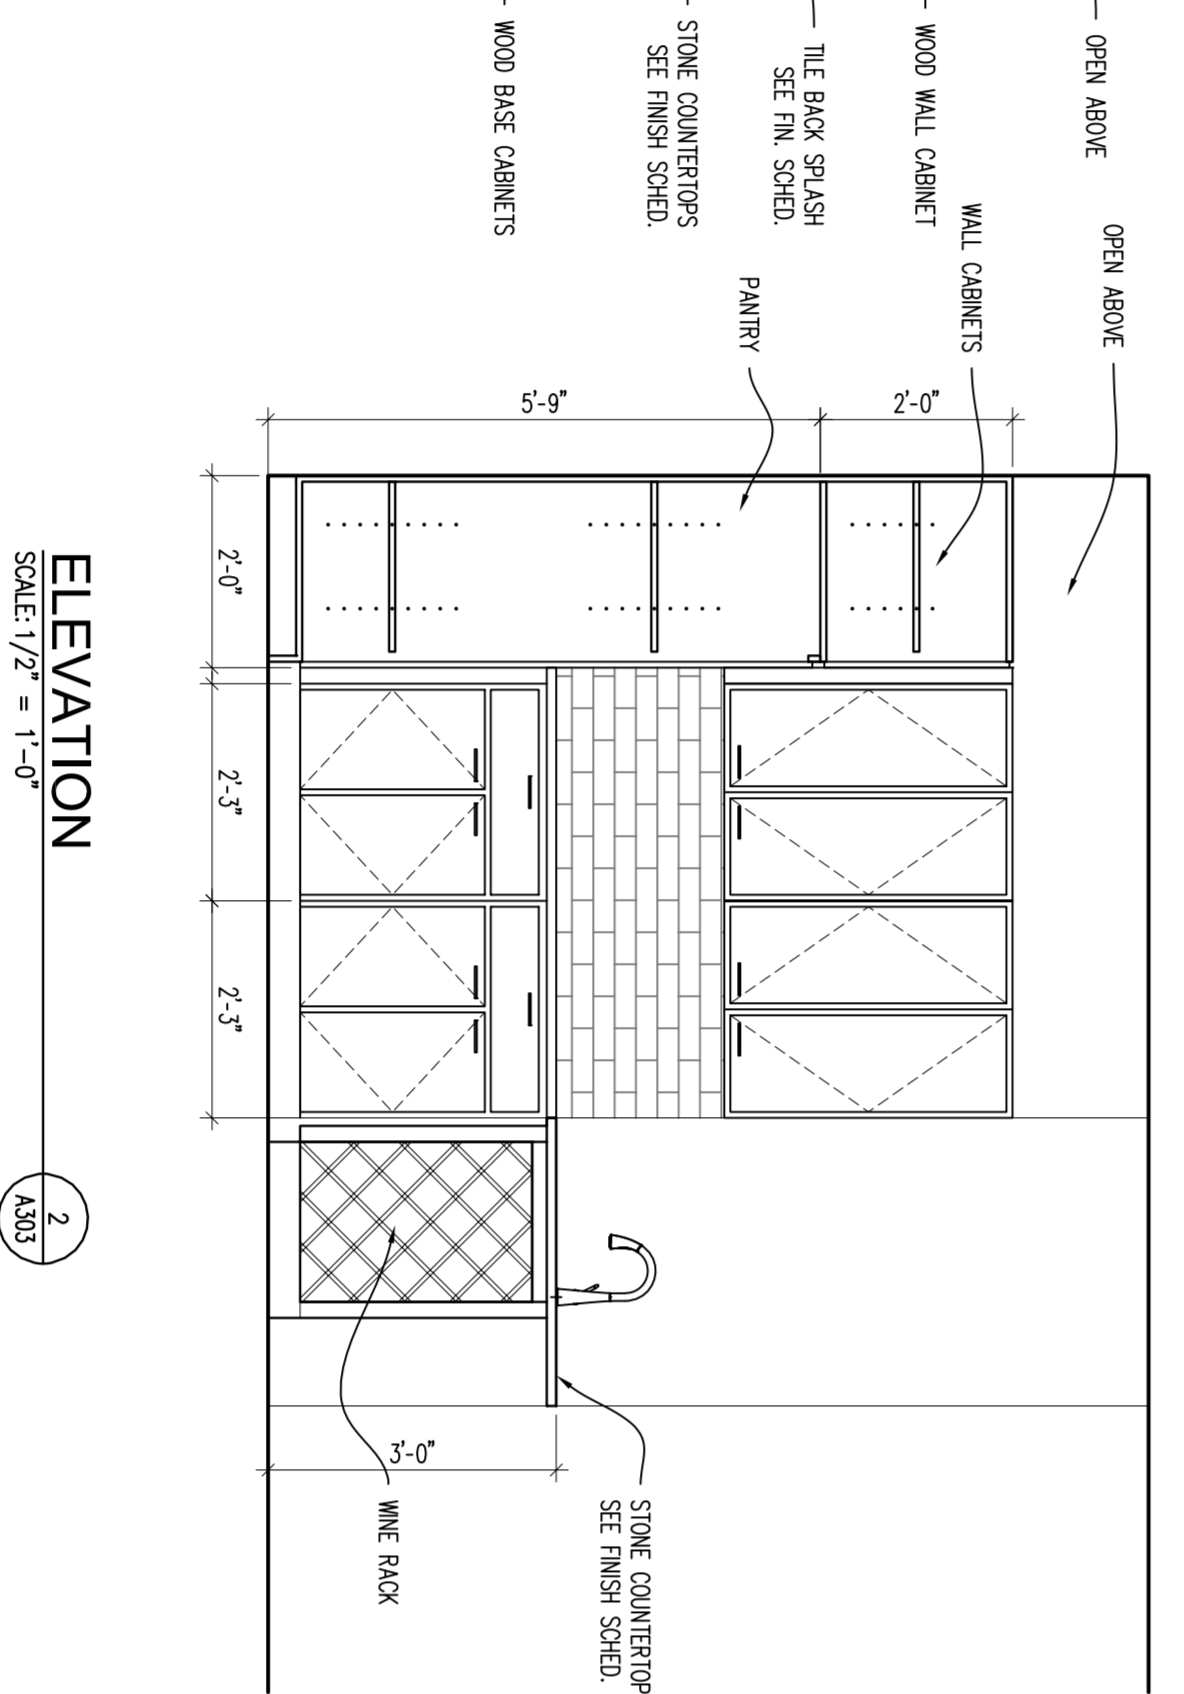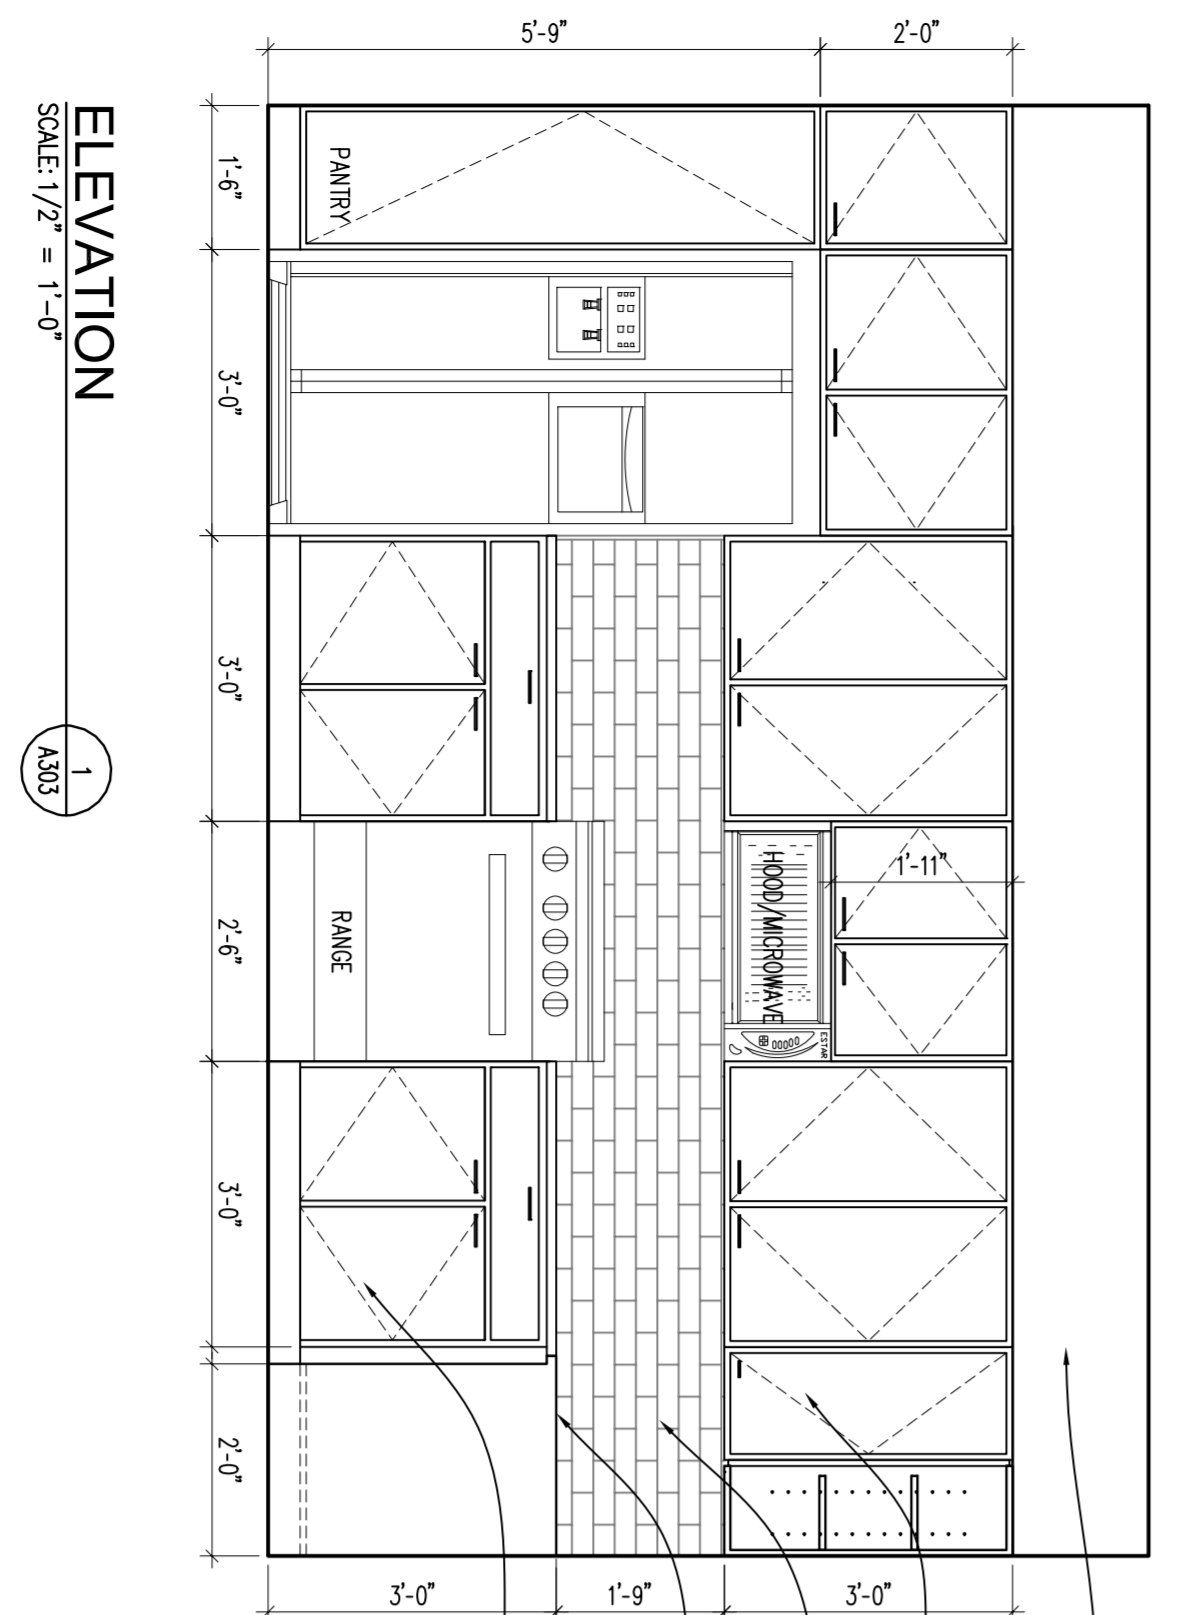

ELEVATION
 SCALE: 1/2" = 1'-0"

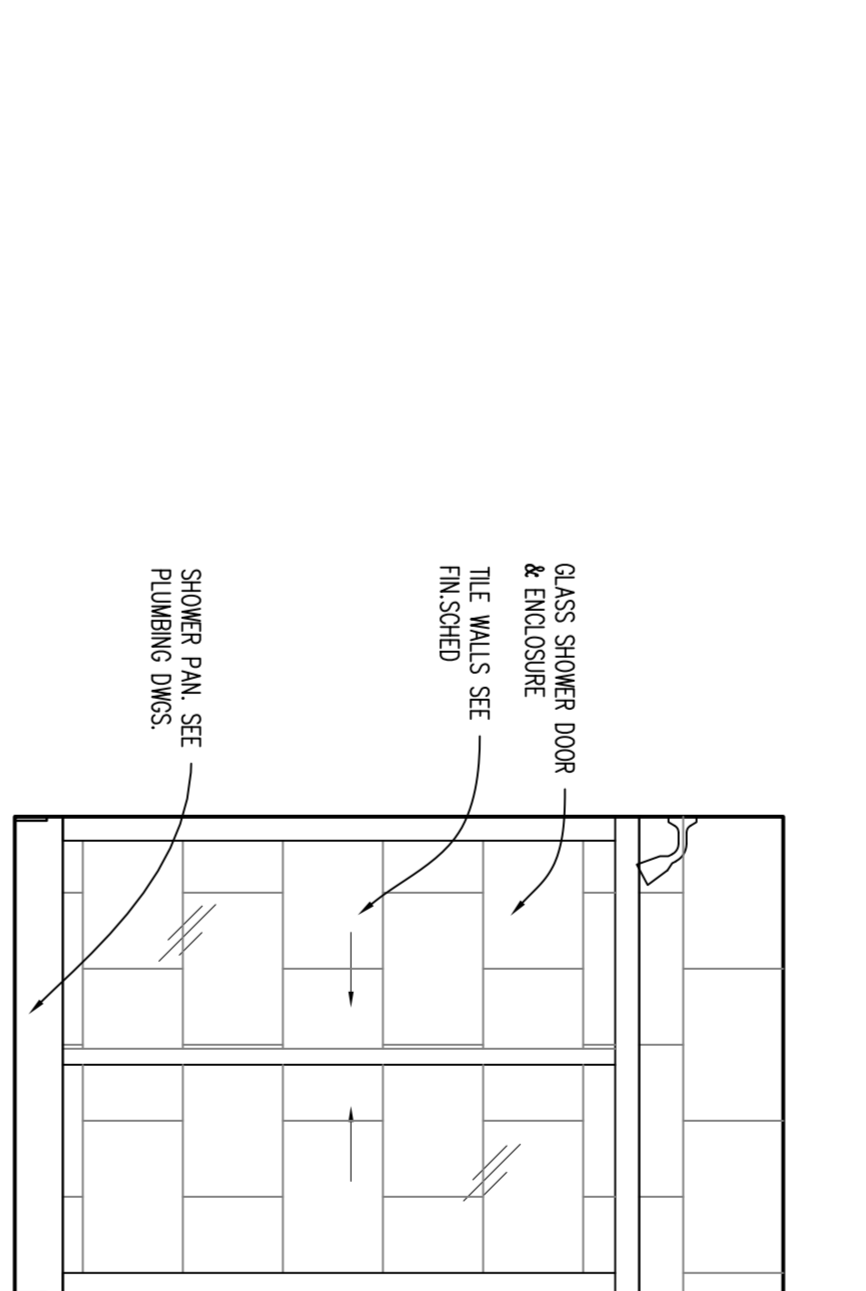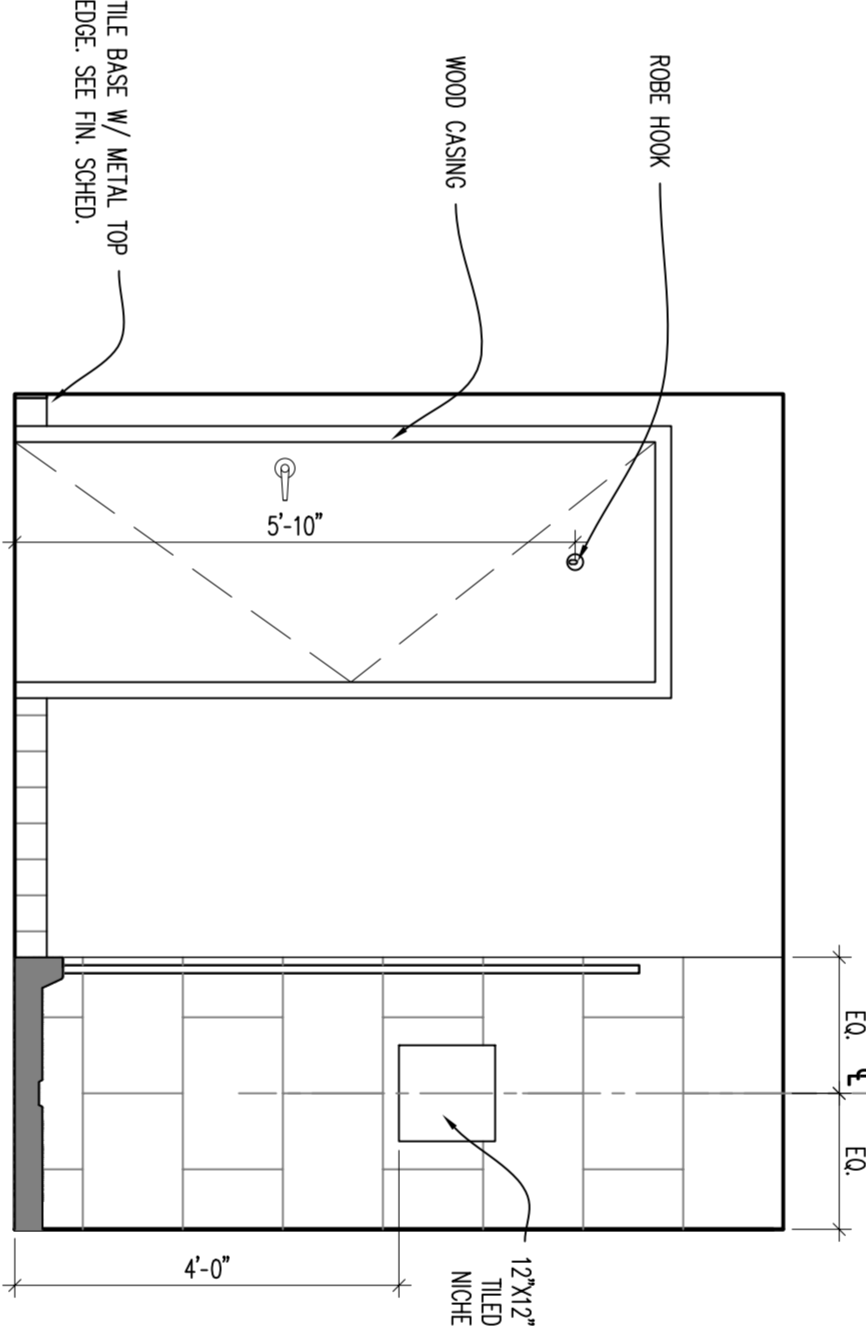

ELEVATION
 SCALE: 1/2" = 1'-0"

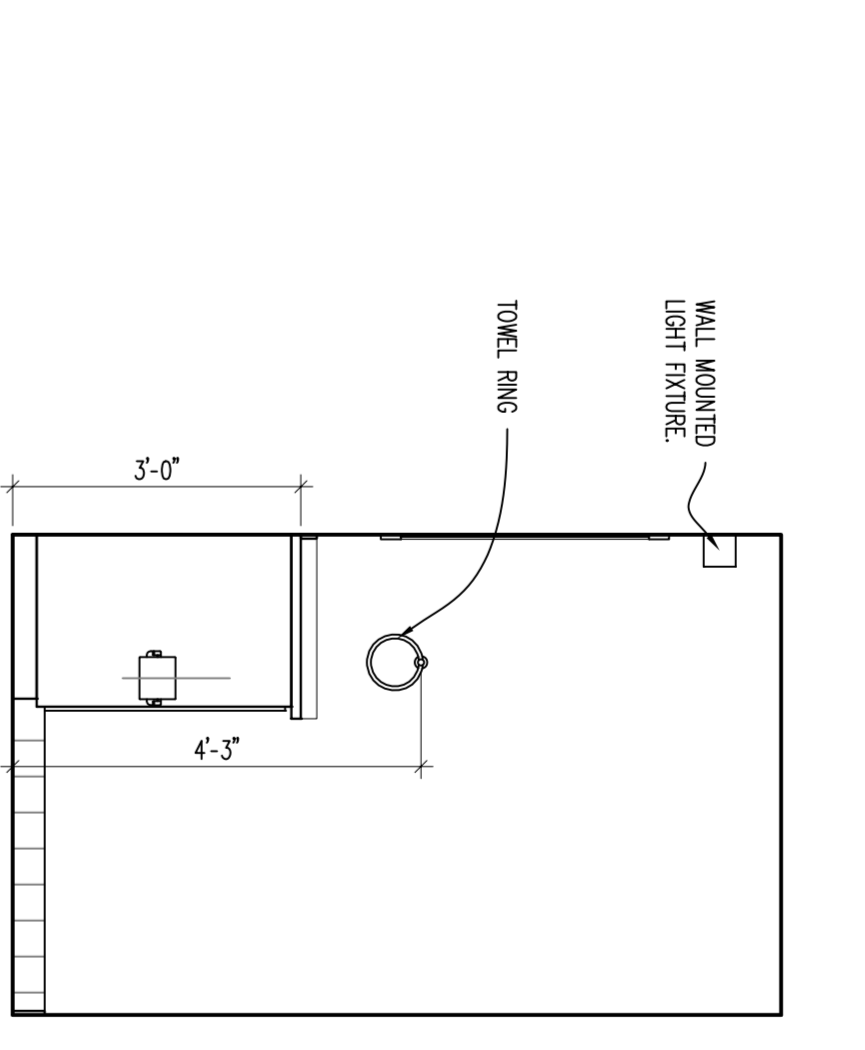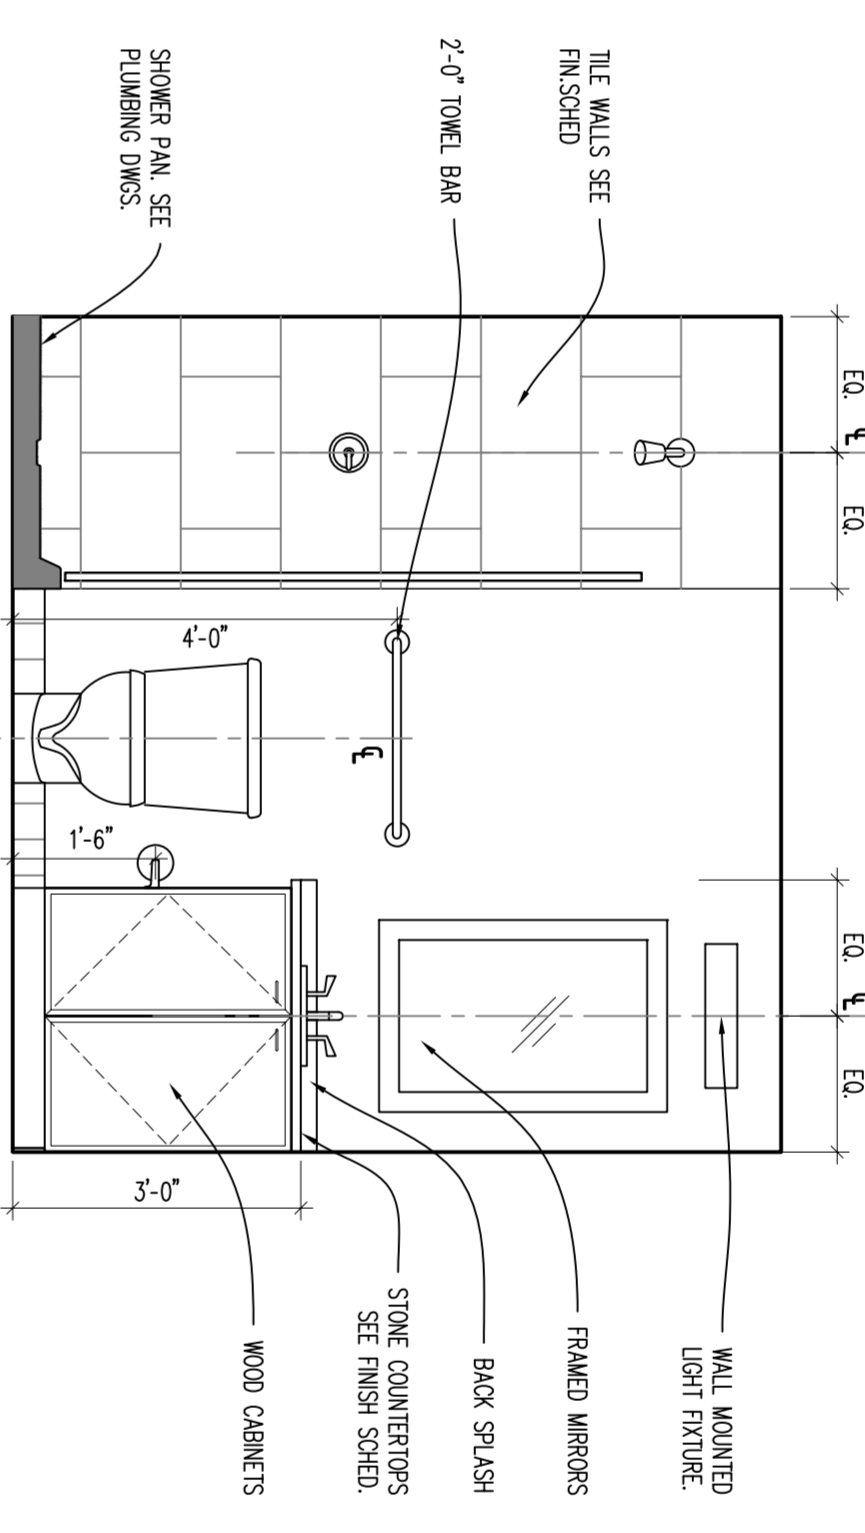

ELEVATION
 SCALE: 1/2" = 1'-0"

APARTMENT ROOM FINISH SCHEDULE

ROOM NAME	FLOOR	WALLS				CEILING	REMARKS	REV. NO.
		NORTH	SOUTH	EAST	WEST			
LIVING AREA	VP-1	RB-3	PT-1	PT-1	PT-1	PT-3	NOTES A	
KITCHEN	VP-1	RB-3	PT-1	PT-1	PT-1	PT-3	NOTES A	
DINING AREA	VP-1	RB-3	PT-1	PT-1	PT-1	PT-3	NOTES A	
BEDROOM	VP-1	RB-3	PT-1	PT-1	PT-1	PT-3	NOTES A	
BATHROOM	VP-1	RB-3	PT-1	PT-1	PT-1	PT-3	NOTES A	
CLOSET / LAUNDRY	VP-1	RB-3	PT-1	PT-1	PT-1	PT-3	NOTES A	

APARTMENT DOOR SCHEDULE

DOOR MARK	DOOR LOCATION	DOOR INFORMATION			FRAME INFORMATION			HW. SET	FIRE RATING	REMARKS
		WIDTH	HEIGHT	THICK STYLE	DOOR MATERIAL	TYPE	FRAME MATERIAL			
D BH	BATHROOM	2'-8"	6'-8"	1 3/8"	OAK	A	WD	5/6800	6/6800	PRE-FINISH STAINED
D C	CLOSET	2'-0"	6'-8"	1 3/8"	OAK	A	WD	5/6800	6/6800	PRE-FINISH STAINED
D C/L	CLOSET / LAUNDRY	2'-6"	6'-8"	1 3/8"	OAK	A	WD	5/6800	6/6800	PRE-FINISH STAINED

- GENERAL APARTMENT NOTES
- DOOR FRAME SHALL BE 4" FROM FACE OF WALL TO BACKSIDE OF FRAME (UNLESS NOTED OTHERWISE).
 - DOOR DIMENSIONS ARE FROM FINISH FACE OF WALL TO FINISH FACE OF WALL UNLESS NOTED OTHERWISE.
 - ALL LIGHTING FIXTURES SHALL BE REFERENCED TO FINISH FLOOR.
 - ALL CABINET DRAWINGS ARE FOR DESIGN INTENT ONLY. ALL CABINET DRAWINGS ARE TO RECEIVE A FINISH GRADE. FINISH GRADE SHALL BE DETERMINED BY THE ARCHITECT. FINISH GRADE SHALL BE NOTED ON ALL DRAWINGS.
 - ALL VISIBLE PARTS OF CABINETS ARE TO RECEIVE A FINISH GRADE. FINISH GRADE SHALL BE DETERMINED BY THE ARCHITECT. FINISH GRADE SHALL BE NOTED ON ALL DRAWINGS.
 - ENERGY STAR APPLIANCES SHALL BE PROVIDED FOR ALL APPLIANCES UNLESS NOTED OTHERWISE.
 - PROVIDE REWORKING FOR FUTURE CABINETS TO RECEIVE FINISH GRADE.
 - ADJUSTABLE MESH SHELVES SHALL BE PROVIDED FOR ALL LINEN CLOSETS TO RECEIVE FINISH GRADE.
 - ADJUSTABLE MESH SHELVES SHALL BE PROVIDED FOR ALL LINEN CLOSETS TO RECEIVE FINISH GRADE.
A303

Project: Formica Building
 115 E 5th Street
 Cincinnati, Ohio 45202

Sheet Title: Unit D Construction
 Project No: 2022_259
 Issue Date: 11.14.2022

Scale: As Shown
 Drawn: []
 Checked: []

Revisions:
 No. 1: ENG CHG #1
 Date: 11.14.2022


Formica Building
 Office/Apartments
 Auditor Address: 115 E. 5th Street, Actual Address: 120 E. 4th Street
 Cincinnati OH 45202

modelgroup
 DEVELOPMENT • CONSTRUCTION • MANAGEMENT


1826 Race Street
 Cincinnati, Ohio 45202
 513.559.0048

STATE OF OHIO
JOSEPH A. BODKIN
 318367
 REGISTERED ARCHITECT


Joseph A. Bodkin, License #313367
 Expiration Date: 12-31-2023

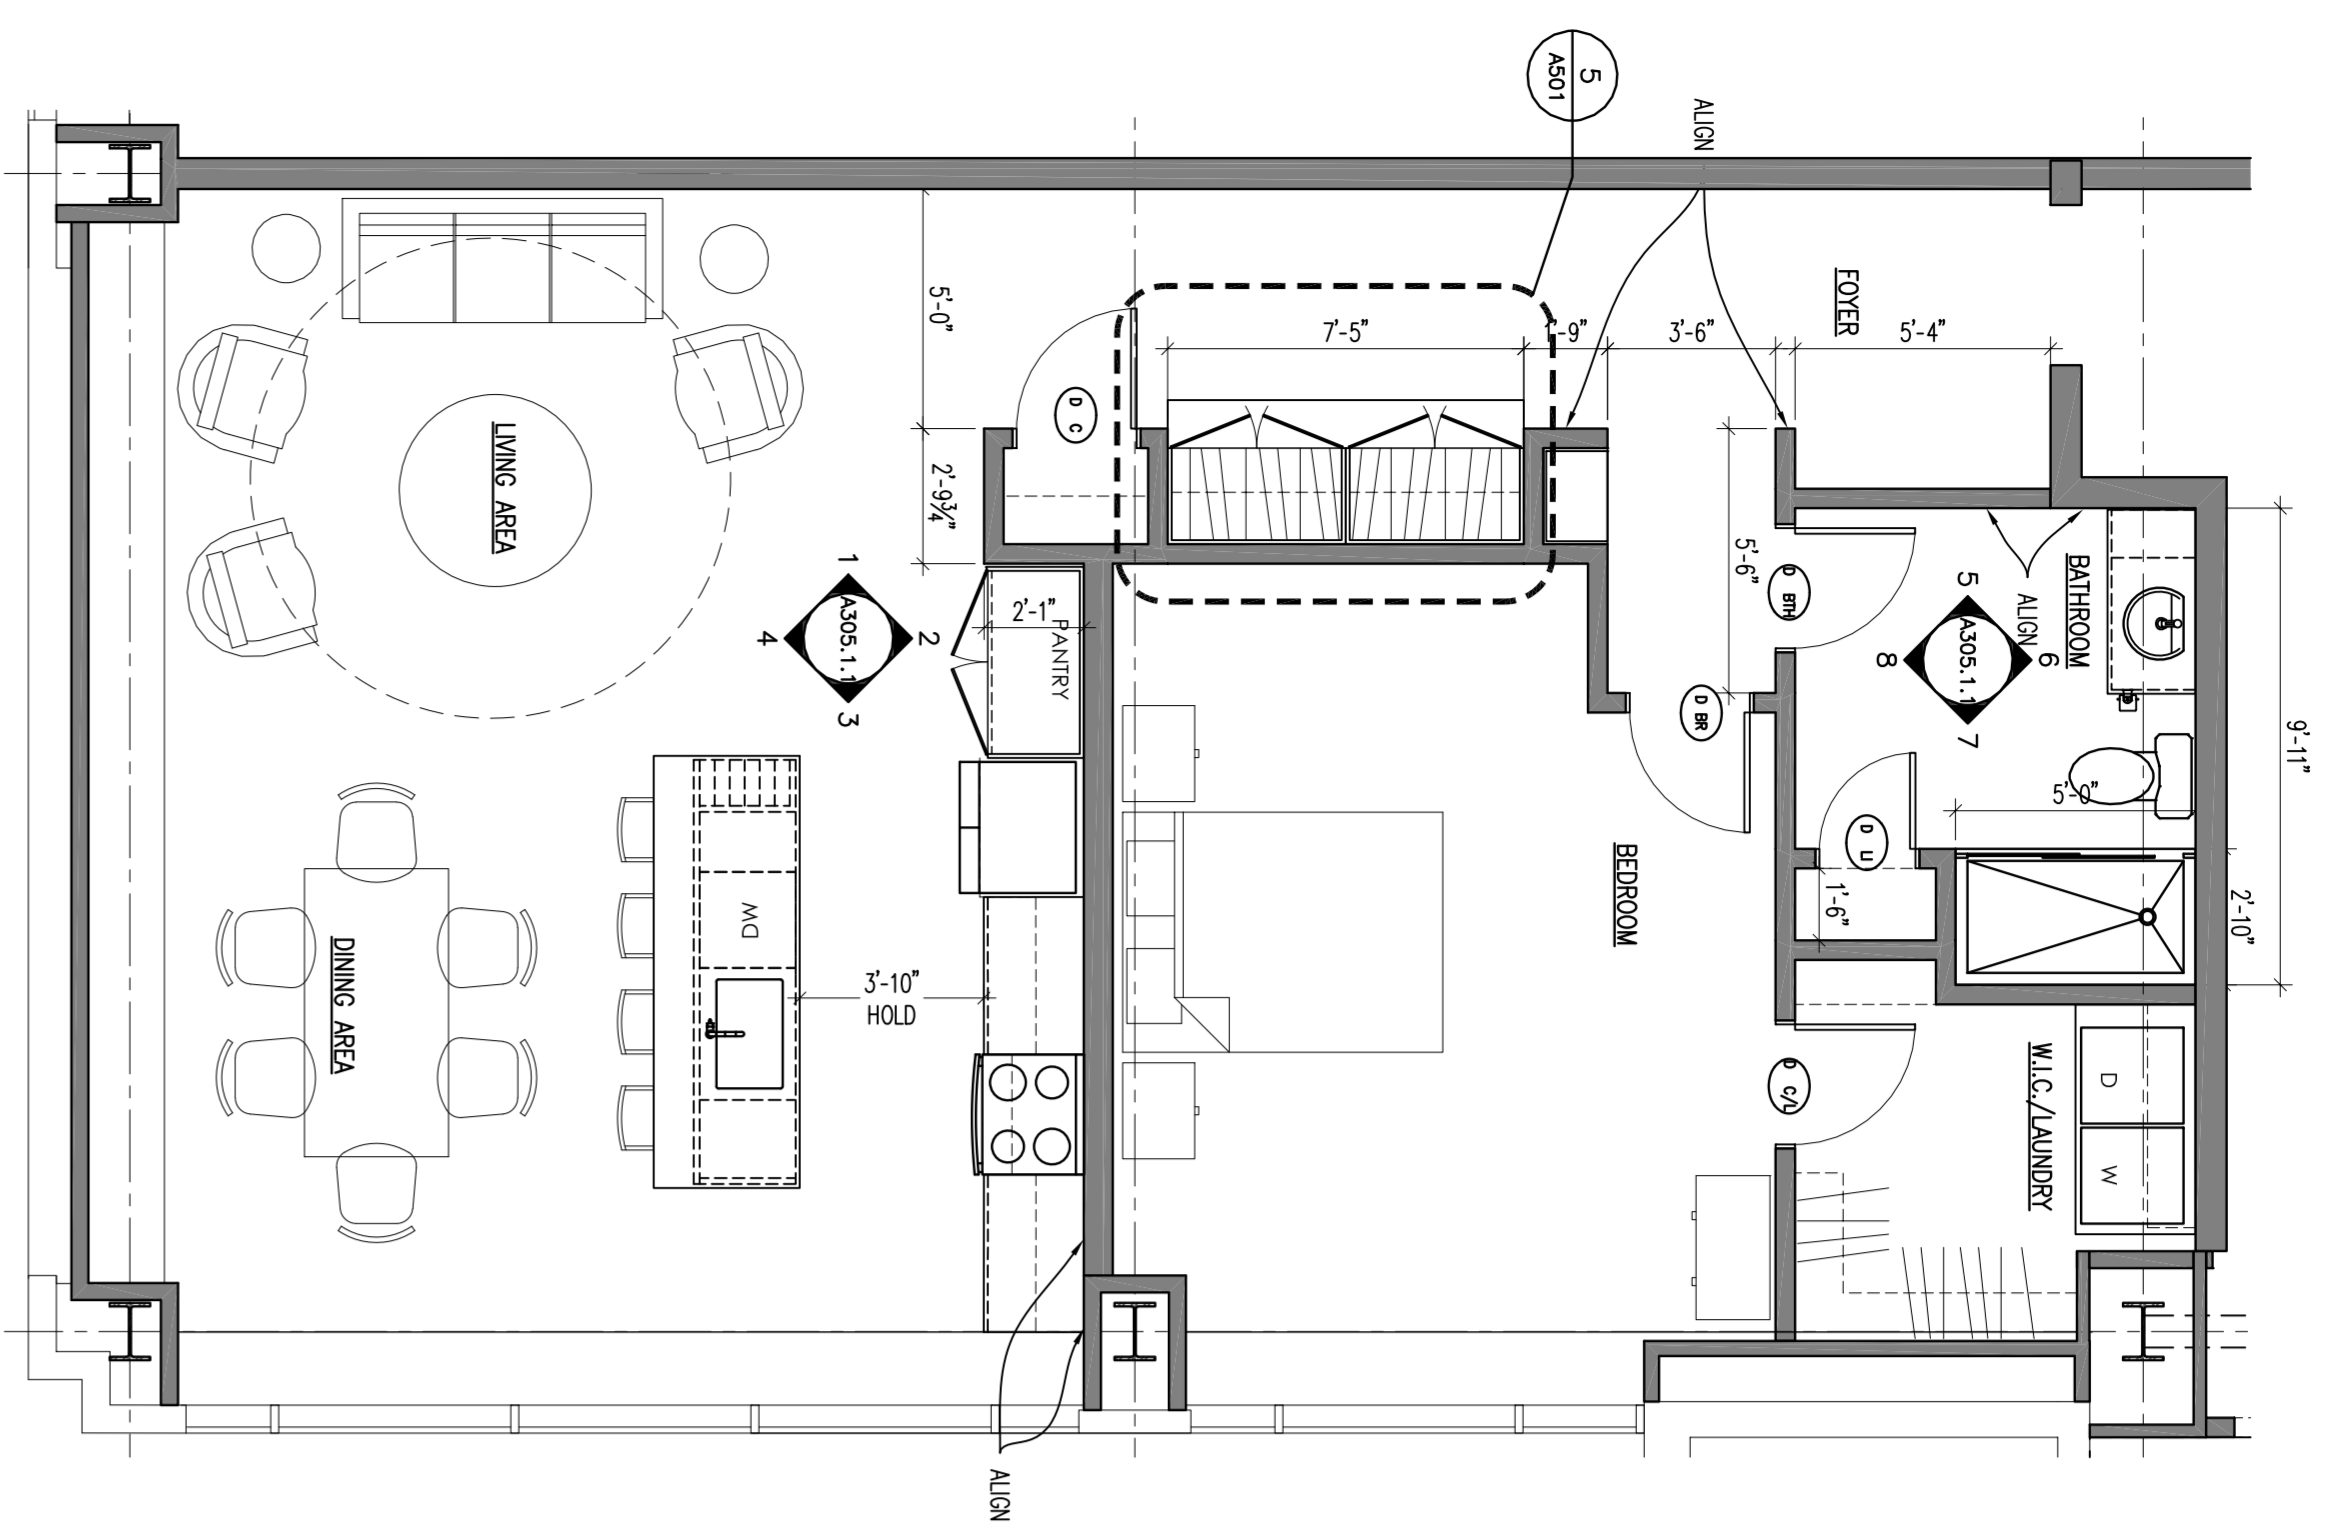


APARTMENT FLOOR PLAN
 SCALE: 1/4" = 1'-0"
 1 A305.1

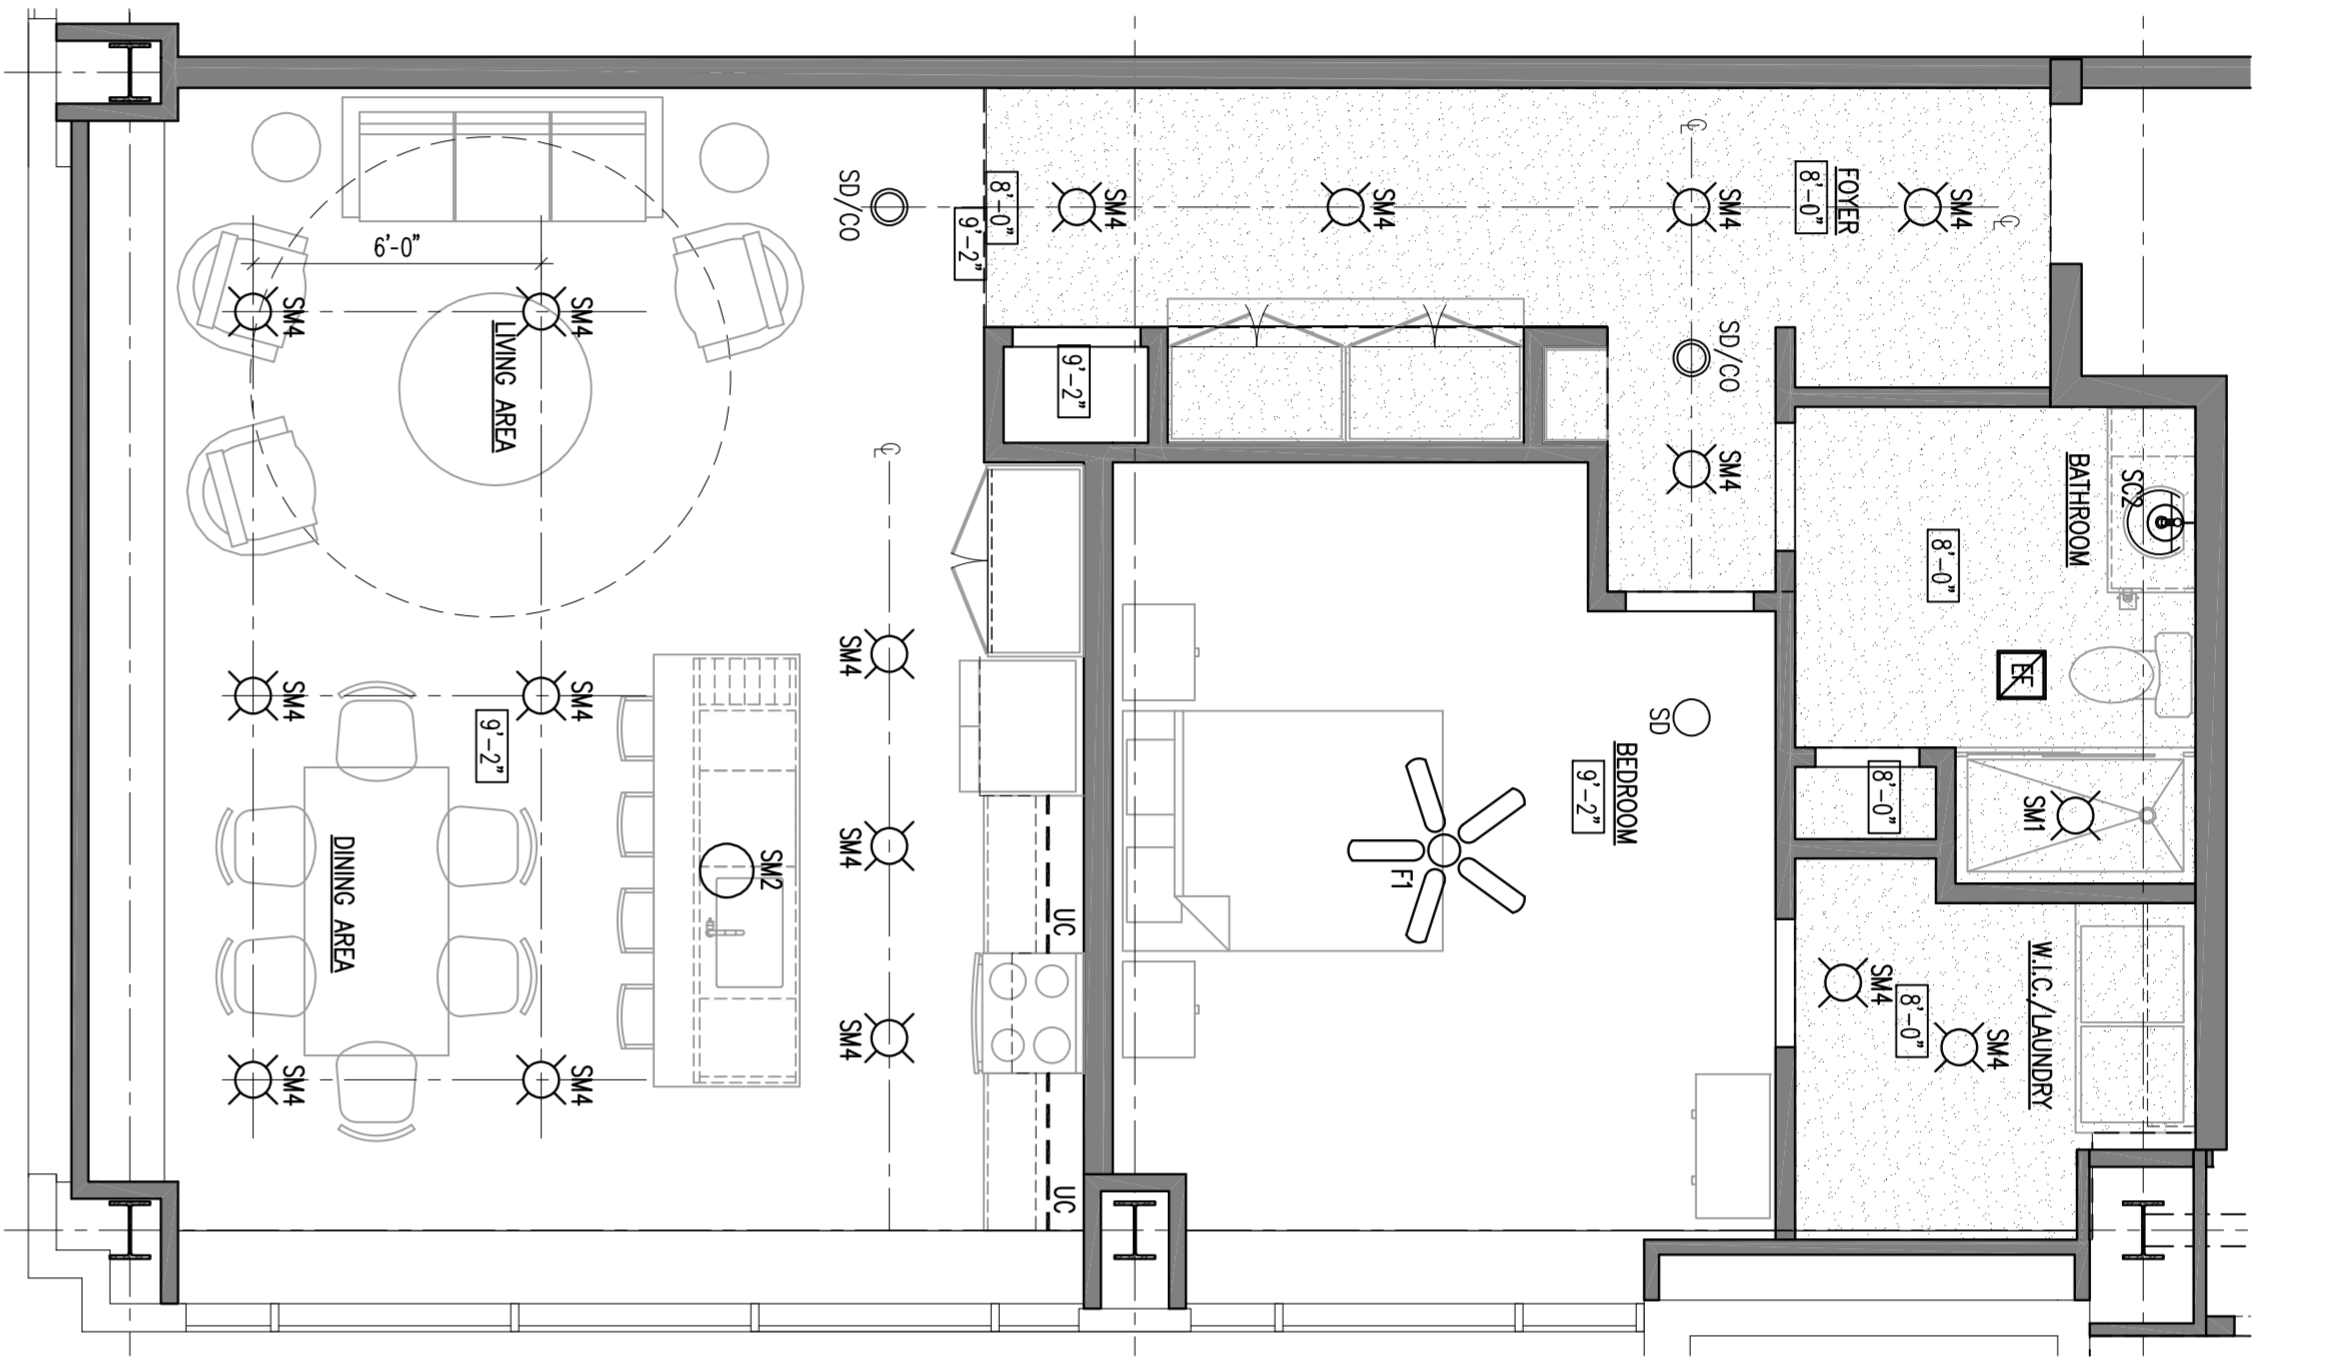


APARTMENT REFLECTED CEILING PLAN
 SCALE: 1/4" = 1'-0"
 2 A305.1

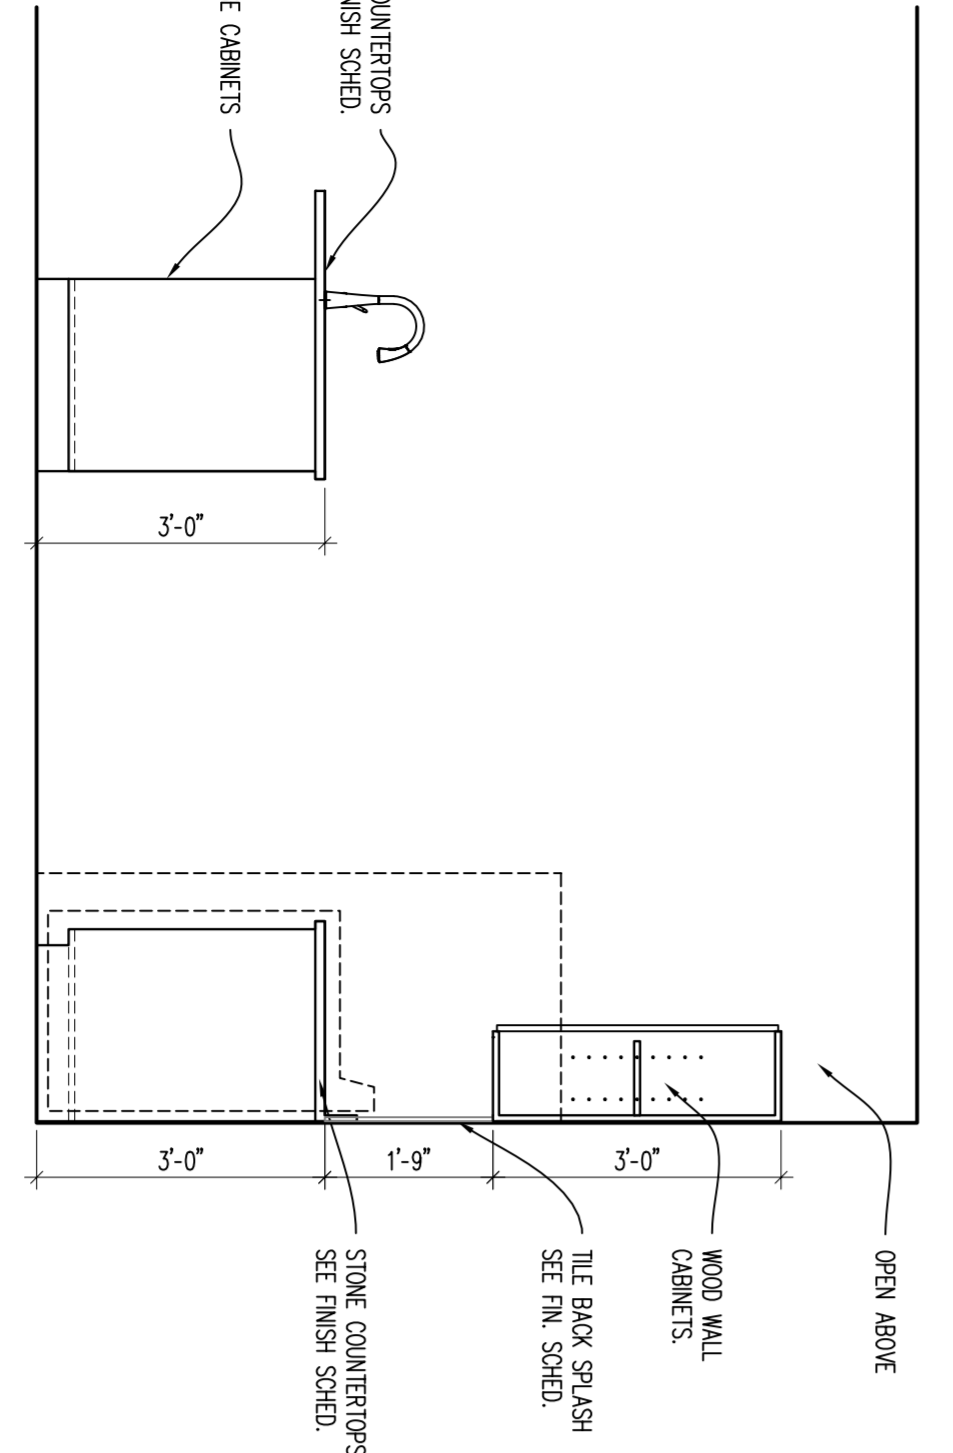


ELEVATION
 SCALE: 1/2" = 1'-0"
 1 A305.1

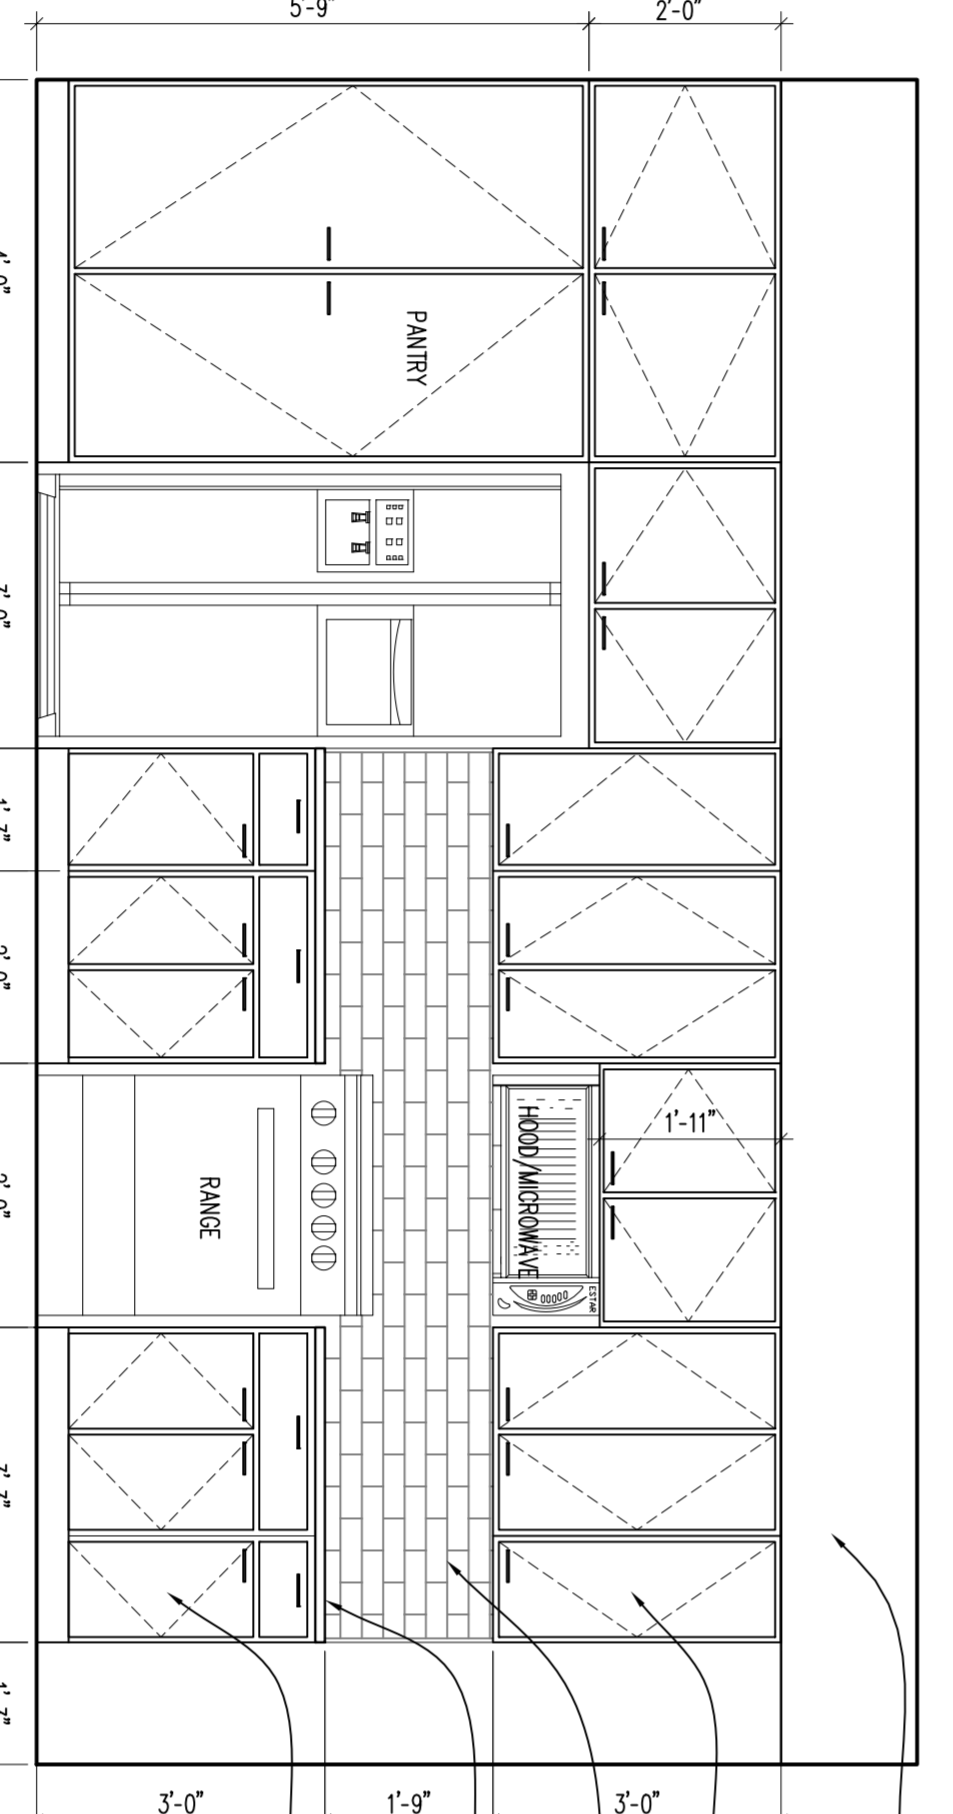


ELEVATION
 SCALE: 1/2" = 1'-0"
 2 A305.1

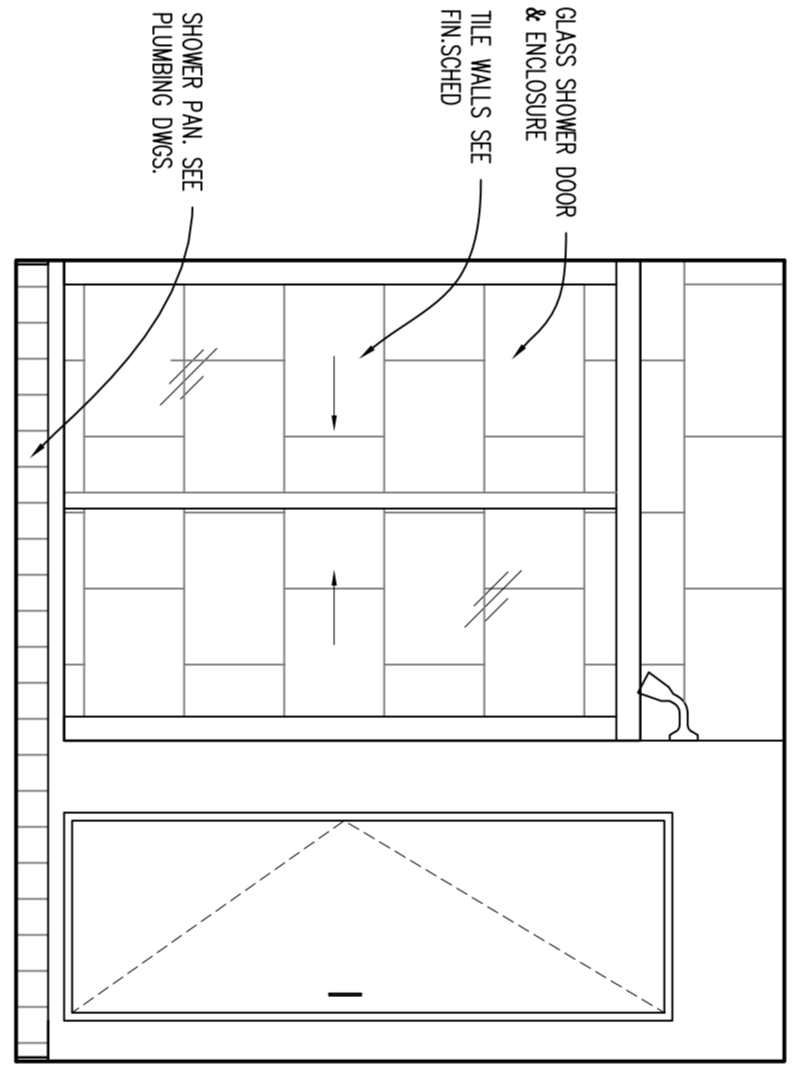


ELEVATION
 SCALE: 1/2" = 1'-0"
 3 A305.1

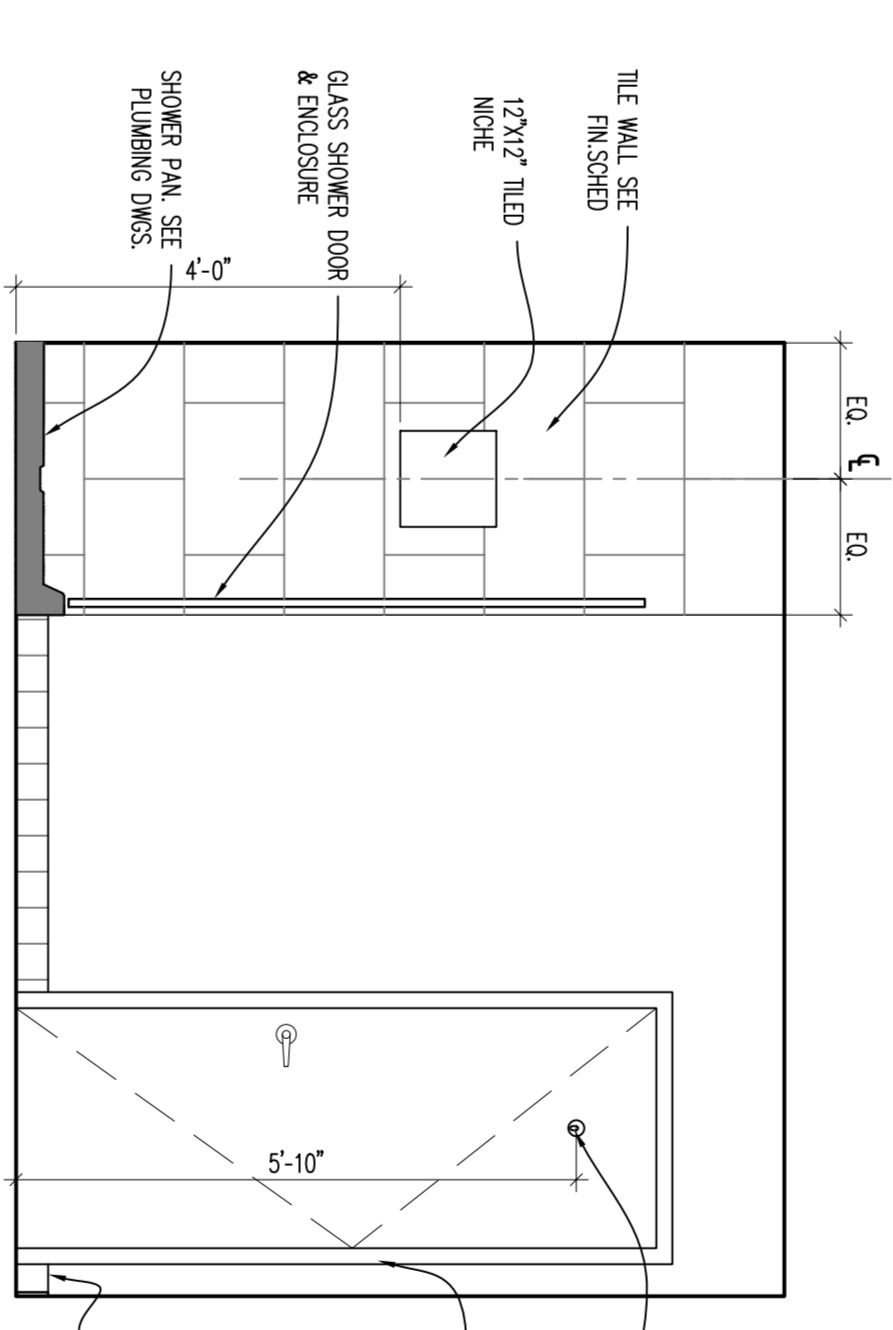

ELEVATION
 SCALE: 1/2" = 1'-0"
 4 A305.1

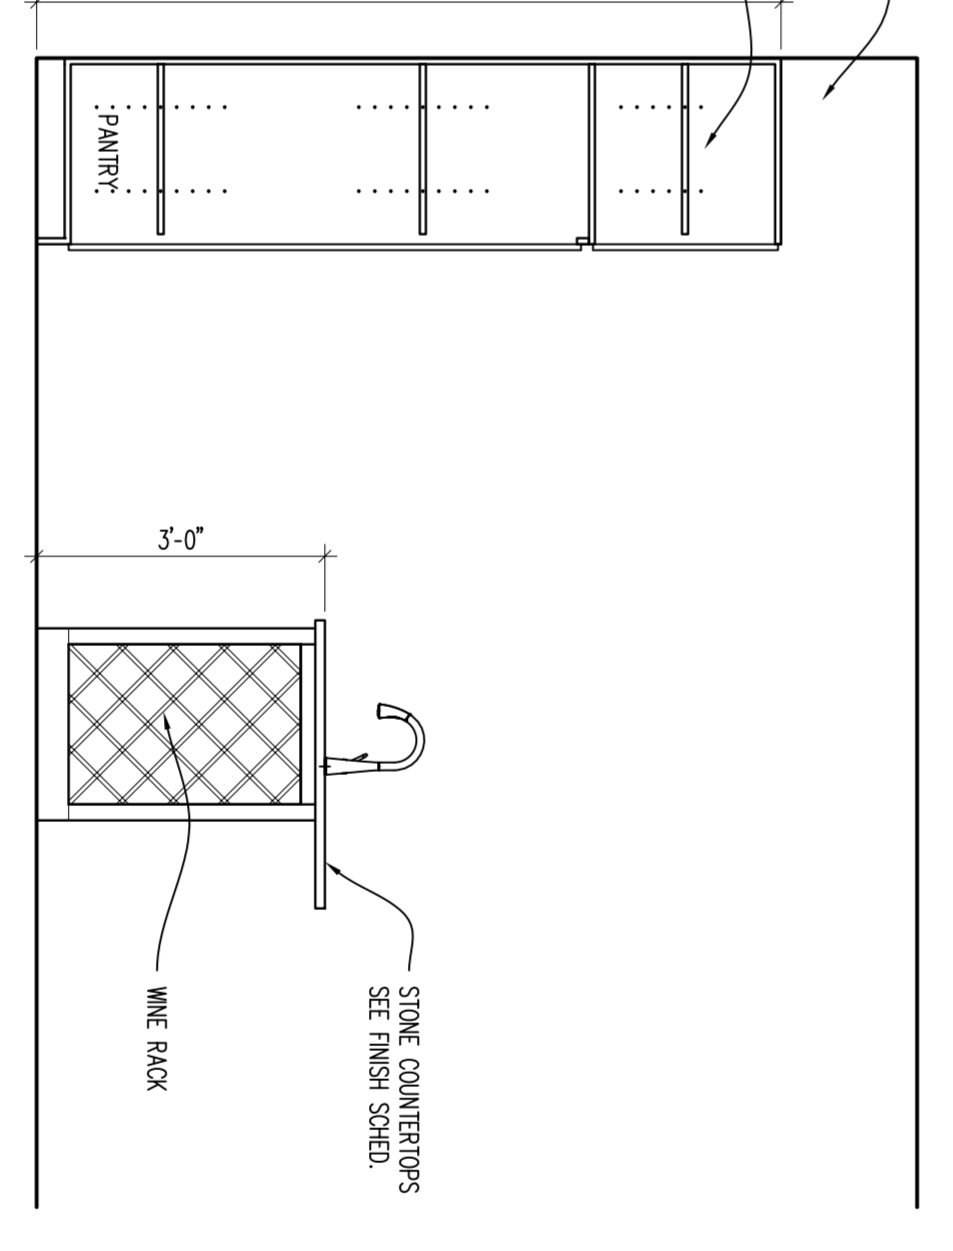

ELEVATION
 SCALE: 1/2" = 1'-0"
 5 A305.1

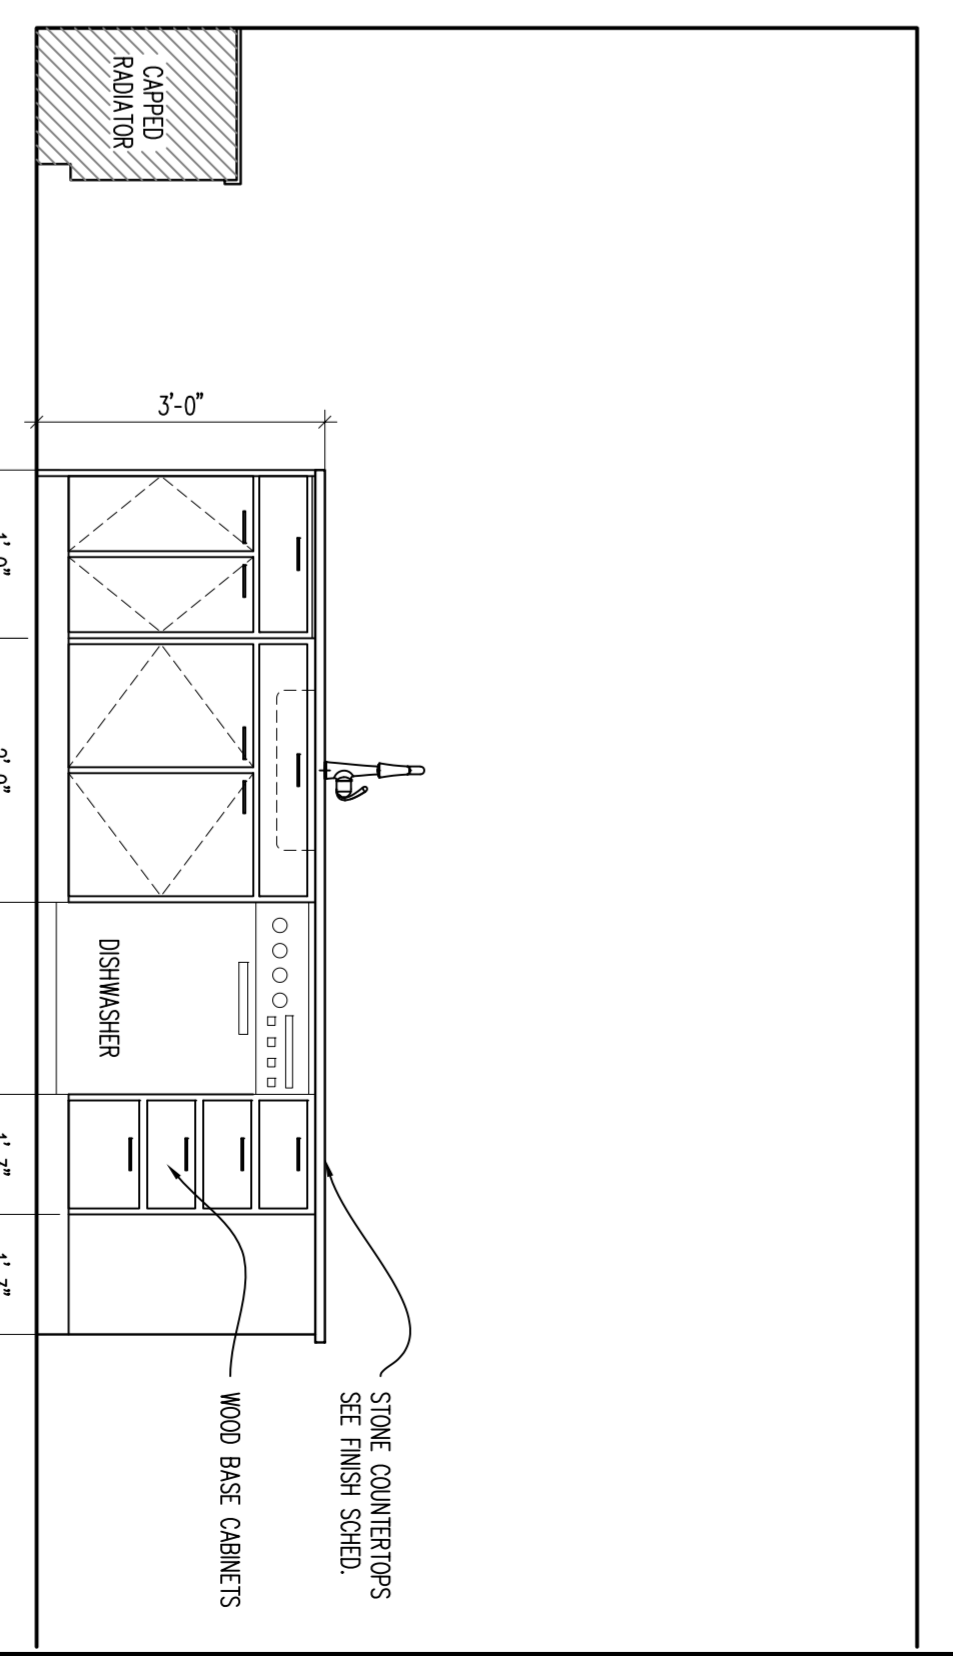

ELEVATION
 SCALE: 1/2" = 1'-0"
 6 A305.1

APARTMENT ROOM FINISH SCHEDULE						
ROOM NAME	FLOOR	BASE	WALLS			REMARKS
			NORTH	SOUTH	EAST WEST	
LIVING AREA	VP-1	RB-3	PT-1	PT-1	PT-1	NOTES: A
DINING AREA	VP-1	RB-3	PT-1	PT-1	PT-1	NOTES: A
KITCHEN	VP-1	RB-3	PT-1	PT-1	PT-1	NOTES: A
CLOSET	VP-1	RB-3	PT-1	PT-1	PT-1	NOTES: A
BEDROOM	VP-1	RB-3	PT-1	PT-1	PT-3	NOTES: A
WALK-IN CLOSET / LAUNDRY	VP-1	RB-3	PT-1	PT-1	PT-3	NOTES: A
LINEN	VP-1	RB-3	PT-1	PT-1	PT-3	NOTES: A
BATHROOM	VP-1	RB-3	PT-1	PT-1	PT-3	NOTES: A
Foyer / Corridor	VP-1	RB-3	PT-1	PT-1	PT-3	NOTES: A

APARTMENT DOOR SCHEDULE												
DOOR MARK	DOOR LOCATION	DOOR INFORMATION			FRAME INFORMATION			HDW. SET	FIRE RATING	REMARKS		
		WIDTH	HEIGHT	THICK	STYLE	DOOR MATERIAL	TYPE				FRAME MATERIAL	HEAD JAMB OTHER
D BR	BEDROOM	2'-8"	6'-8"	1 3/8"	2	OK	A	WD	5/4600	6/4600	2	PRE-FINISH STAINED
D BRH	BATHROOM	2'-8"	6'-8"	1 3/8"	2	OK	A	WD	5/4600	6/4600	2	PRE-FINISH STAINED
D C	CLOSET	2'-6"	6'-8"	1 3/8"	2	OK	A	WD	5/4600	6/4600	3	PRE-FINISH STAINED
D C	CLOSET	2'-6"	6'-8"	1 3/8"	2	OK	A	WD	5/4600	6/4600	3	PRE-FINISH STAINED
D U	LINEN	2'-0"	6'-8"	1 3/8"	2	OK	A	WD	5/4600	6/4600	3	PRE-FINISH STAINED

- GENERAL APARTMENT NOTES**
- DOOR FRAME SHALL BE 4" FROM FACE OF WALL TO BACKSIDE OF FRAME UNLESS NOTED OTHERWISE.
 - DOOR DIMENSIONS ARE FROM FINISH FACE OF WALL TO FINISH FACE OF WALL UNLESS NOTED OTHERWISE.
 - ALL LIGHTING FOR REFERENCE ONLY.
 - ALL CEILING DIMENSIONS ARE FOR DESIGN INTENT ONLY. ALL VISIBLE SIZES OF CABINETS ARE TO RECEIVE A FINISH. ALL DIMENSIONS ARE FROM FINISH FACE OF WALL UNLESS NOTED OTHERWISE.
 - ENERGY STAR APPLIANCES (REFRIGERATOR, STOVE, DISHWASHER AND/OR RANGE) THE WINDOWS, TOP OF ALL ENERGY STAR APPLIANCES (REFRIGERATOR, STOVE, DISHWASHER AND/OR RANGE) SHALL BE NEW.
 - ADJUSTABLE METALME SHELVES TO RECEIVE FINISH (3) EACH SHOWER TO BE PROVIDED W/ GLASS SHOWER DOOR, BRNS (1) TOILET PAPER HOLDER (1) ROBE HOOK.

Project: Formica Building
 115 E 5th Street
 Cincinnati, Ohio 45202
 No. Revisions: 1
 Date: 11.14.2022
 Sheet Title: Construction
 Project No: 2022_259
 Issue Date:
 Scale: As Noted
 Drawn: [Signature]
 Checked: [Signature]

Formica Building

Office/Apartments
 Auditor Address: 115 E. 5th Street, Actual Address: 120 E. 4th Street
 Cincinnati OH 45202


modelgroup
 DEVELOPMENT • CONSTRUCTION • MANAGEMENT

1826 Race Street
 Cincinnati, Ohio 45202
 513.559.0048


STATE OF OHIO
JOSEPH A. BODKIN
 313367
 REGISTERED ARCHITECT

Joseph A. Bodkin, License #313367
 Expiration Date: 12-31-2023


A305.1

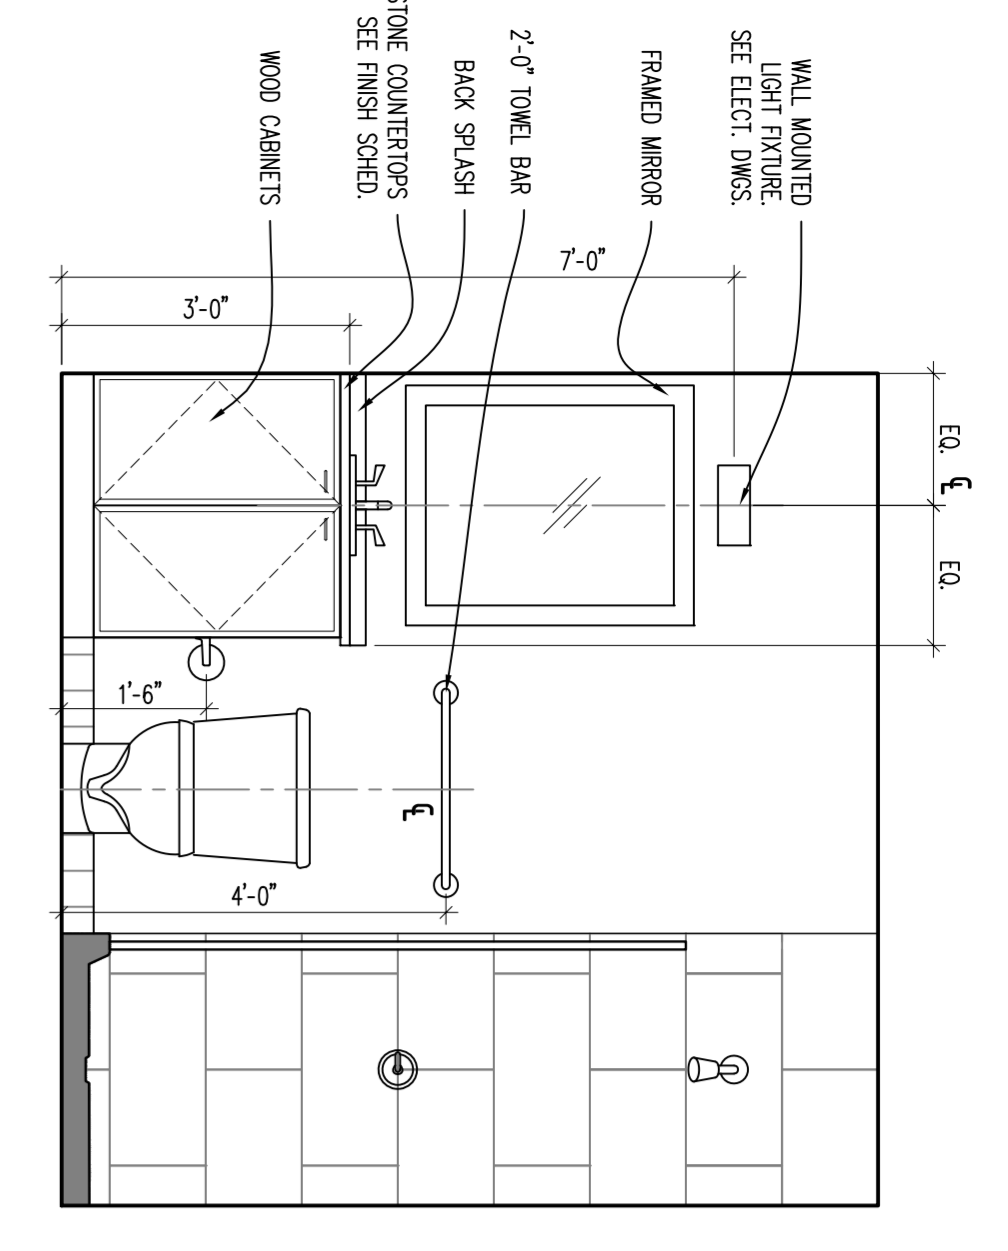


ELEVATION 1
 SCALE: 1/2" = 1'-0"

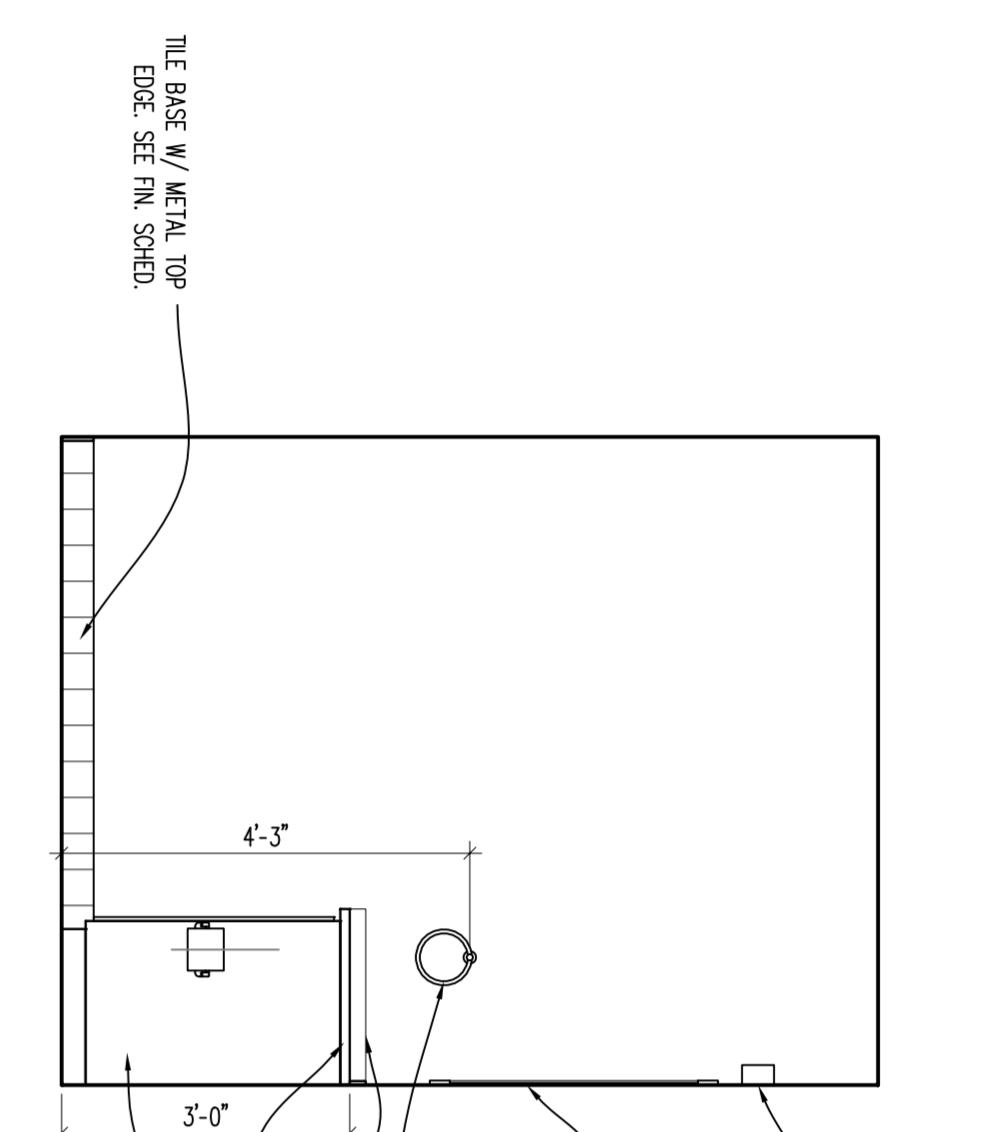


ELEVATION 2
 SCALE: 1/2" = 1'-0"

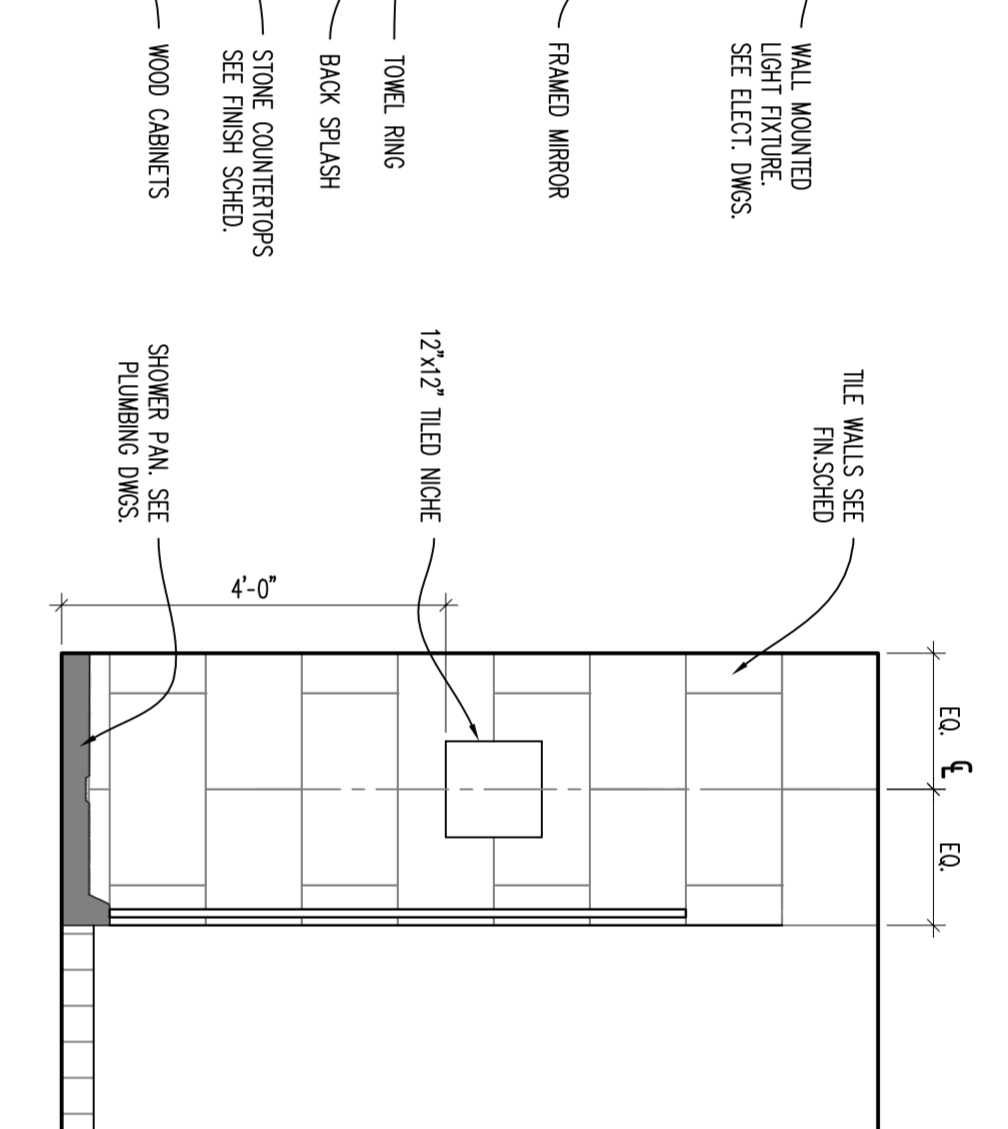


ELEVATION 3
 SCALE: 1/2" = 1'-0"

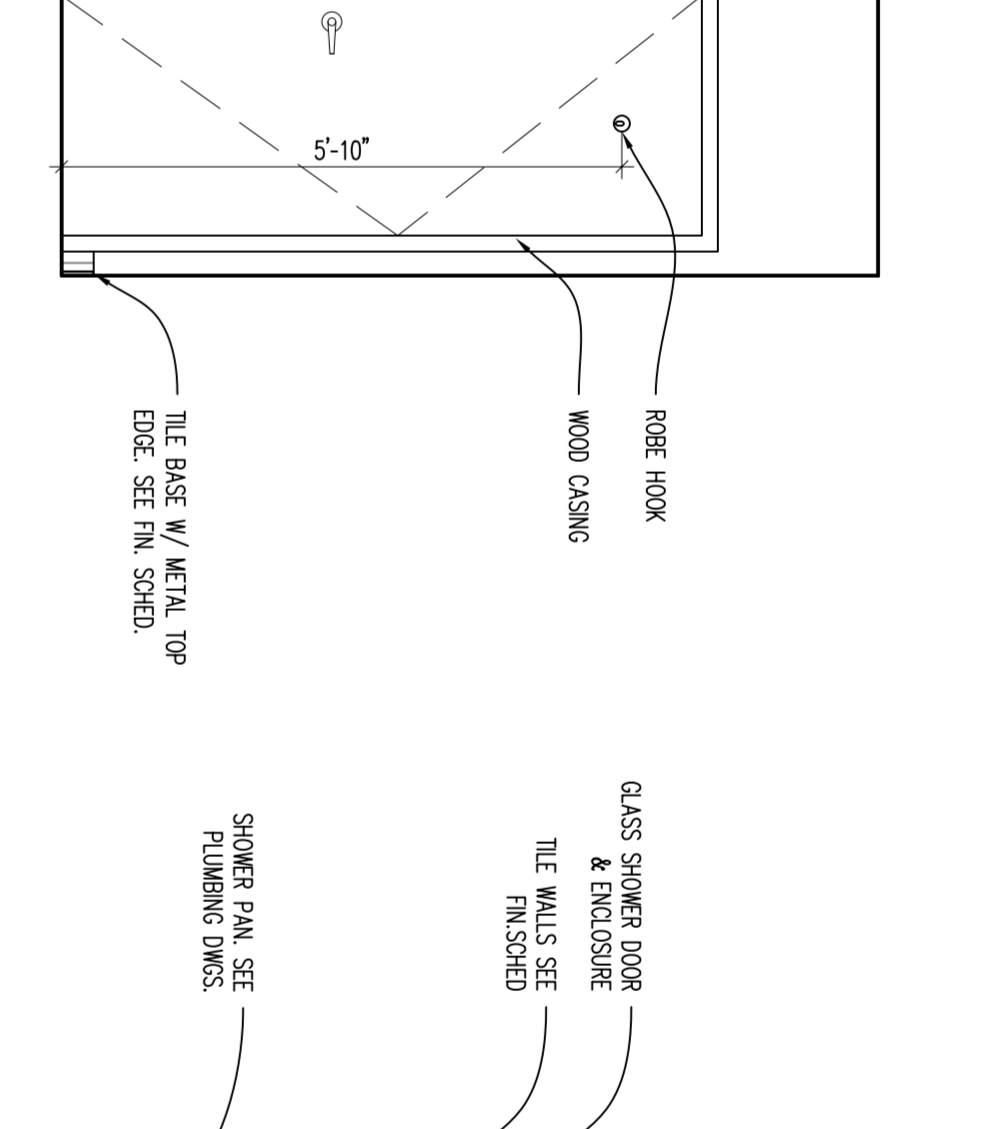


ELEVATION 4
 SCALE: 1/2" = 1'-0"

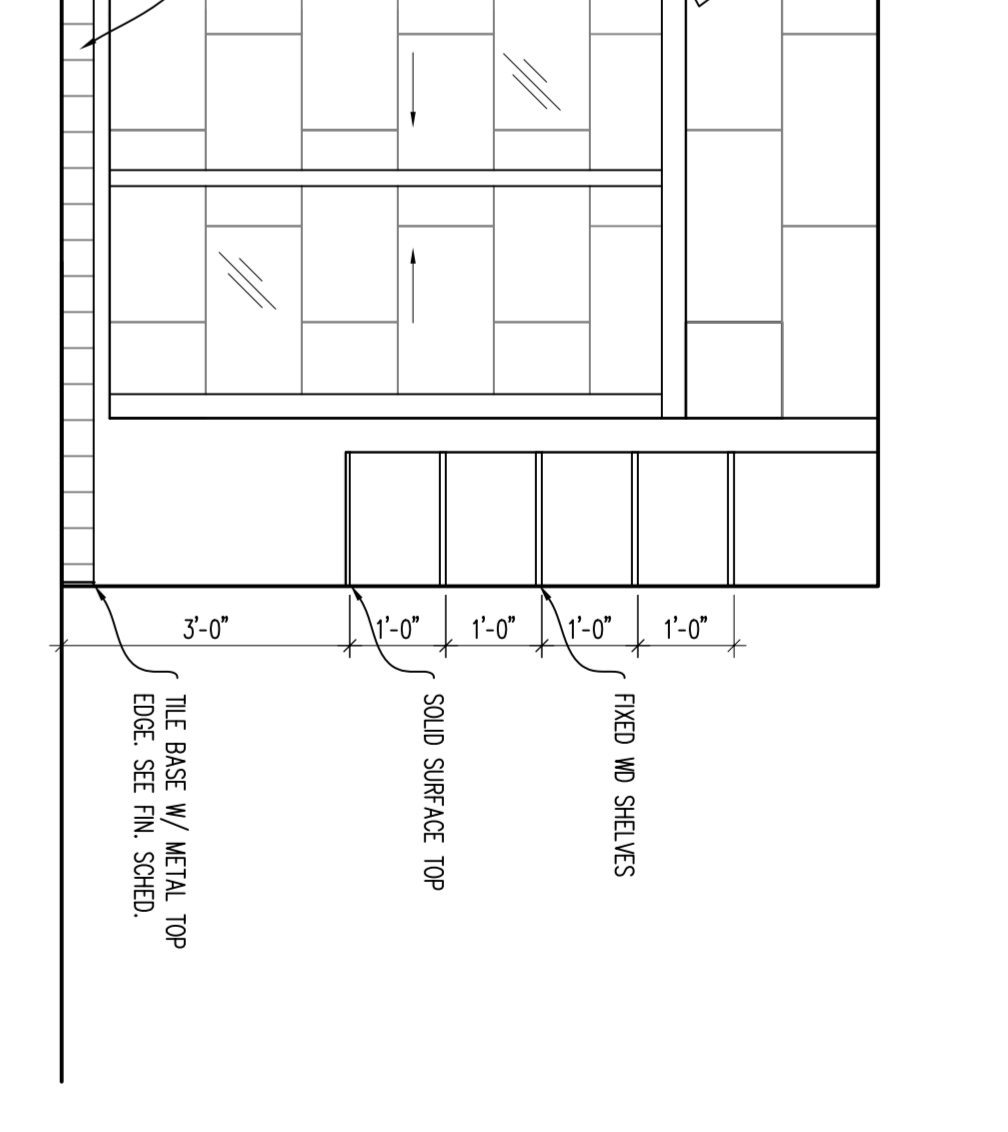


ELEVATION 5
 SCALE: 1/2" = 1'-0"

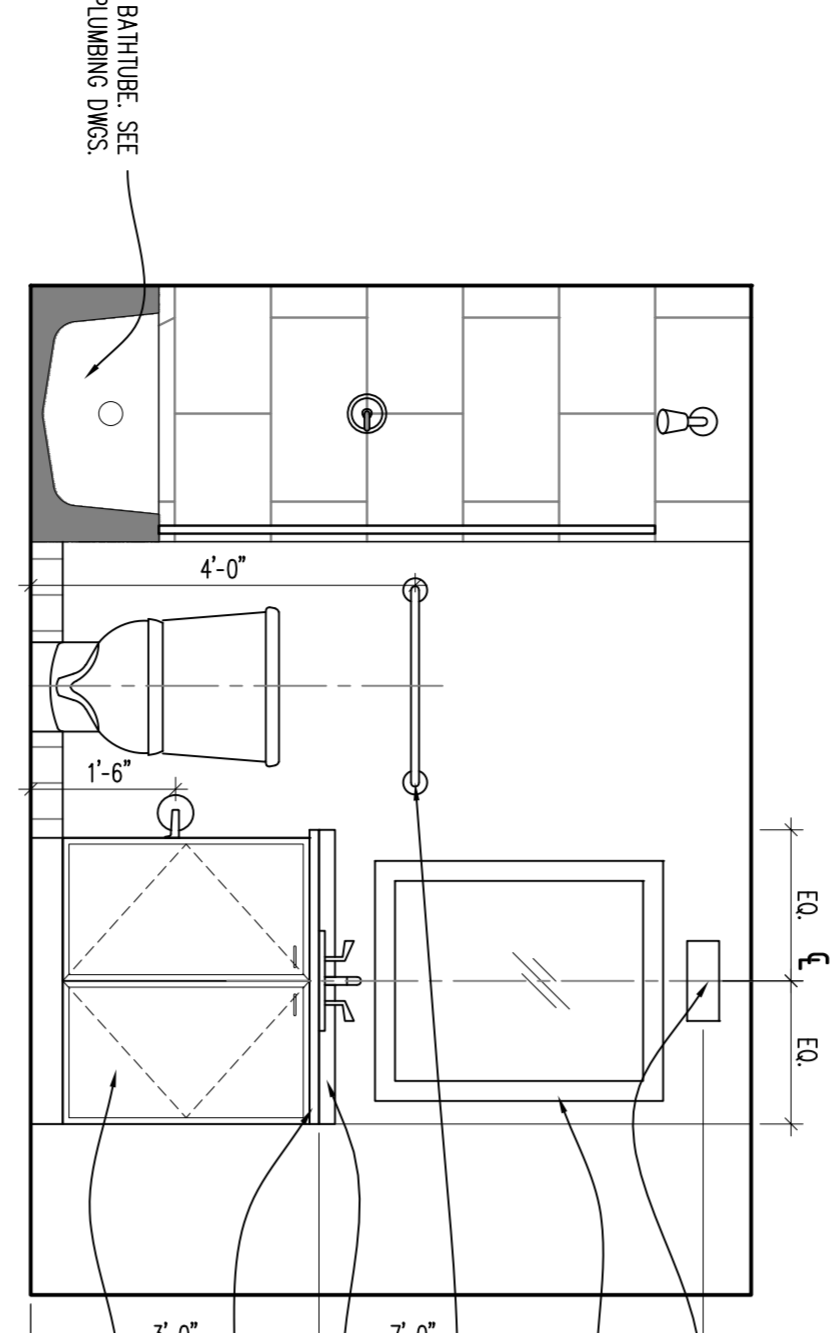


ELEVATION 6
 SCALE: 1/2" = 1'-0"

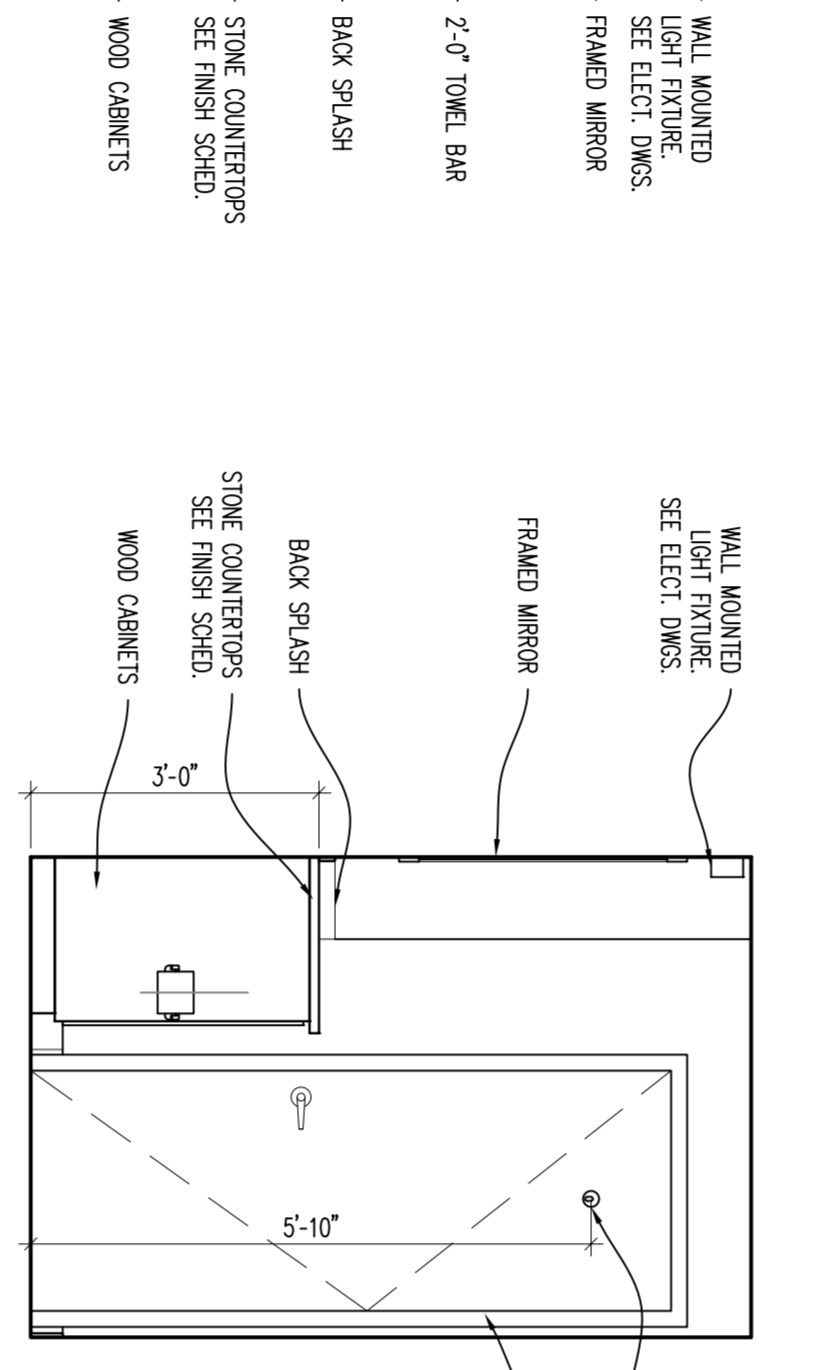


ELEVATION 7
 SCALE: 1/2" = 1'-0"

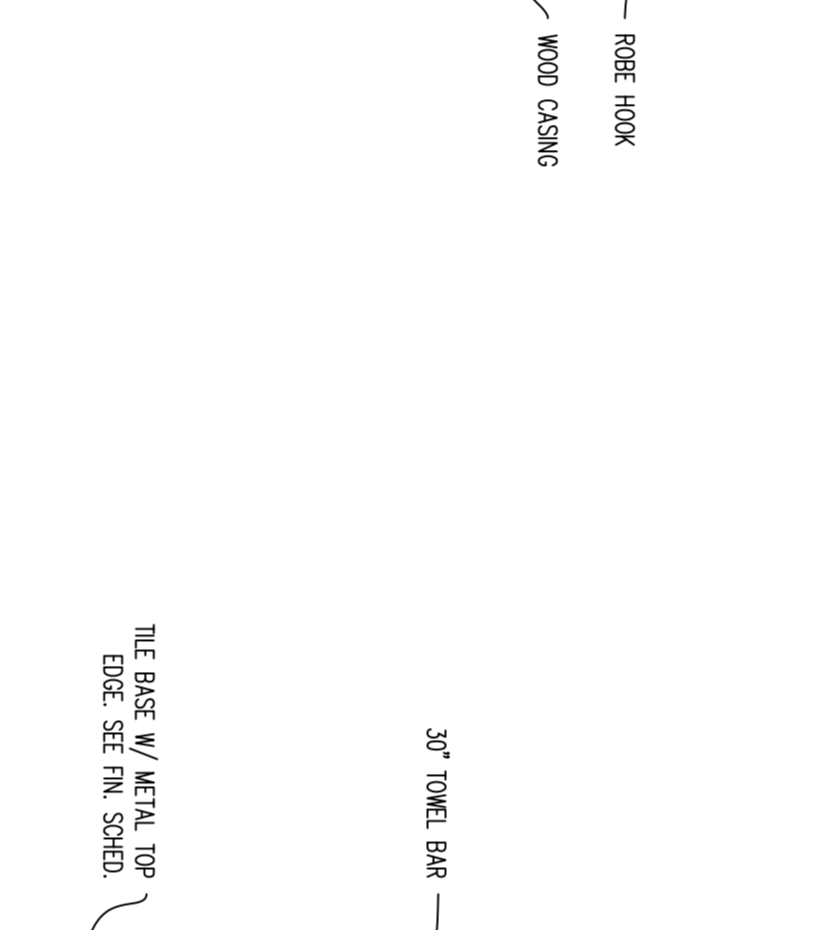


ELEVATION 8
 SCALE: 1/2" = 1'-0"

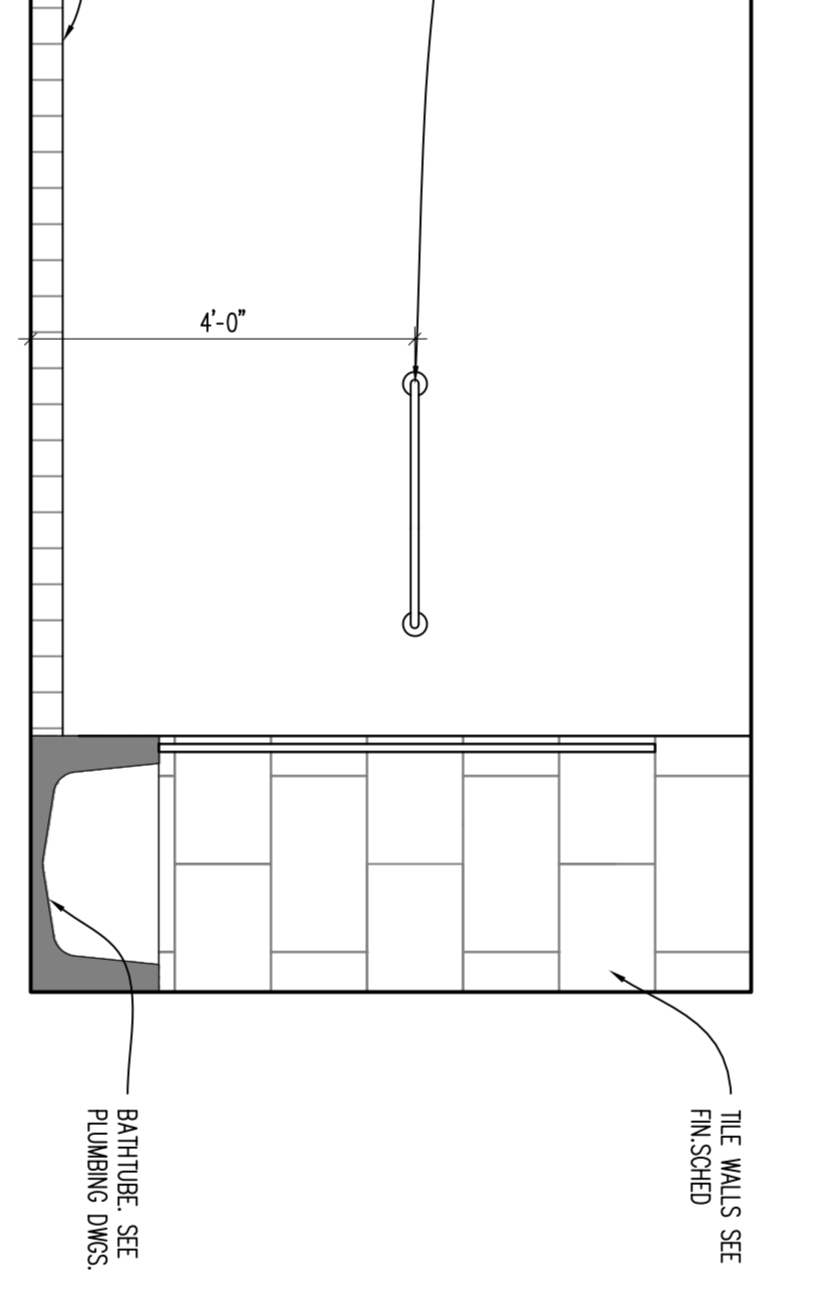


ELEVATION 9
 SCALE: 1/2" = 1'-0"

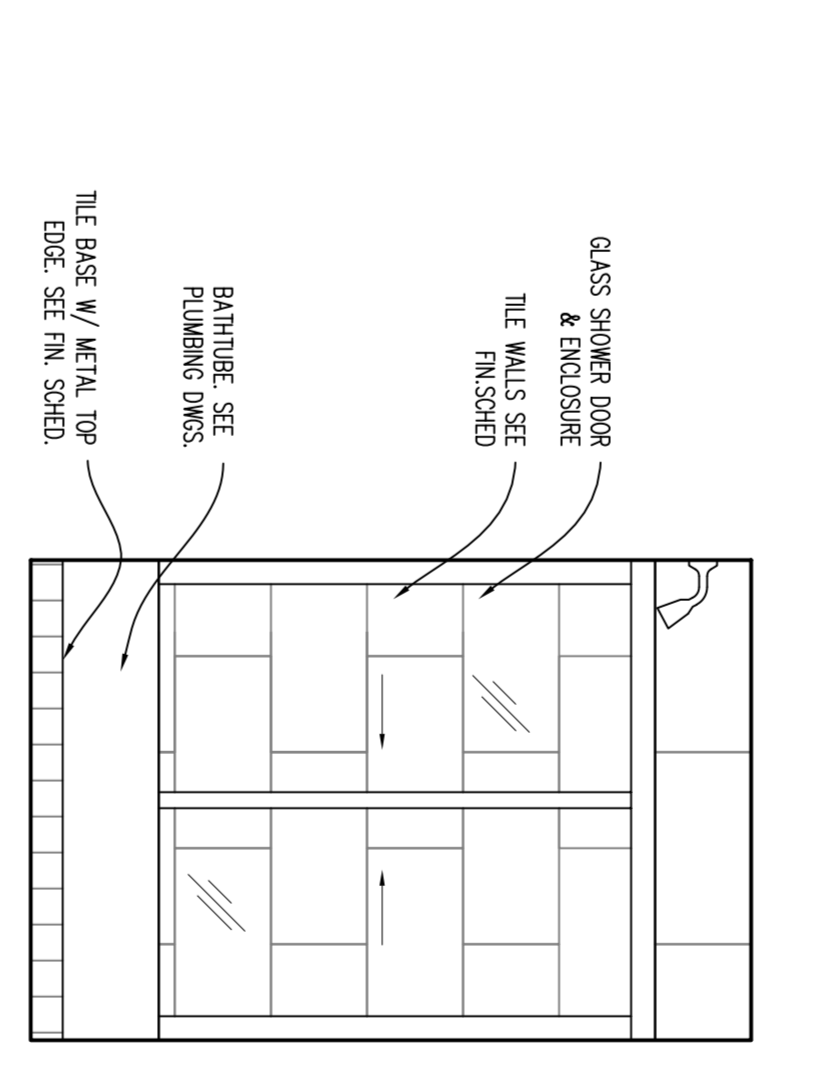


ELEVATION 10
 SCALE: 1/2" = 1'-0"

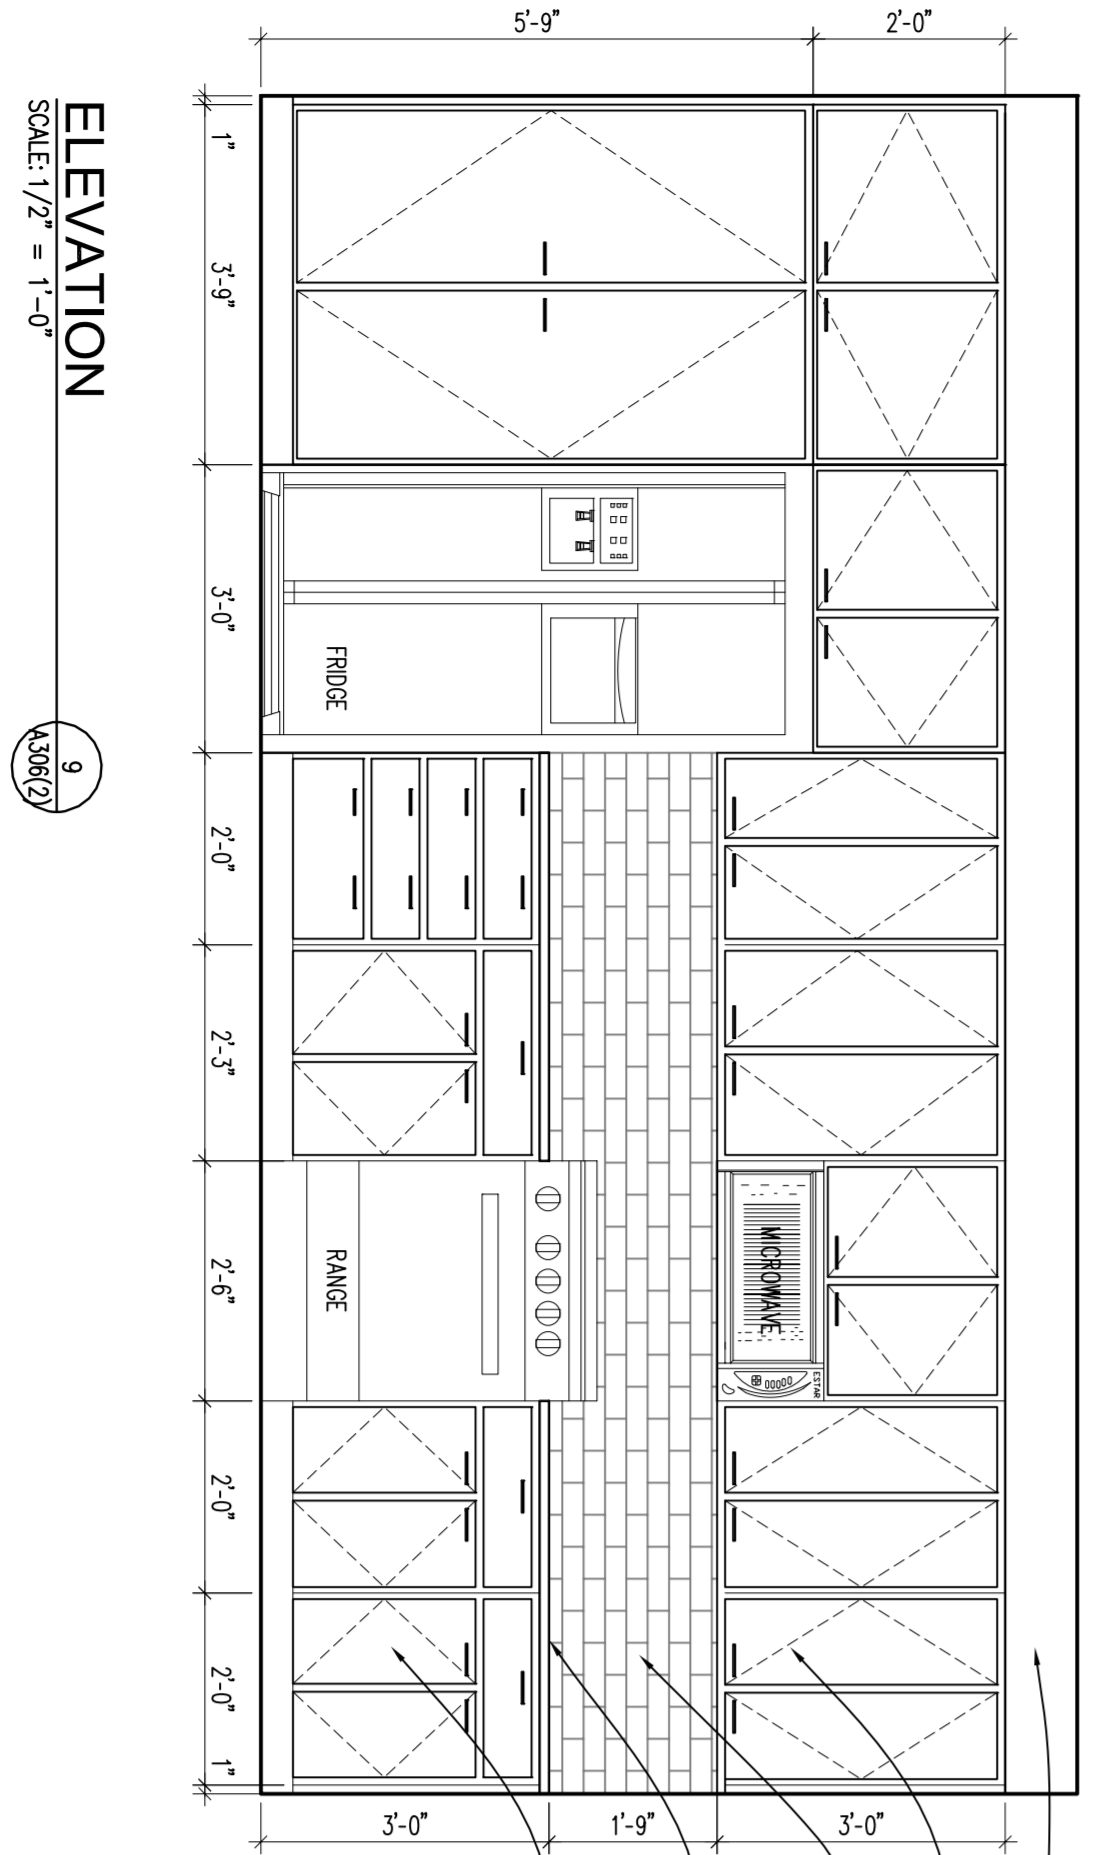


ELEVATION 11
 SCALE: 1/2" = 1'-0"

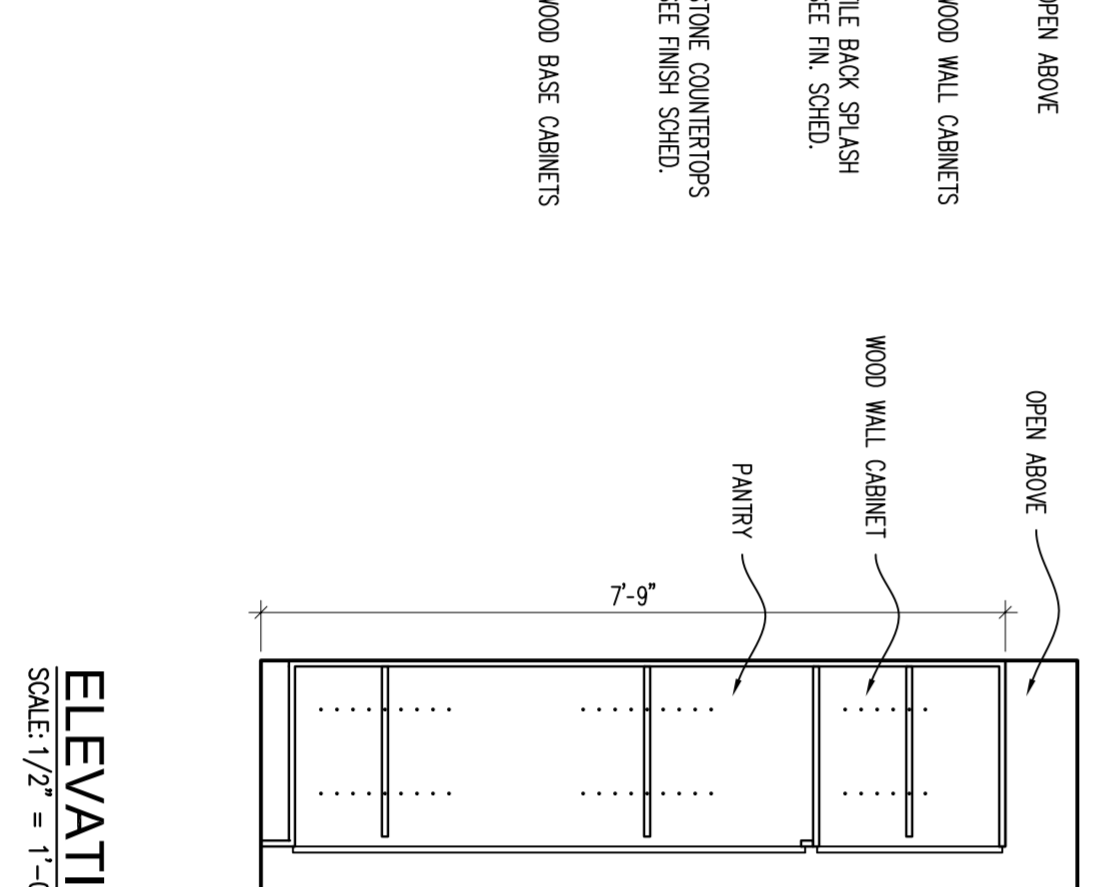


ELEVATION 12
 SCALE: 1/2" = 1'-0"

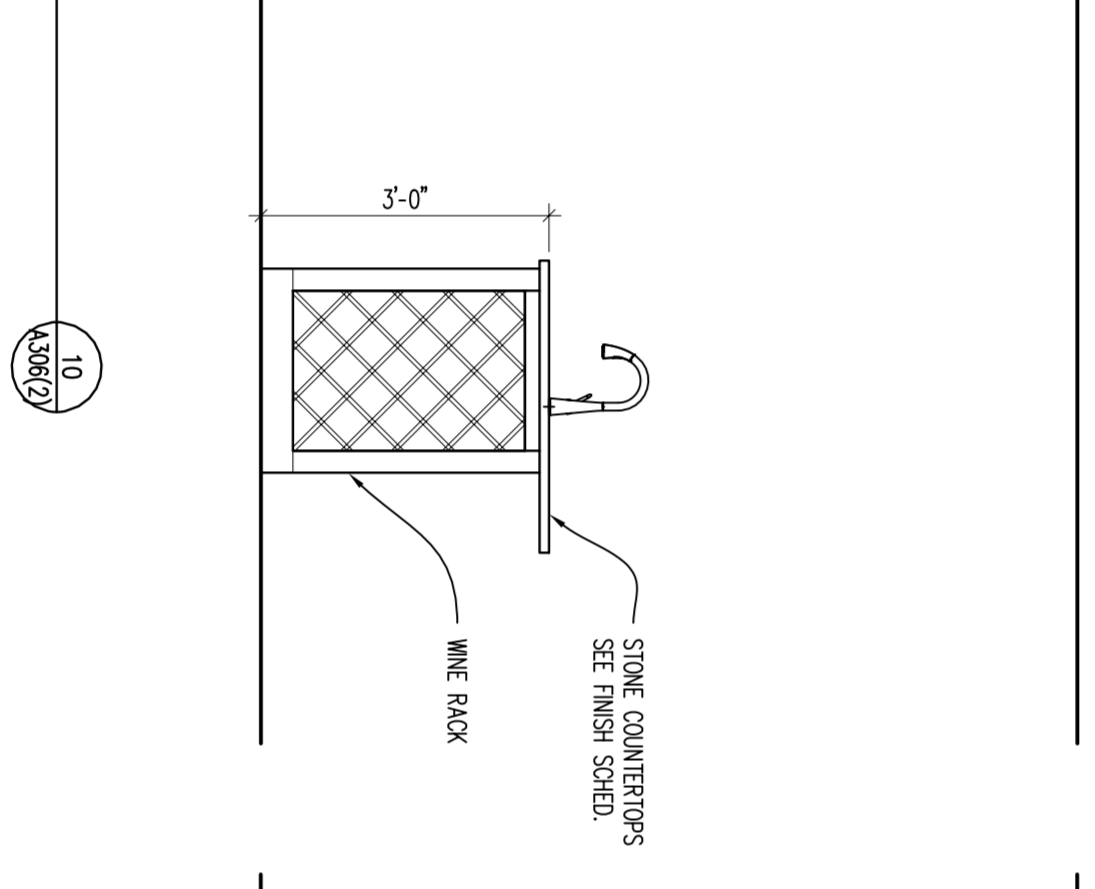

ELEVATION 13
 SCALE: 1/2" = 1'-0"

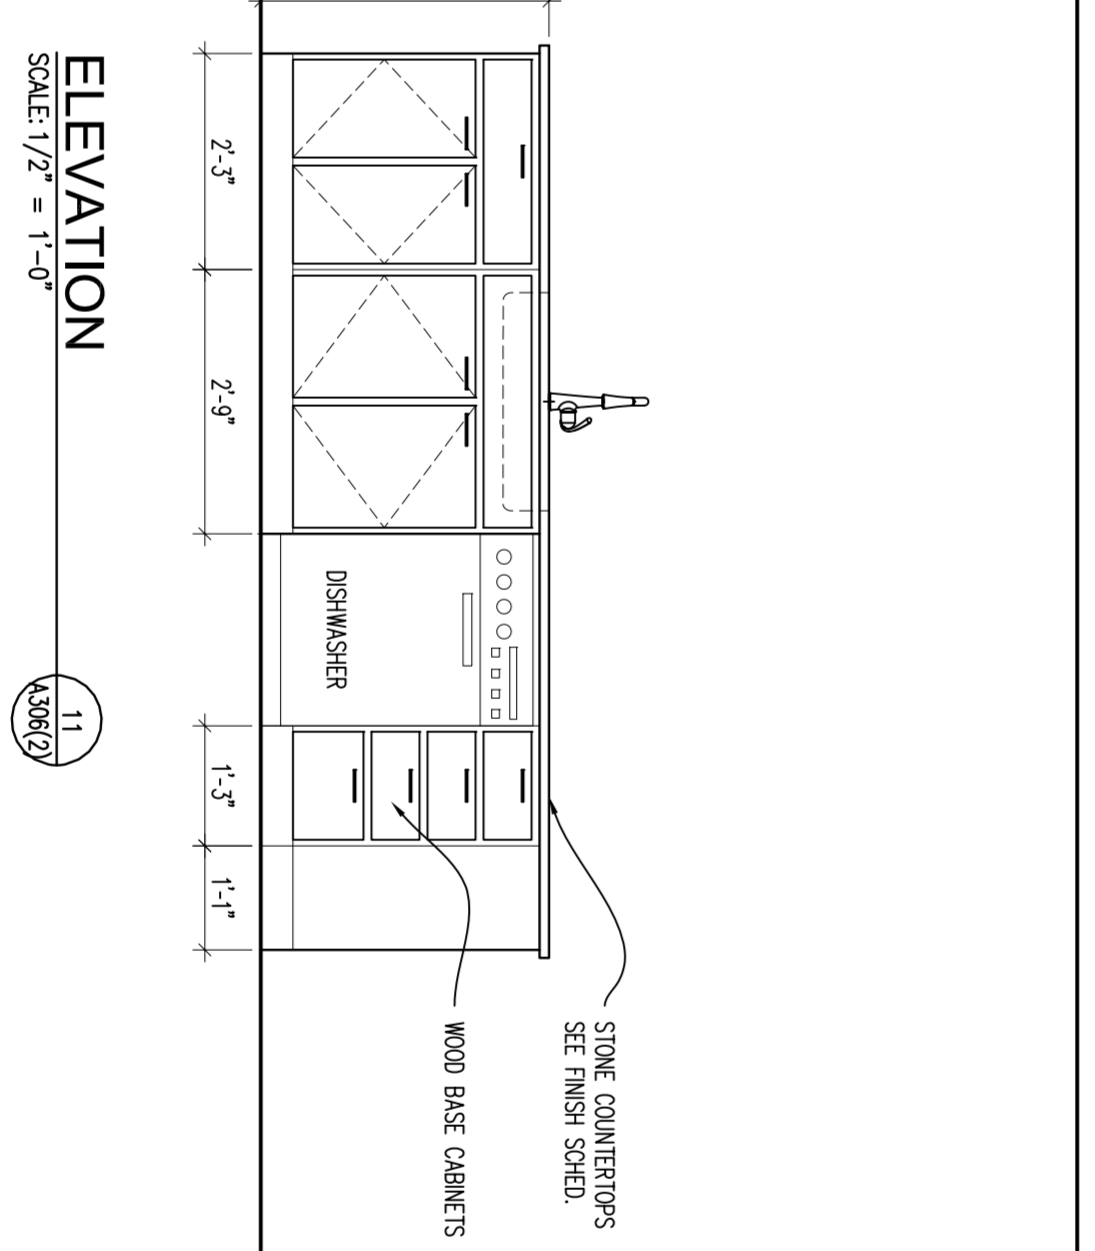

ELEVATION 14
 SCALE: 1/2" = 1'-0"

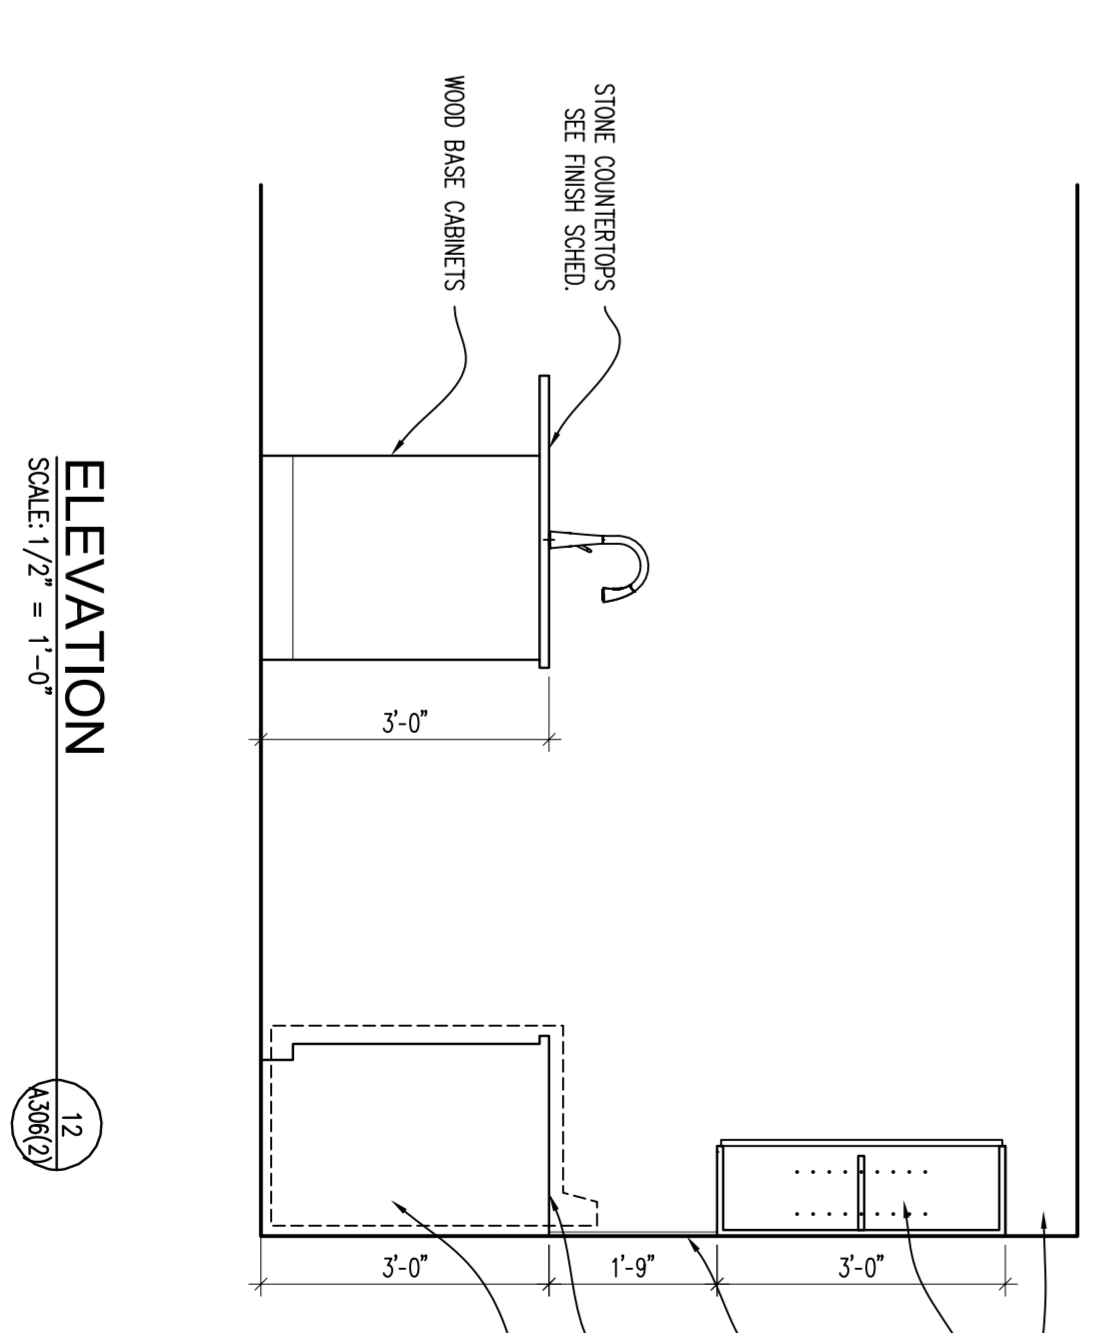

ELEVATION 15
 SCALE: 1/2" = 1'-0"

- GENERAL APARTMENT NOTES**
- DOOR FRAME SHALL BE 4" FROM FACE OF WALL TO BACKSIDE OF FRAME UNLESS TYPE 3 UNLESS NOTED.
 - ALL DIMENSIONS ARE FROM FINISH FACE OF WALL TO FINISH FACE OF WALL UNLESS NOTED.
 - FACE OF WALL UNLESS NOTED.
 - ALL LIGHTING FOR REFERENCE ONLY.
 - ALL CABINET DIMENSIONS ARE FOR DESIGN AND ONLY FOR REVIEW BASIS OF DESIGN ARE SHOWN CABINETS INCLUDES CABINETS THAT ARE UP AGAINST THE BUILDINGS AND/OR FRAMING THE WINDOWS, TOP OF ALL NEW ENERGY SAVING APPLIANCES, PANTRY BINS WILL BE NEW PROVIDE REWORKING FOR FUTURE GRID BARS IN ALL UNIT.
 - ALL FINISHES SHALL BE FOR DESIGN AND ONLY FOR REVIEW BASIS OF DESIGN ARE SHOWN CABINETS INCLUDES CABINETS THAT ARE UP AGAINST THE BUILDINGS AND/OR FRAMING THE WINDOWS, TOP OF ALL NEW ENERGY SAVING APPLIANCES, PANTRY BINS WILL BE NEW PROVIDE REWORKING FOR FUTURE GRID BARS IN ALL UNIT.
 - ADJUSTABLE METALWARE SHELVES (1) INCLUDES SHELF AND COAT HOOK UNLESS NOTED IN EACH APARTMENT (2) DOOR, PROVIDE AND INSTALL IN EACH APARTMENT (3) ROBE HOOK, BINS (1) TOWER PAPER HOLDER (1) ROBE HOOK.

Project	Formica Building	
	115 E 5th Street	
Sheet Title	Unit G Construction	
	Project No. 2022_259 Issue Date	
Scale	As Noted	Drawn
Checked		

Formica Building

Office/Apartments


Auditor Address: 115 E. 5th Street, Actual Address: 120 E. 4th Street
 Cincinnati OH 45202

modelgroup
 DEVELOPMENT • CONSTRUCTION • MANAGEMENT


1826 Race Street
 Cincinnati, Ohio 45202
 513.559.0048

STATE OF OHIO
 JOSEPH A. BODKIN
 REGISTERED ARCHITECT
 License #313367
 Expiration Date: 12.31.2025


A306(2)

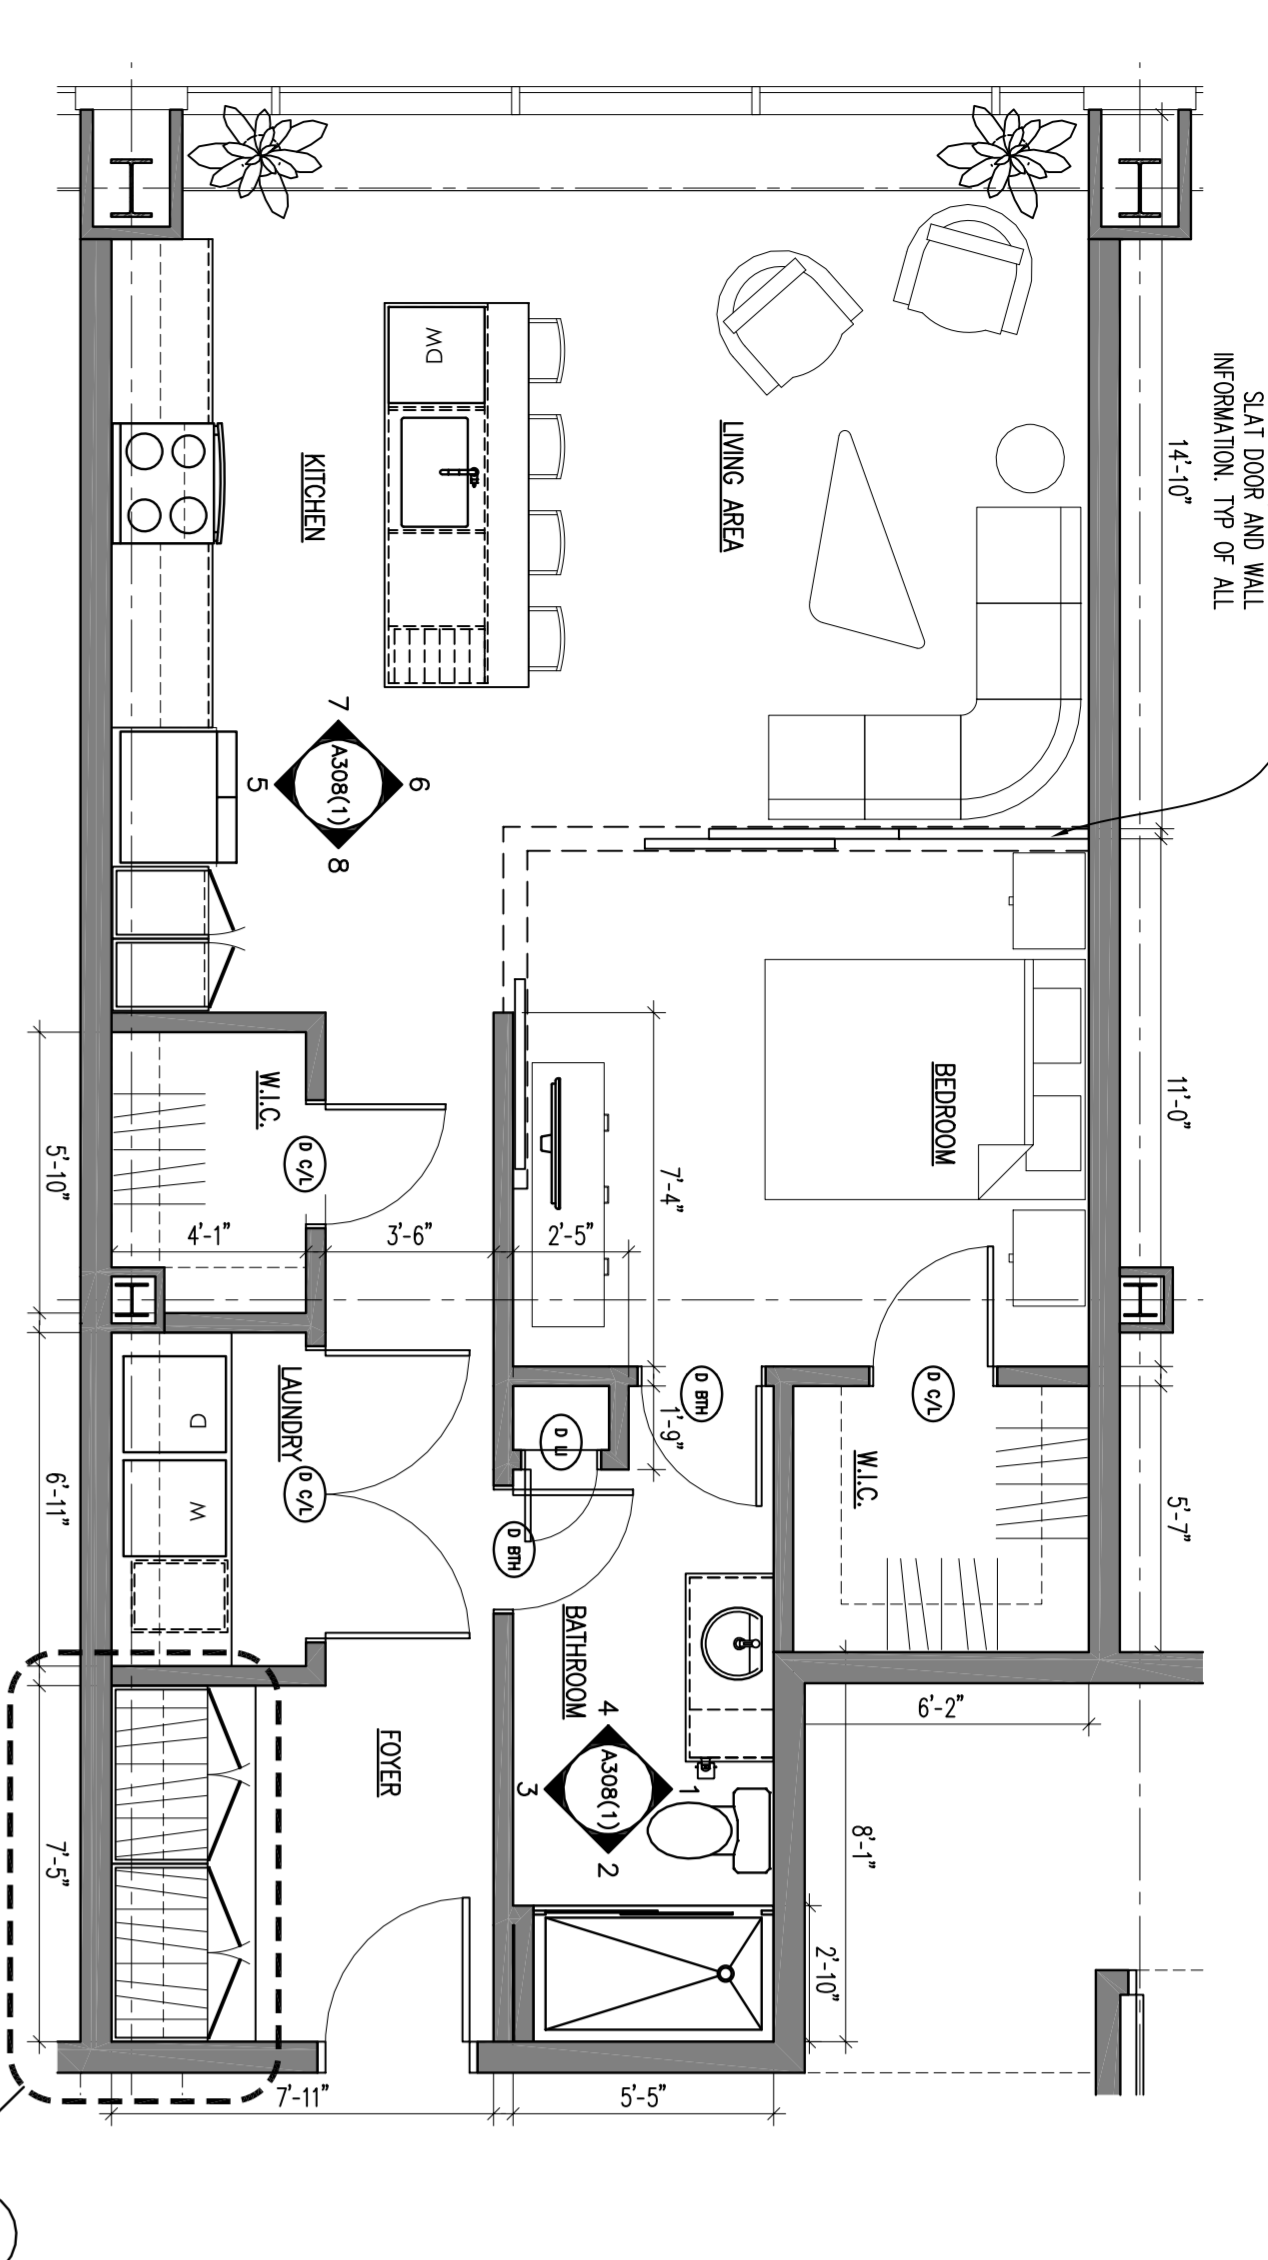


APARTMENT FLOOR PLAN
 SCALE: 1/4" = 1'-0"

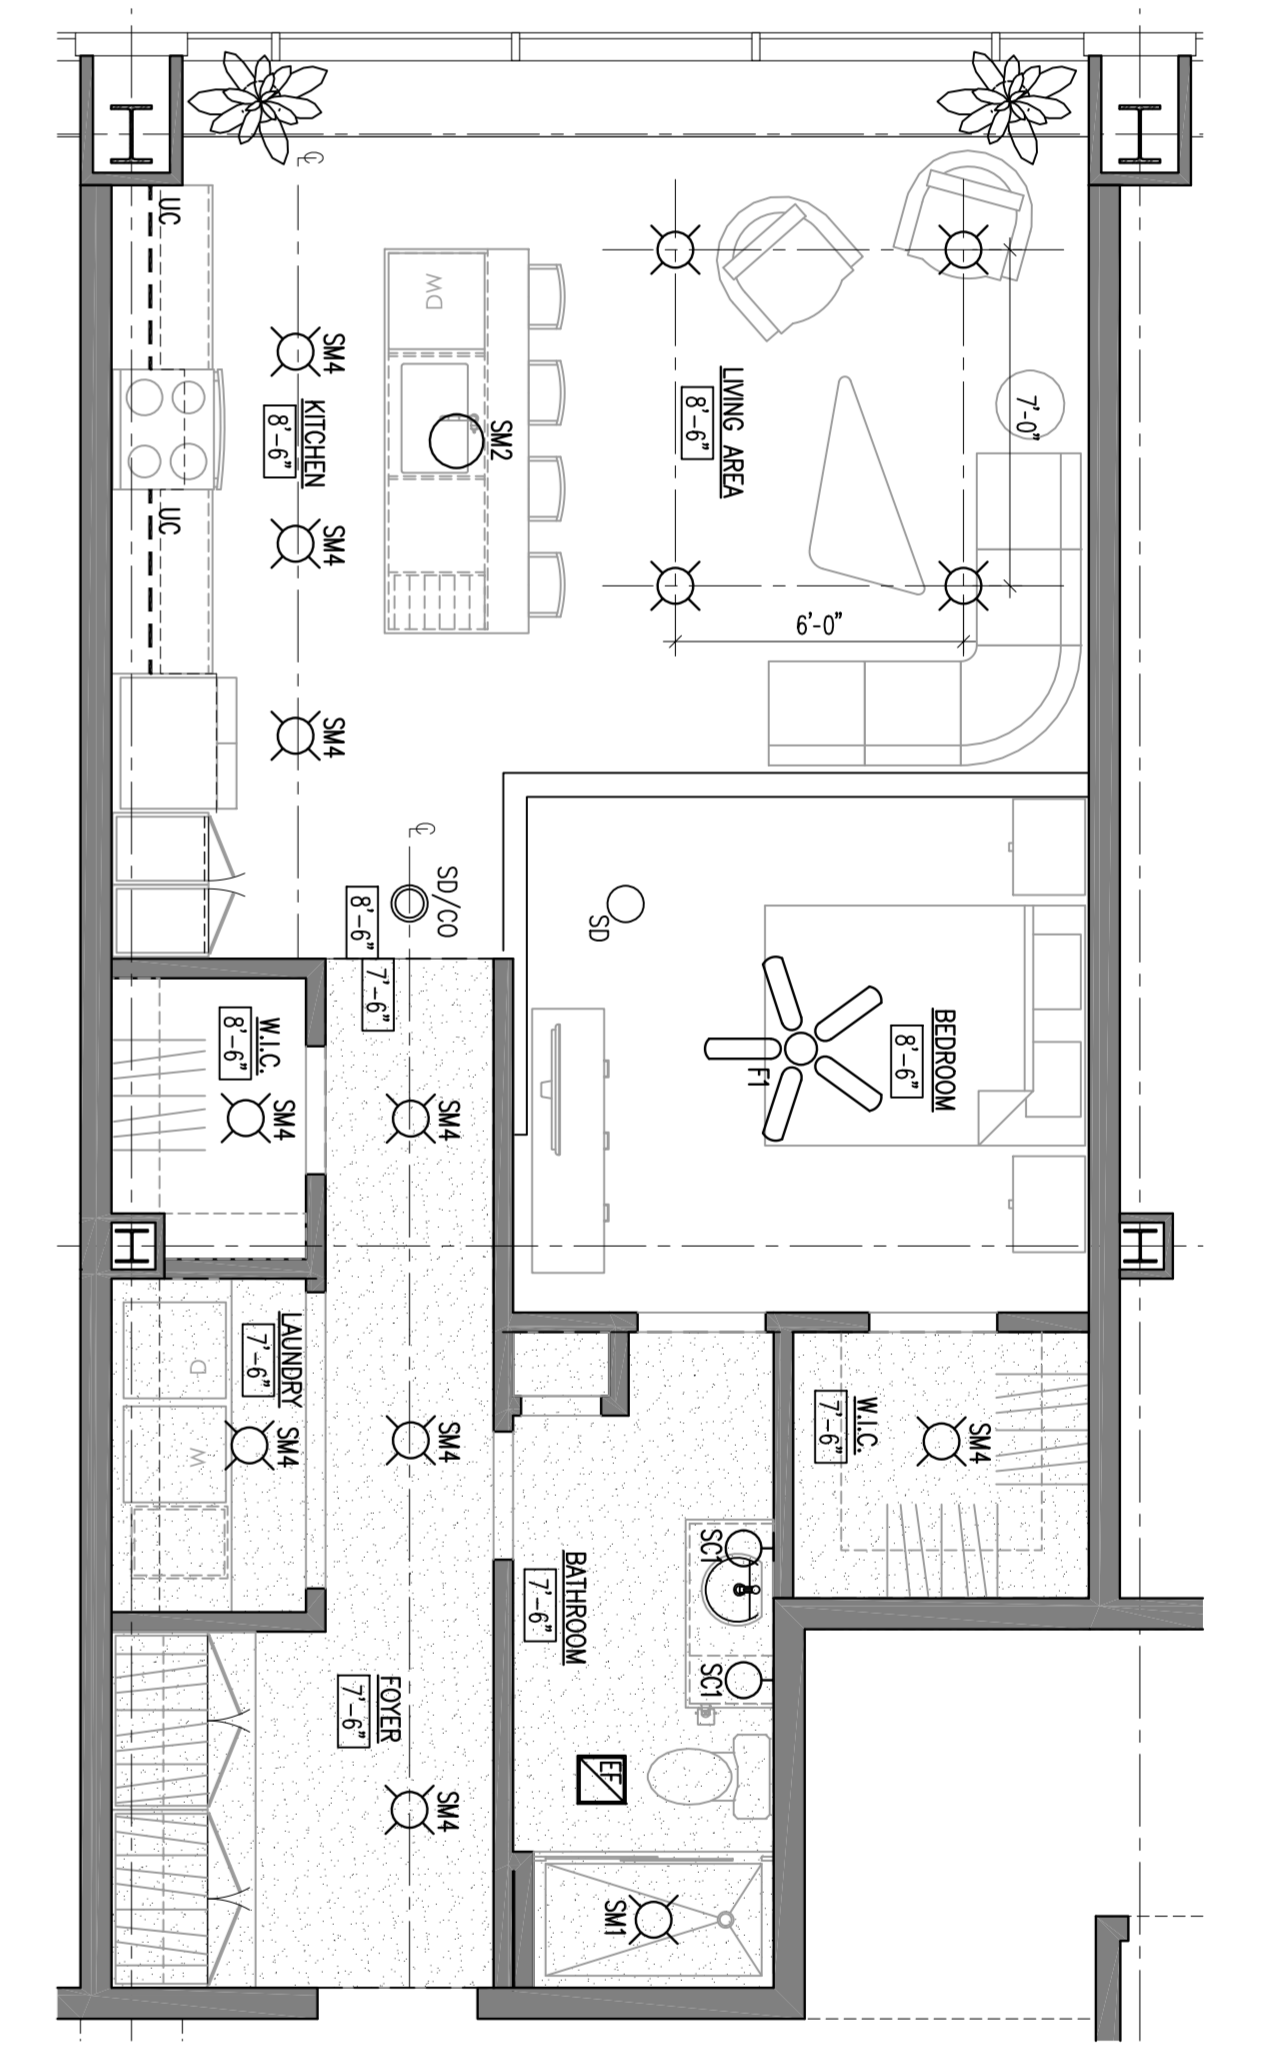


APARTMENT REFLECTED CEILING PLAN
 SCALE: 1/4" = 1'-0"

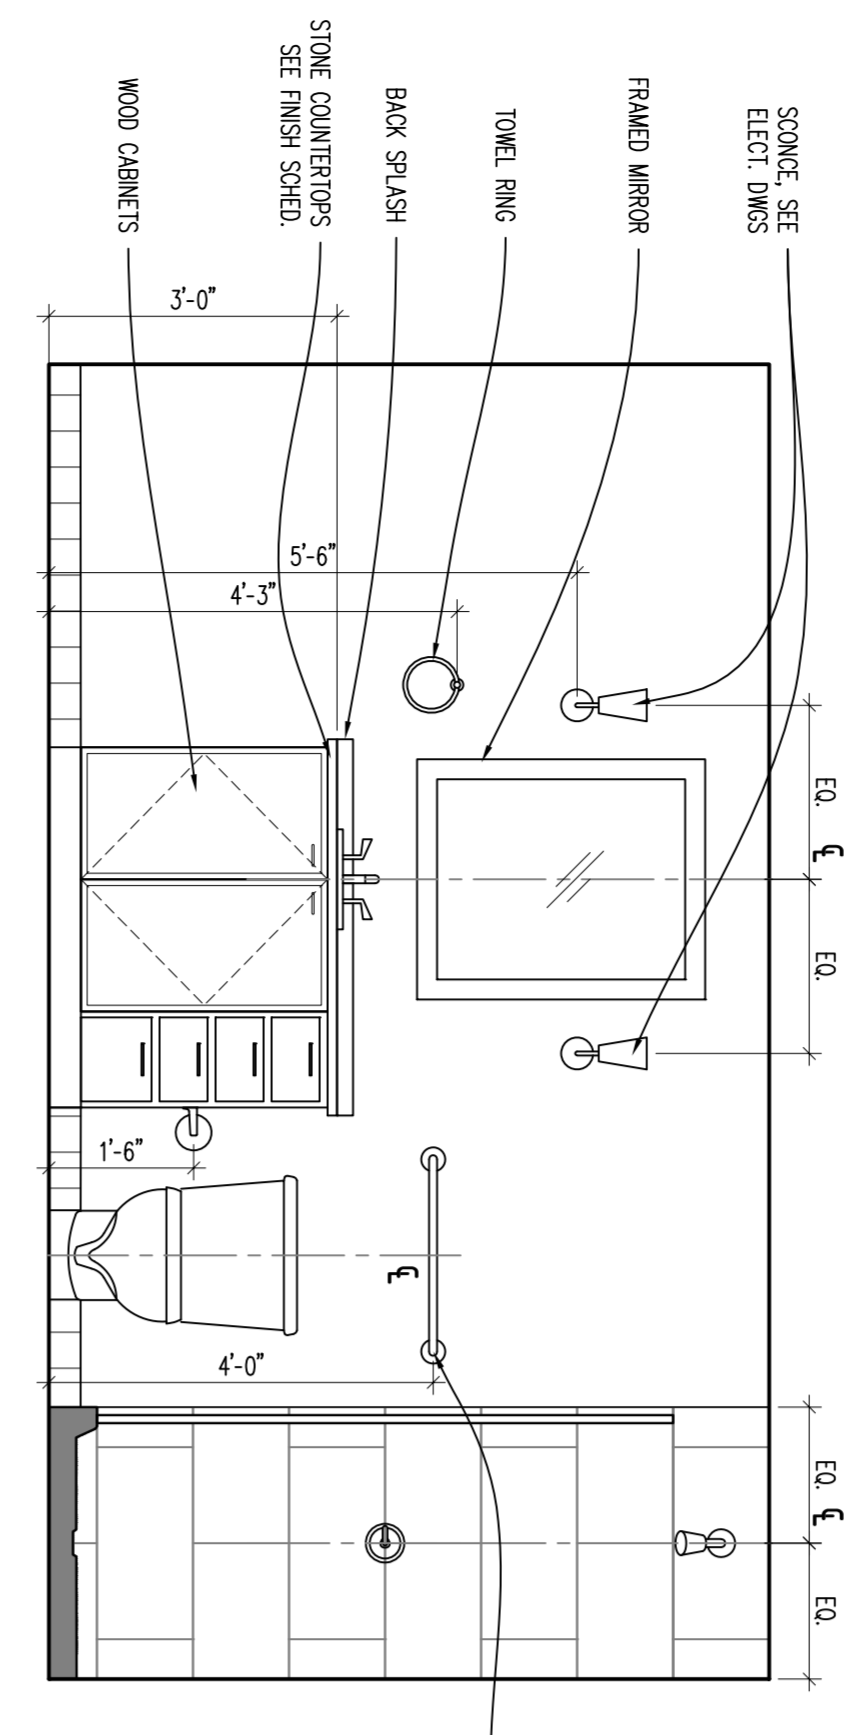


ELEVATION 1
 SCALE: 1/2" = 1'-0"

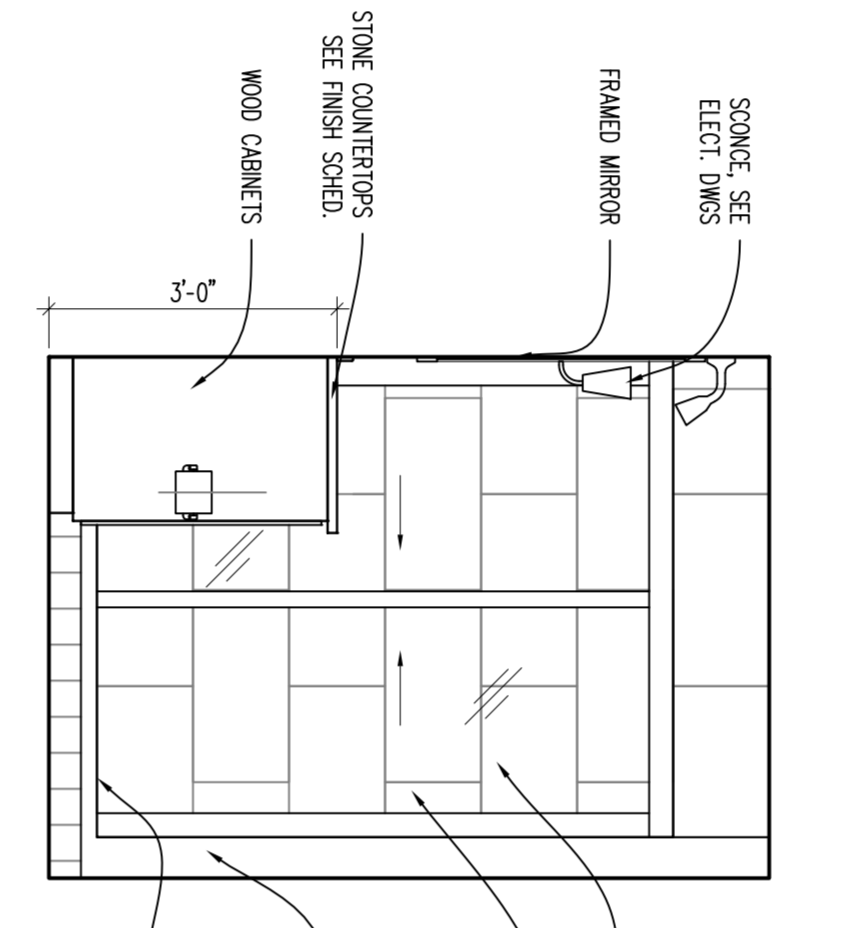


ELEVATION 2
 SCALE: 1/2" = 1'-0"

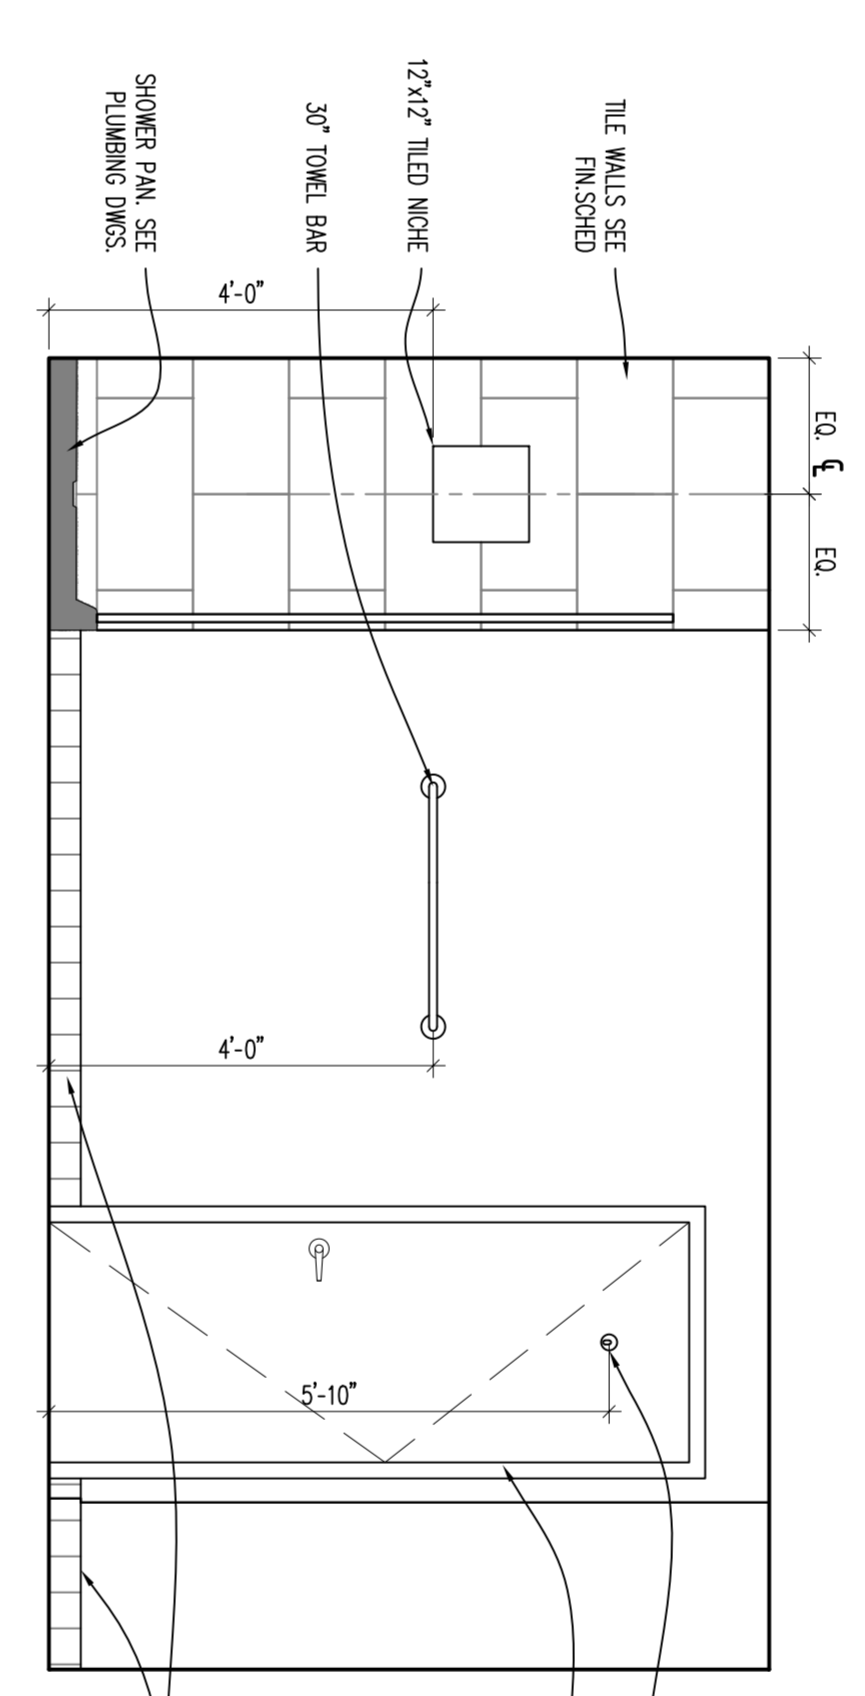


ELEVATION 3
 SCALE: 1/2" = 1'-0"

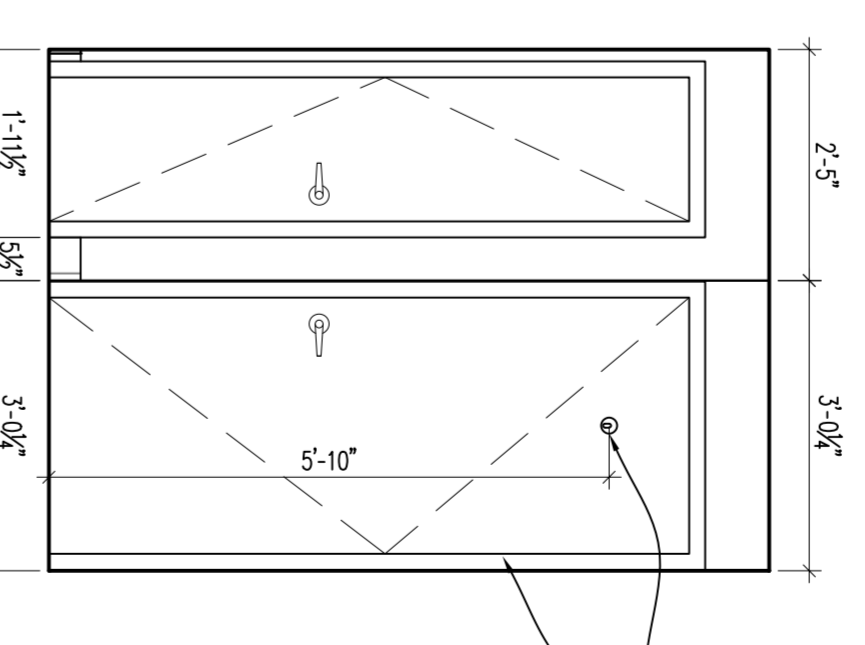


ELEVATION 4
 SCALE: 1/2" = 1'-0"

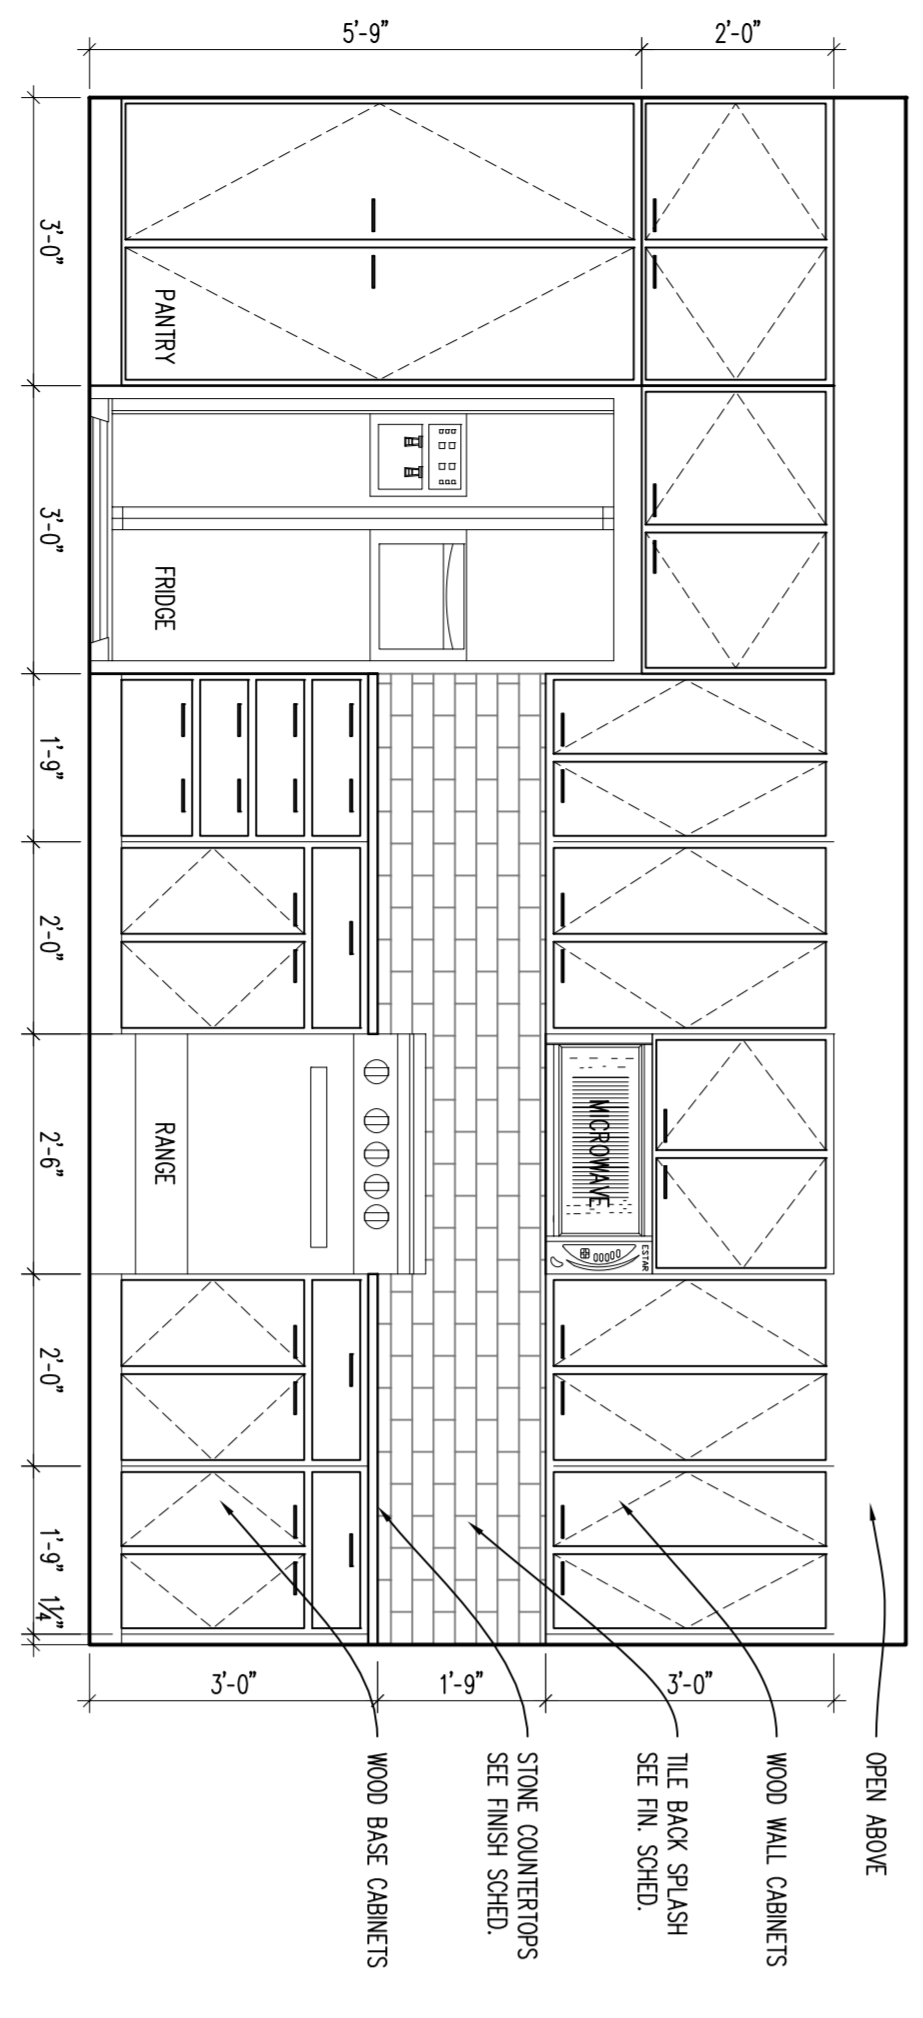


ELEVATION 5
 SCALE: 1/2" = 1'-0"

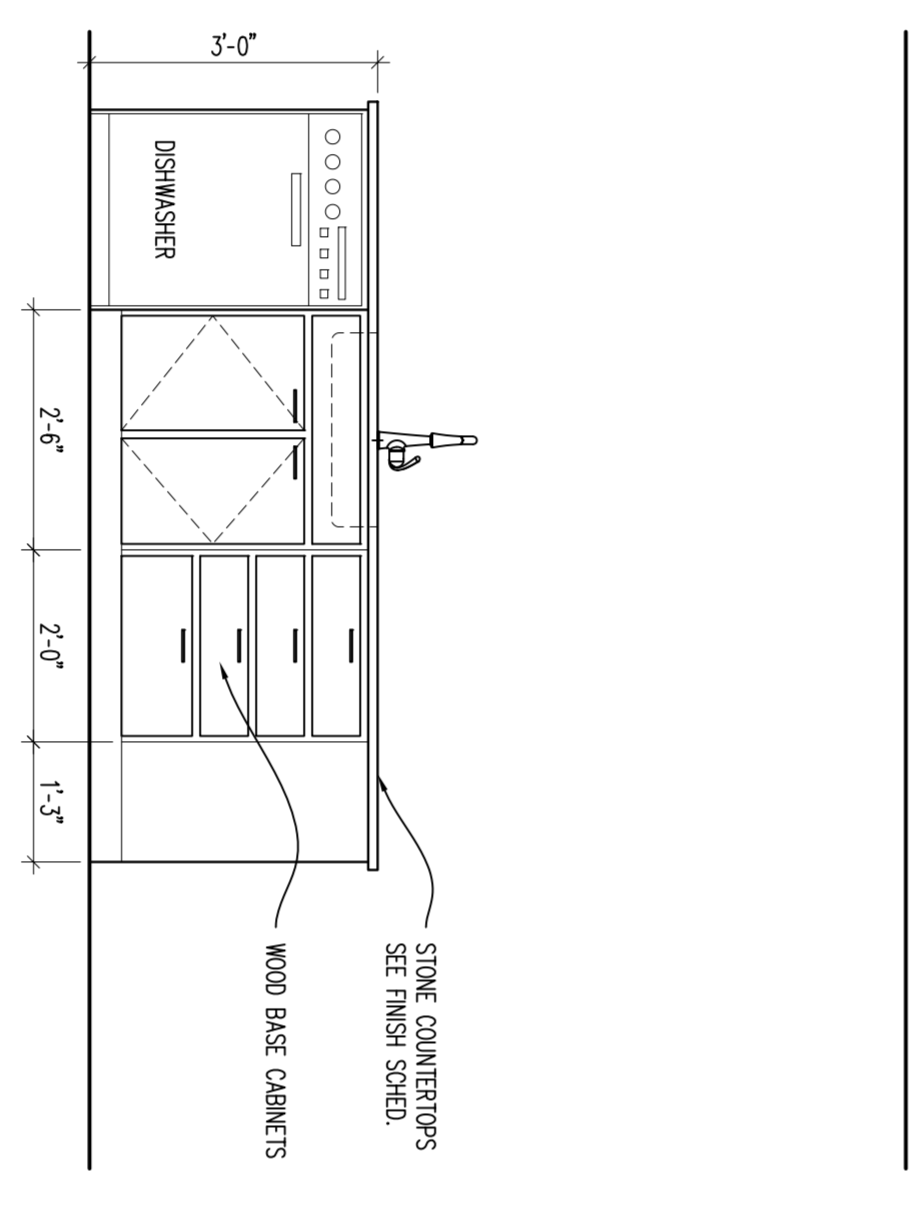

ELEVATION 6
 SCALE: 1/2" = 1'-0"

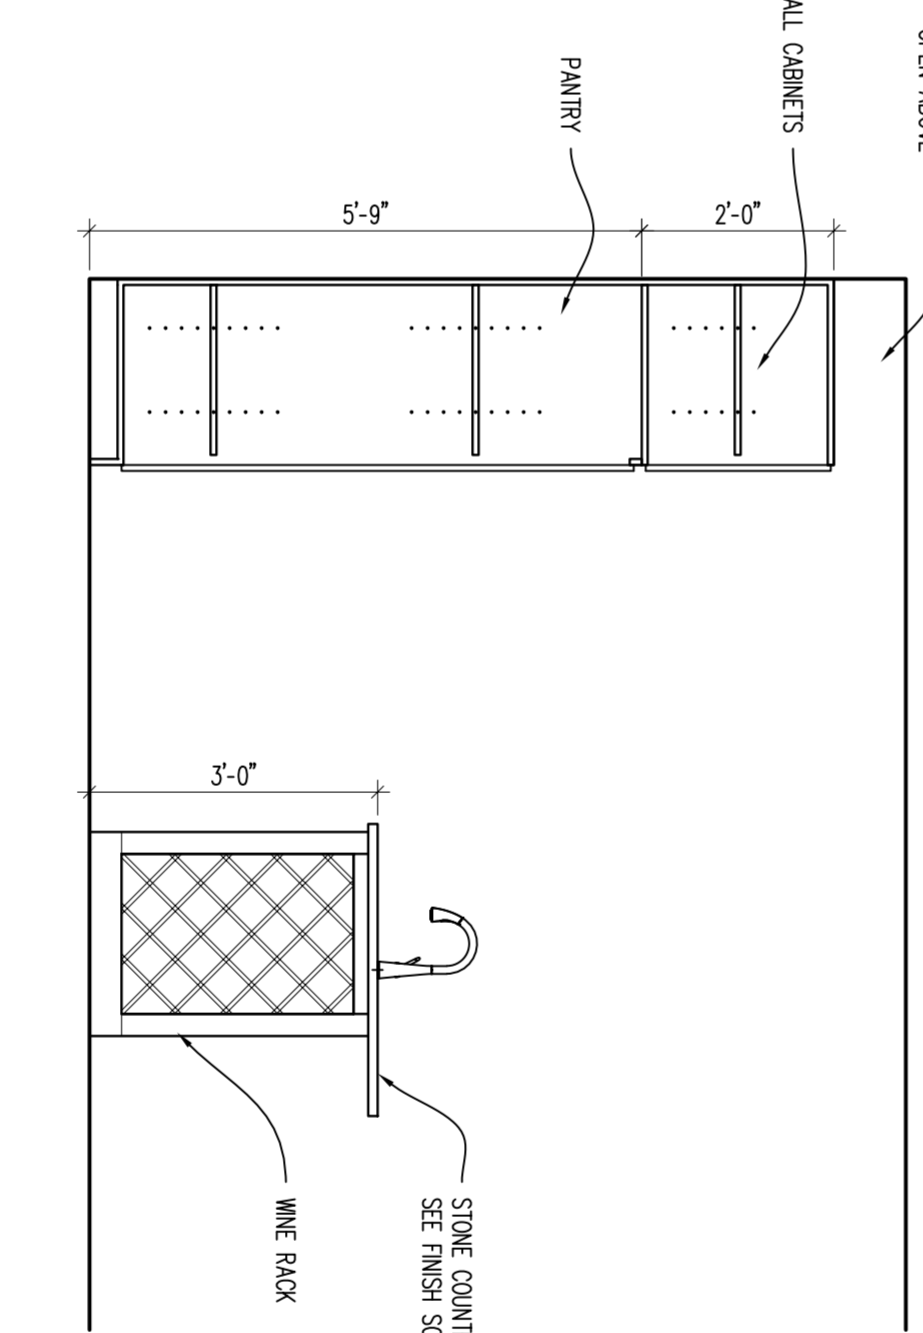

ELEVATION 7
 SCALE: 1/2" = 1'-0"

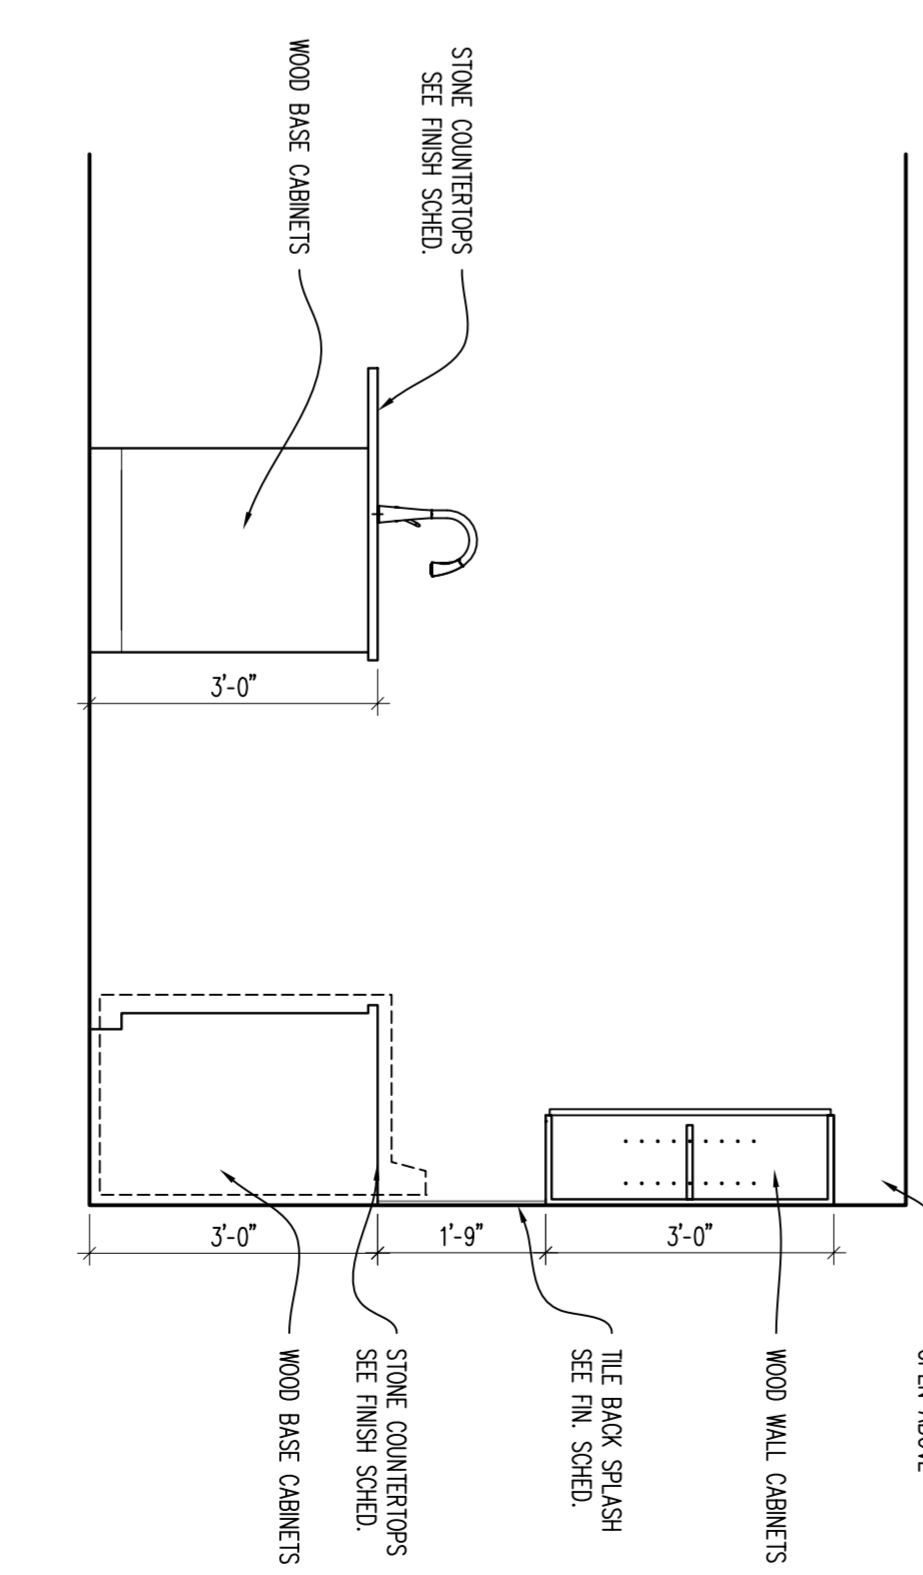

ELEVATION 8
 SCALE: 1/2" = 1'-0"

APARTMENT ROOM FINISH SCHEDULE

ROOM NAME	FLOOR	BASE	WALLS				CEILING	REMARKS
			NORTH	SOUTH	EAST	WEST		
LIVING AREA	VP-1	RB-3	PT-1	PT-1	PT-1	PT-1	NOTES A	
KITCHEN	VP-1	RB-3	PT-1	PT-1	PT-1	PT-3	NOTES A	
WALK-IN CLOSET	VP-1	RB-3	PT-1	PT-1	PT-1	PT-3	NOTES A	
BEDROOM	VP-1	RB-3	PT-1	PT-1	PT-1	PT-3	NOTES A	
BATHROOM	VP-1	RB-3	PT-1	PT-1	PT-1	PT-3	NOTES A	
FOYER / CORRIDOR	VP-1	RB-3	PT-1	PT-1	PT-1	PT-3	NOTES A	
WALK-IN CLOSET	VP-1	RB-3	PT-1	PT-1	PT-1	PT-3	NOTES A	
LAUNDRY	VP-1	RB-3	PT-1	PT-1	PT-1	PT-3	NOTES A	
LOBBY	VP-1	RB-3	PT-1	PT-1	PT-1	PT-3	NOTES A	

APARTMENT DOOR SCHEDULE

DOOR MARK	DOOR LOCATION	DOOR INFORMATION			FRAME INFORMATION			HW. SET	FIRE RATING	REMARKS		
		WIDTH	HEIGHT	THICK	STYLE	DOOR MATERIAL	TYPE				FRAME MATERIAL	
D (L)	BATHROOM	2'-8"	6'-8"	1 3/8"	2	OK	A	WD	5/4800	6/4800	2	PRE-FINISH STAINED
D (L)	WALK-IN CLOSET	2'-6"	6'-8"	1 3/8"	2	OK	A	WD	5/4800	6/4800	3	PRE-FINISH STAINED
D (L)	LAUNDRY	3'-0"	6'-8"	1 3/8"	2	OK	A	WD	5/4800	6/4800	4	PRE-FINISH STAINED
D (L)	LOBBY	1'-6"	6'-8"	1 3/8"	2	OK	A	WD	5/4800	6/4800	3	PRE-FINISH STAINED

- GENERAL APARTMENT NOTES
- DOOR FRAME SHALL BE 4" FROM FACE OF WALL TO
 - BACKGROUND OF FRAME UNLESS TYPE 3 UNLESS
 - INDICATED OTHERWISE.
 - ALL DIMENSIONS ARE FROM FINISH FACE OF WALL TO FINISH
 - FACE OF WALL UNLESS INDICATED OTHERWISE.
 - ALL LIGHTING FIXTURES SHALL BE NEW.
 - ALL CABINET DRAWERS ARE FOR DESIGN AND ONLY
 - FOR INFORMATION. ALL DIMENSIONS ARE TO CENTER
 - UNLESS OTHERWISE NOTED.
 - ALL FINISHES SHALL BE AS SHOWN ON FINISH SCHEDULE
 - REVIEW BASIS OF DESIGN AND SMART CABINETS
 - INCLUDES CABINETS THAT ARE UP AGAINST THE BUILDINGS
 - AND/OR FRAMING THE WINDOW, TOP OF ALL
 - ENERGY STAR APPLIANCES (REFRIGERATOR, DISH WASHER, ENERGY STAR APPLIANCES) SHALL BE NEW
 - PROVIDE REWORKING FOR FUTURE SWAP BARS IN ALL UNIT
 - ALL BATH AND LINEN CLOSETS TO RECEIVE FINE (5)
 - AUTOMATIC MECHANICAL SHUTTERS.
 - COAT HOOD UNITS TO BE PROVIDED W/ GLASS SHOWER DOOR.
 - EACH SHOWER TO BE PROVIDED W/ GLASS SHOWER DOOR.
 - PROVIDE AND INSTALL IN EACH APARTMENT (2) TOWER
 - BRASS (1) TOWER (PUSH BUTTON) (1) ROSE GOLD.

Project: Formica Building
 115 E 5th Street
 Cincinnati, Ohio 45202
 Sheet Title: Unit 1 - 11th Construction
 Project No: 2022_259 Issue Date:
 Scale: As Noted Drawn: Checked:

No.	Revisions	Date
1	ENG CHG #1	11.14.2022

A308.1

Formica Building


Office/Apartments
 Auditor Address: 115 E. 5th Street, Actual Address: 120 E. 4th Street
 Cincinnati OH 45202

modelgroup
 DEVELOPMENT • CONSTRUCTION • MANAGEMENT


1826 Race Street
 Cincinnati, Ohio 45202
 513.559.0048

STATE OF OHIO
JOSEPH A. BODKIN
 5133567
 REGISTERED ARCHITECT


Joseph A. Bodkin, License #5133567
 Expiration Date: 12.31.2025

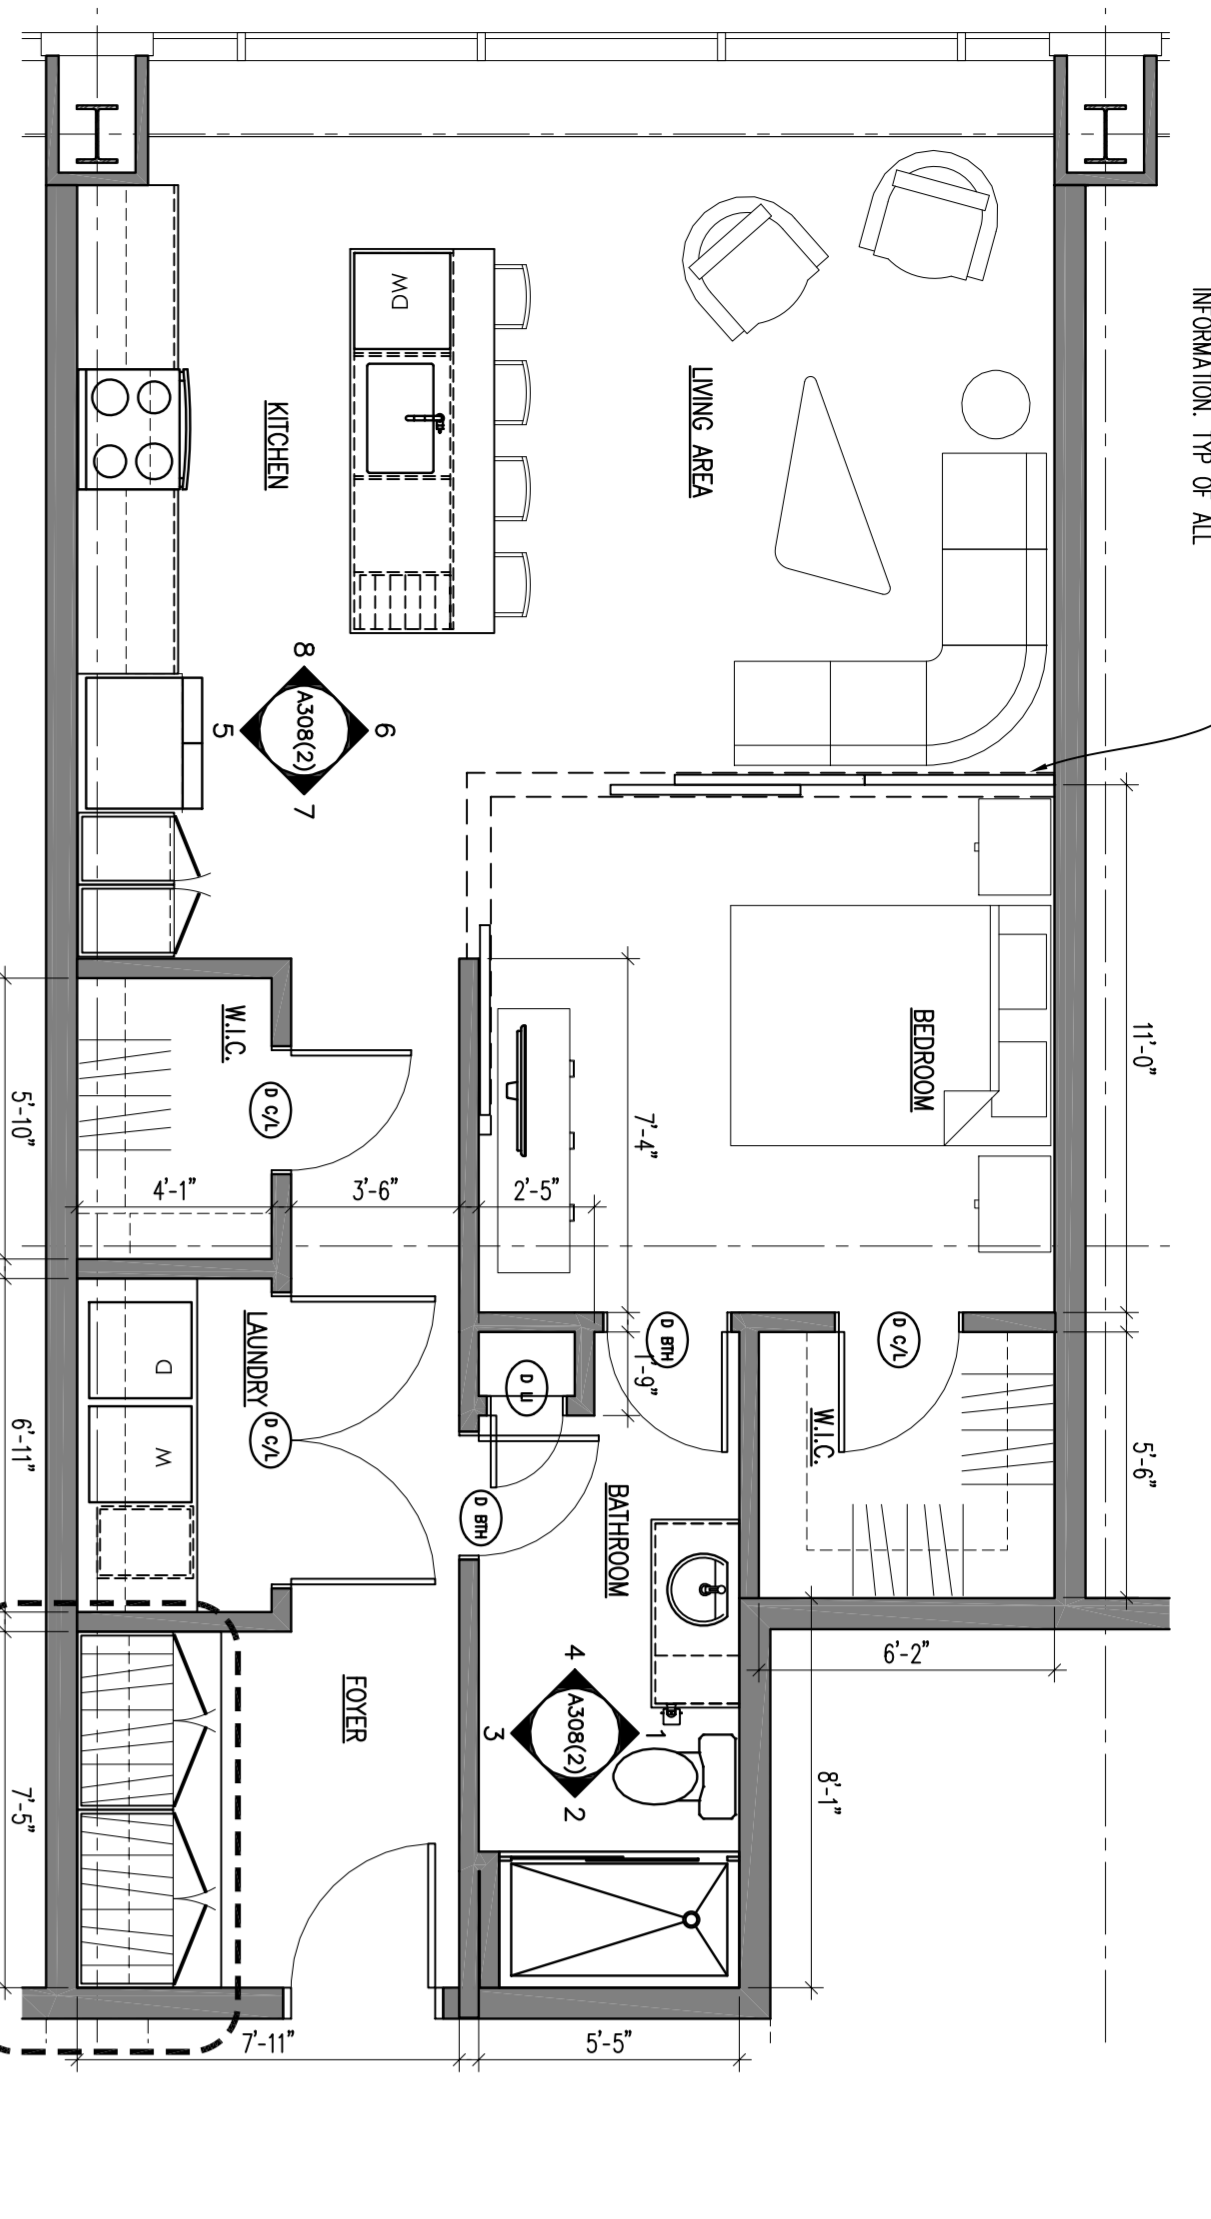


APARTMENT FLOOR PLAN
 SCALE: 1/4" = 1'-0"
 (1) A308.2

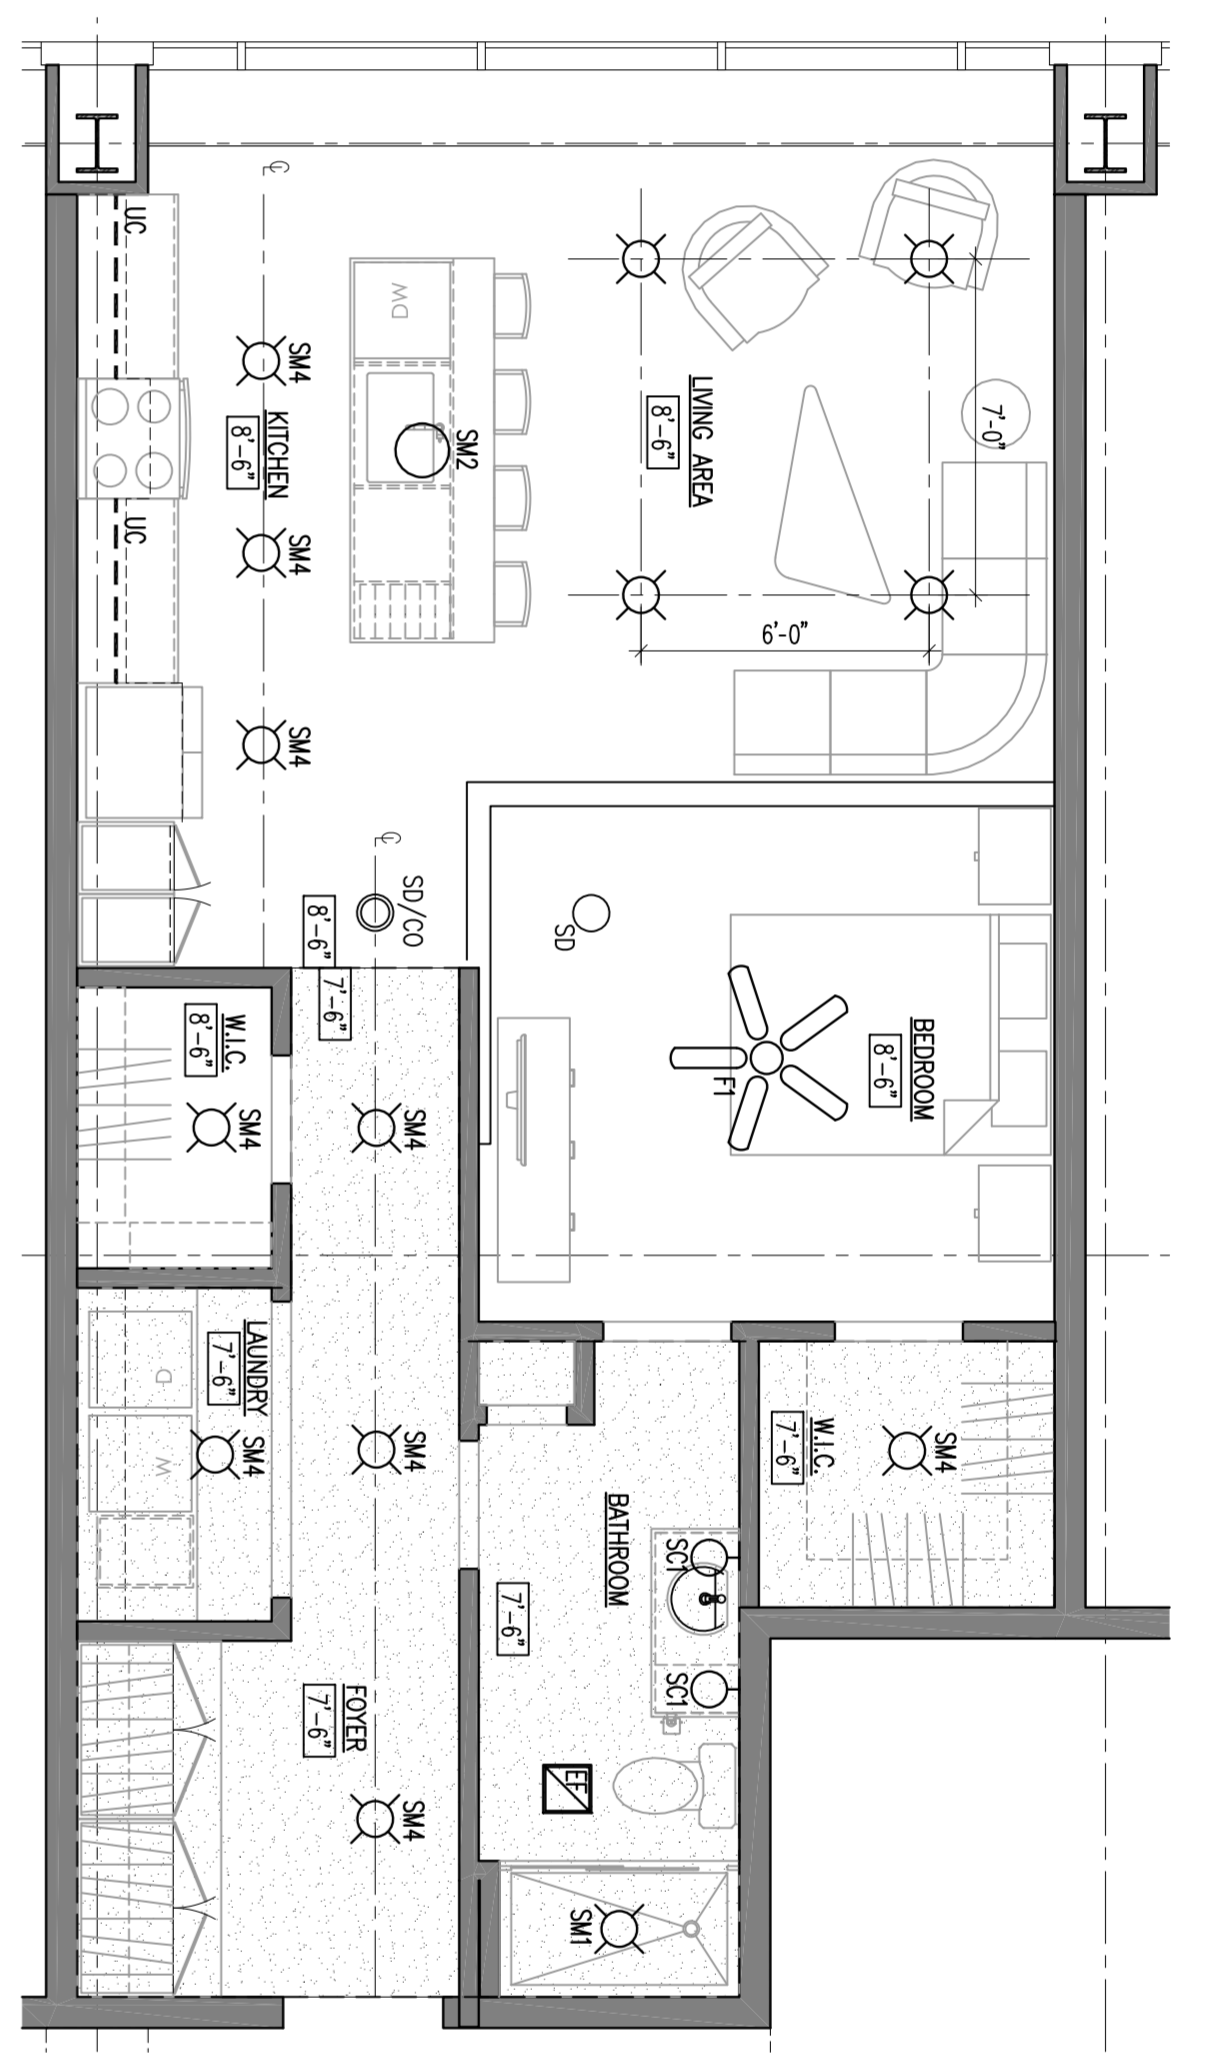


APARTMENT REFLECTED CEILING PLAN
 SCALE: 1/4" = 1'-0"
 (2) A308.2

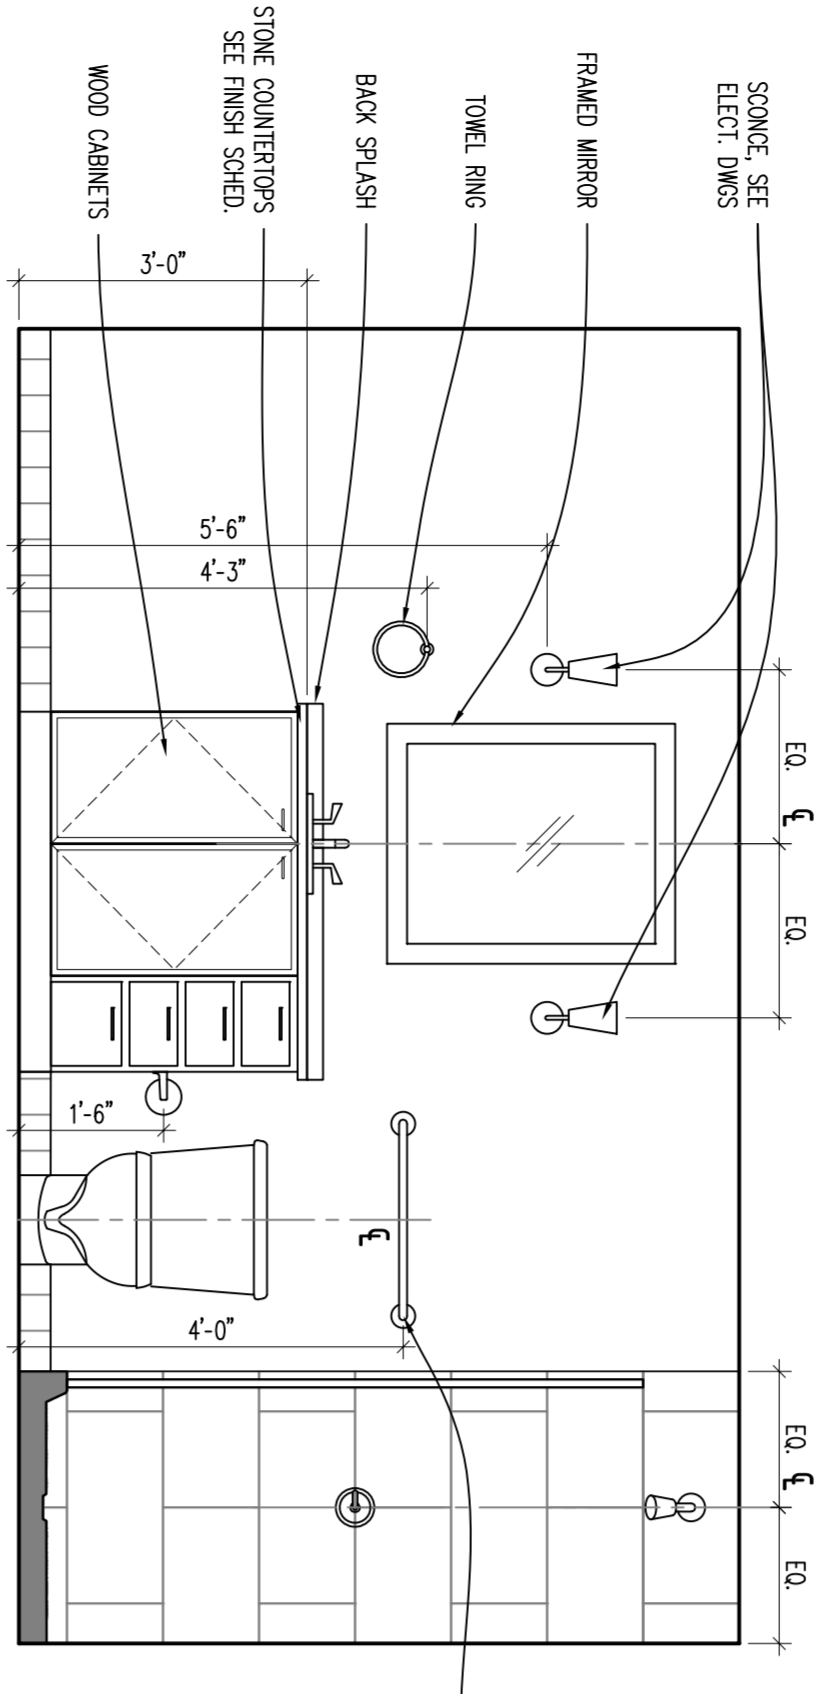


ELEVATION
 SCALE: 1/2" = 1'-0"
 (1) A308.2

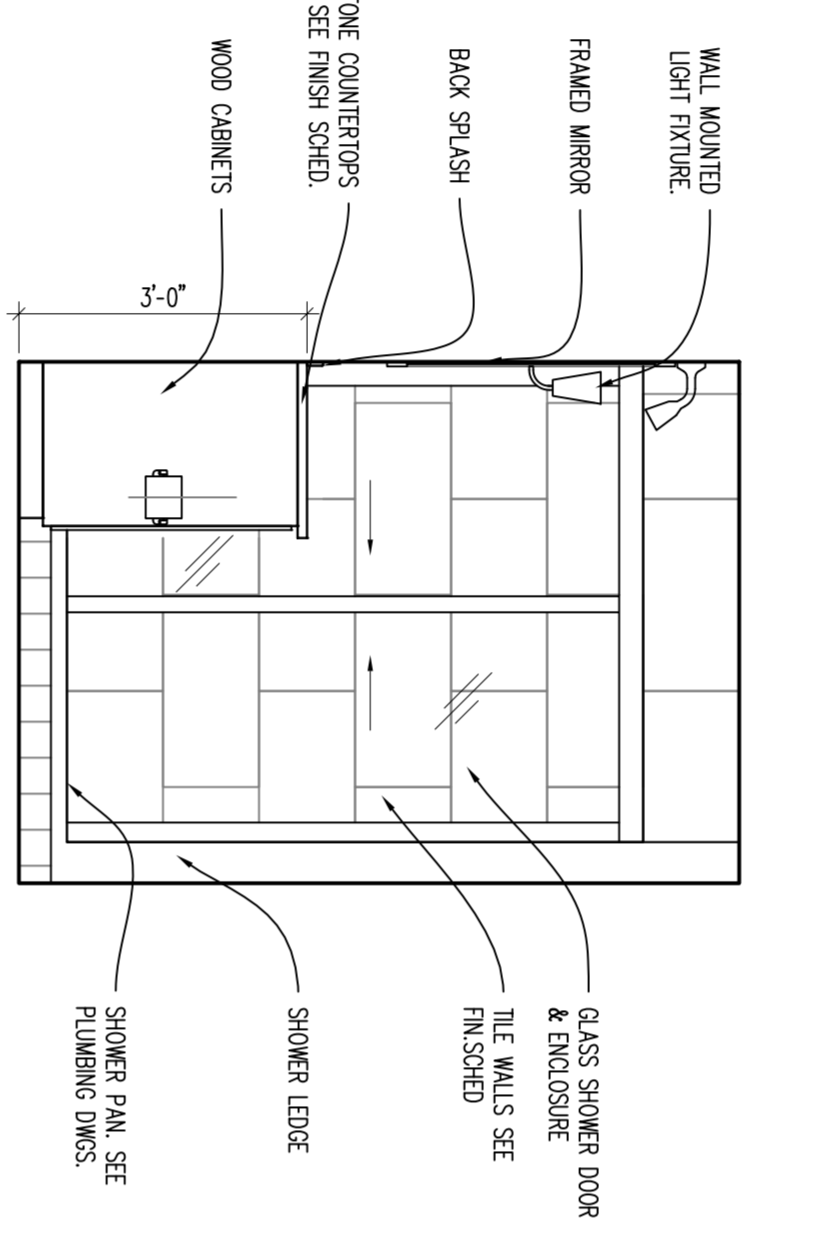


ELEVATION
 SCALE: 1/2" = 1'-0"
 (2) A308.2

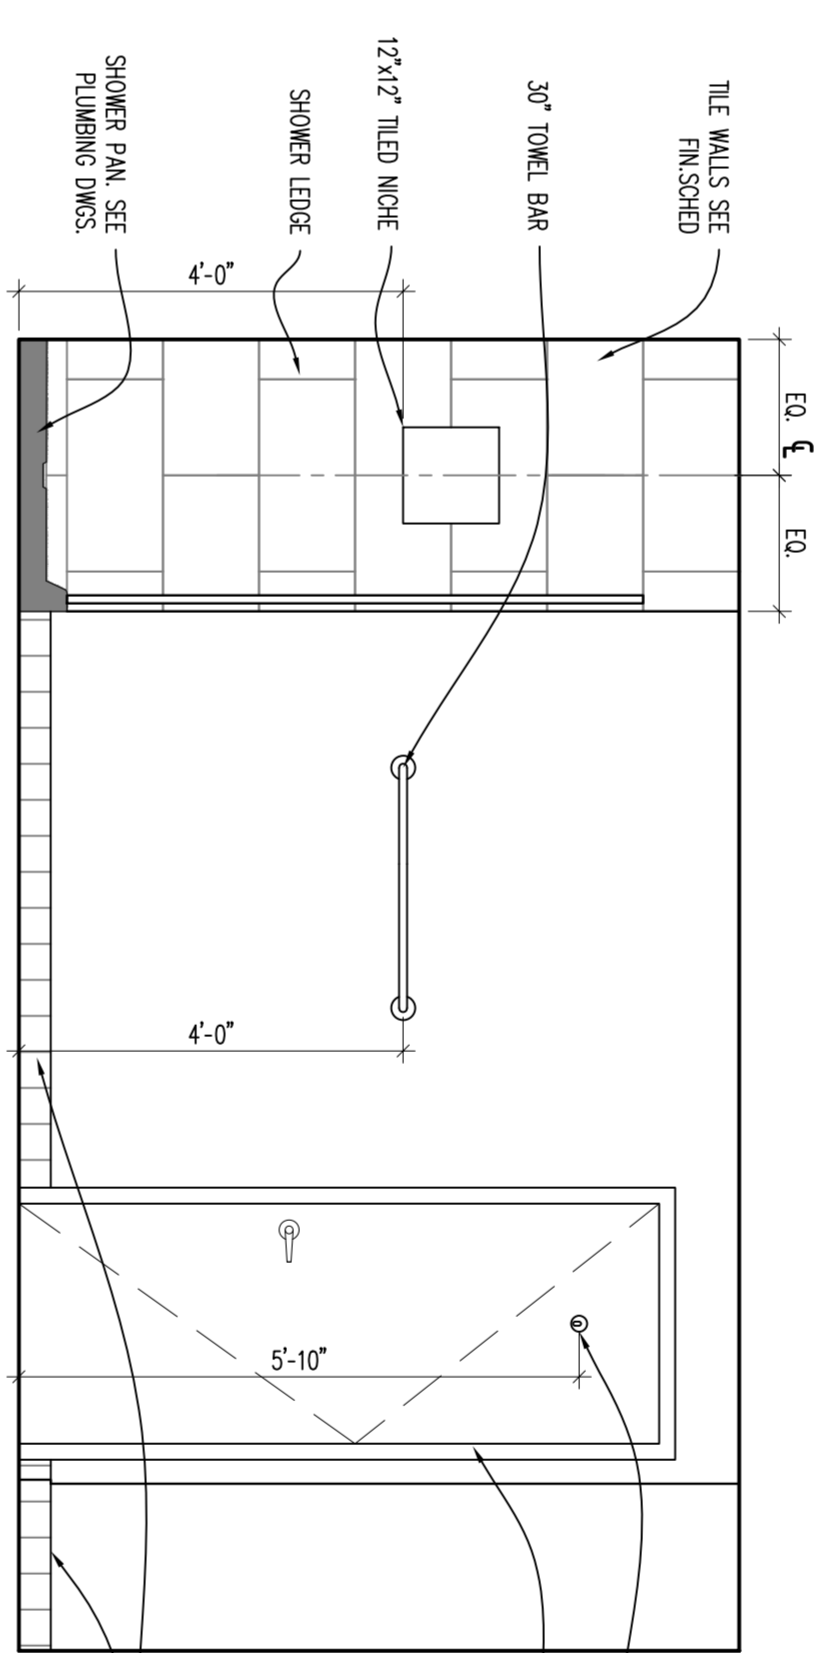


ELEVATION
 SCALE: 1/2" = 1'-0"
 (3) A308.2

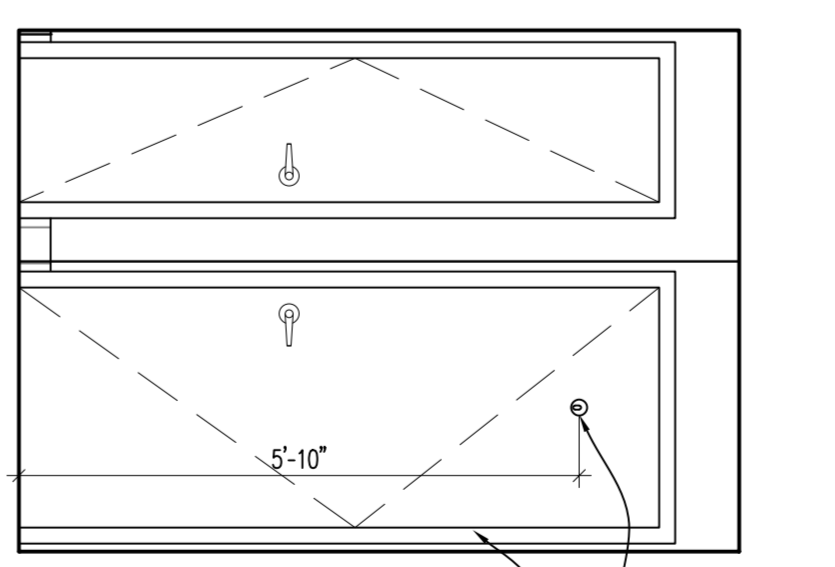


ELEVATION
 SCALE: 1/2" = 1'-0"
 (4) A308.2

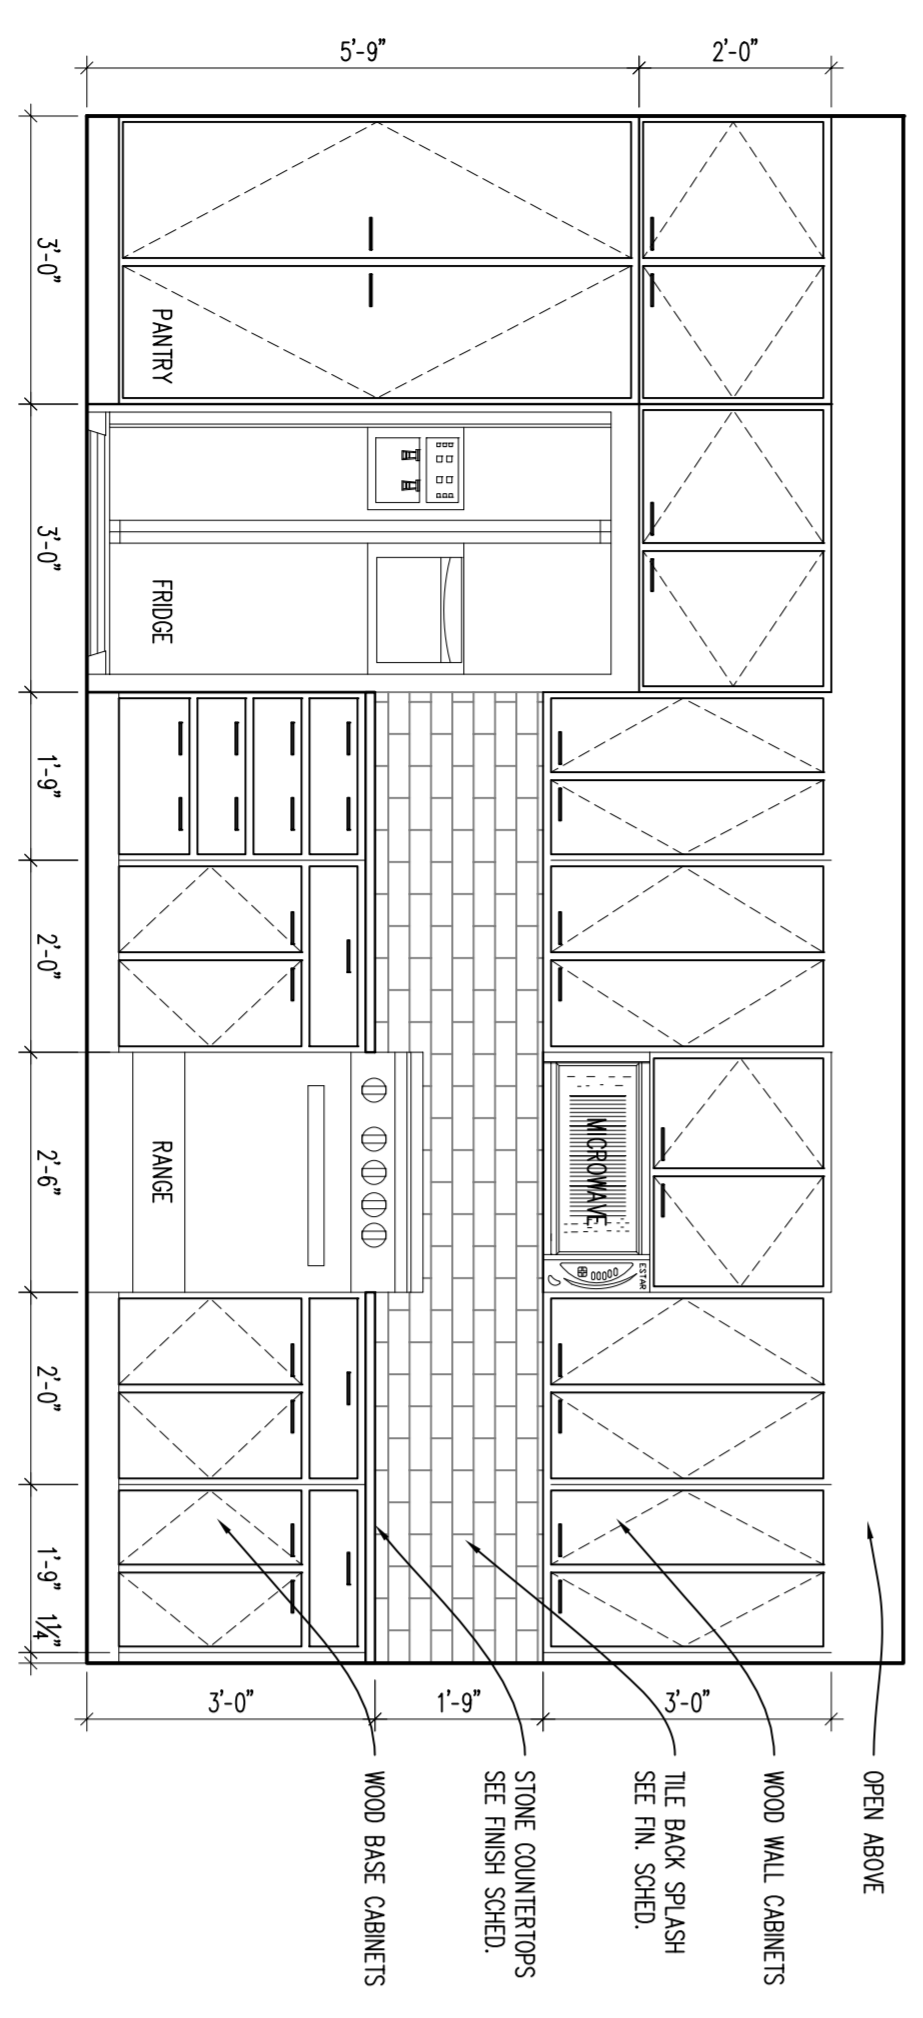


ELEVATION
 SCALE: 1/2" = 1'-0"
 (5) A308.2

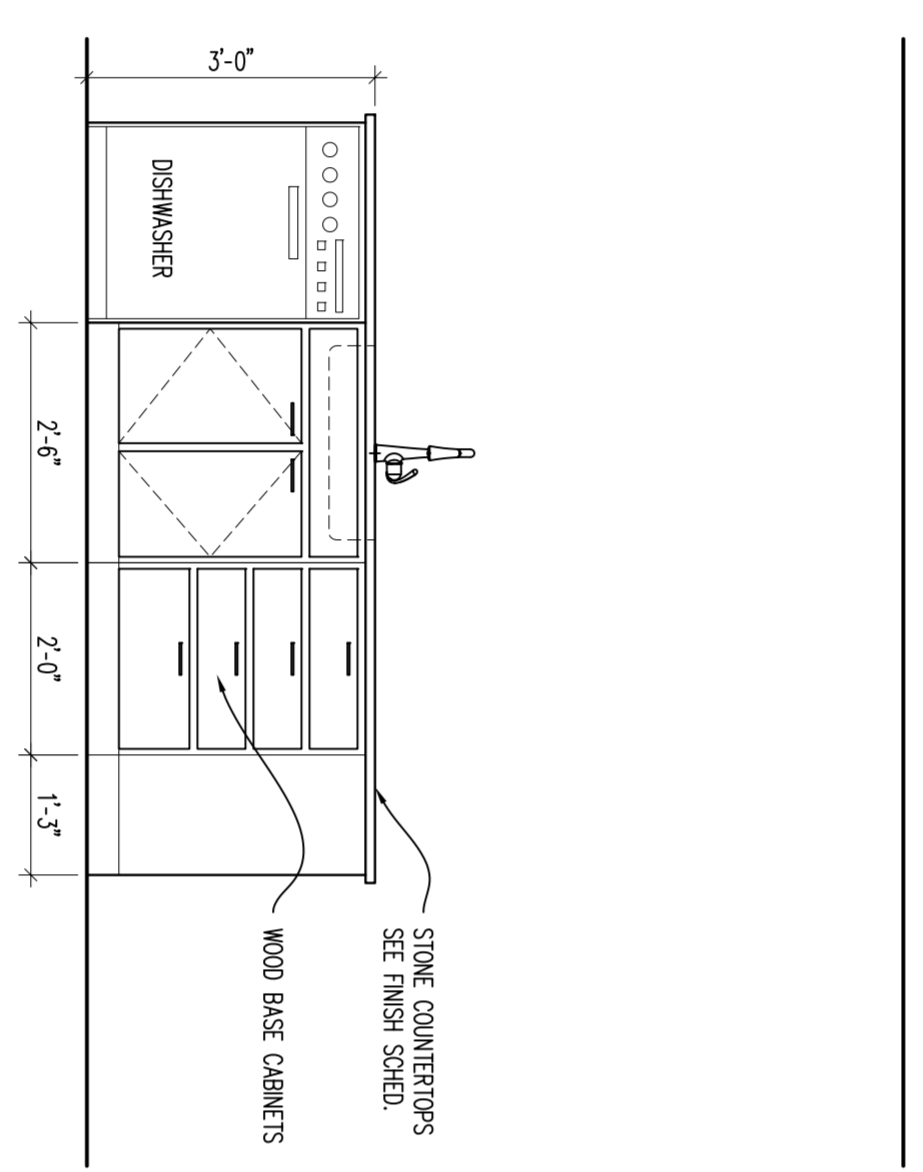

ELEVATION
 SCALE: 1/2" = 1'-0"
 (6) A308.2

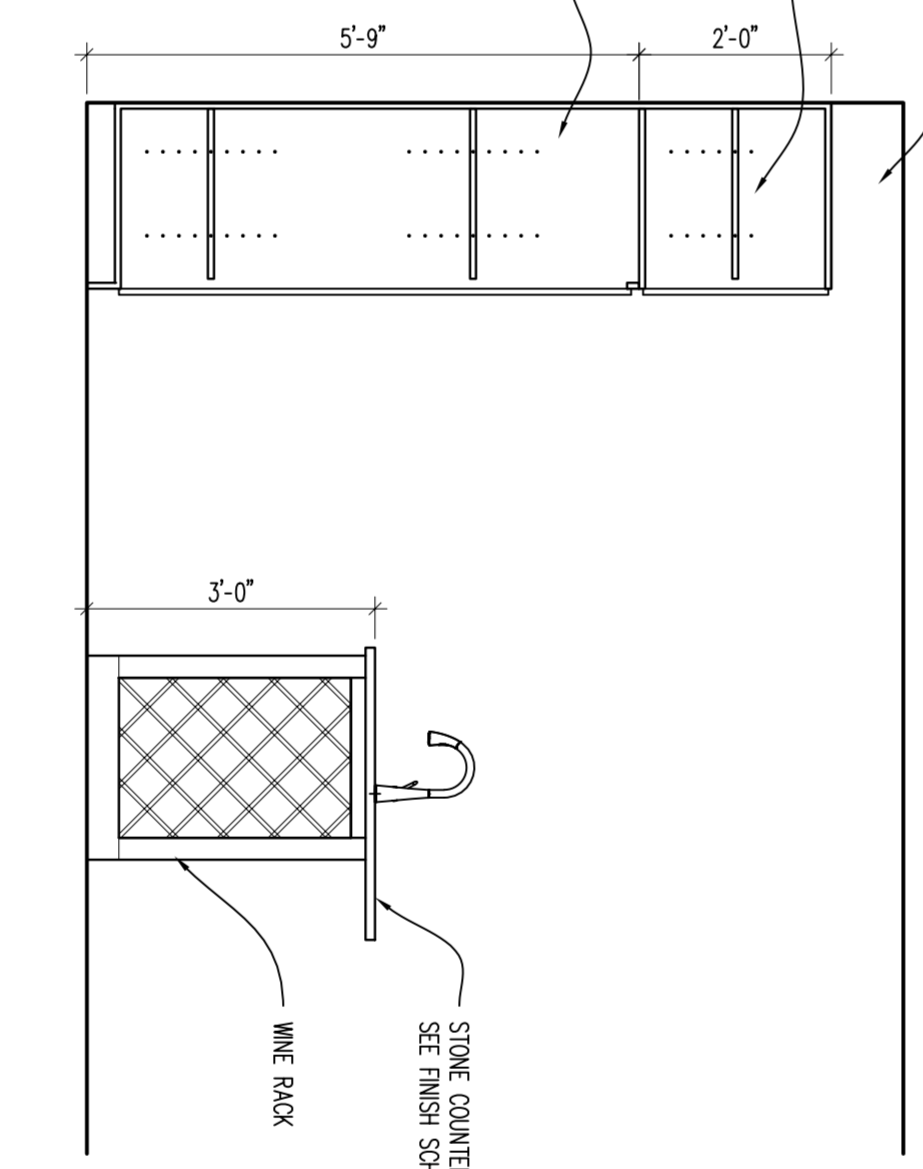

ELEVATION
 SCALE: 1/2" = 1'-0"
 (7) A308.2

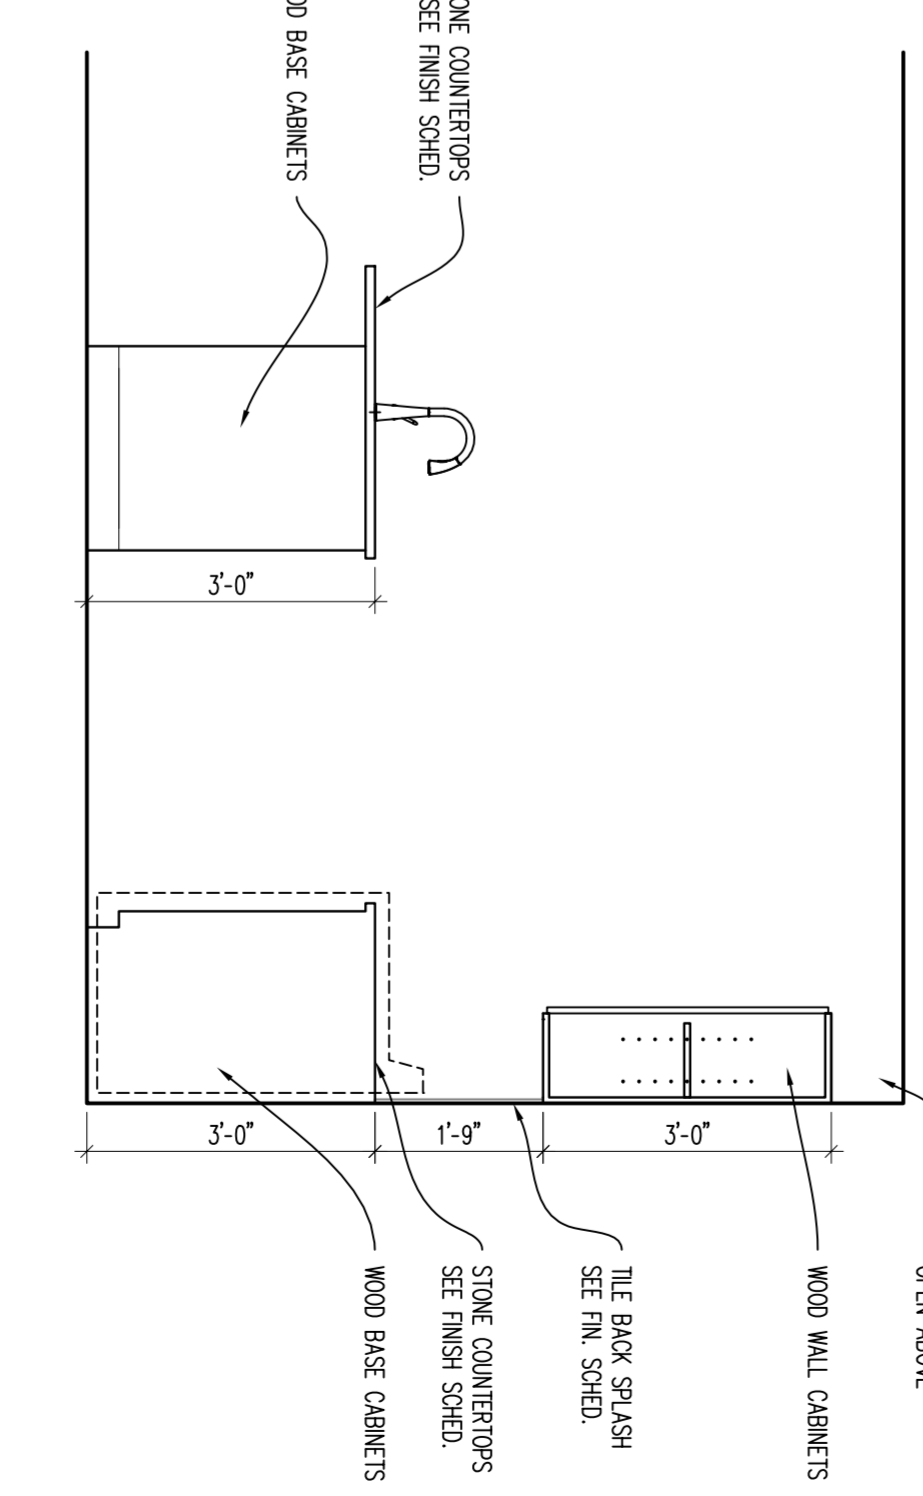

ELEVATION
 SCALE: 1/2" = 1'-0"
 (8) A308.2

APARTMENT ROOM FINISH SCHEDULE						
ROOM NAME	FLOOR	BASE	WALLS			REMARKS
			NORTH	SOUTH	EAST WEST	
LIVING AREA	VP-1	RB-3	PT-1	PT-1	PT-1	NOTES: A
KITCHEN	VP-1	RB-3	PT-1	PT-1	PT-1	NOTES: A
WALK-IN CLOSET	VP-1	RB-3	PT-1	PT-1	PT-1	NOTES: A
BEDROOM	VP-1	RB-3	PT-1	PT-1	PT-1	NOTES: A
BATHROOM	VP-1	RB-3	PT-1	PT-1	PT-1	NOTES: A
FOYER / CORRIDOR	VP-1	RB-3	PT-1	PT-1	PT-1	NOTES: A
WALK-IN CLOSET	VP-1	RB-3	PT-1	PT-1	PT-1	NOTES: A
LAUNDRY	VP-1	RB-3	PT-1	PT-1	PT-1	NOTES: A

APARTMENT DOOR SCHEDULE							
DOOR MARK	DOOR LOCATION	DOOR INFORMATION			FRAME INFORMATION		REMARKS
		WIDTH	HEIGHT	THICK	DOOR MATERIAL	TYPE	
D BH (C2)	BATHROOM	2'-4"	6'-8"	1 3/8"	OK	A	PRE-FINISH STAINED
D C (C2)	WALK-IN CLOSET	2'-4"	6'-8"	1 3/8"	OK	A	PRE-FINISH STAINED
D L (X)	LAUNDRY	3'-0" (2)	6'-0"	1 3/8"	OK	A	PRE-FINISH STAINED
D U (X)	UNITEN	1'-6"	6'-8"	1 3/8"	OK	A	PRE-FINISH STAINED

- GENERAL APARTMENT NOTES**
- DOOR FRAME SHALL BE 4" FROM FACE OF WALL TO
 - BACKGROUND OF FRAME UNLESS TYPE 3 UNLESS
 - DIMENSIONS ARE FROM FINISH FACE OF WALL TO FINISH
 - FACE OF WALL UNLESS NOTED OTHERWISE
 - ALL LIGHTING FIXTURES SHALL BE TYPE 1 UNLESS
 - NOTED OTHERWISE
 - ALL CABINET FINISHES ARE FOR DESIGN AND ONLY FOR
 - REFERENCE. FINISHES SHALL BE AS SHOWN ON
 - FINISH SCHEDULE UNLESS NOTED OTHERWISE
 - ALL FINISHES SHALL BE TO RECEIVE A
 - MINIMUM OF TWO COATS OF FINISH UNLESS
 - NOTED OTHERWISE
 - AND/OR FINISH THE WINDOWS, TOP OF ALL
 - ENERGY SAVING APPLIANCES SHALL BE NEW
 - PROVIDE REWORKING FOR FUTURE GRID BARS IN ALL UNIT
 - L ALL PANTRY AND LINEN CLOSETS TO RECEIVE FIN. (5)
 - ADJUSTABLE WEARLINE SHELVES.
 - COAT RACK UNLESS NOTED OTHERWISE
 - EACH SHOWER TO BE PROVIDED W/ GLASS SHOWER DOOR.
 - PROVIDE AND INSTALL IN EACH APARTMENT (2) TOWER
 - BRASS (1) TOWER PER FLOOR (1) ROSE FINISH.

A308.2

Project: Formica Building
 115 E 5th Street
 Cincinnati, Ohio 45202

Sheet: Unit 1
 Construction

Project No: 2022_259
 Issue Date: 11.14.2022

Scale: As Noted
 Status: Drawn

Revisions:
 No. 1
 Description: ENG CHG #1
 Date: 11.14.2022

Formica Building

Office/Apartments











Auditor Address: 115 E. 5th Street, Actual Address: 120 E. 4th Street
 Cincinnati OH 45202

modelgroup
 DEVELOPMENT • CONSTRUCTION • MANAGEMENT

1826 Race Street
 Cincinnati, Ohio 45202
 513.559.0048

STATE OF OHIO
JOSEPH A. BODKIN
 5133567
 REGISTERED ARCHITECT

Joseph A. Bodkin, License #5133567
 Expiration Date: 12.31.2025

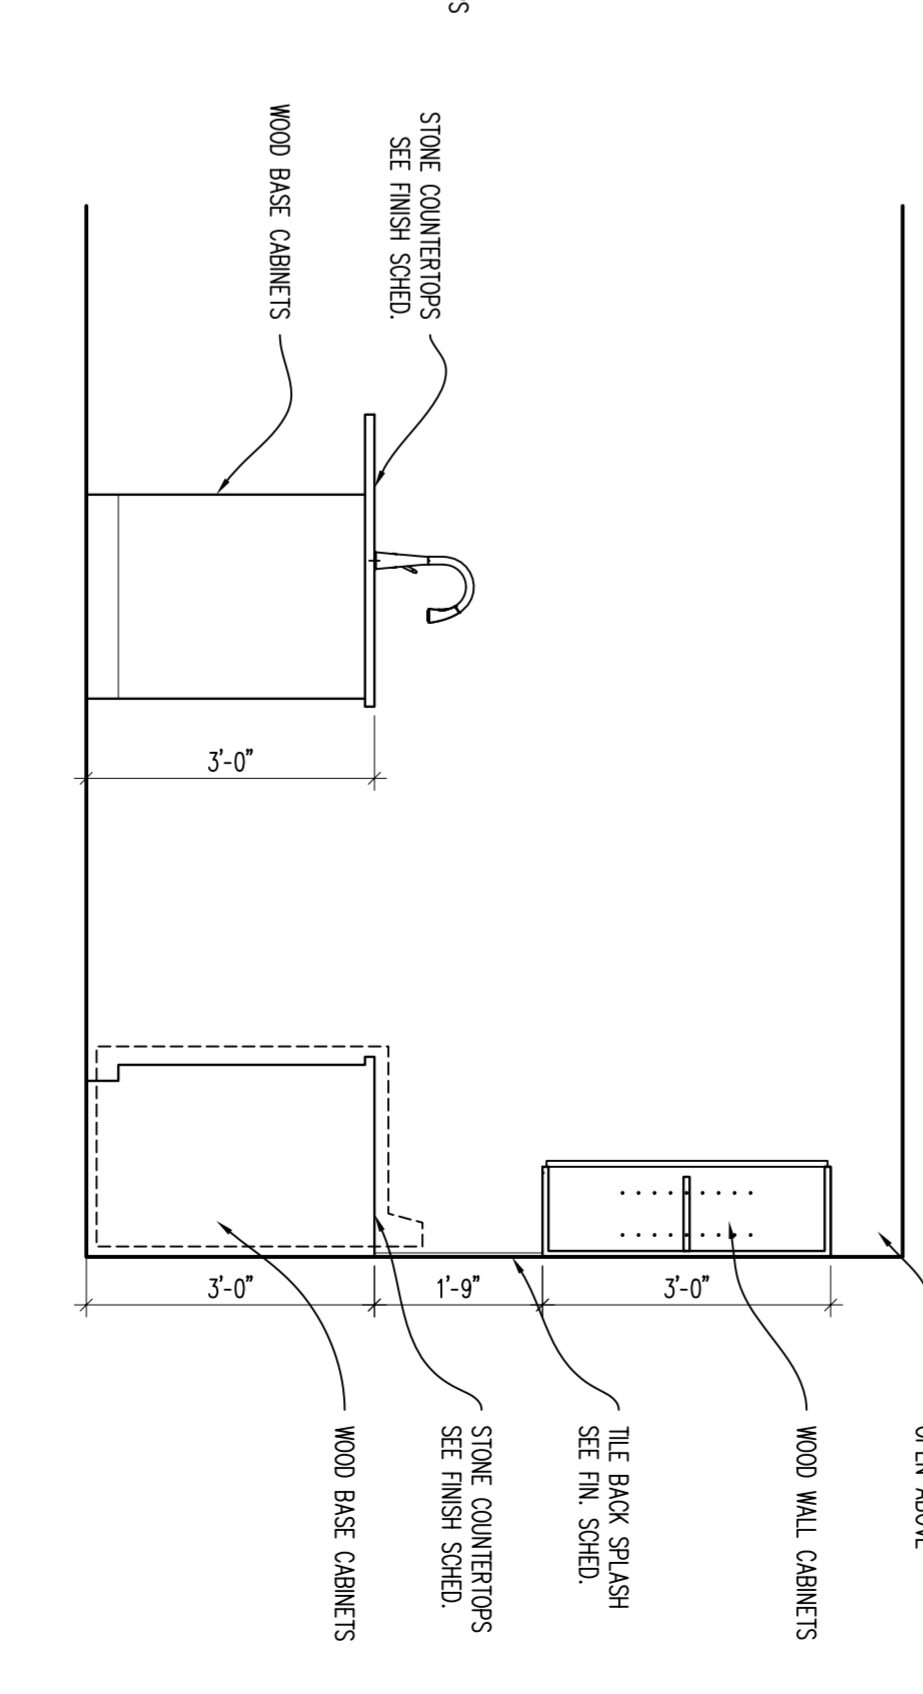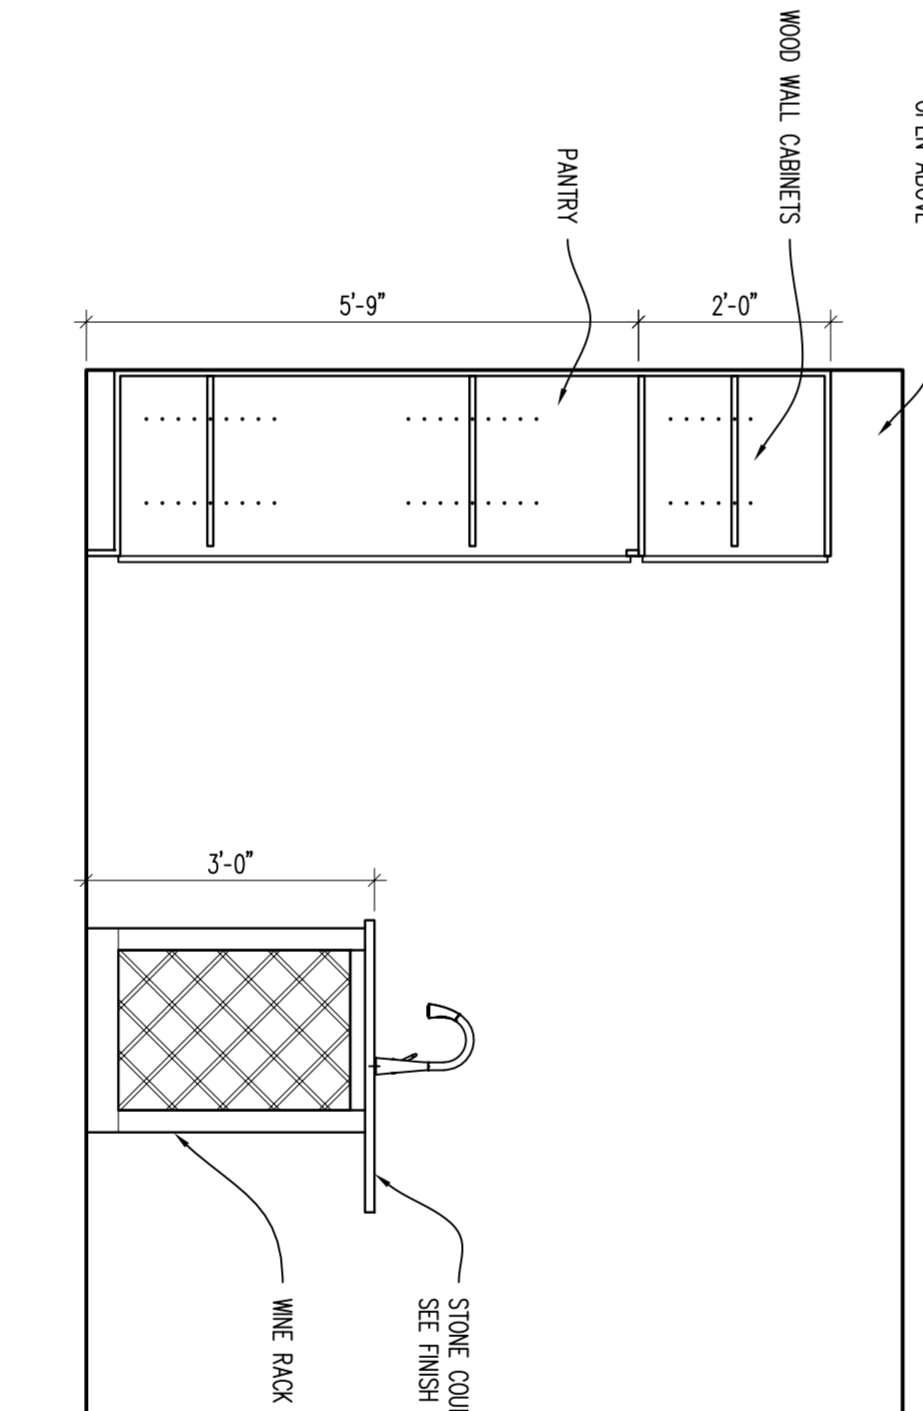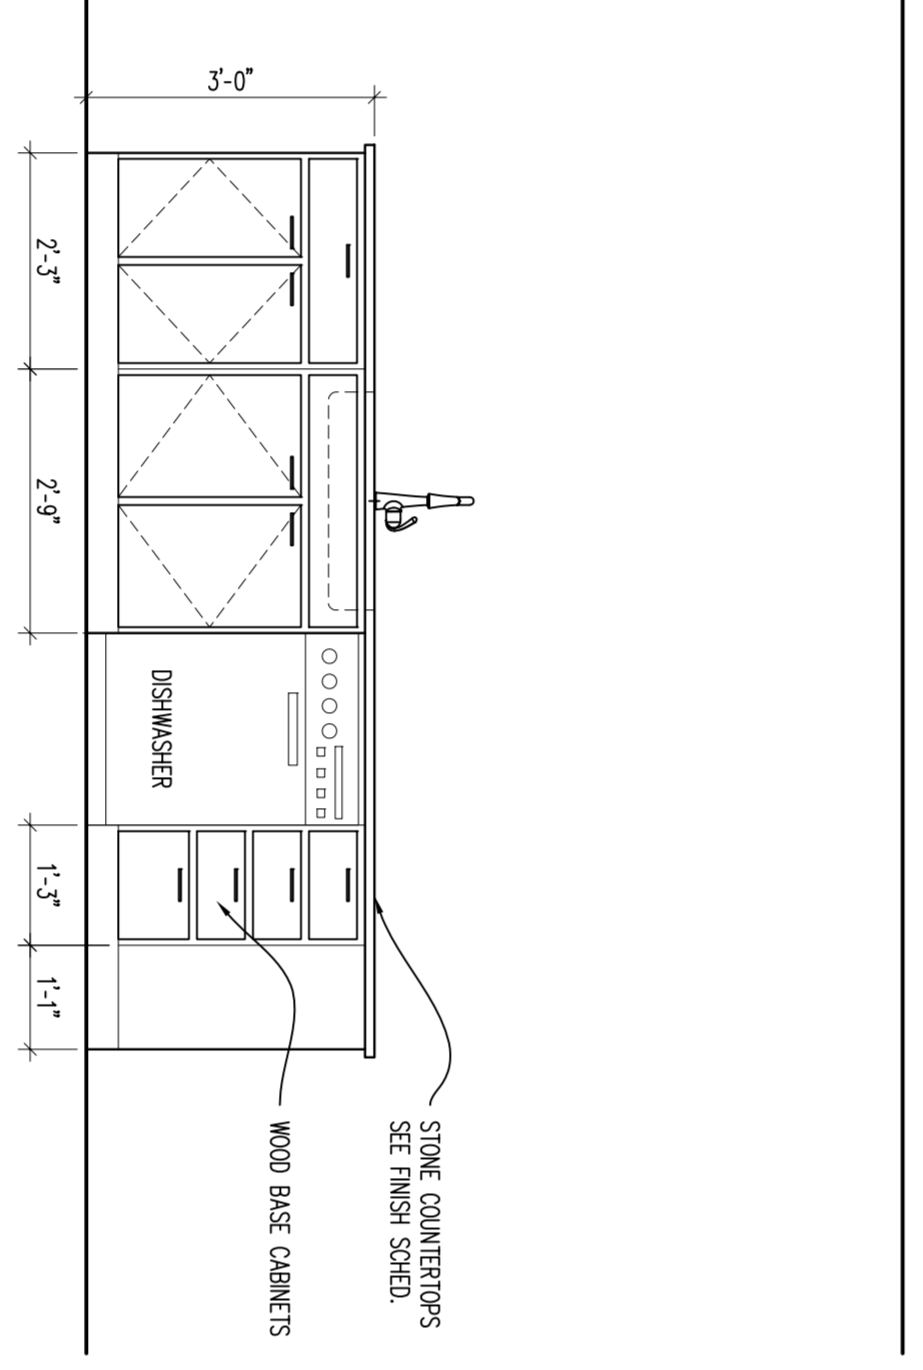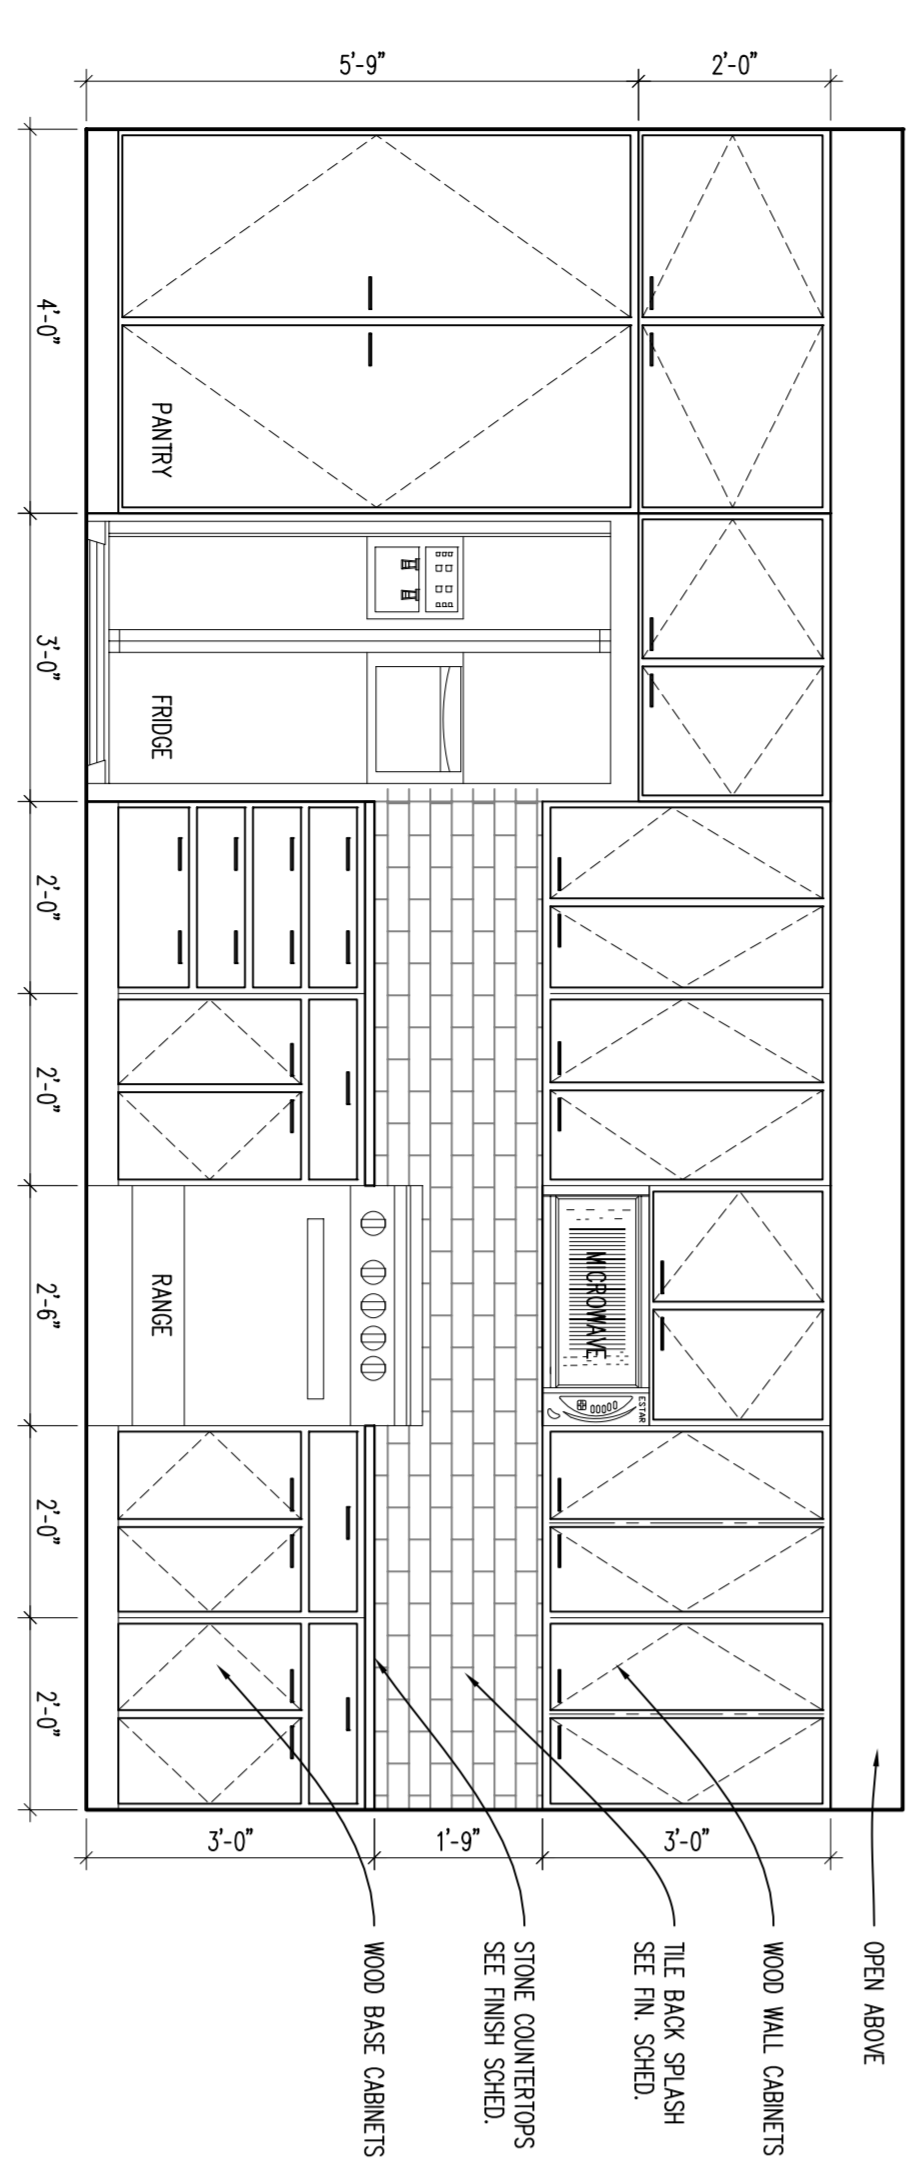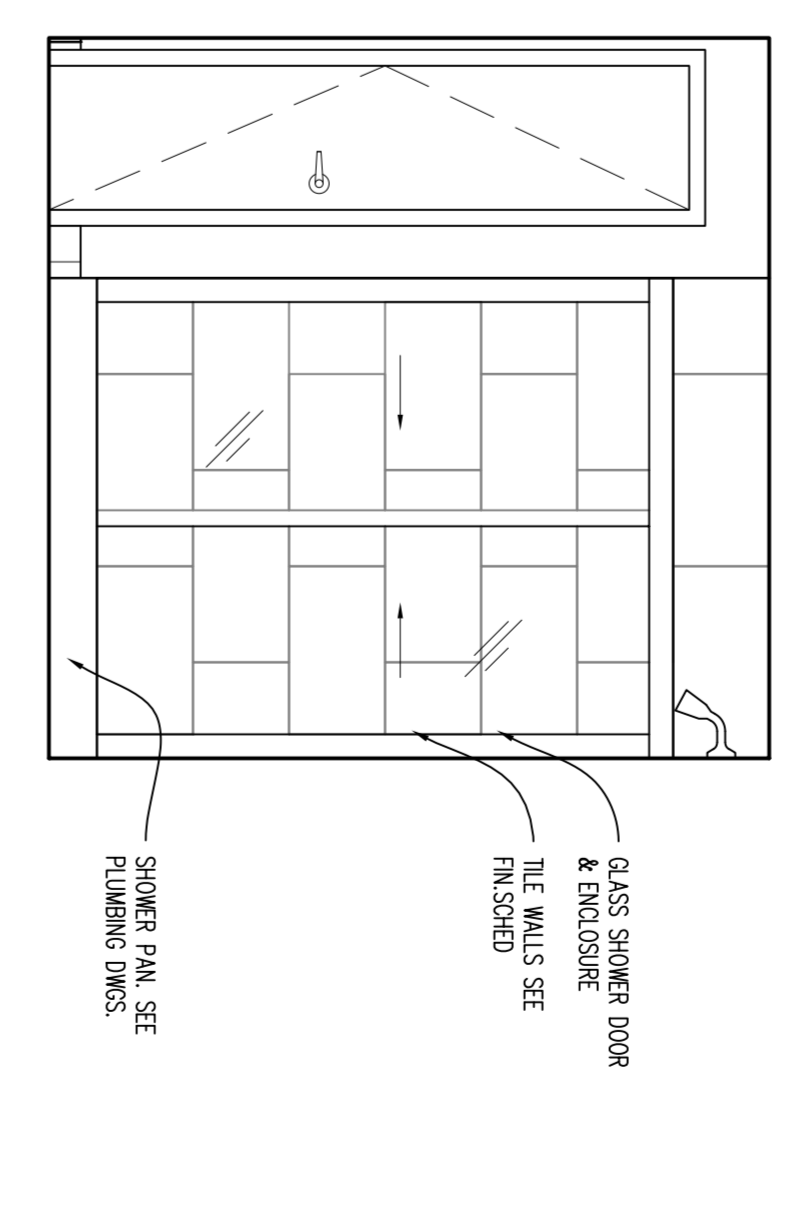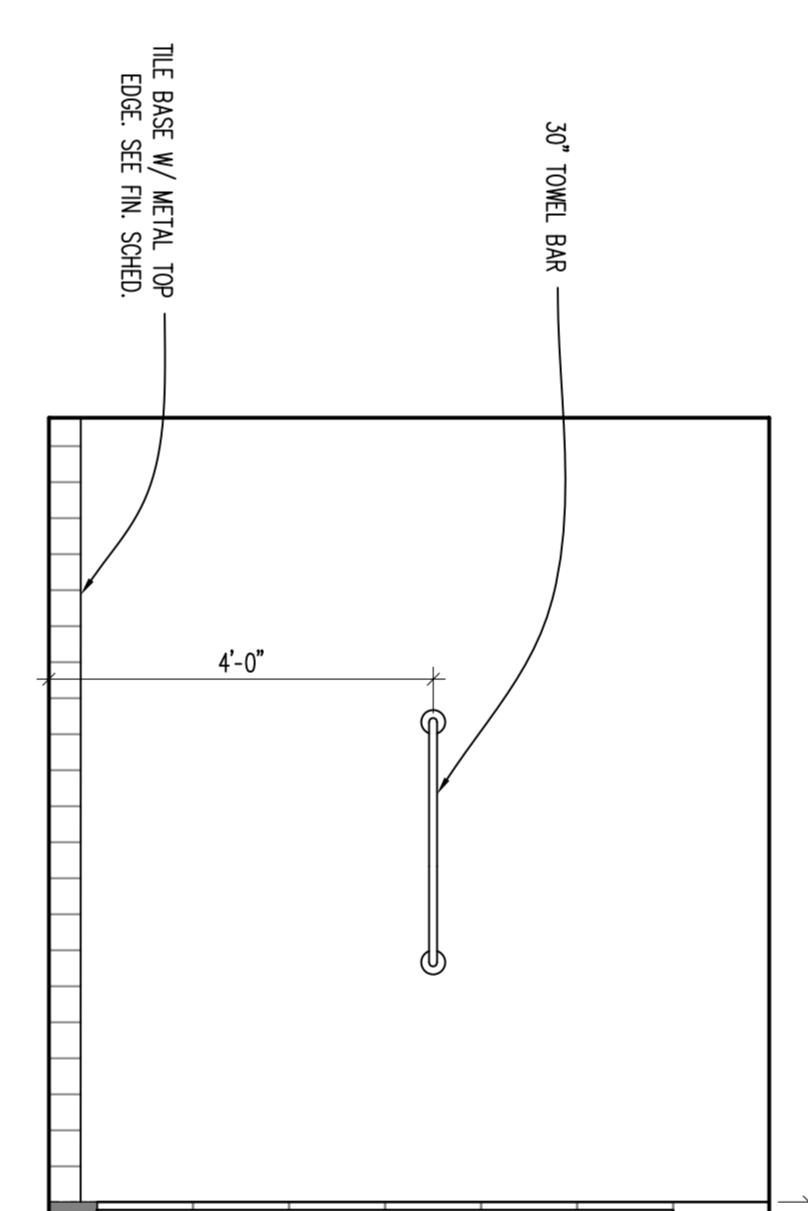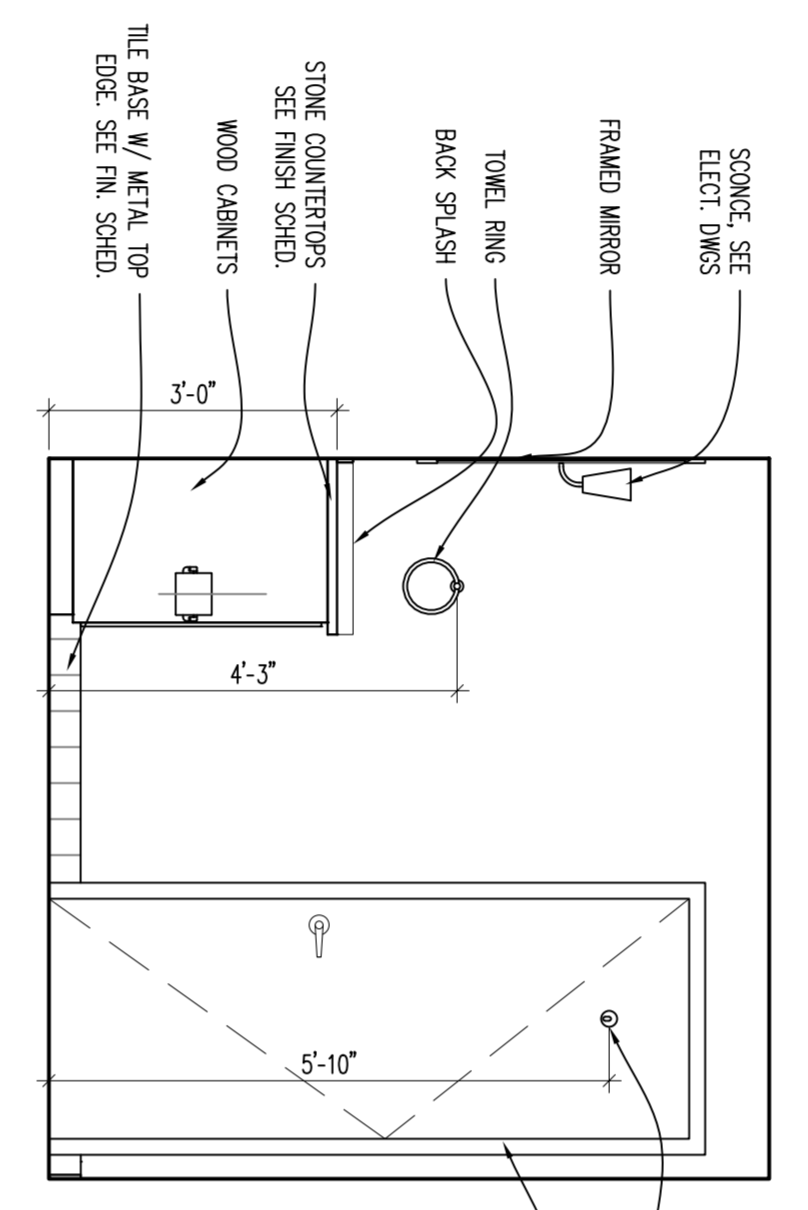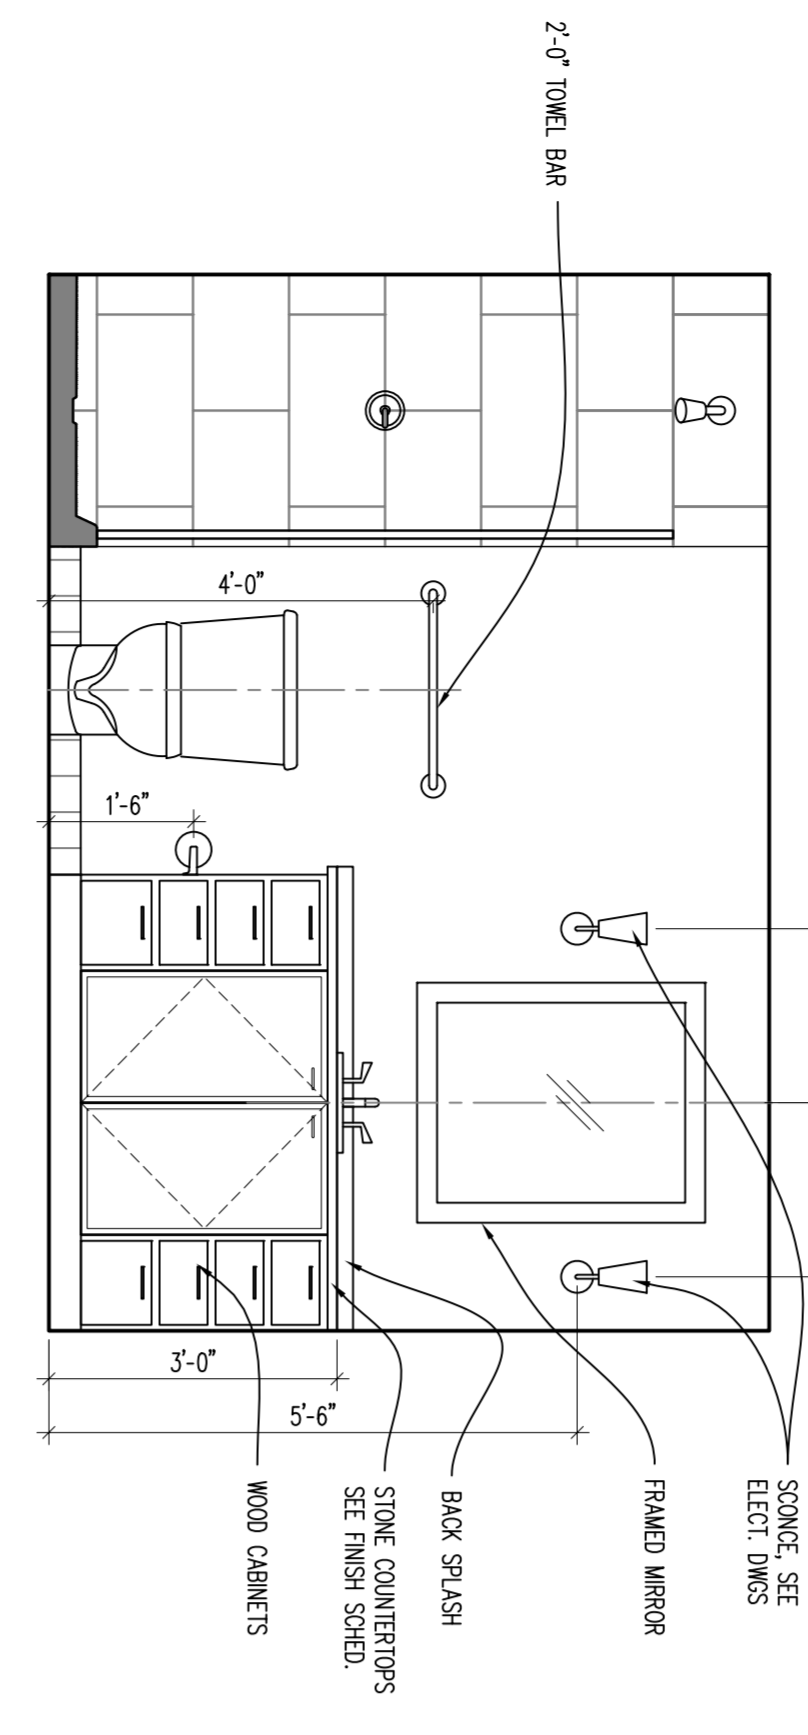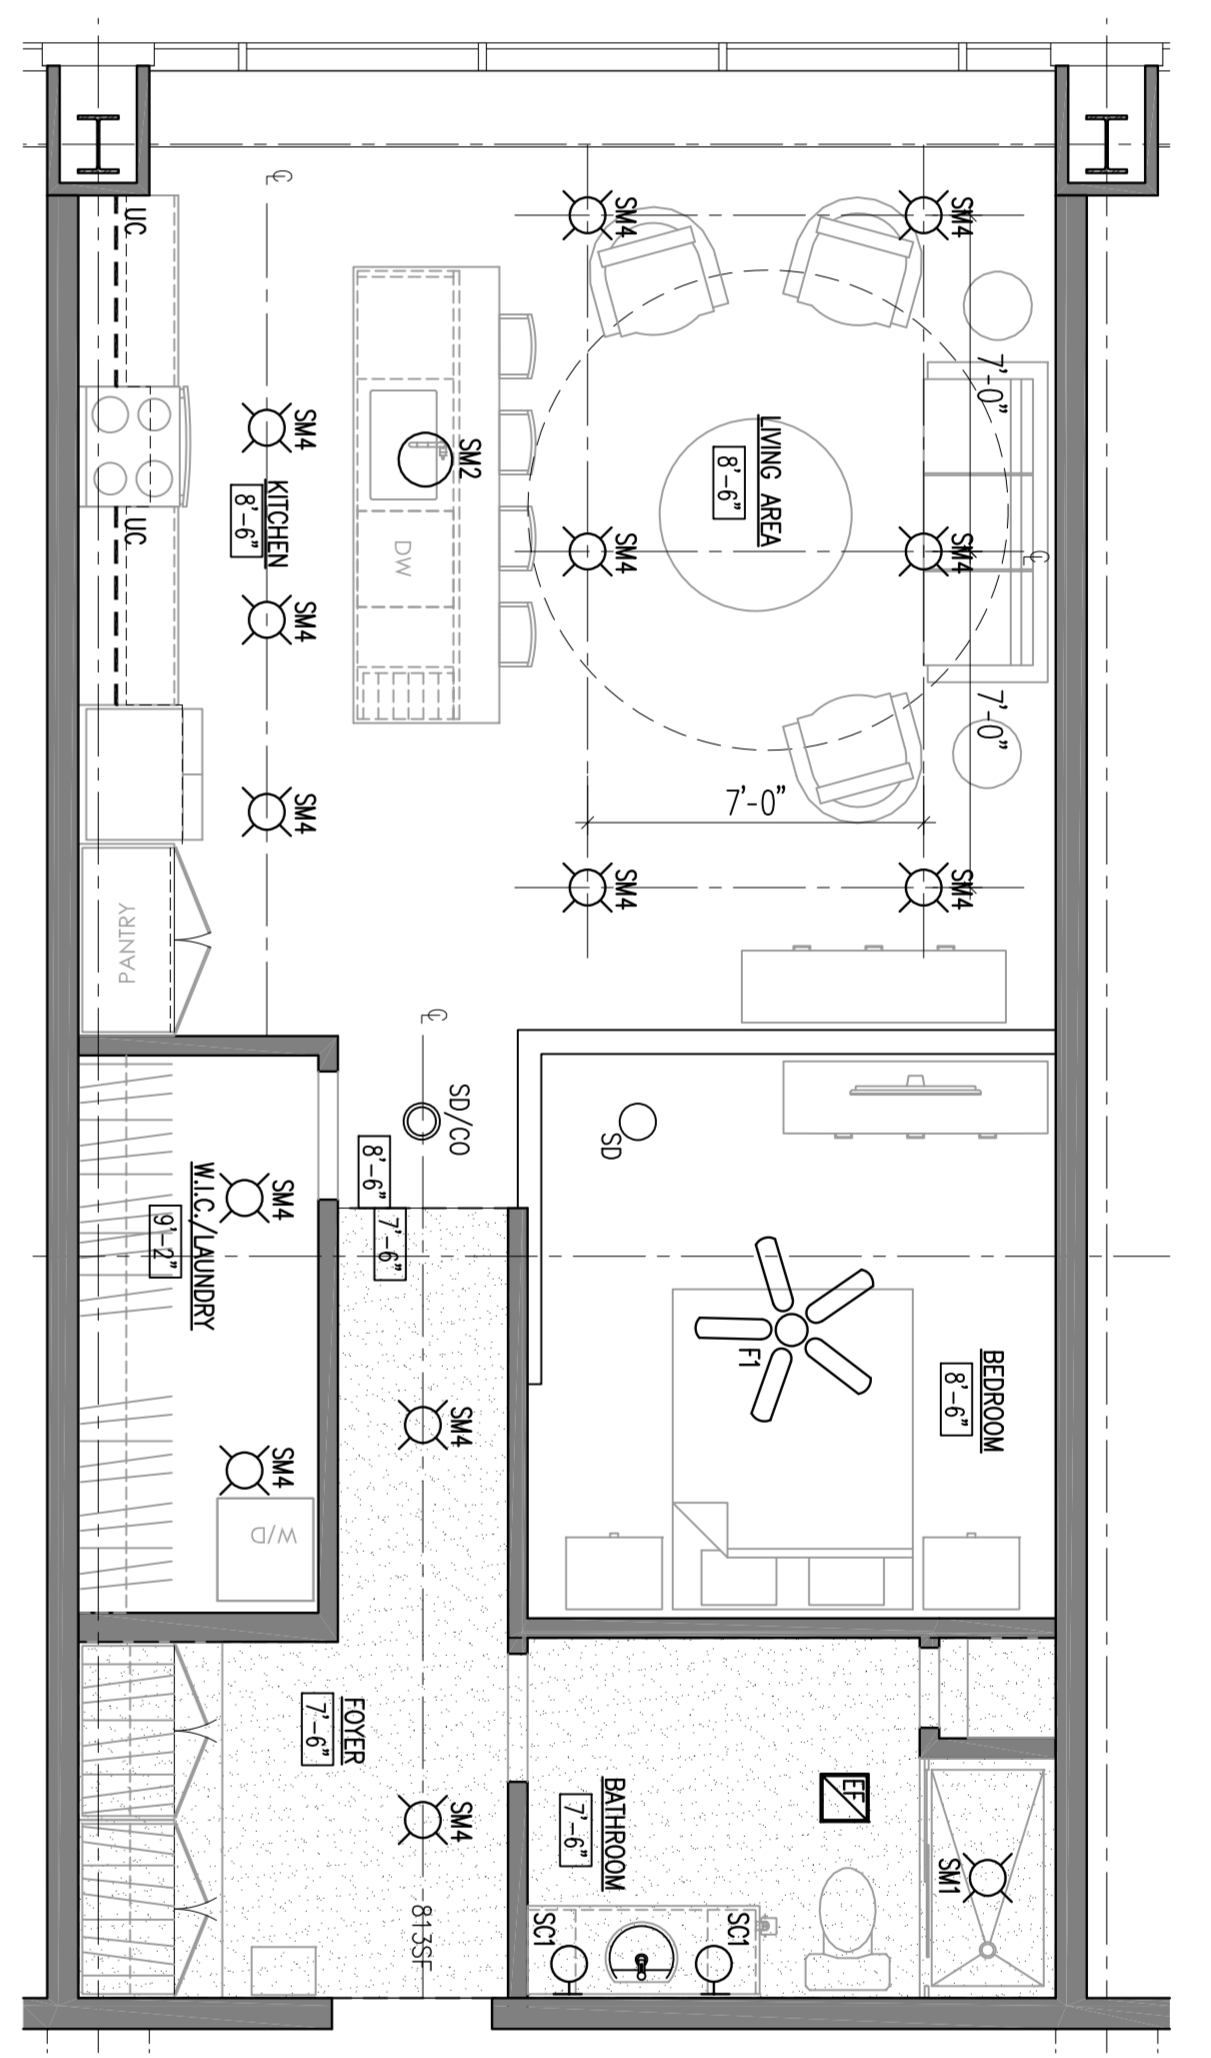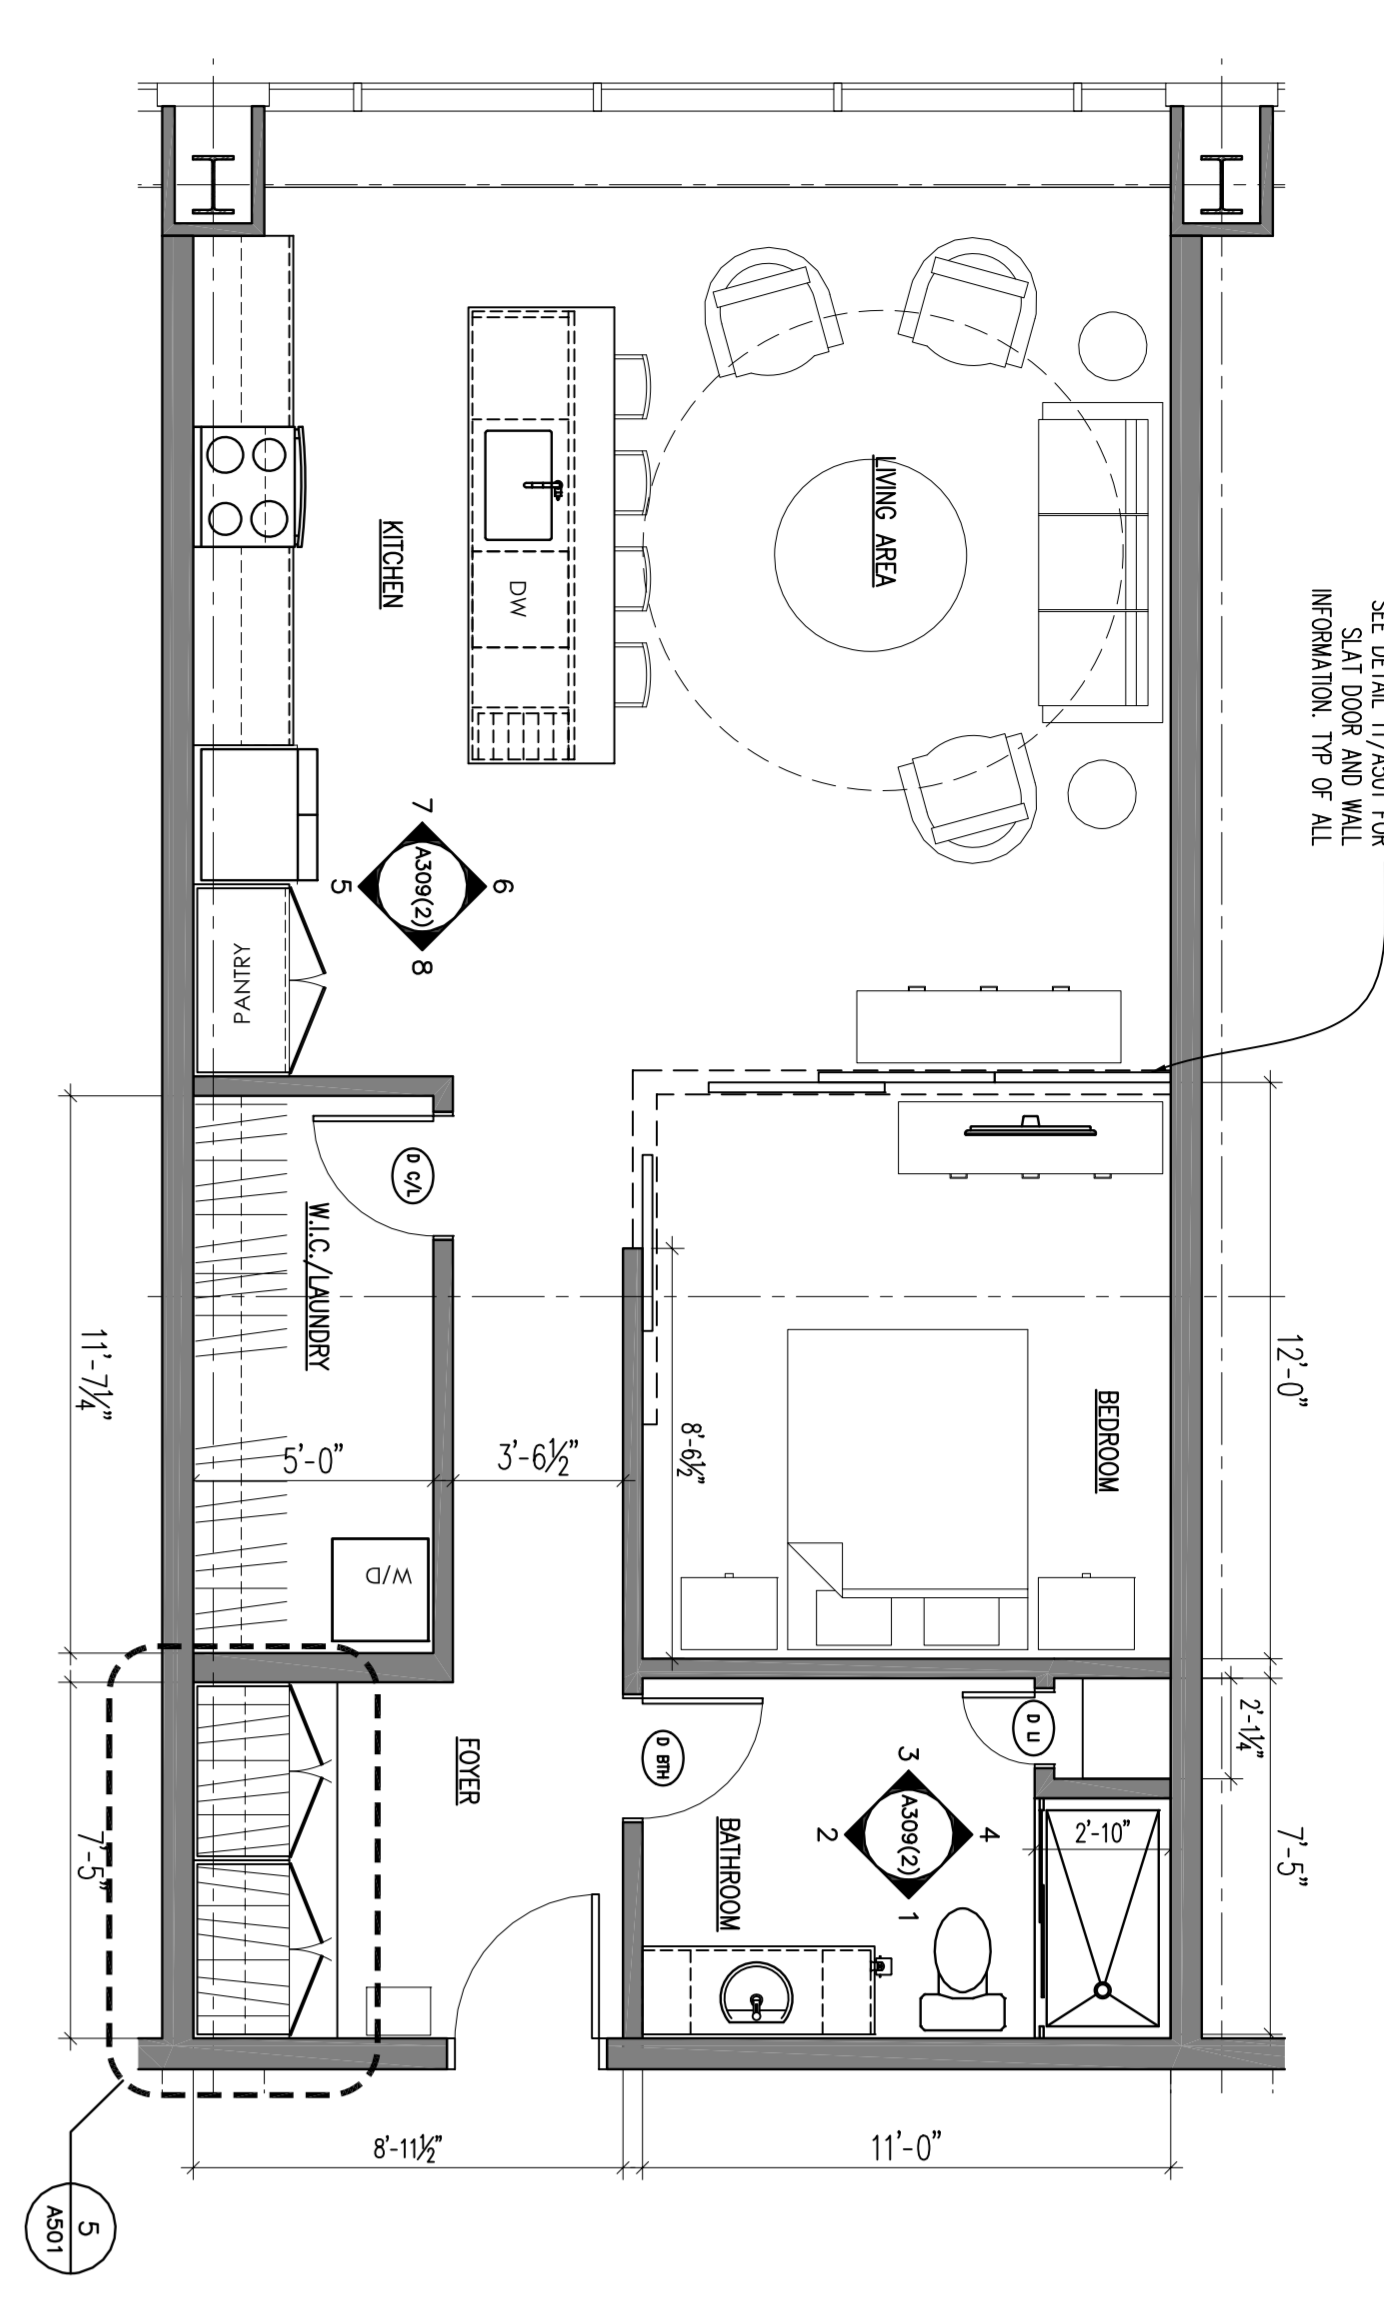

APARTMENT ROOM FINISH SCHEDULE						
ROOM NAME	FLOOR	BASE	WALLS			REMARKS
			NORTH	SOUTH	EAST	
LIVING AREA	VP-1	RB-3	PT-1	PT-1	PT-1	NOTES: A
KITCHEN	VP-1	RB-3	PT-1	PT-1	PT-1	NOTES: A
CLOSET / LAUNDRY	VP-1	RB-3	PT-1	PT-1	PT-1	NOTES: A
BEDROOM	VP-1	RB-3	PT-1	PT-1	PT-1	NOTES: A
BEDROOM	VP-1	RB-3	PT-1	PT-1	PT-1	NOTES: A
BEDROOM	VP-1	RB-3	PT-1	PT-1	PT-1	NOTES: A
FOYER / CORRIDOR	VP-1	RB-3	PT-1	PT-1	PT-1	NOTES: A
LINKEN	VP-1	RB-3	PT-1	PT-1	PT-3	NOTES: A

APARTMENT DOOR SCHEDULE							
DOOR MARK	DOOR LOCATION	DOOR INFORMATION			FRAME INFORMATION		REMARKS
		WIDTH	HEIGHT	THICK	DOOR MATERIAL	TYPE	
D 011 (A)	BEDROOM	2'-8"	6'-8"	1 3/8"	OK	A	PRE-FINISH STAINED
D 012 (A)	CLOSET / LAUNDRY	2'-8"	6'-8"	1 3/8"	OK	A	PRE-FINISH STAINED
D 013 (A)	LINKEN	1'-8"	6'-8"	1 3/8"	OK	A	PRE-FINISH STAINED

- GENERAL APARTMENT NOTES**
- DOOR FRAME SHALL BE 4" FROM FACE OF WALL TO BACKSIDE OF FRAME UNLESS TYPE 3 UNLESS DIMENSIONS ARE FROM FINISH FACE OF WALL TO FINISH FACE OF WALL UNLESS NOTED OTHERWISE.
 - FACE OF WALL UNLESS NOTED OTHERWISE.
 - ALL LIGHTING FIXTURES SHALL BE NEW UNLESS NOTED OTHERWISE.
 - ALL CABINET DRAWINGS ARE FOR DESIGN AND ONLY FOR REVIEW. ALL CABINET DRAWINGS ARE FOR REVIEW ONLY. ALL CABINET DRAWINGS ARE FOR REVIEW ONLY. ALL CABINET DRAWINGS ARE FOR REVIEW ONLY.
 - ALL FINISHES SHALL BE NEW UNLESS NOTED OTHERWISE.
 - ALL FINISHES SHALL BE NEW UNLESS NOTED OTHERWISE.
A309.2

Formica Building
115 E 5th Street
Cincinnati, Ohio 45202

Project No. 2022_259
Issue Date: [Blank]

Scale: As Noted

Revisions: ENG CHG #1
Date: 11.14.2022

Formica Building

Office/Apartments


Auditor Address: 115 E. 5th Street, Actual Address: 120 E. 4th Street
Cincinnati OH 45202

modelgroup
DEVELOPMENT • CONSTRUCTION • MANAGEMENT


1826 Race Street
Cincinnati, Ohio 45202
513.559.0048

STATE OF OHIO
JOSEPH A. BODKIN
REGISTERED ARCHITECT
#133567


Joseph A. Bodkin, License #133567
Expiration Date: 12.31.2025

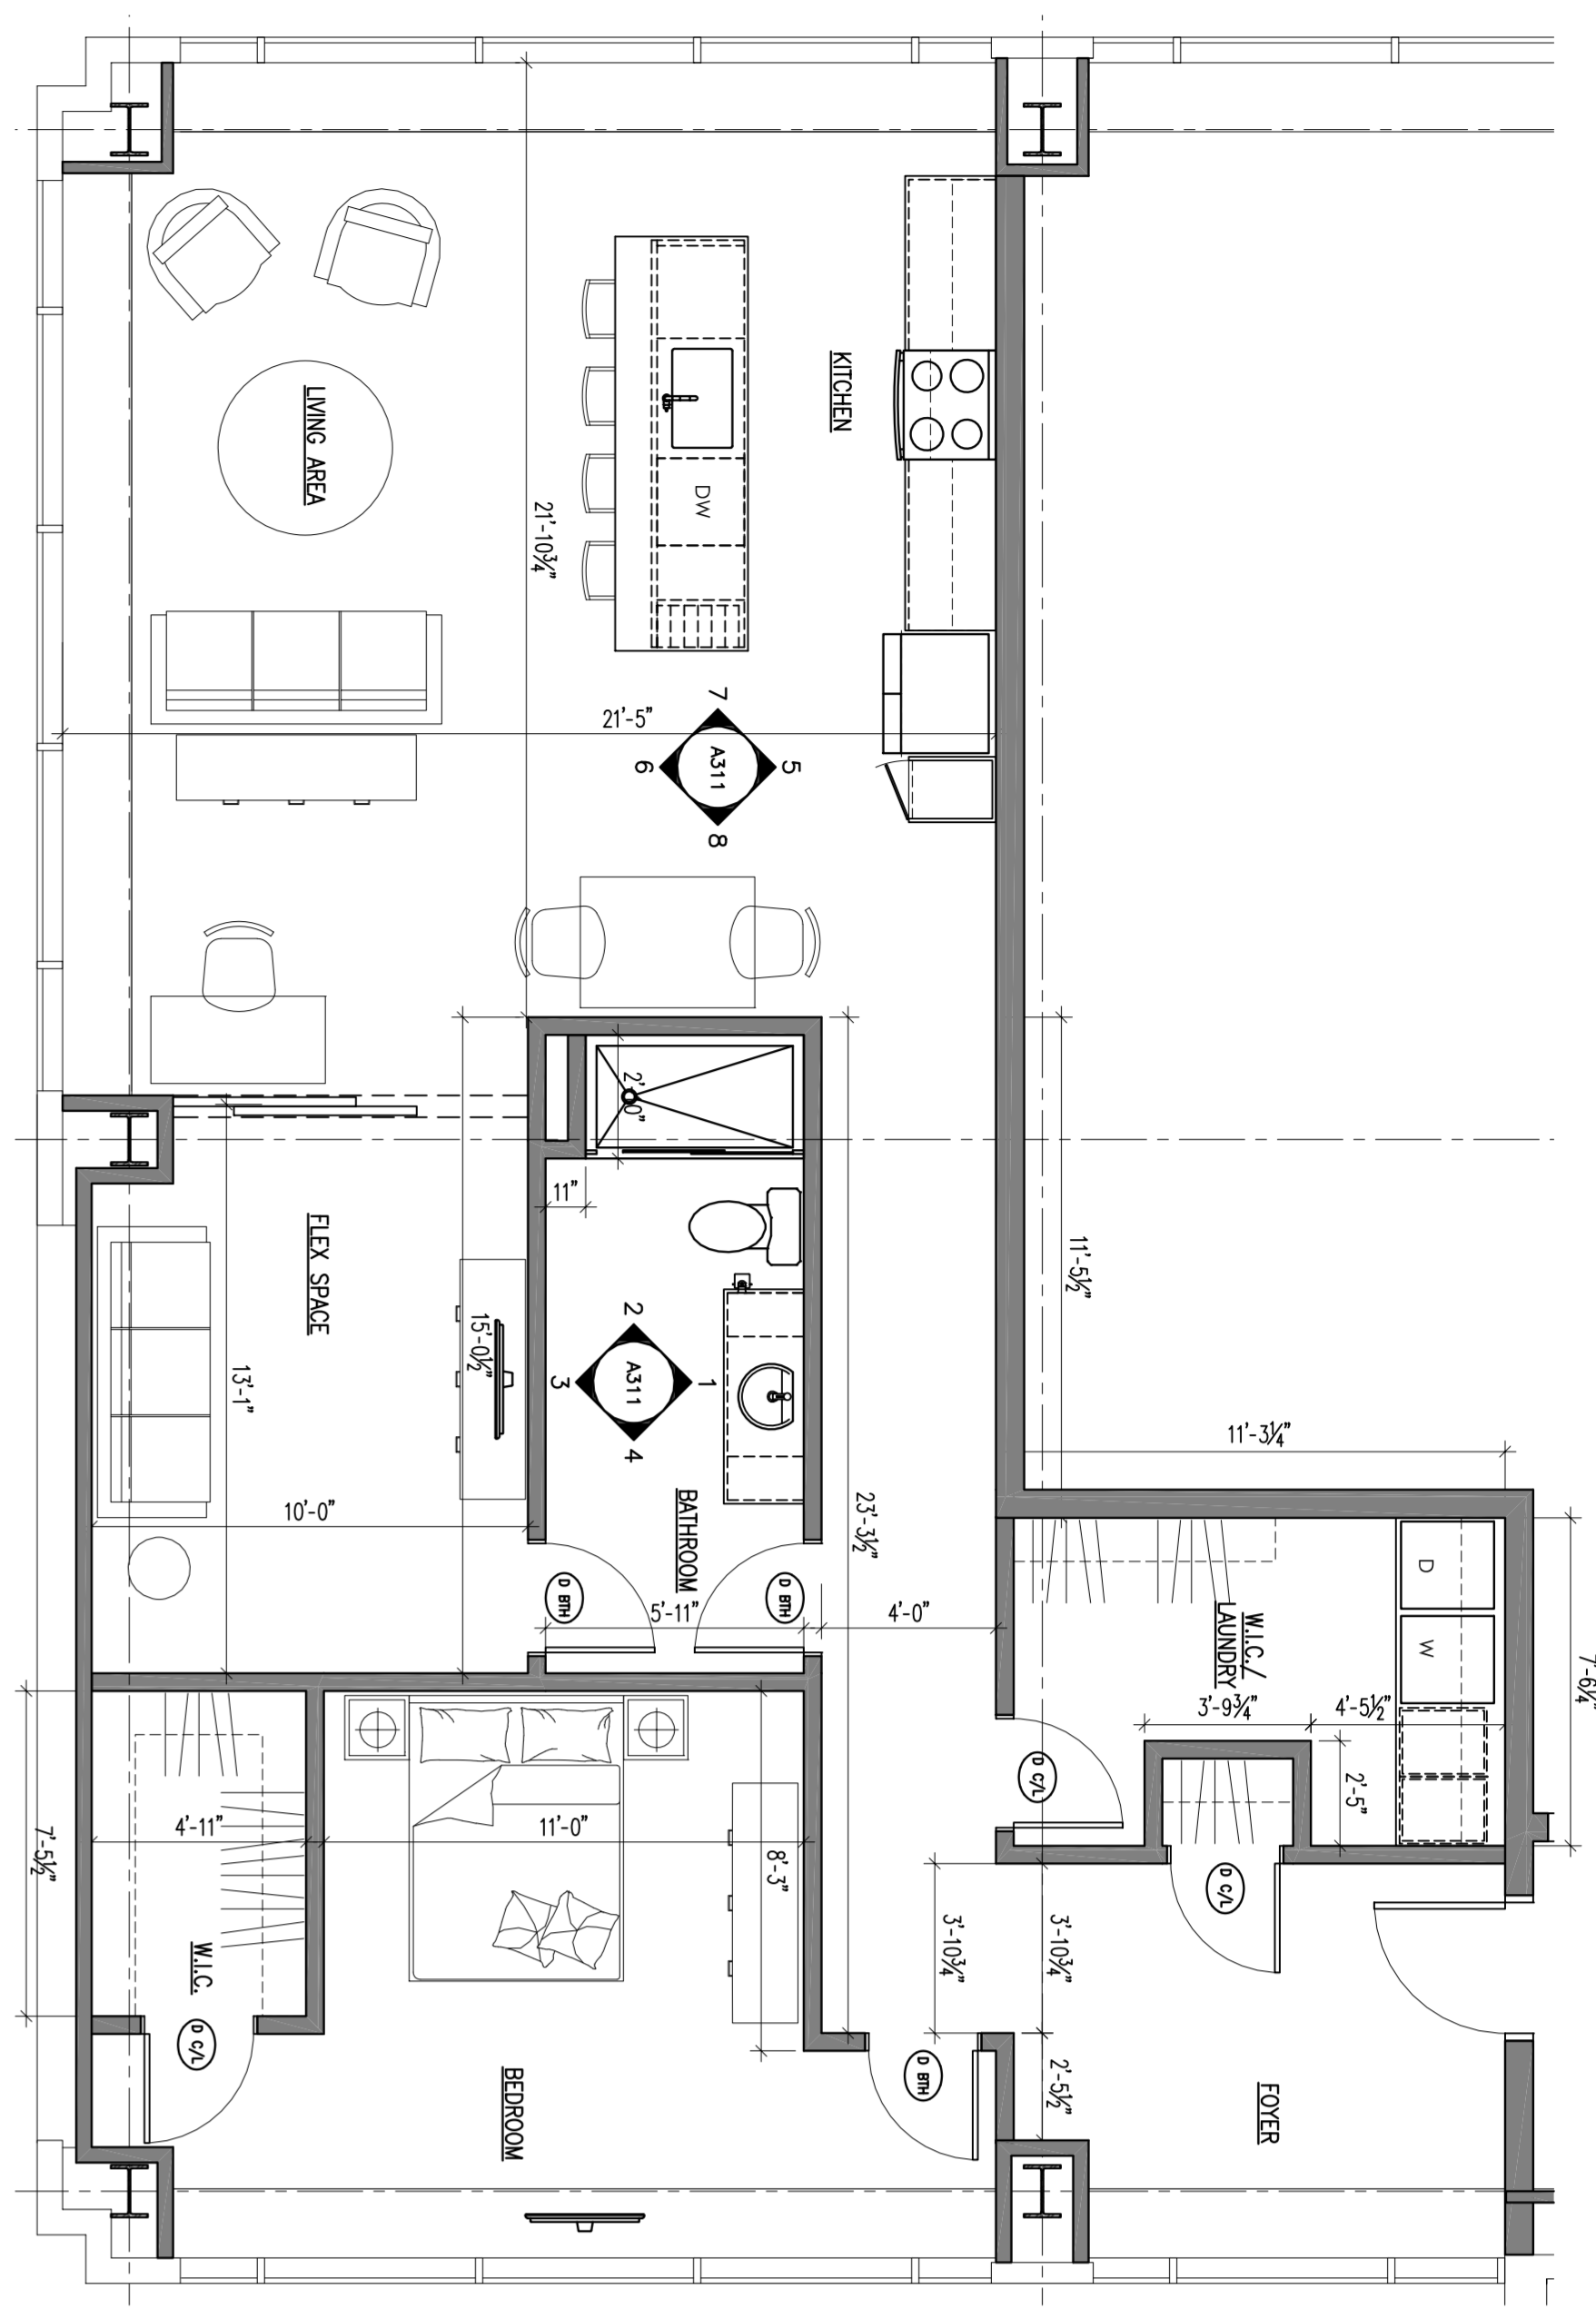


APARTMENT FLOOR PLAN
 SCALE: 1/4" = 1'-0"

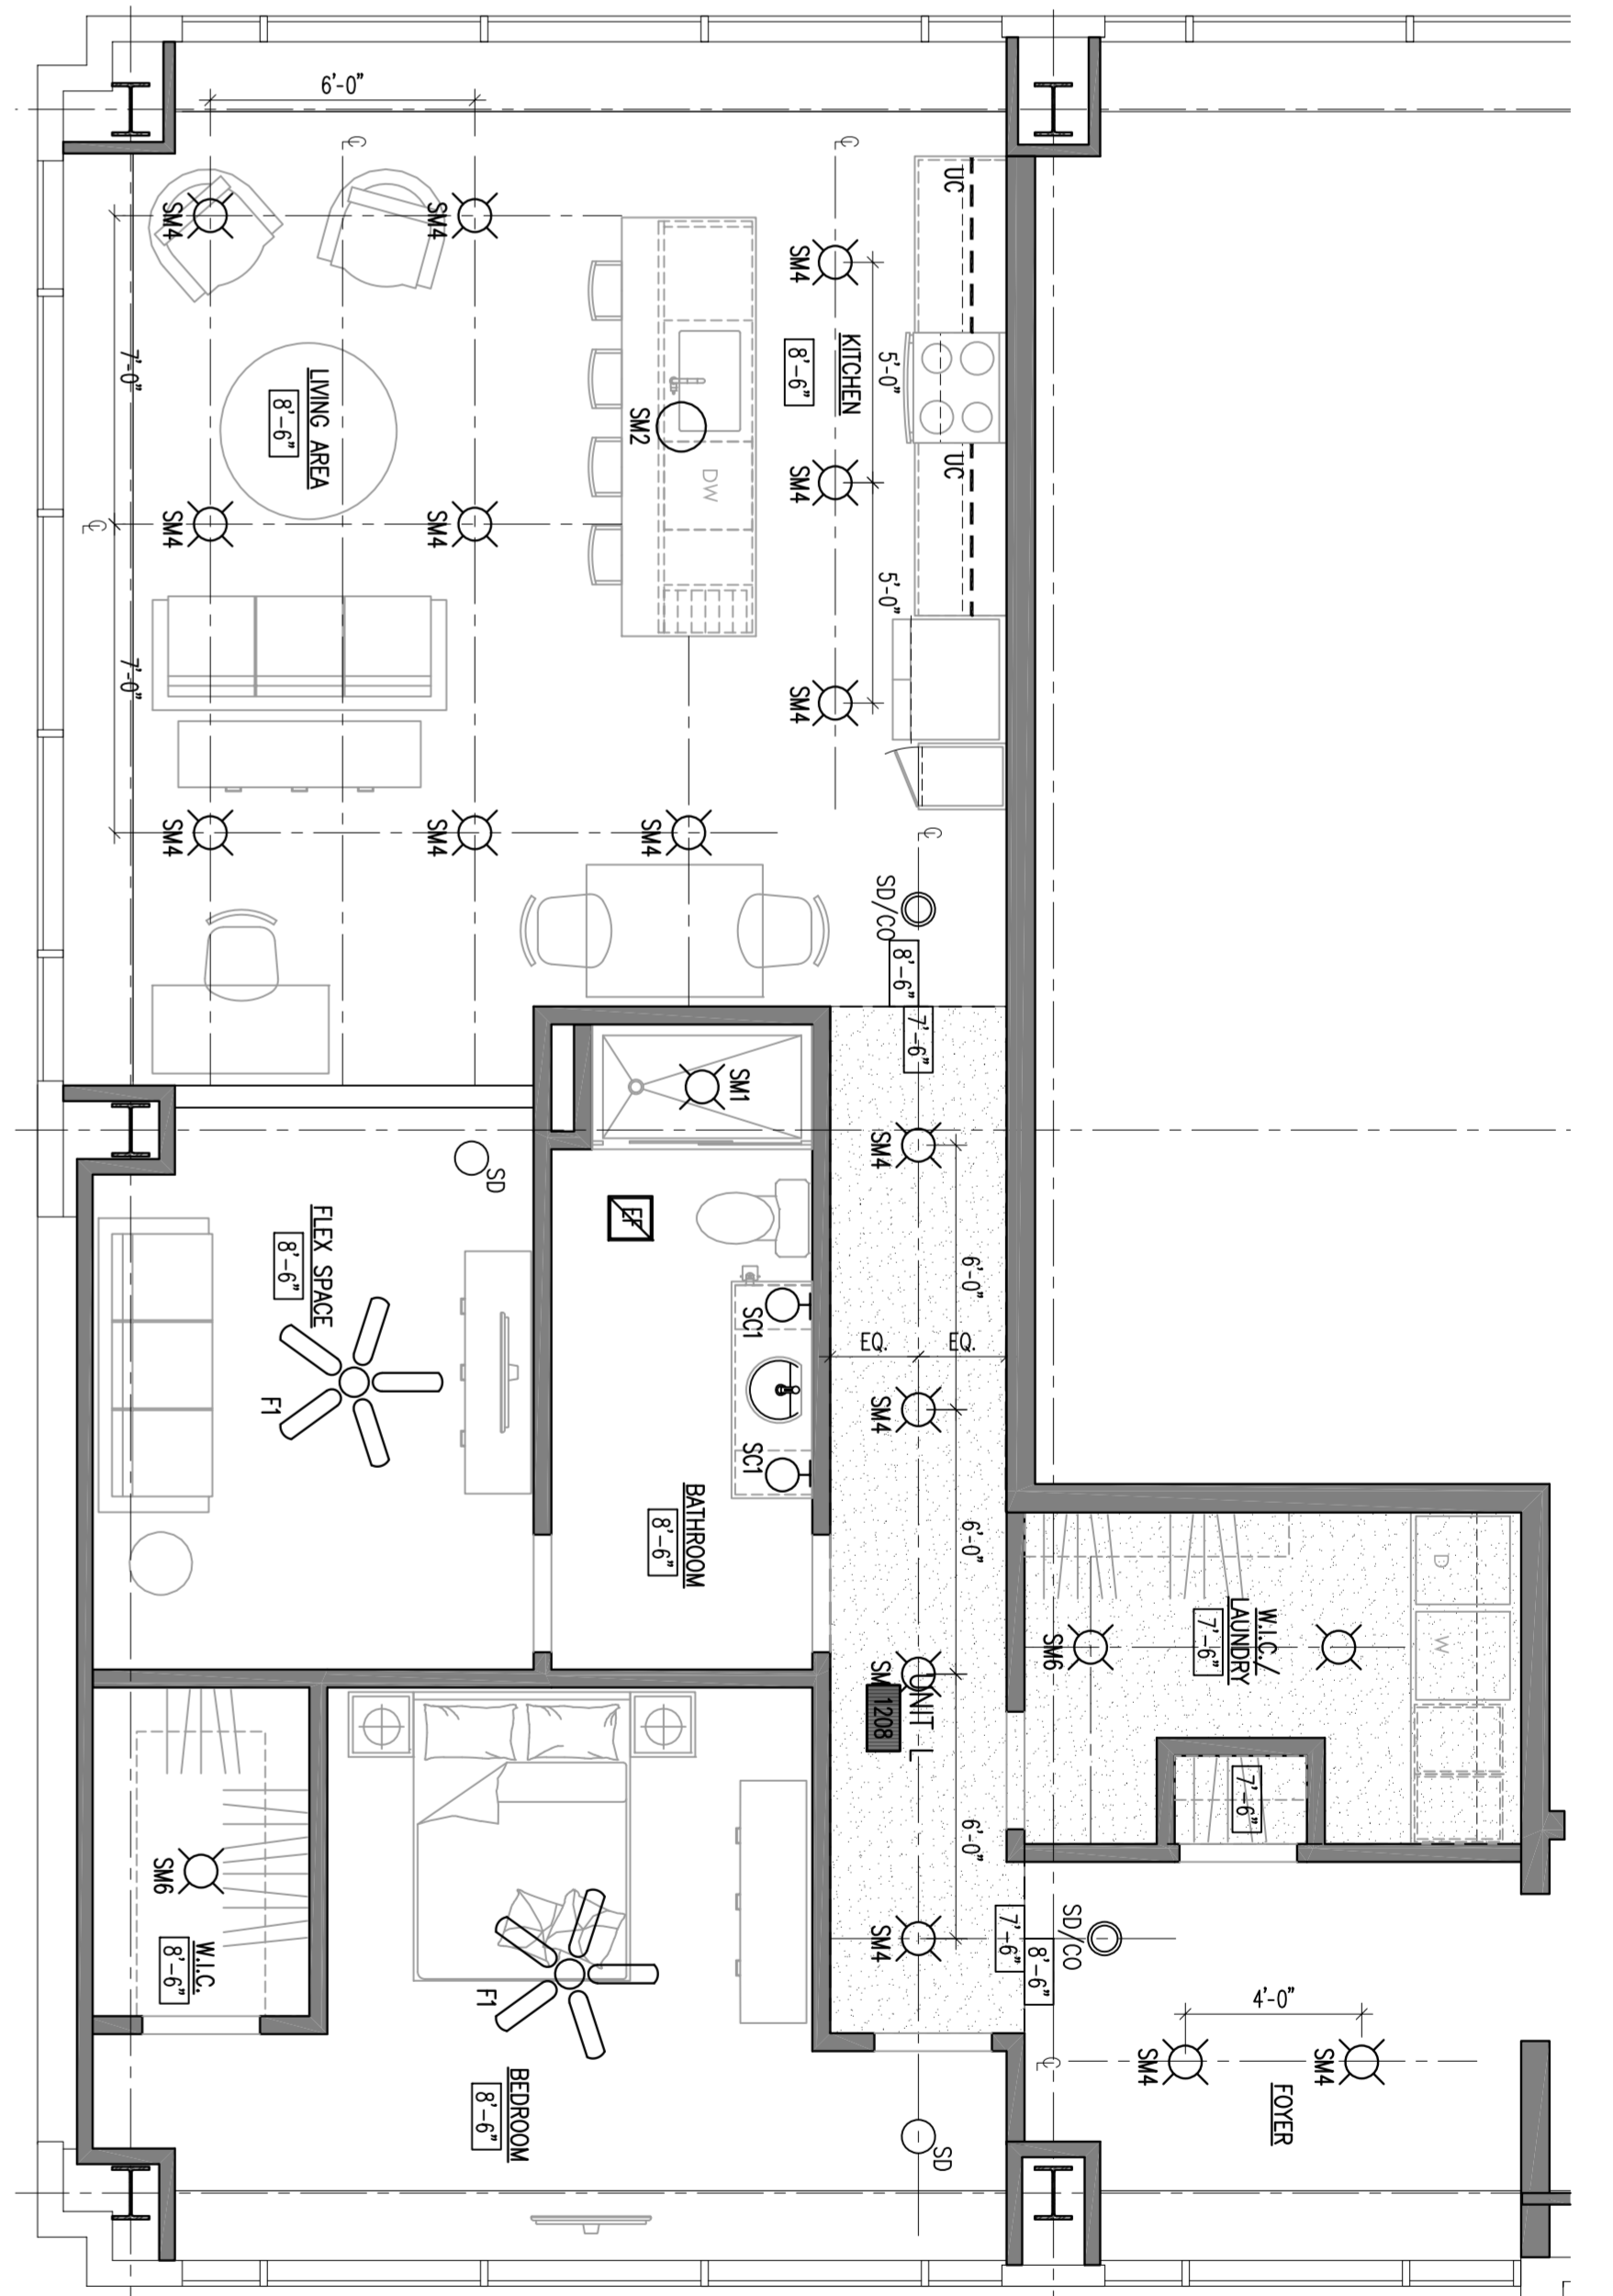


APARTMENT REFLECTED CEILING PLAN
 SCALE: 1/4" = 1'-0"

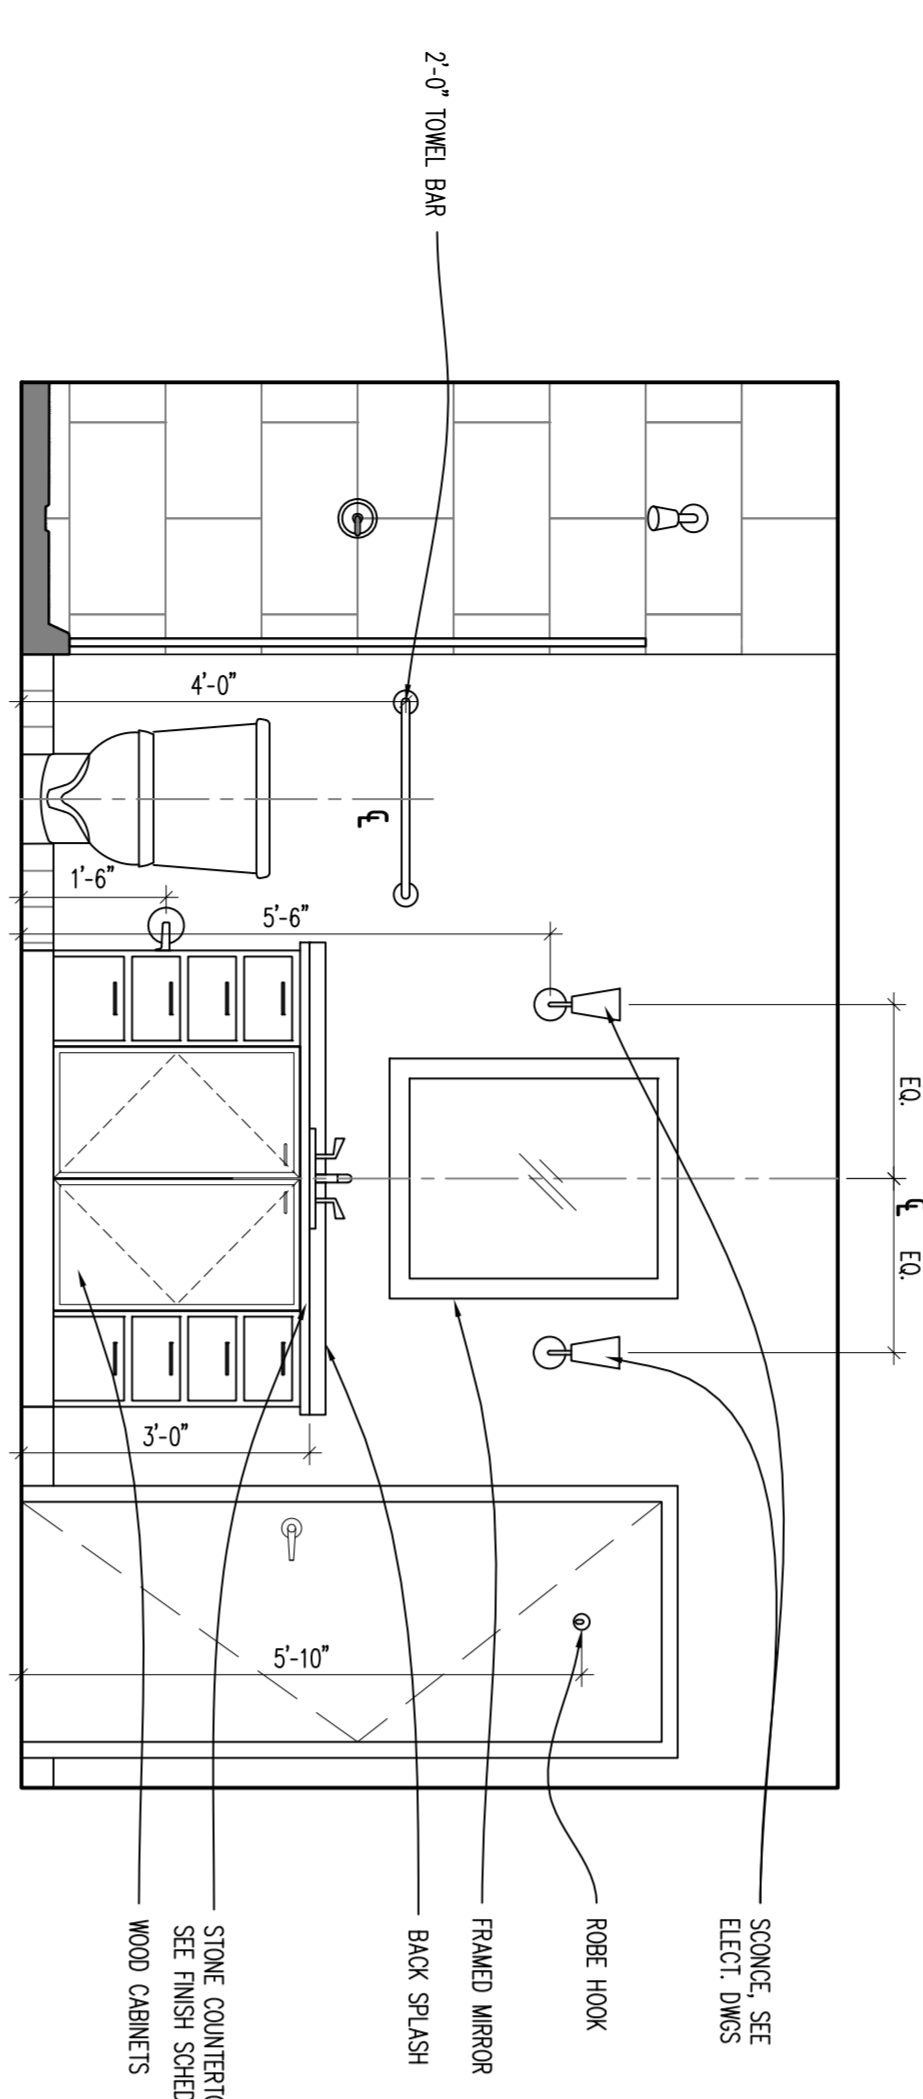


ELEVATION 1
 SCALE: 1/2" = 1'-0"

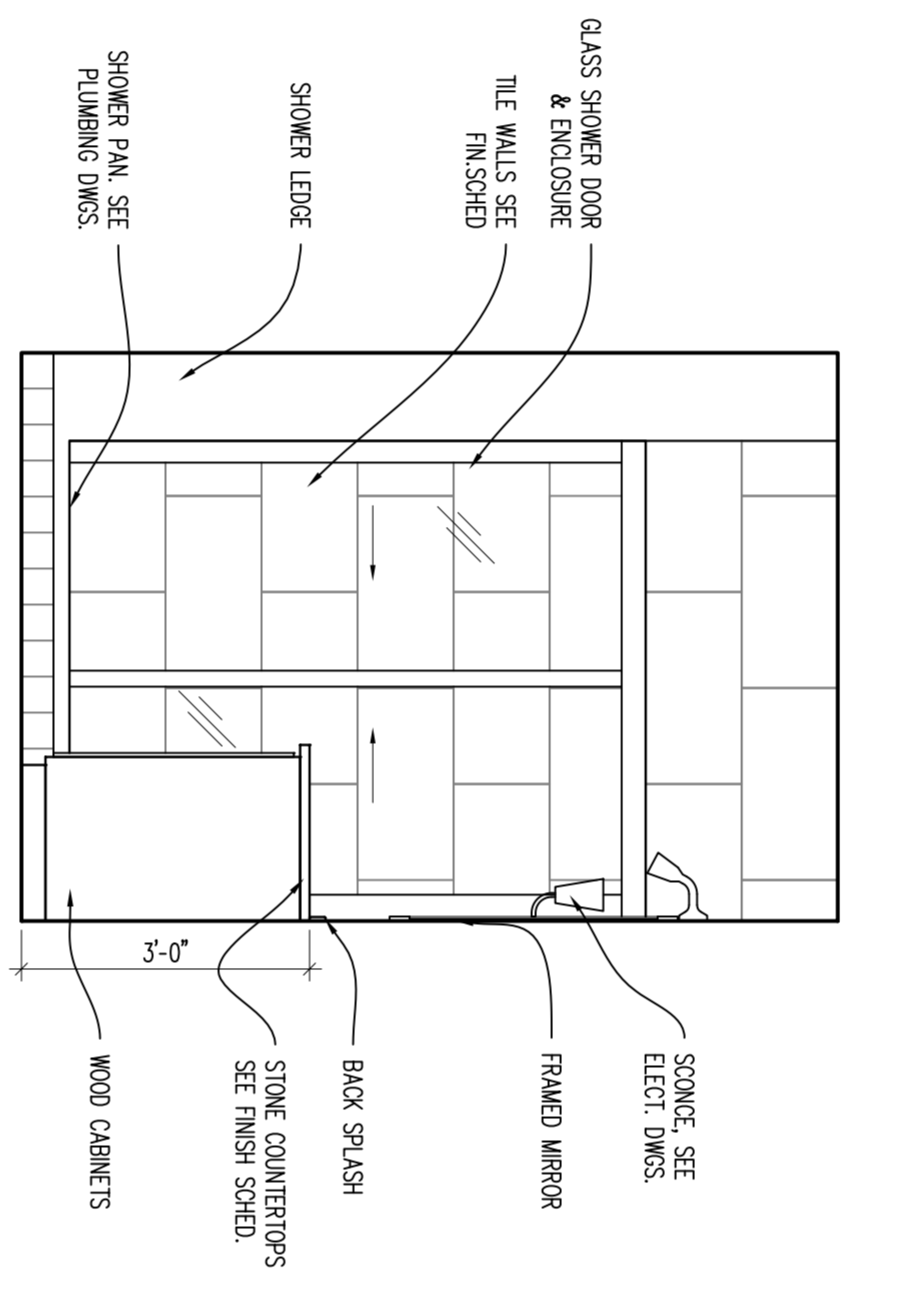


ELEVATION 2
 SCALE: 1/2" = 1'-0"

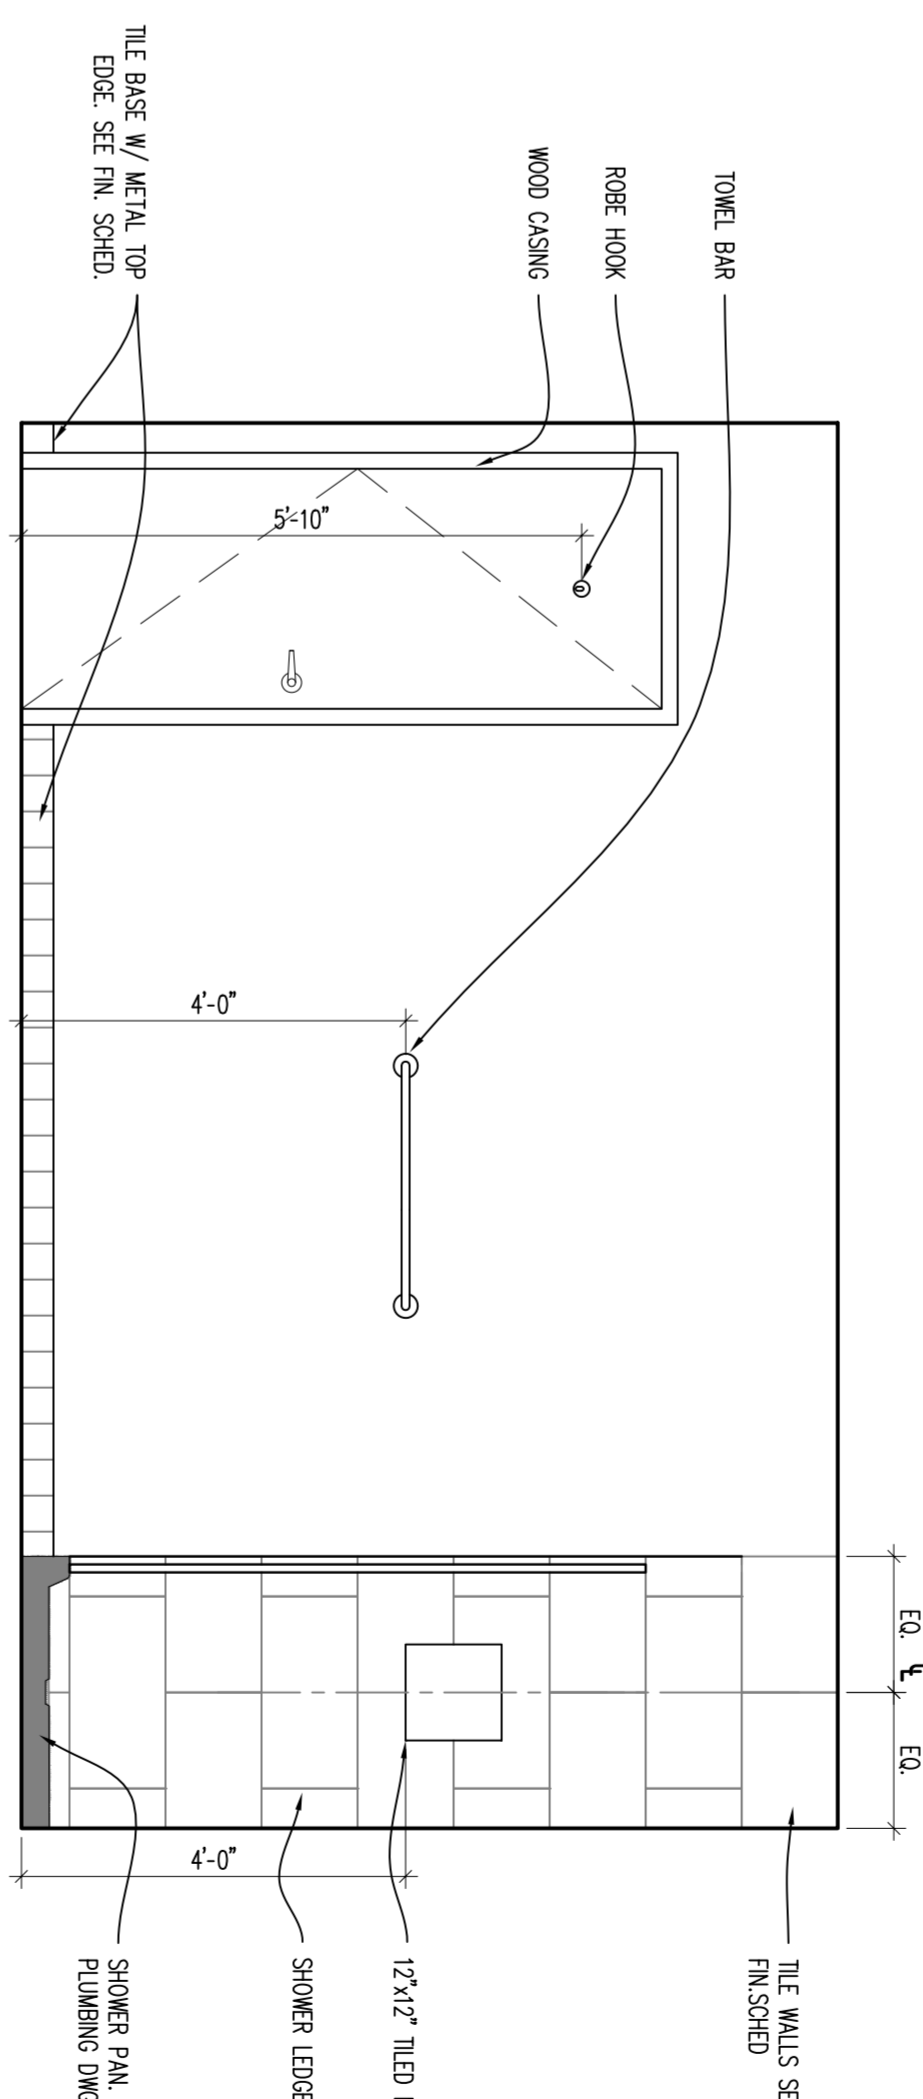


ELEVATION 3
 SCALE: 1/2" = 1'-0"

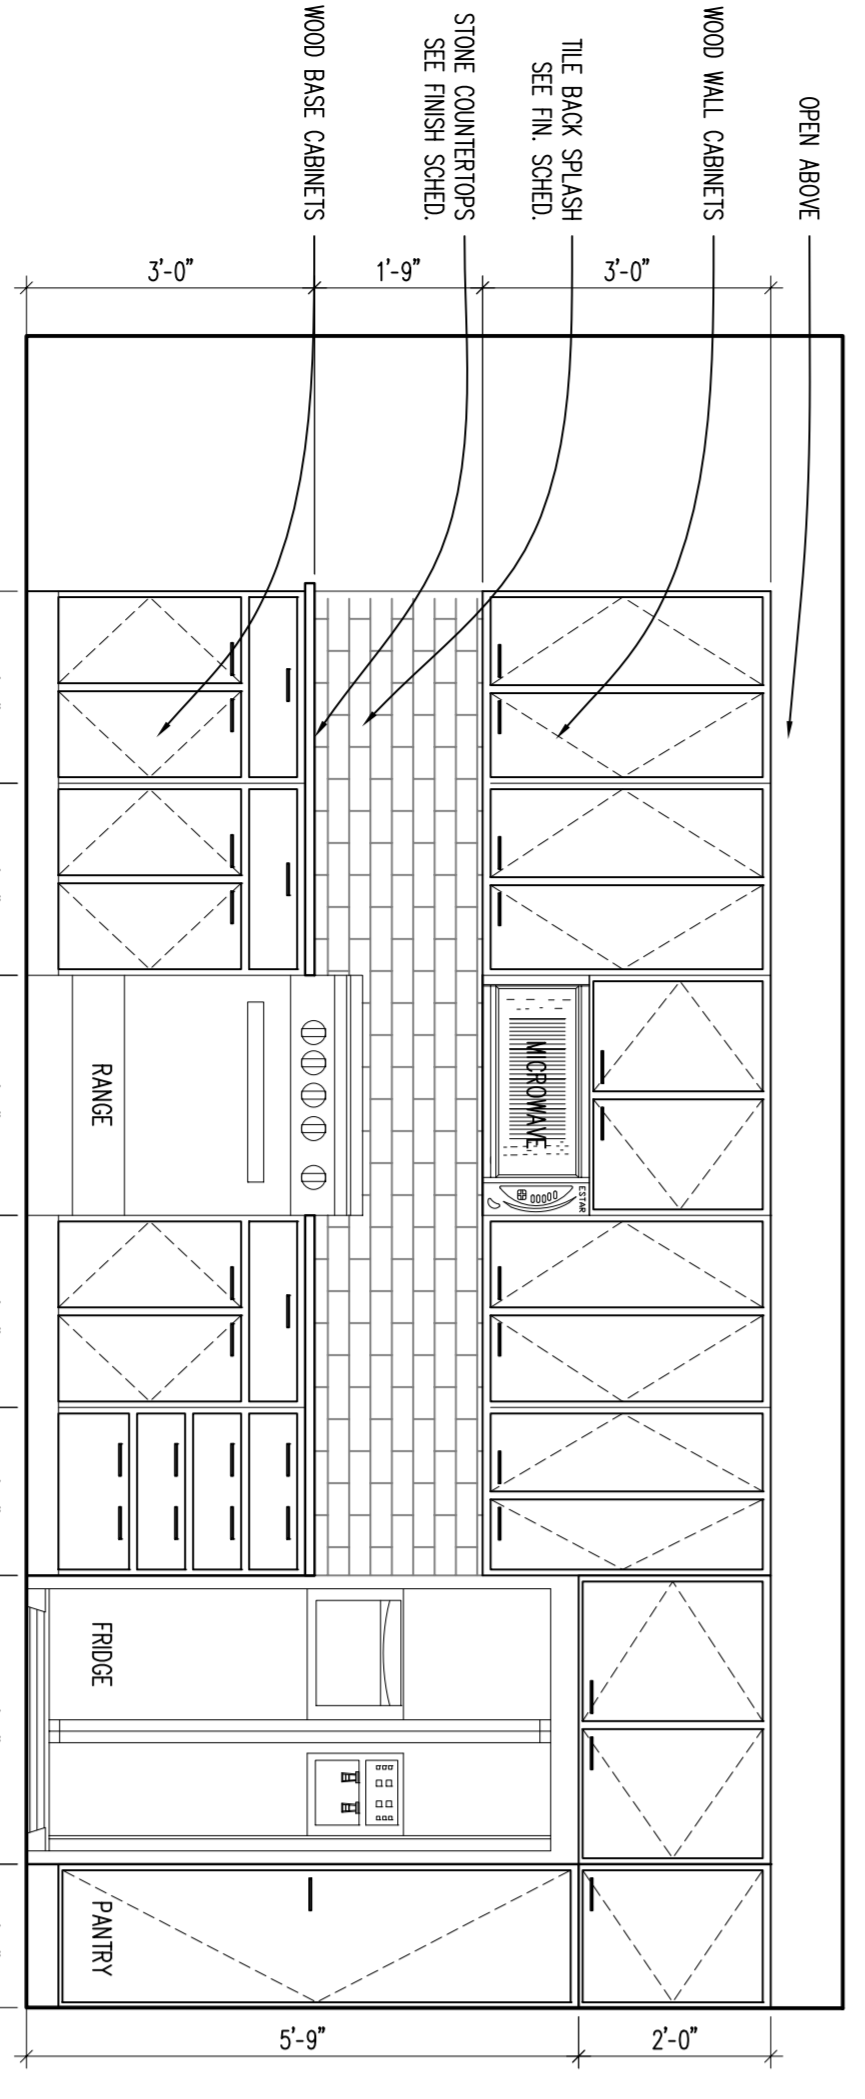


ELEVATION 4
 SCALE: 1/2" = 1'-0"

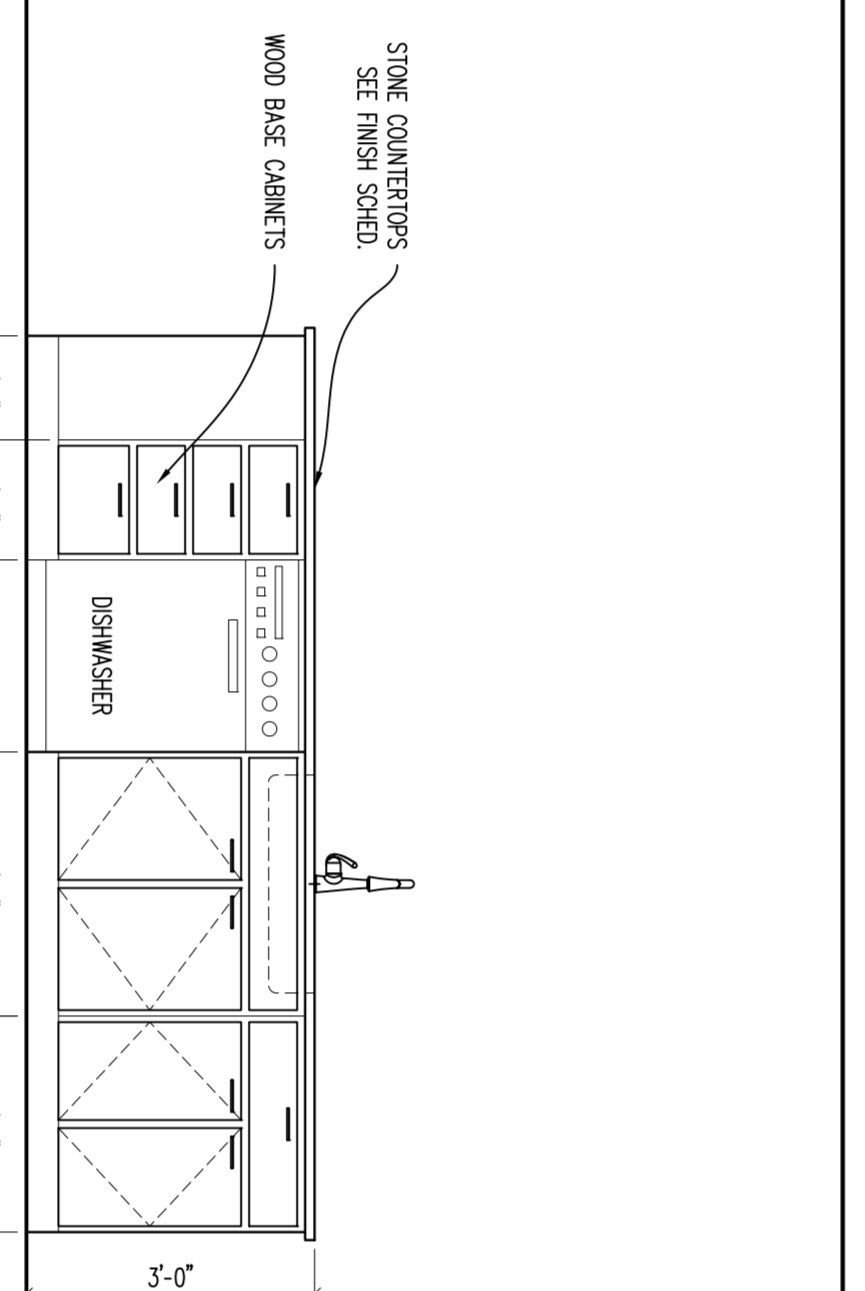


ELEVATION 5
 SCALE: 1/2" = 1'-0"

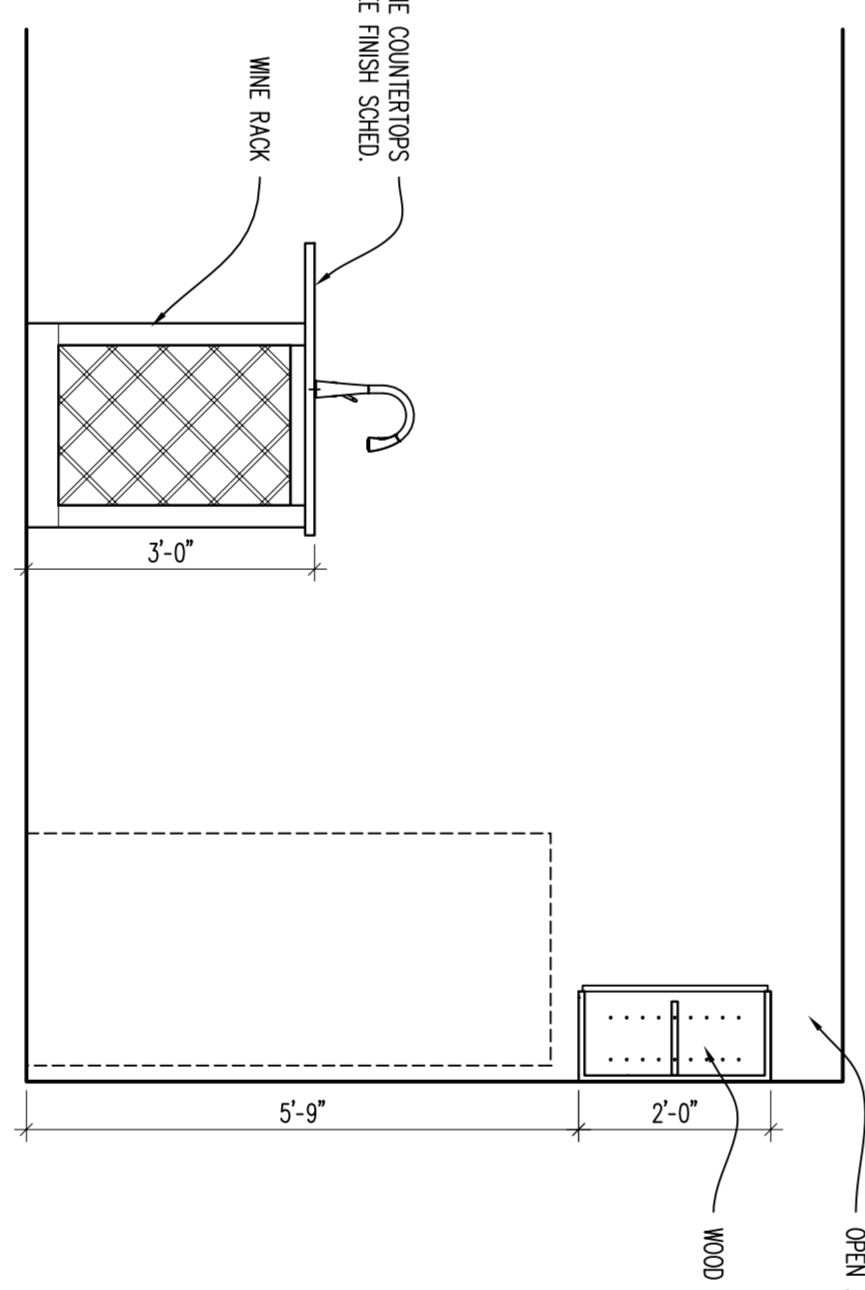

ELEVATION 6
 SCALE: 1/2" = 1'-0"

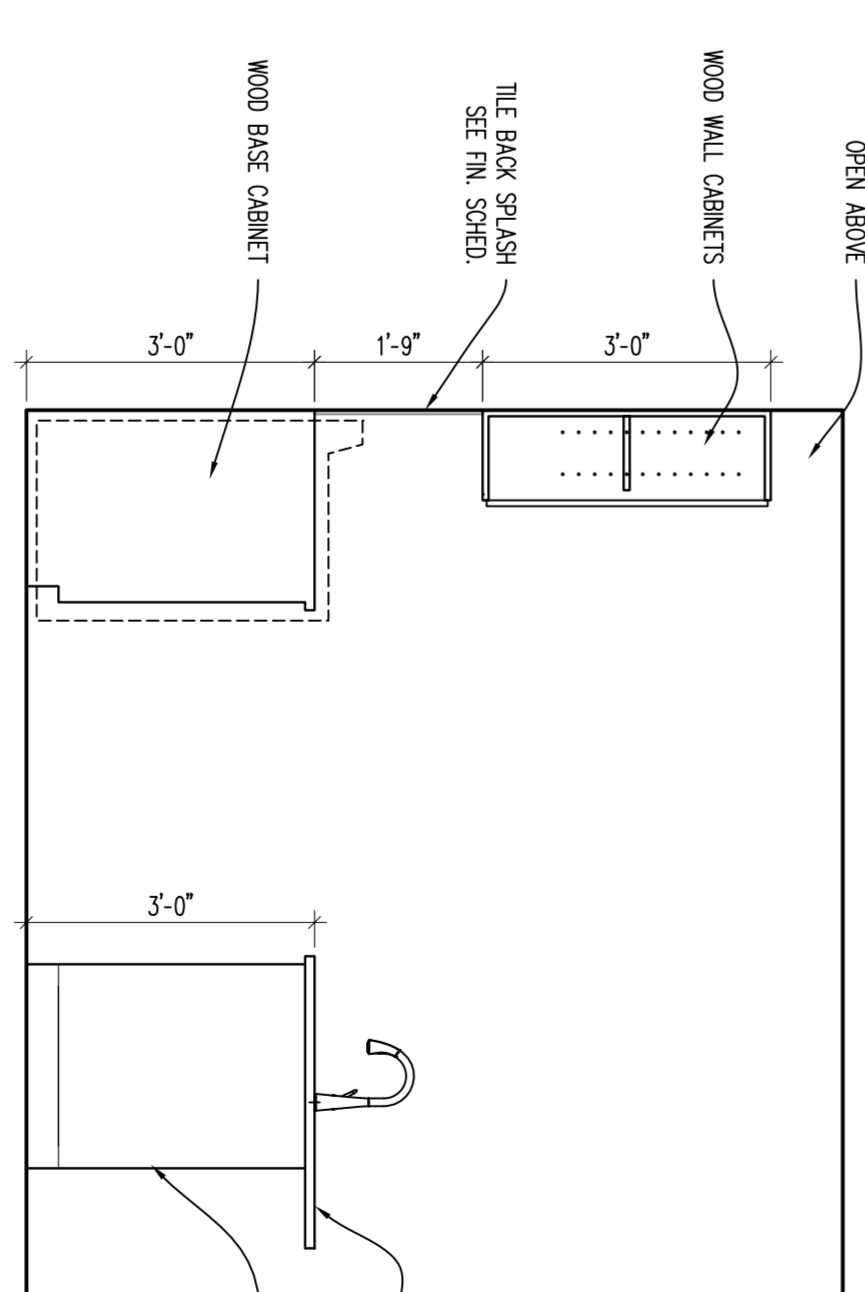

ELEVATION 7
 SCALE: 1/2" = 1'-0"

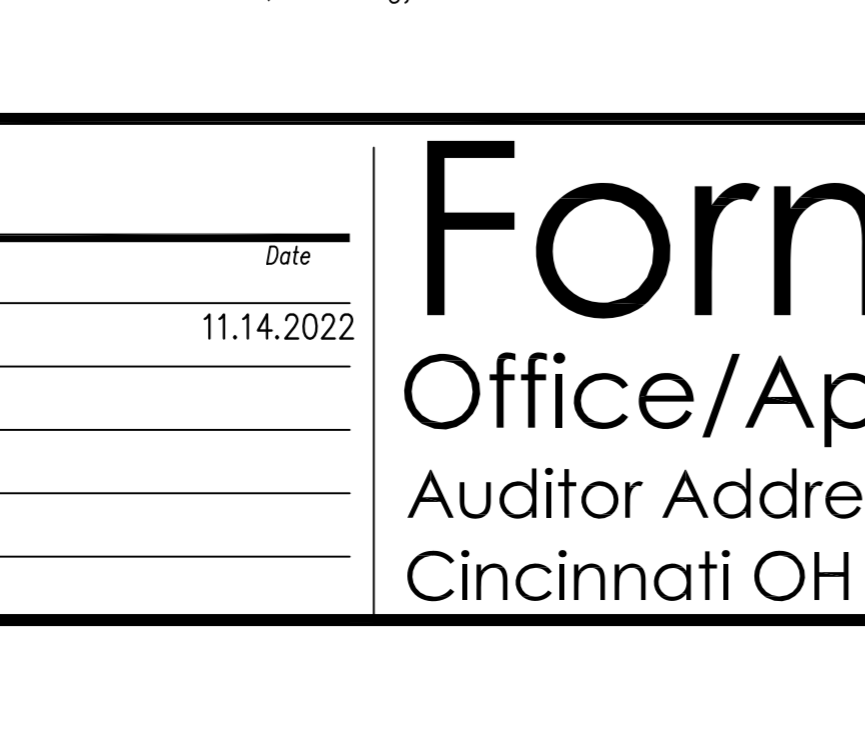

ELEVATION 8
 SCALE: 1/2" = 1'-0"

APARTMENT ROOM FINISH SCHEDULE

ROOM NAME	FLOOR	WALLS				REMARKS	REV. NO.
		NORTH	SOUTH	EAST	WEST		
DINING AREA	VP-1	RB-3	PT-1	PT-1	PT-3	NOTES: A	
KITCHEN	VP-1	RB-3	PT-1	PT-1	PT-3	NOTES: A	
BATHROOM	VP-1	RB-3	PT-1	PT-1	PT-3	NOTES: A	
HALLWAY / CORRIDOR	VP-1	RB-3	PT-1	PT-1	PT-3	NOTES: A	
CLOSET / LAUNDRY	VP-1	RB-3	PT-1	PT-1	PT-3	NOTES: A	
BEDROOM	VP-1	RB-3	PT-1	PT-1	PT-3	NOTES: A	
WALK-IN CLOSET	VP-1	RB-3	PT-1	PT-1	PT-3	NOTES: A	
STAIR SPACE	VP-1	RB-3	PT-1	PT-1	PT-3	NOTES: A	

APARTMENT DOOR SCHEDULE

DOOR MARK	DOOR LOCATION	DOOR INFORMATION			FRAME INFORMATION			REMARKS
		WIDTH	HEIGHT	THICK	TYPE	FRAME MATERIAL	HEAD JAMB OTHER	
	BEDROOM	2'-8"	1-3/8"	2	A	WD	5/4800	PRE-FINISH STAINED
	BATHROOM	2'-8"	1-3/8"	2	A	WD	5/4800	PRE-FINISH STAINED
	D C (L2)	6'-8"	1-3/8"	2	A	WD	5/4800	PRE-FINISH STAINED
	D C (L1)	6'-8"	1-3/8"	2	A	WD	5/4800	PRE-FINISH STAINED

- GENERAL APARTMENT NOTES**
- DOOR FRAME SHALL BE 4" FROM FACE OF WALL TO
 - BACKGROUND OF FRAME UNLESS TYPE 3 UNLESS
 - DIMENSIONS ARE FROM FINISH FACE OF WALL TO FINISH
 - FACE OF WALL UNLESS NOTED OTHERWISE
 - ALL LIGHTING FOR REFERENCE ONLY
 - ALL CABINET DIMENSIONS ARE FOR DESIGN INTENT ONLY
 - ALL FINISH SCHEDULES ARE TO RECEIVE A
 - REVISIONS TO FINISH SCHEDULES SHALL BE
 - INDICATED BY A NUMBER IN THE MARGINS
 - AND/OR HANGING THE WINDOWS, TOP OF ALL
 - ENERGY STAR APPLIANCES, PANTRY AND
 - PROVIDE REWORKING FOR FUTURE OWNER
 - ADJUSTABLE WEARLINE SHEETS
 - CEILING SHALL BE NEW
 - ALL PANTRY AND LINEN CLOSETS TO RECEIVE FINE (5)
 - EACH SHOWER TO BE PROVIDED W/ GLASS SHOWER DOOR
 - PROVIDE TWO INSTANT IN EACH APARTMENT (2) TOWEL
 - PROVIDE (1) TOWEL HOOK PER TOWEL (1) ROBE HOOK

Formica Building

Office/Apartments

Auditor Address: 115 E. 5th Street, Actual Address: 120 E. 4th Street
 Cincinnati OH 45202

modelgroup
 DEVELOPMENT • CONSTRUCTION • MANAGEMENT

1826 Race Street
 Cincinnati, Ohio 45202
 513.559.0048

STATE OF OHIO
JOSEPH A. BODKIN
 5133567
 REGISTERED ARCHITECT

Joseph A. Bodkin, License #5133567
 Expiration Date: 12.31.2025



Project: Formica Building
 115 E 5th Street
 Cincinnati, Ohio 45202

Sheet Title: Unit L Construction
 Project No: 2022_259
 Issue Date: 11.14.2022

Scale: As Noted

Revisions: ENG CHG #1

A311

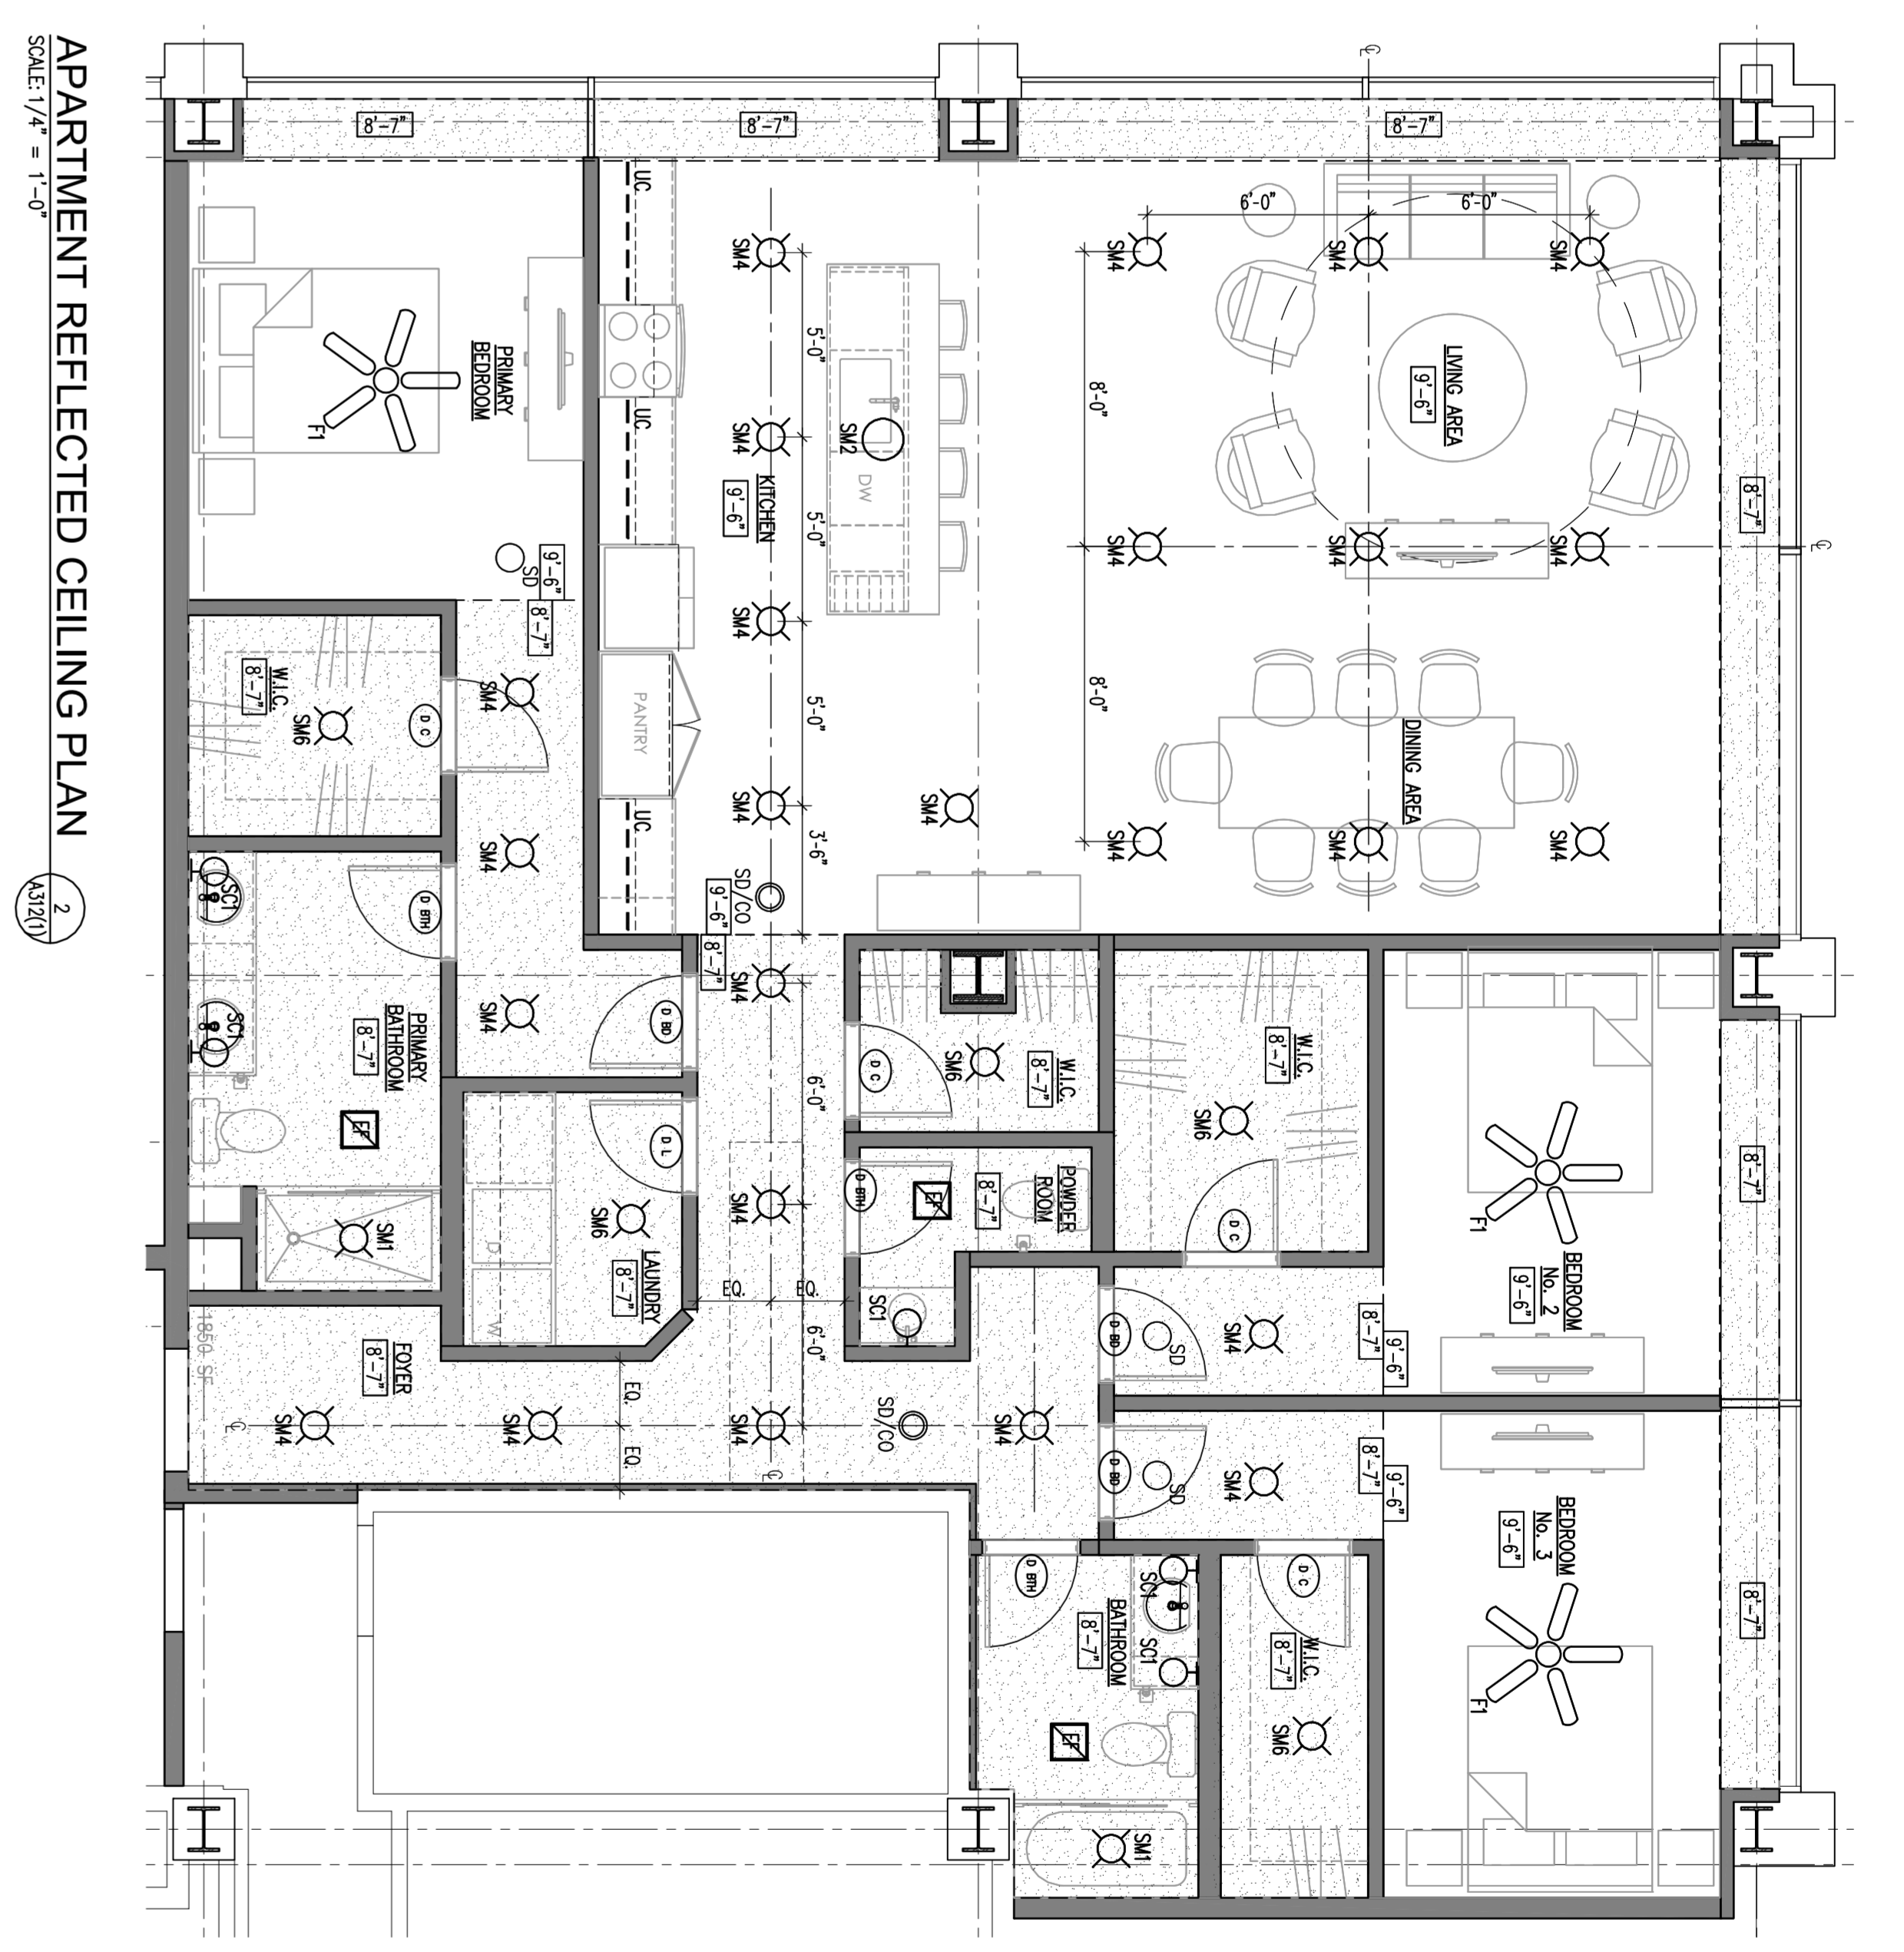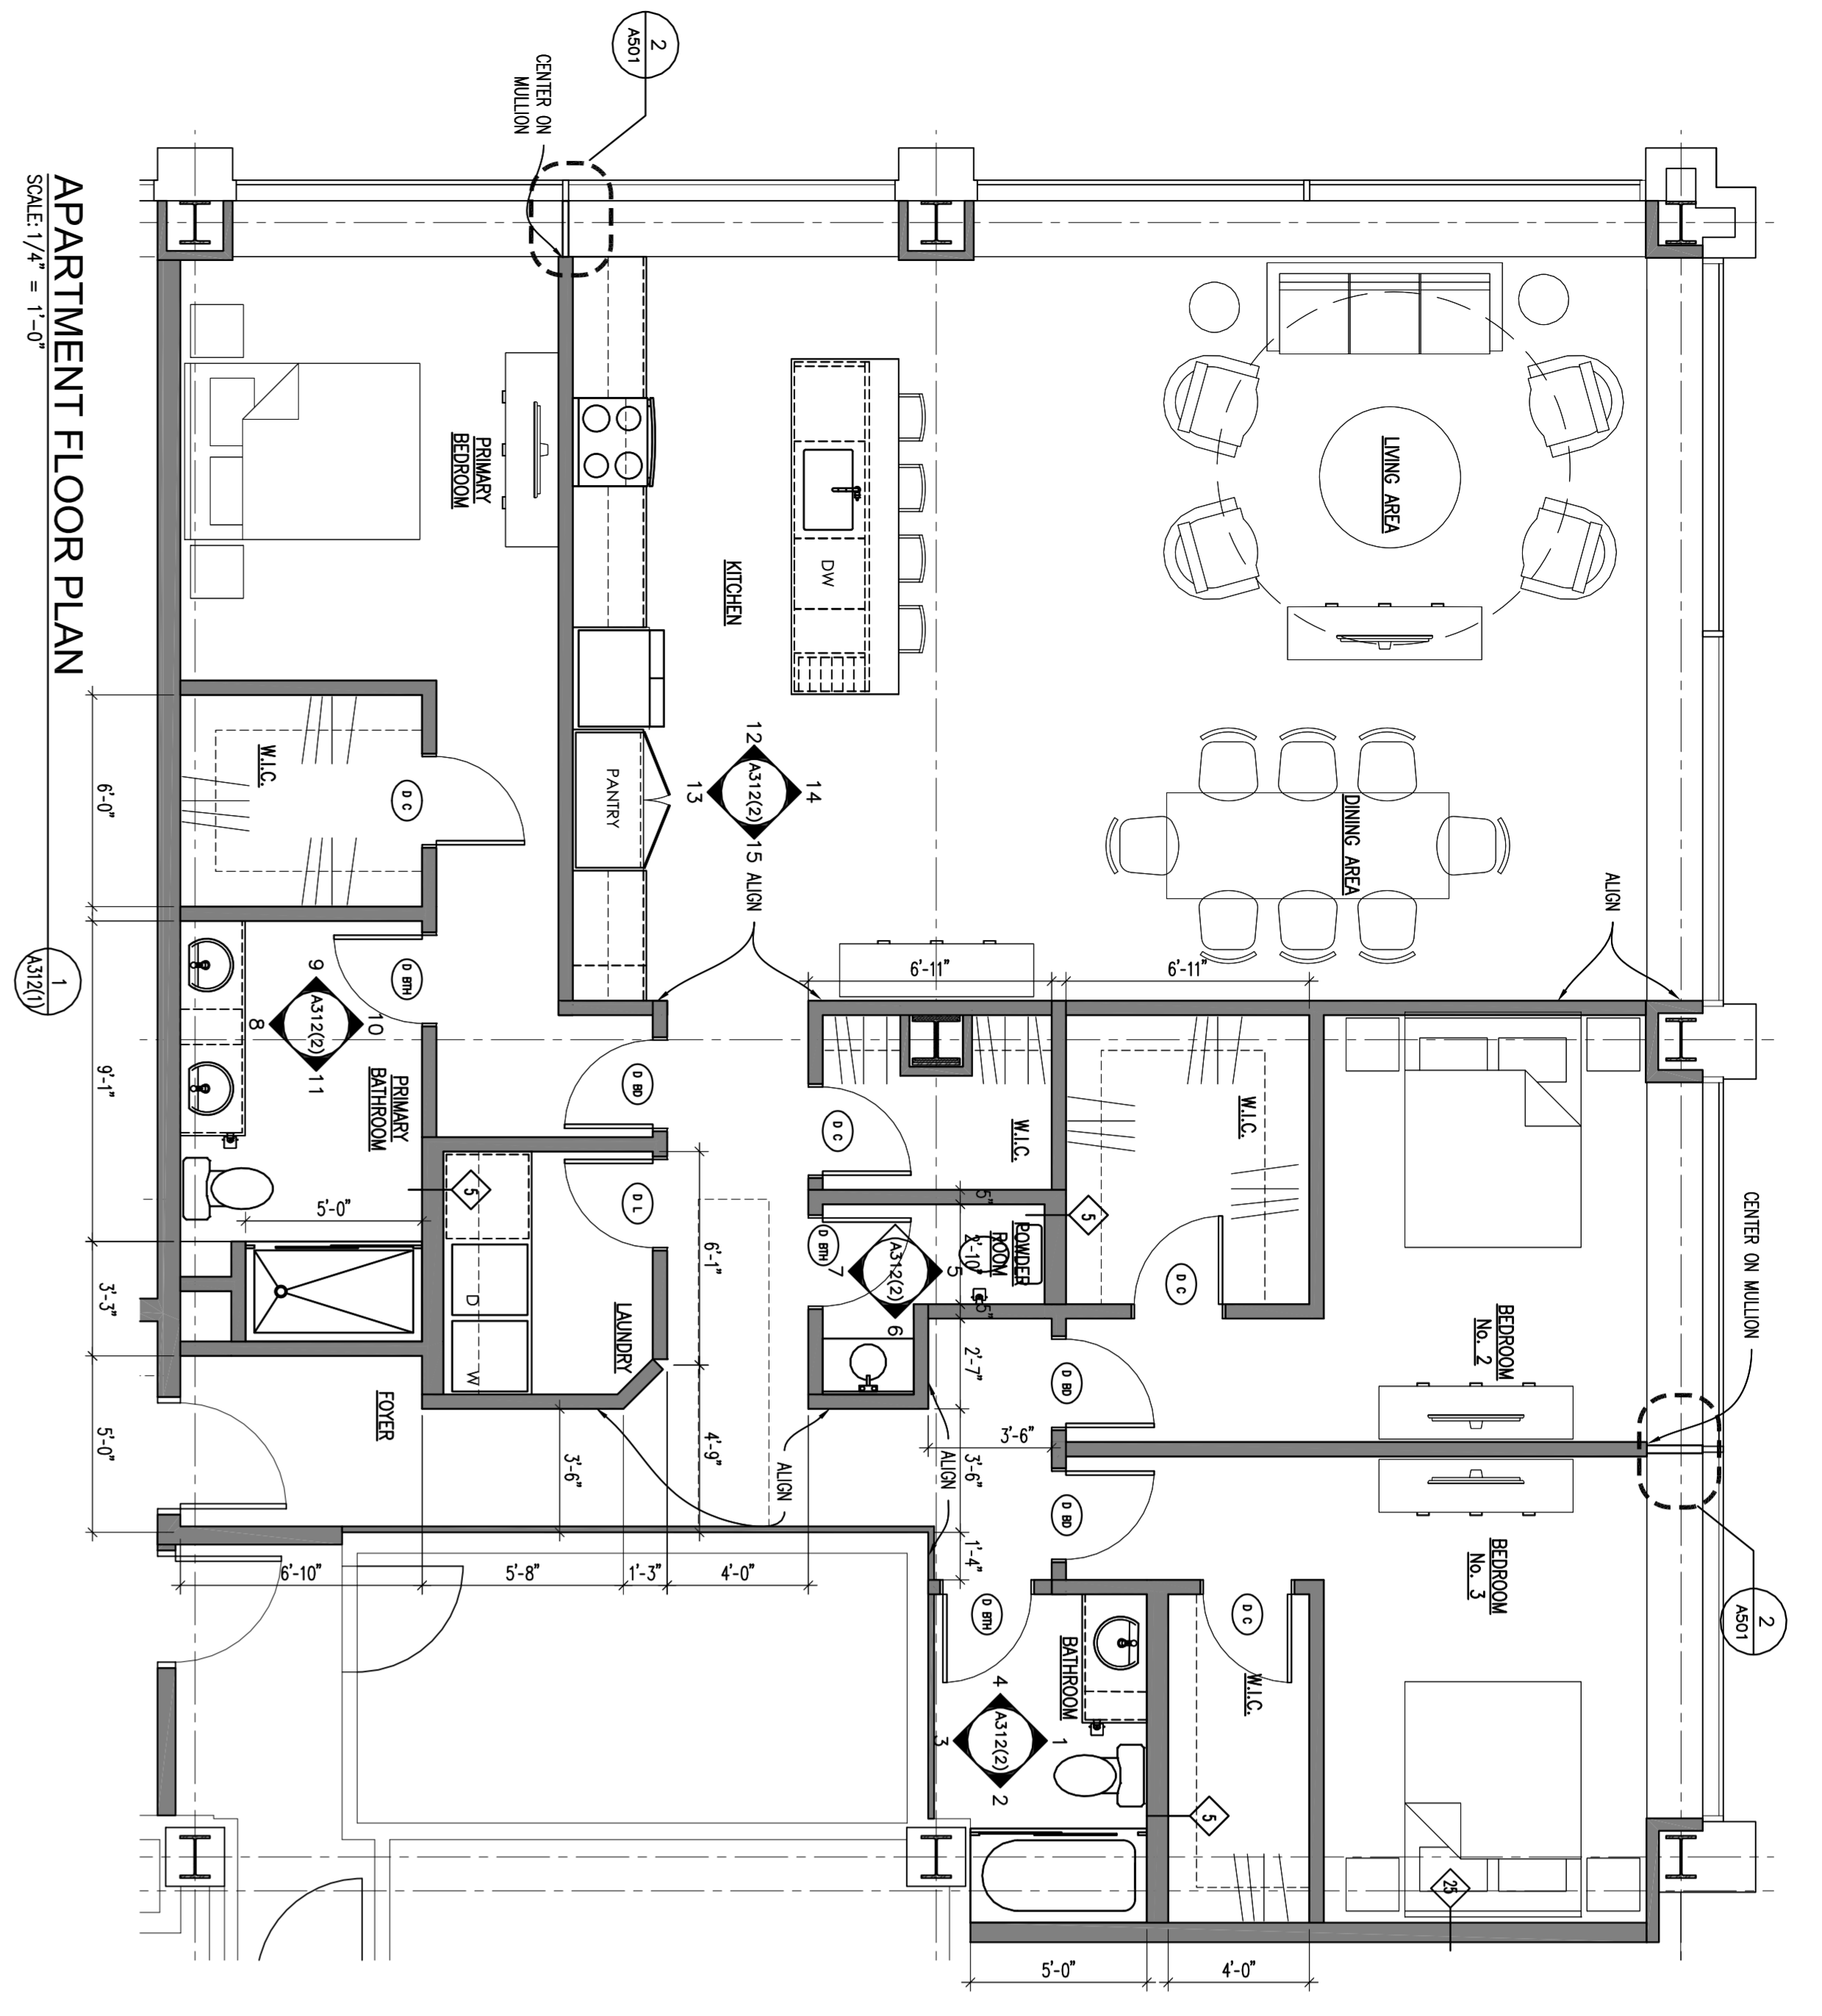

APARTMENT ROOM FINISH SCHEDULE						REV. NO.	
ROOM NAME	FLOOR	BASE	WALLS				REMARKS
			NORTH	SOUTH	EAST	WEST	
LIVING / DINING AREA	VP-1	RB-3	PF-1	PF-1	PF-1	PF-3	NOTES: A
KITCHEN	VP-1	RB-3	PF-1	PF-1	PF-1	PF-3	NOTES: A
CLOSET / LAUNDRY	VP-1	RB-3	PF-1	PF-1	PF-1	PF-3	NOTES: A
POWDER ROOM	VP-1	RB-3	PF-1	PF-1	PF-1	PF-3	NOTES: A
BEDROOM	VP-1	RB-3	PF-1	PF-1	PF-1	PF-3	NOTES: A
BEDROOM	VP-1	RB-3	PF-1	PF-1	PF-1	PF-3	NOTES: A
BATHROOM	VP-1	RB-3	PF-1	PF-1	PF-1	PF-3	NOTES: A
POWDER ROOM	VP-1	RB-3	PF-1	PF-1	PF-1	PF-3	NOTES: A

NOTES:
 A. ALL TRIM, CASINGS, DOORS, ETC ARE TO BE PAINTED. COLOR & SHEEN TBL.

APARTMENT DOOR SCHEDULE						REV. NO.						
DOOR MARK	DOOR LOCATION	WIDTH	HEIGHT	THICK	STYLE		FRAME INFORMATION			REMARKS		
						DOOR MATERIAL	TYPE	FRAME MATERIAL	HEAD JAMBOTHER		HDW. SET	FIRE RATING
O BR (A3)	BEDROOM	2'-8"	6'-8"	1 3/8"	2	OKM	A	WD	5/480	6/480	2	PRE-FINISH STAINED
O BR (A3)	BEDROOM / POWDER	2'-8"	6'-8"	1 3/8"	2	OKM	A	WD	5/480	6/480	2	PRE-FINISH STAINED
O C (A4)	CLOSET / WALK IN	2'-8"	6'-8"	1 3/8"	2	OKM	A	WD	5/480	6/480	3	PRE-FINISH STAINED
O L (A1)	LAUNDRY	2'-8"	6'-8"	1 3/8"	2	OKM	A	WD	5/480	6/480	4	PRE-FINISH STAINED

- GENERAL APARTMENT NOTES**
- A. DOOR FRAME SHALL BE 4" FROM FACE OF WALL TO FACE OF WALL.
 - B. ALL NEW UNIT PARTITIONS ARE TYPE 3 UNDO.
 - C. DIMENSIONS ARE FROM FINISH FACE OF WALL TO FINISH FACE OF WALL.
 - D. CENTER ALL CLOSET DOORS ON CLOSET UNDO.
 - E. ALL LIGHTING FOR REFERENCE ONLY. CONSULT UNIT ONLY.
 - F. CABINET MARKERS TO IDENTIFY FINISH CABINETS FOR FINISHING.
 - G. FINISHING SHALL BE DONE AFTER ALL CABINETS ARE IN PLACE.
 - H. FINISHING SHALL BE DONE AFTER ALL CABINETS ARE IN PLACE.
 - I. FINISHING SHALL BE DONE AFTER ALL CABINETS ARE IN PLACE.
 - J. FINISHING SHALL BE DONE AFTER ALL CABINETS ARE IN PLACE.
 - K. FINISHING SHALL BE DONE AFTER ALL CABINETS ARE IN PLACE.
 - L. FINISHING SHALL BE DONE AFTER ALL CABINETS ARE IN PLACE.
 - M. FINISHING SHALL BE DONE AFTER ALL CABINETS ARE IN PLACE.
 - N. FINISHING SHALL BE DONE AFTER ALL CABINETS ARE IN PLACE.
 - O. FINISHING SHALL BE DONE AFTER ALL CABINETS ARE IN PLACE.


Project	Formica Building	No. Revisions	Date
Sheet	115 E 5th Street	ENG CHG #1	11.14.2022
Scale	Cincinnati, Ohio 45202		
As Noted	Construction		
Project No.	2022_259	Issue Date	
Scale	As Noted	Drawn	Checked

Formica Building


Office/Apartments
 Auditor Address: 115 E. 5th Street, Actual Address: 120 E. 4th Street
 Cincinnati OH 45202

modelgroup
 DEVELOPMENT • CONSTRUCTION • MANAGEMENT


1826 Race Street
 Cincinnati, Ohio 45202
 513.559.0048

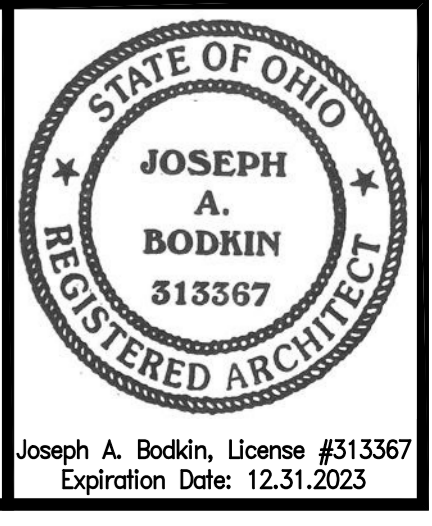


A312 (1)

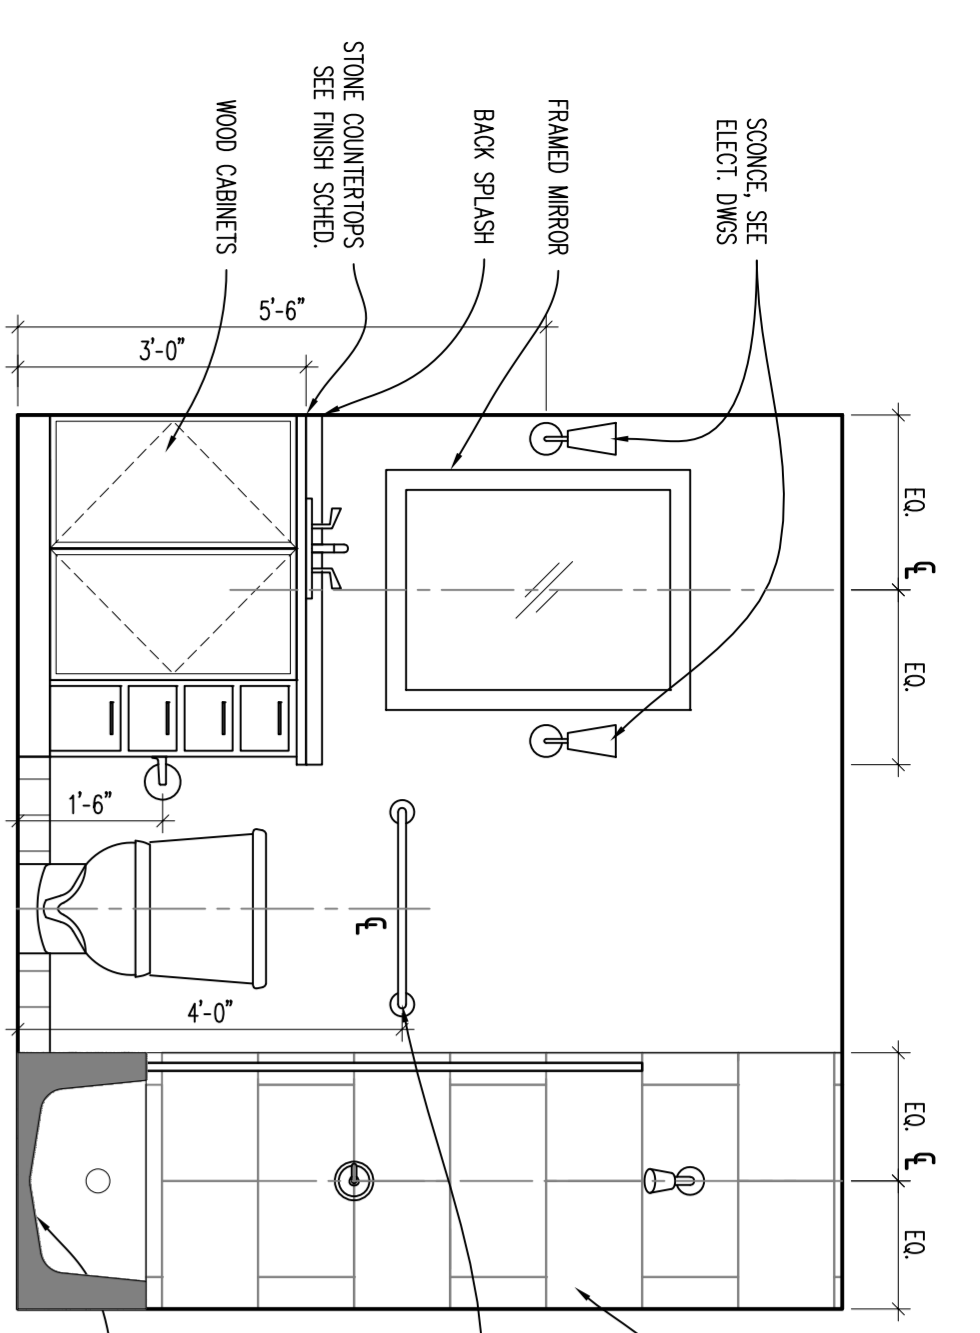


ELEVATION 1
 SCALE: 1/2" = 1'-0"

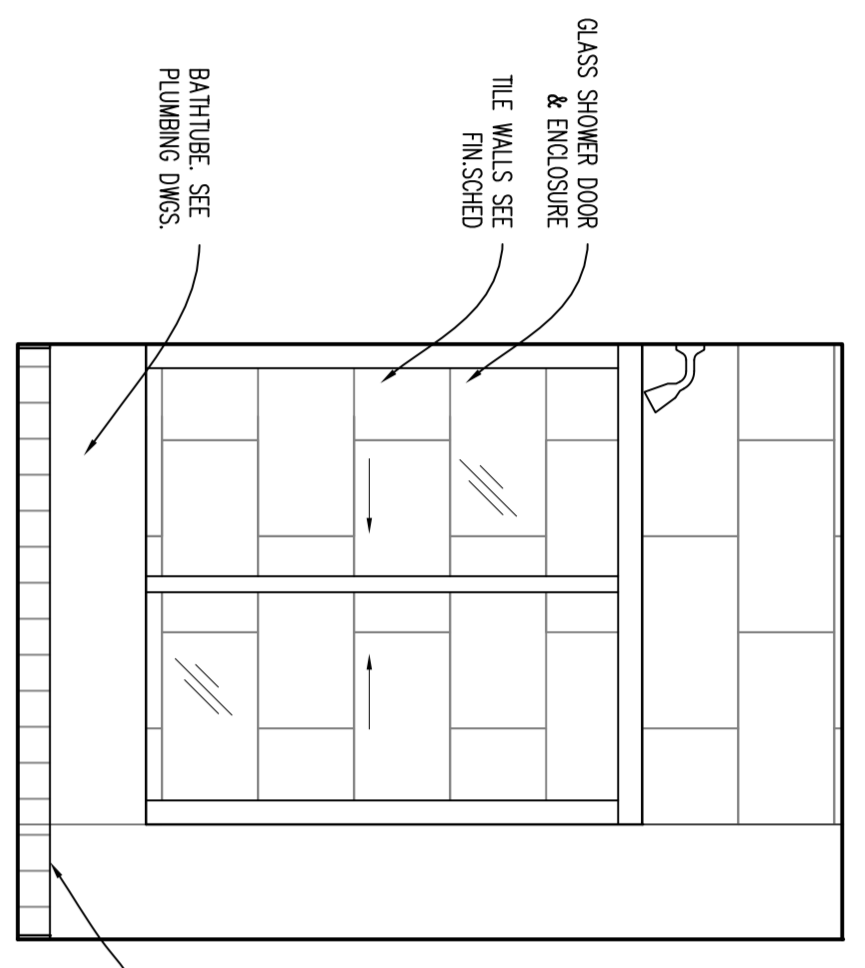


ELEVATION 2
 SCALE: 1/2" = 1'-0"

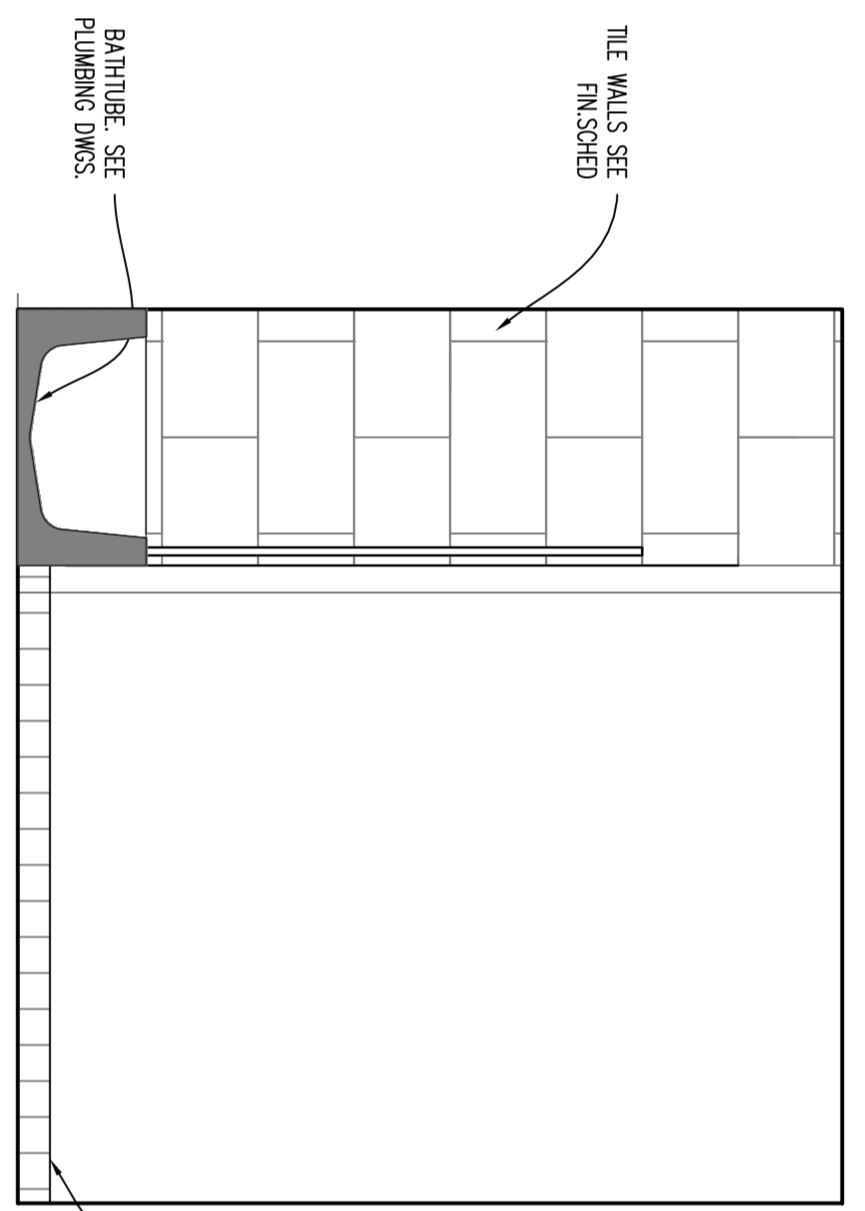


ELEVATION 3
 SCALE: 1/2" = 1'-0"

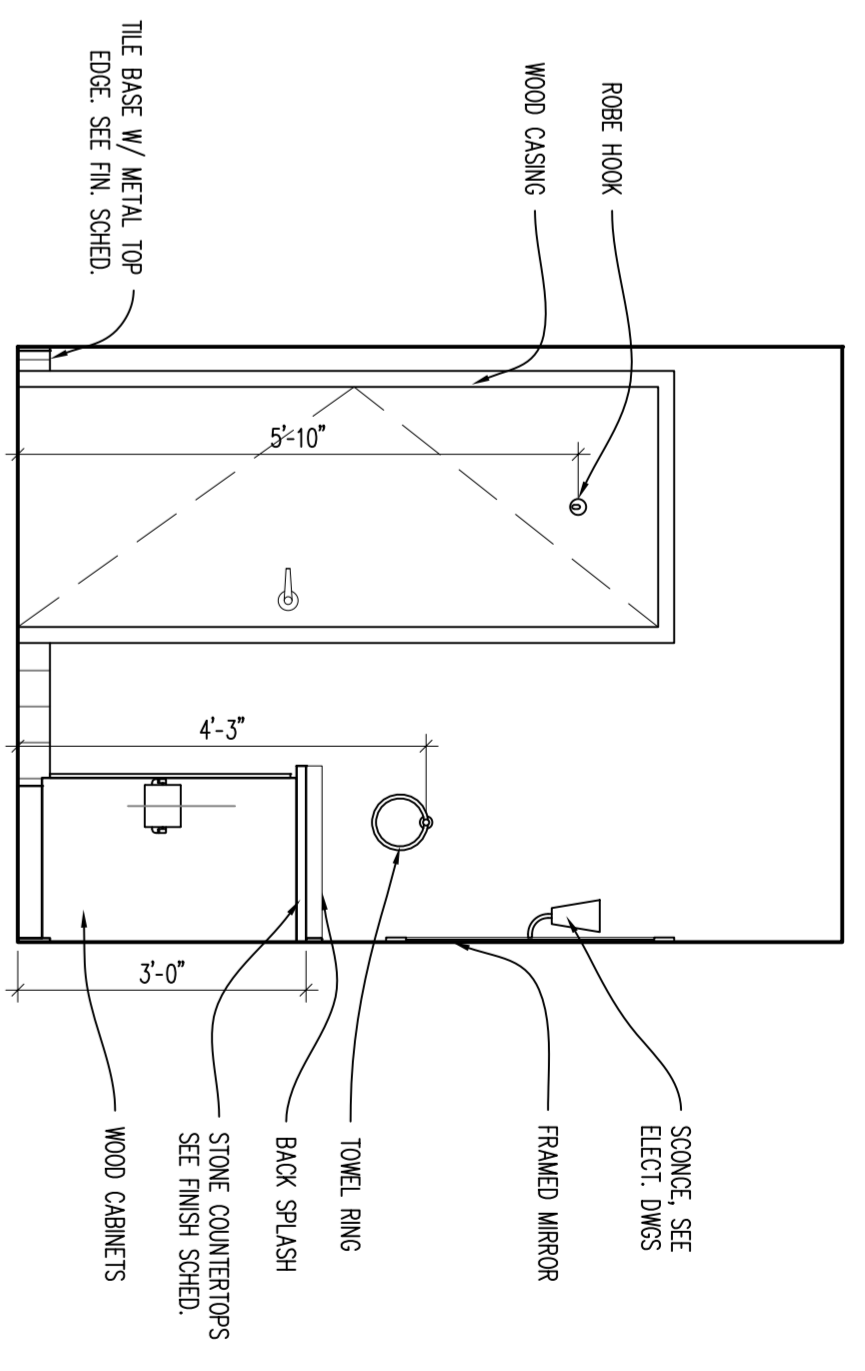


ELEVATION 4
 SCALE: 1/2" = 1'-0"

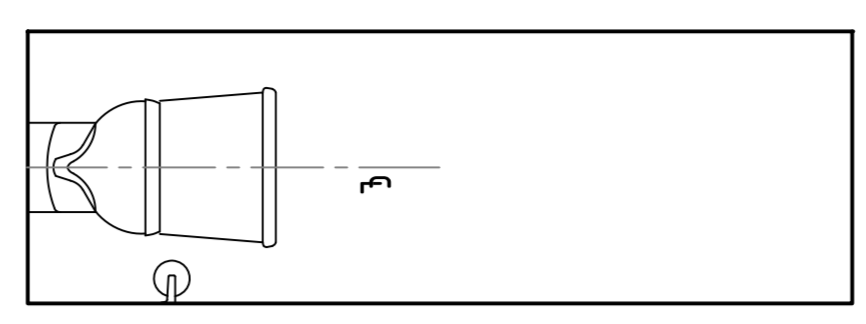


ELEVATION 5
 SCALE: 1/2" = 1'-0"

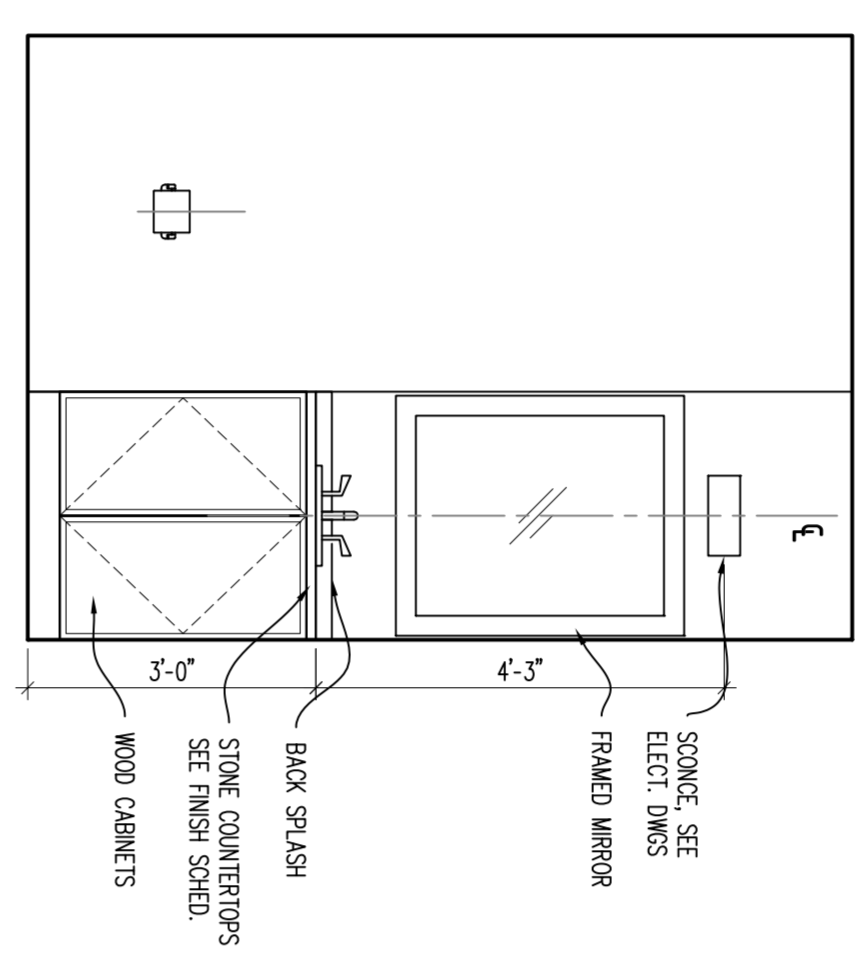


ELEVATION 6
 SCALE: 1/2" = 1'-0"

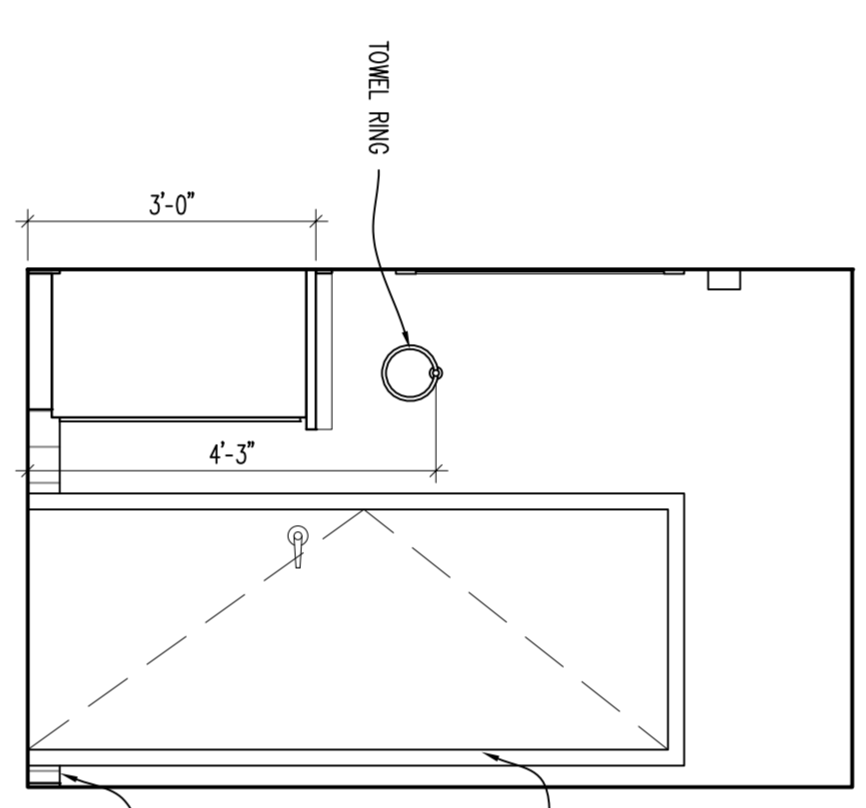


ELEVATION 7
 SCALE: 1/2" = 1'-0"

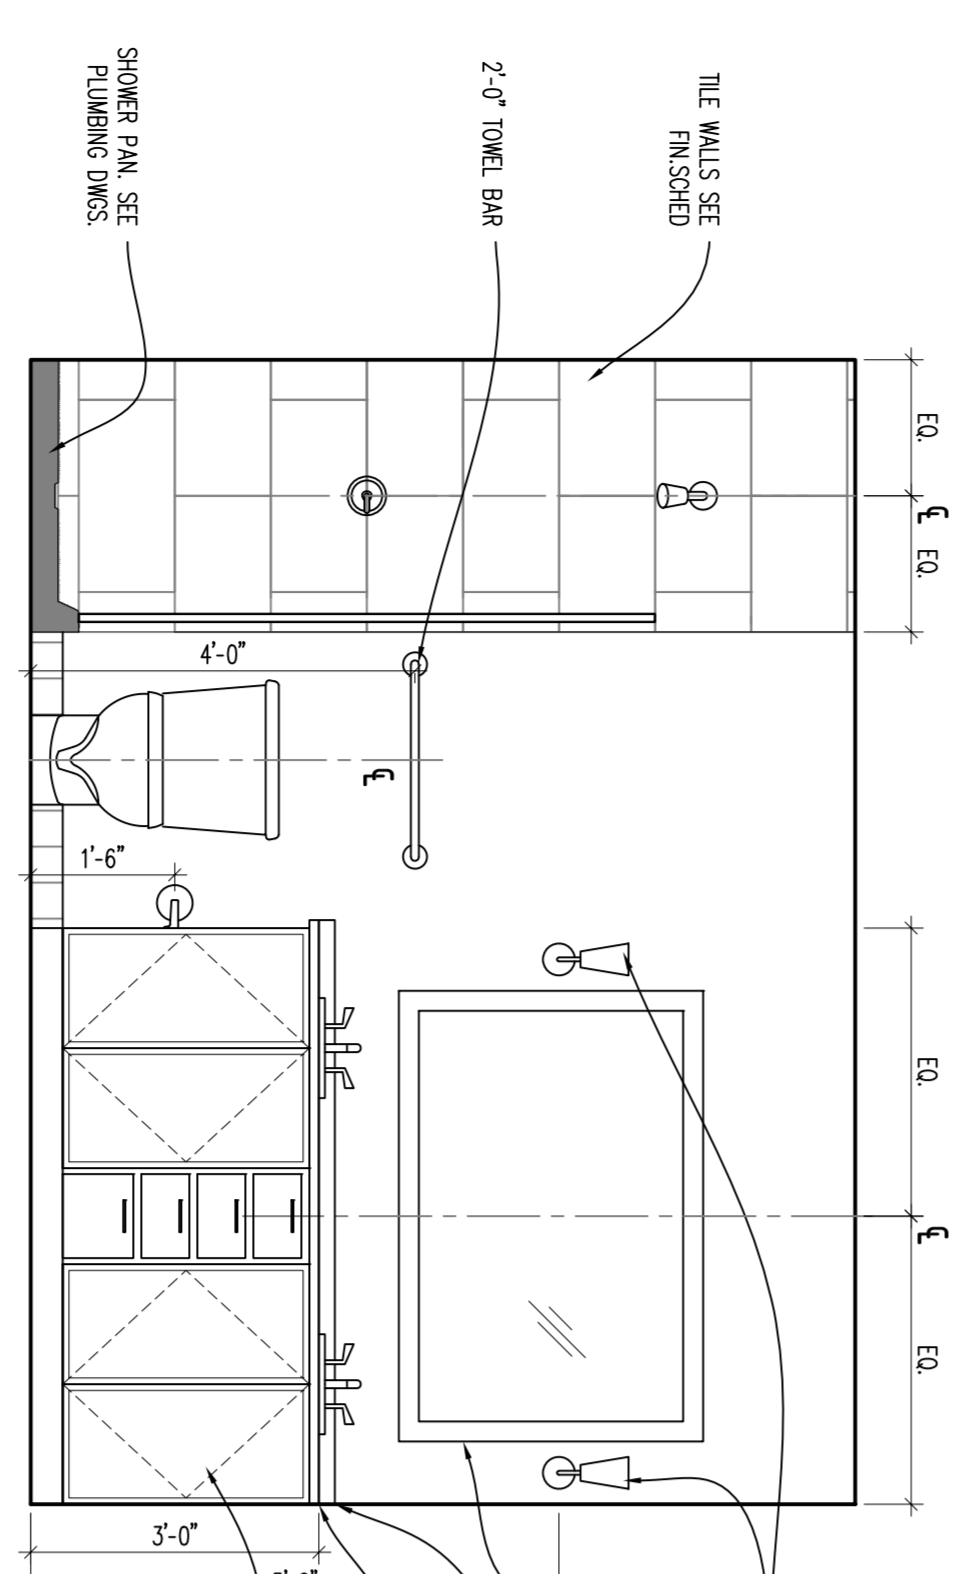


ELEVATION 8
 SCALE: 1/2" = 1'-0"

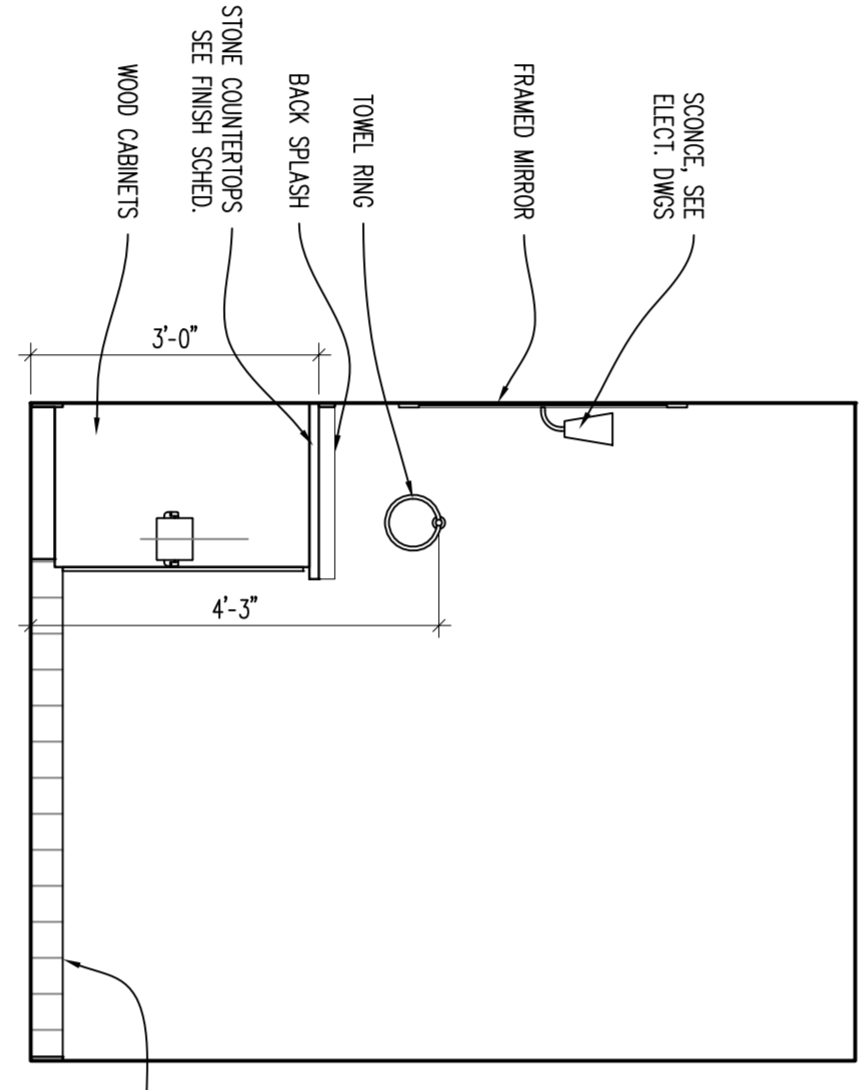


ELEVATION 9
 SCALE: 1/2" = 1'-0"

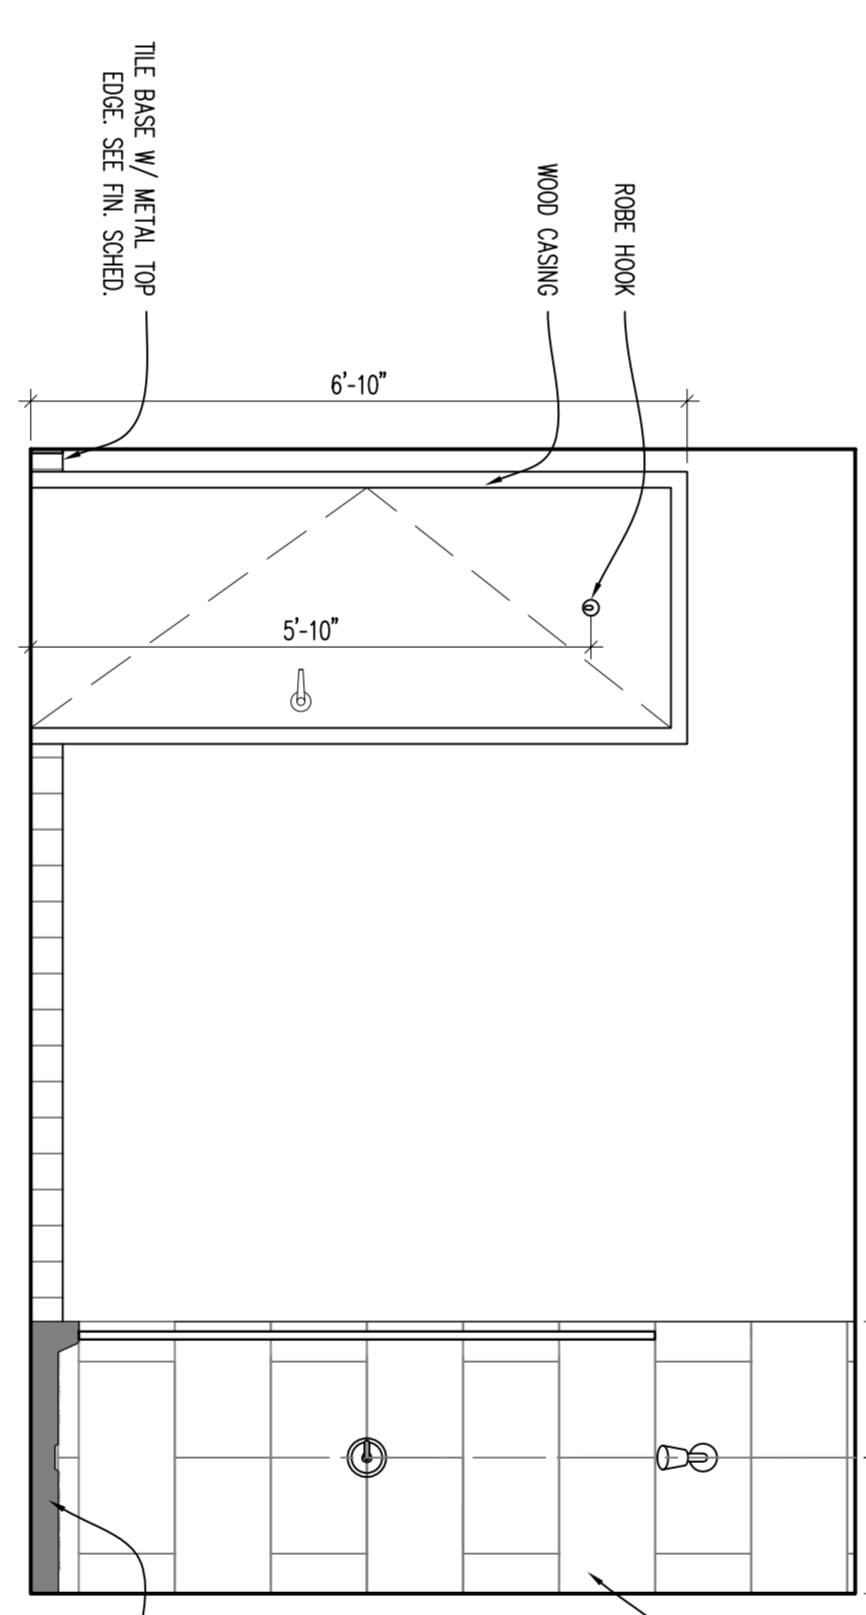


ELEVATION 10
 SCALE: 1/2" = 1'-0"

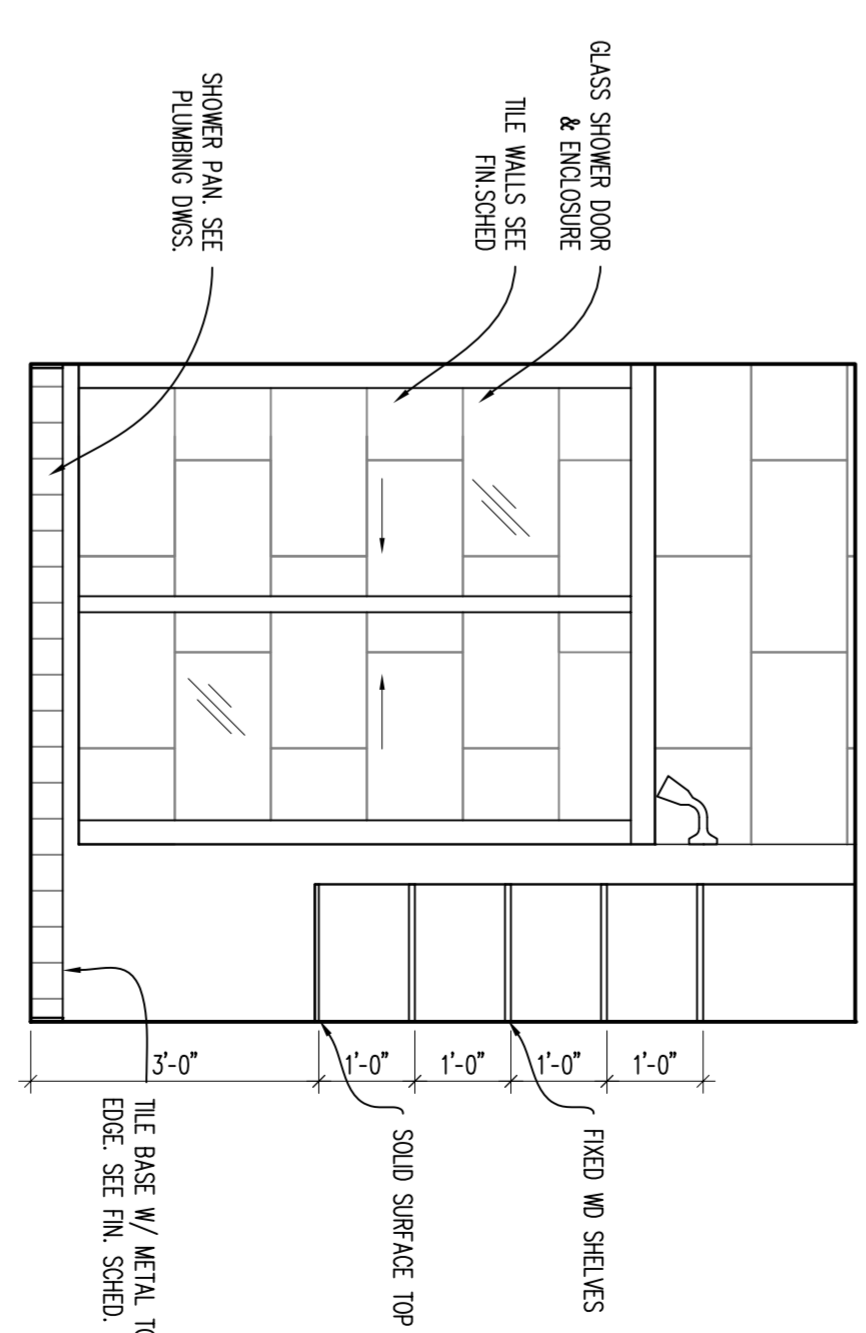


ELEVATION 11
 SCALE: 1/2" = 1'-0"

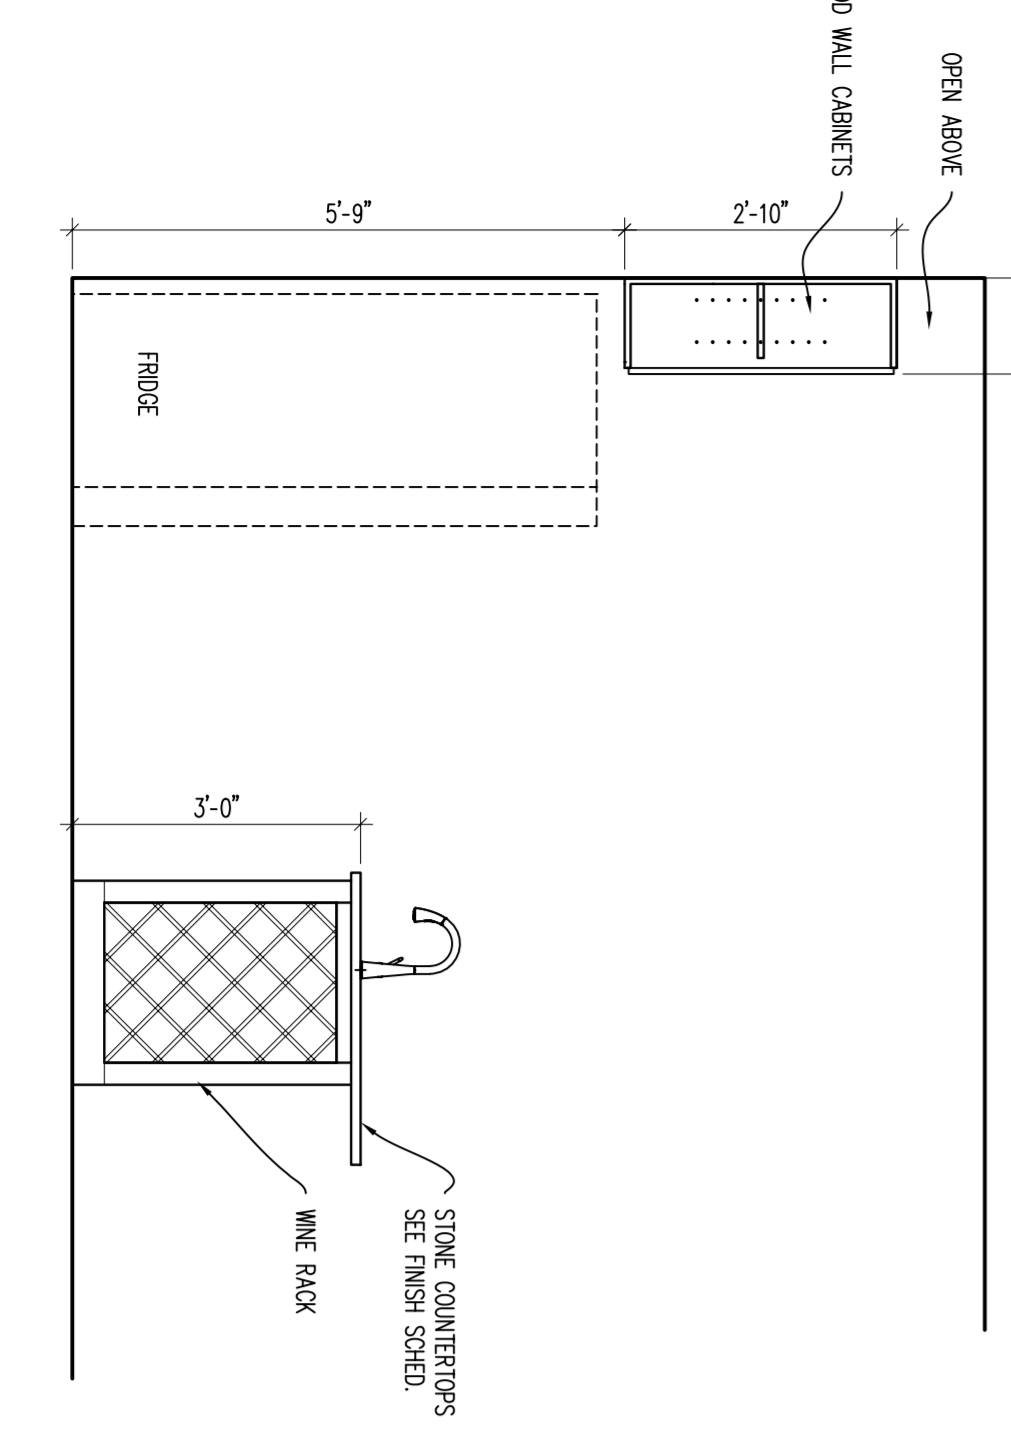


ELEVATION 12
 SCALE: 1/2" = 1'-0"

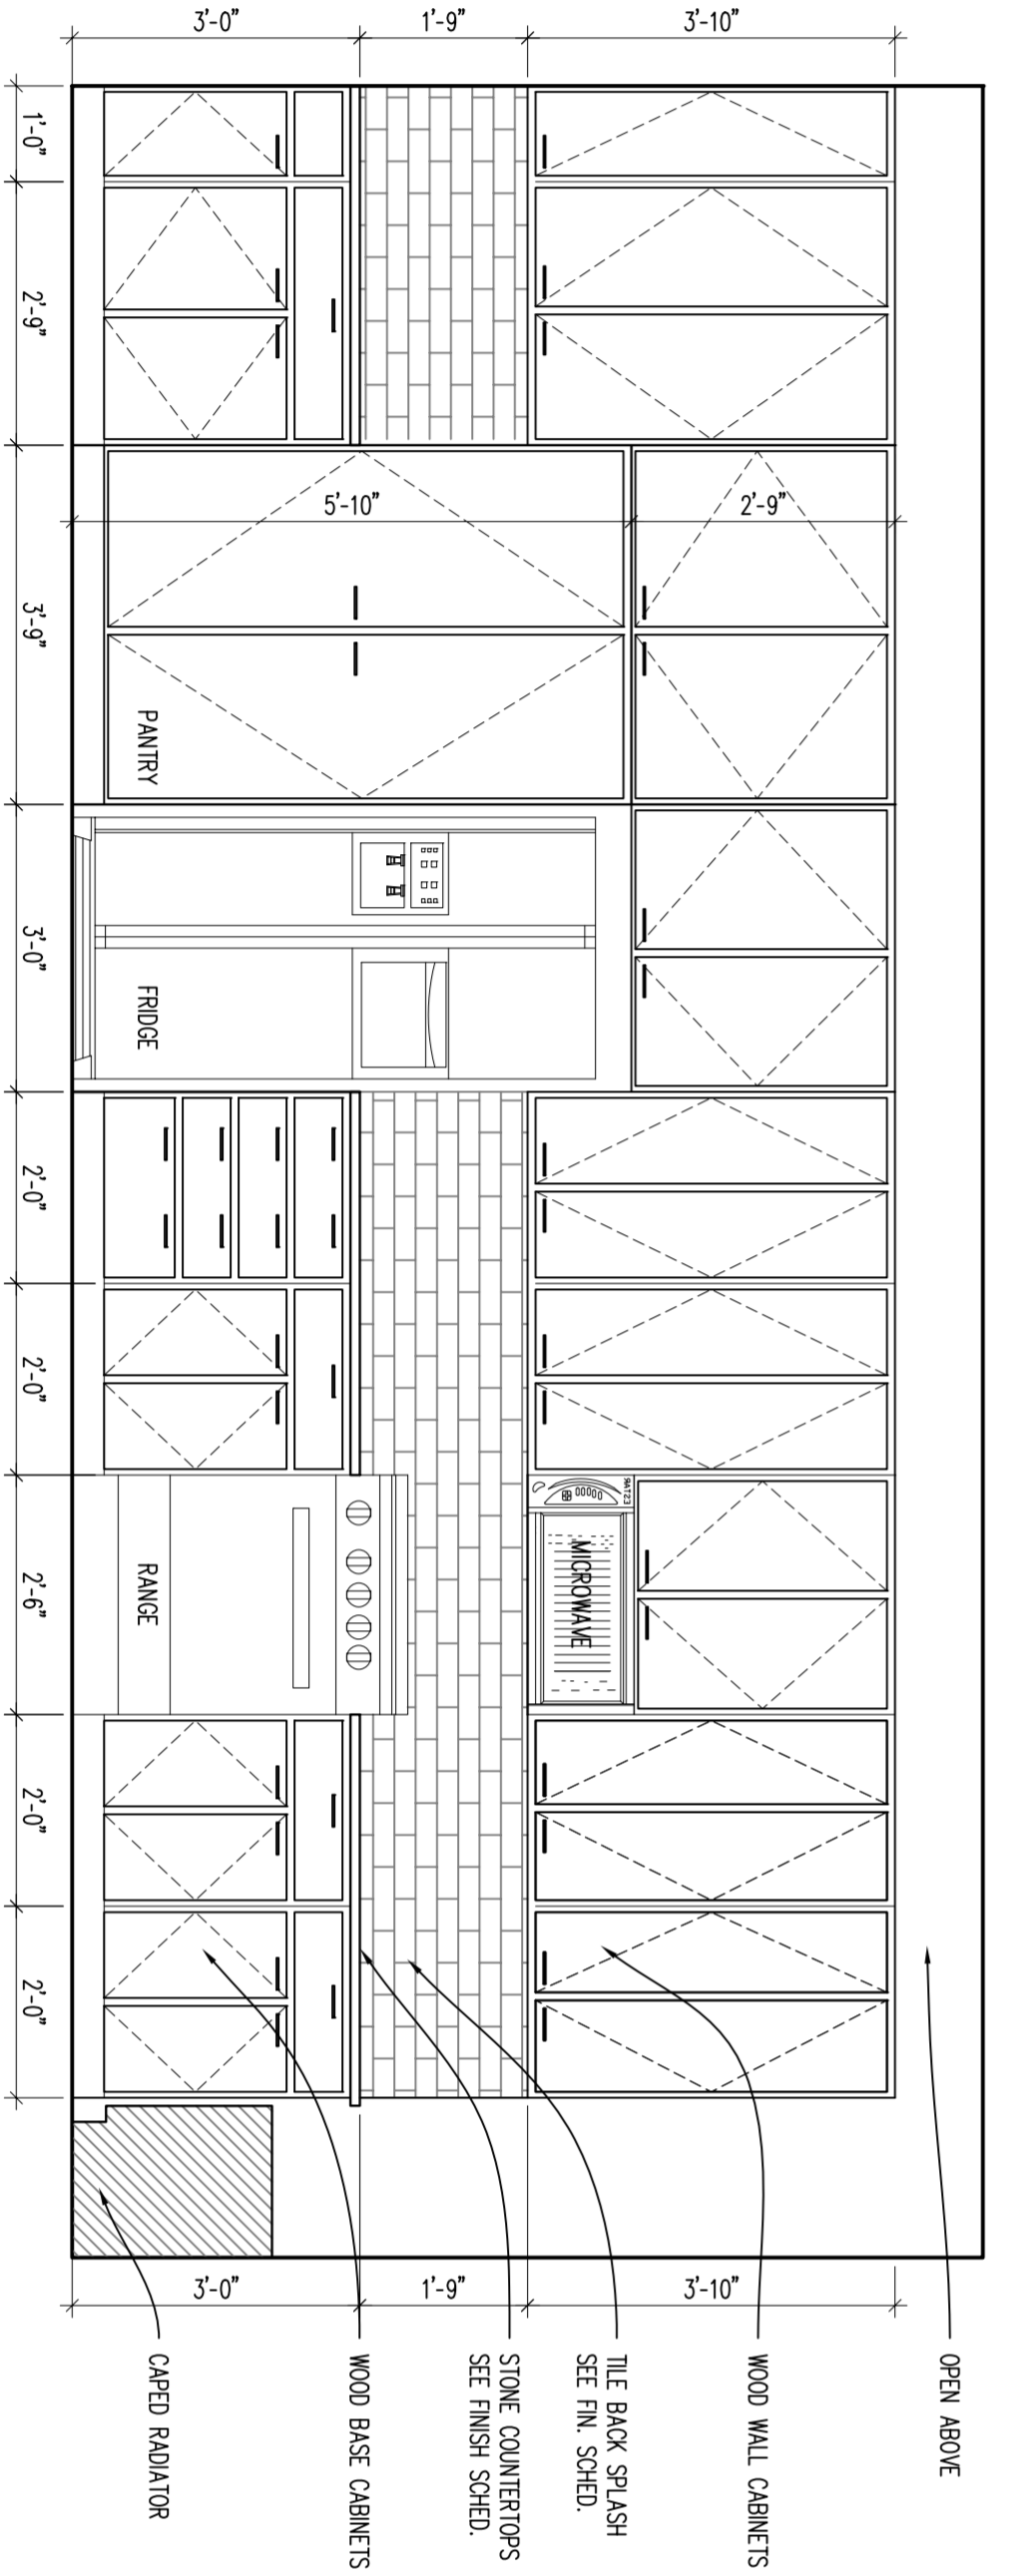

ELEVATION 13
 SCALE: 1/2" = 1'-0"

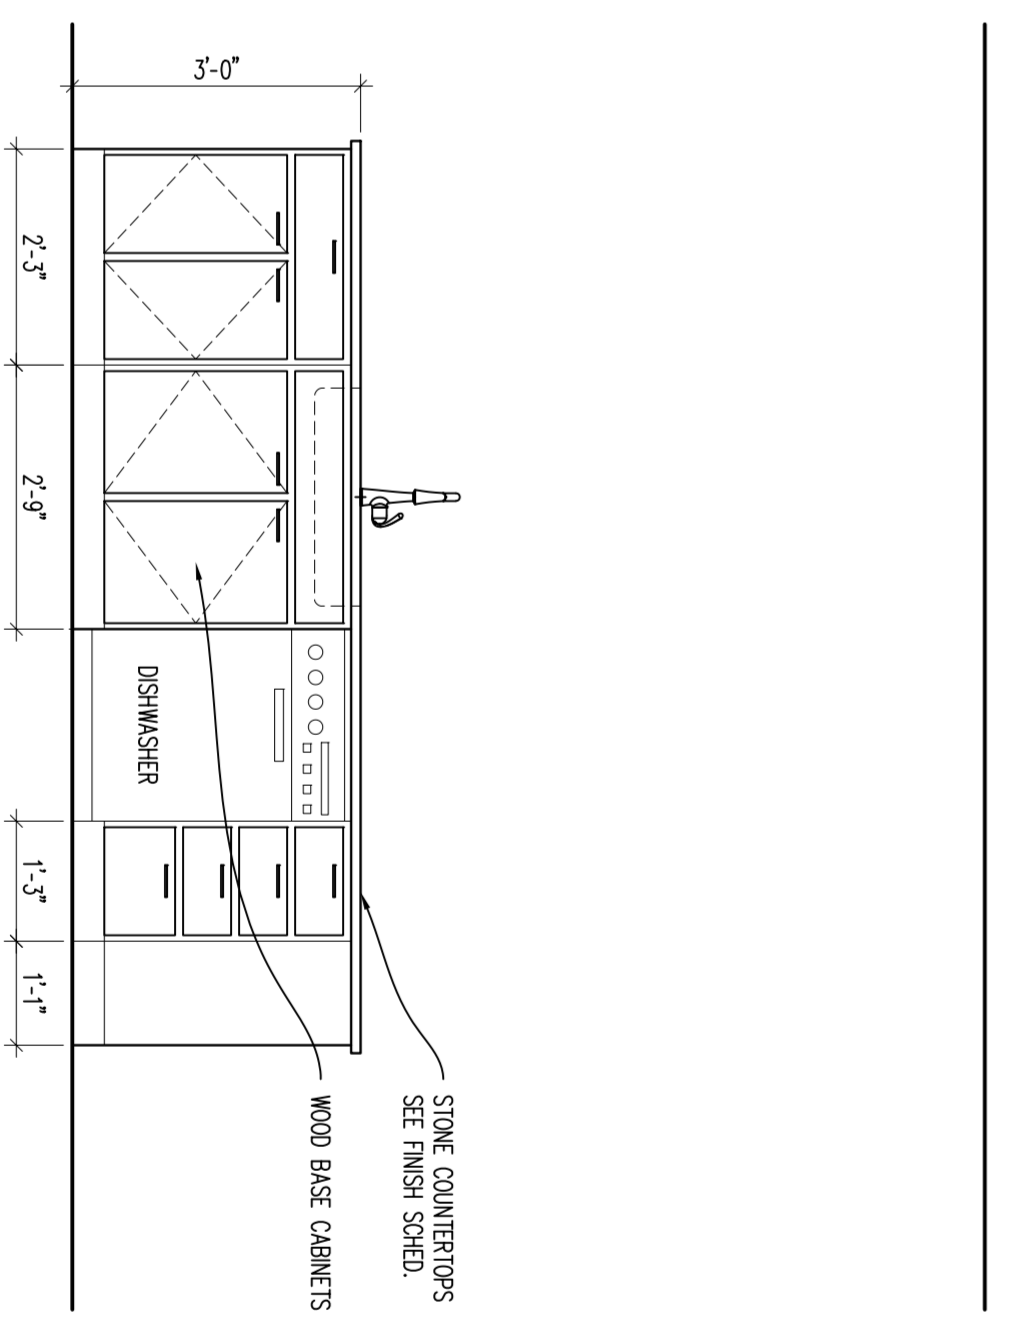

ELEVATION 14
 SCALE: 1/2" = 1'-0"

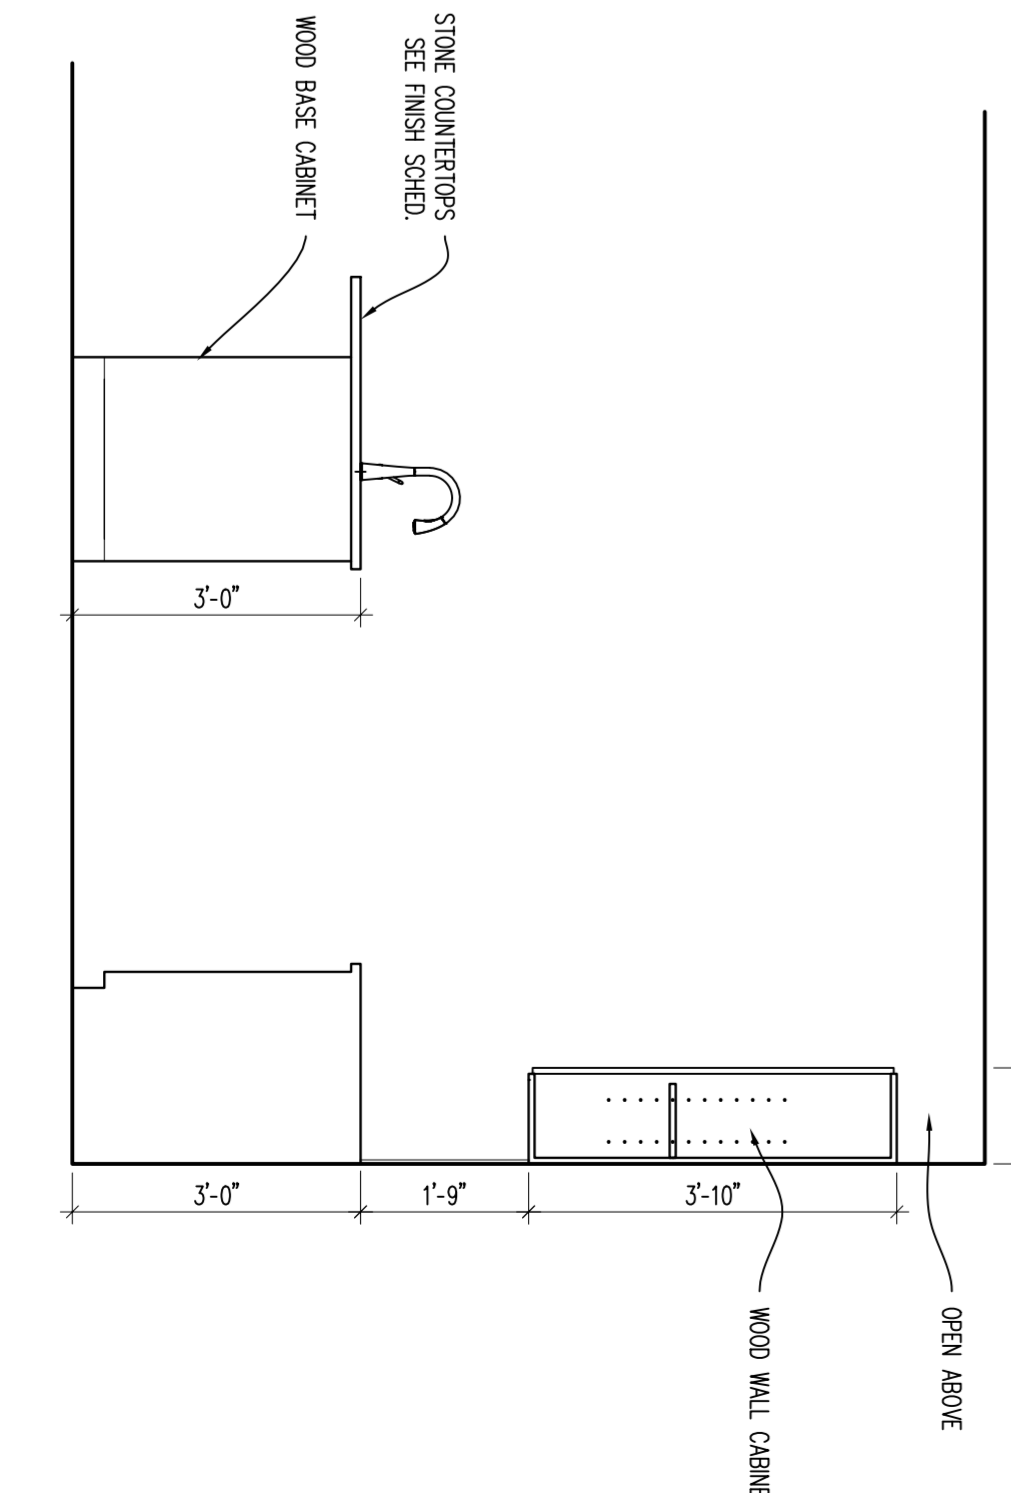

ELEVATION 15
 SCALE: 1/2" = 1'-0"

- GENERAL APARTMENT NOTES**
- DOOR FRAME SHALL BE 4" FROM FACE OF WALL TO ALL NEW UNIT PARTITIONS ARE TYPE 3 UNDO.
 - DIMENSIONS ARE FROM FINISH FACE OF WALL TO FINISH CENTER ALL CLOSET DOORS ON CLOSETS UNDO.
 - ALL LIGHTING FOR REFERENCE ONLY. CONSULT UNIT ONLY FOR LIGHTING FIXTURES.
 - REVIEW BASIS OF DESIGN AND SMART CABINETS. THIS FINISHED PANEL THAT MATCHES THE CABINETS. THIS INCLUDES CABINETS THAT ARE UP AGAINST THE DIVIDORS AND CLOSETS IN THE APARTMENT UNITS WILL BE NEW BATHROOMS.
 - ENERGY STAR APPLIANCES.
 - ALL PAINT AND LINEN CLOSETS TO RECEIVE FINE (6) BATHROOMS.
 - COAT RACK UNDO.
 - DOOR SWIVER TO BE REMOVED W/ GLASS SHOWER DOOR. (1) TOWEL PAPER HOLDER (1) ROBE HOOK.

Project	Formica Building	No. Revisions	Date
Address	115 E 5th Street	ENG CHG #1	11.14.2022
Sheet	Light M		
Construction			
Project No.	2022_259	Issue Date	
Scale	As Noted	Drawn	Checked


Formica Building

Office/Apartments















Auditor Address: 115 E. 5th Street, Actual Address: 120 E. 4th Street
 Cincinnati OH 45202



1826 Race Street
 Cincinnati, Ohio 45202
 513.559.0048

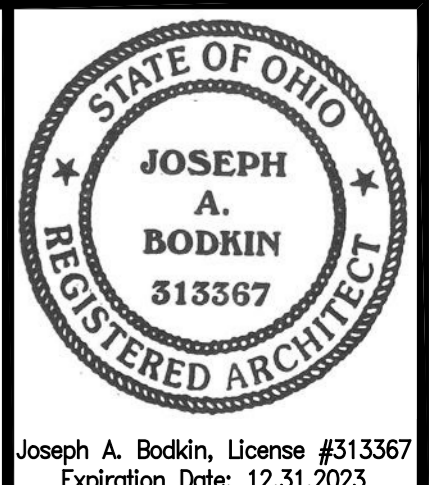

A312 (2)

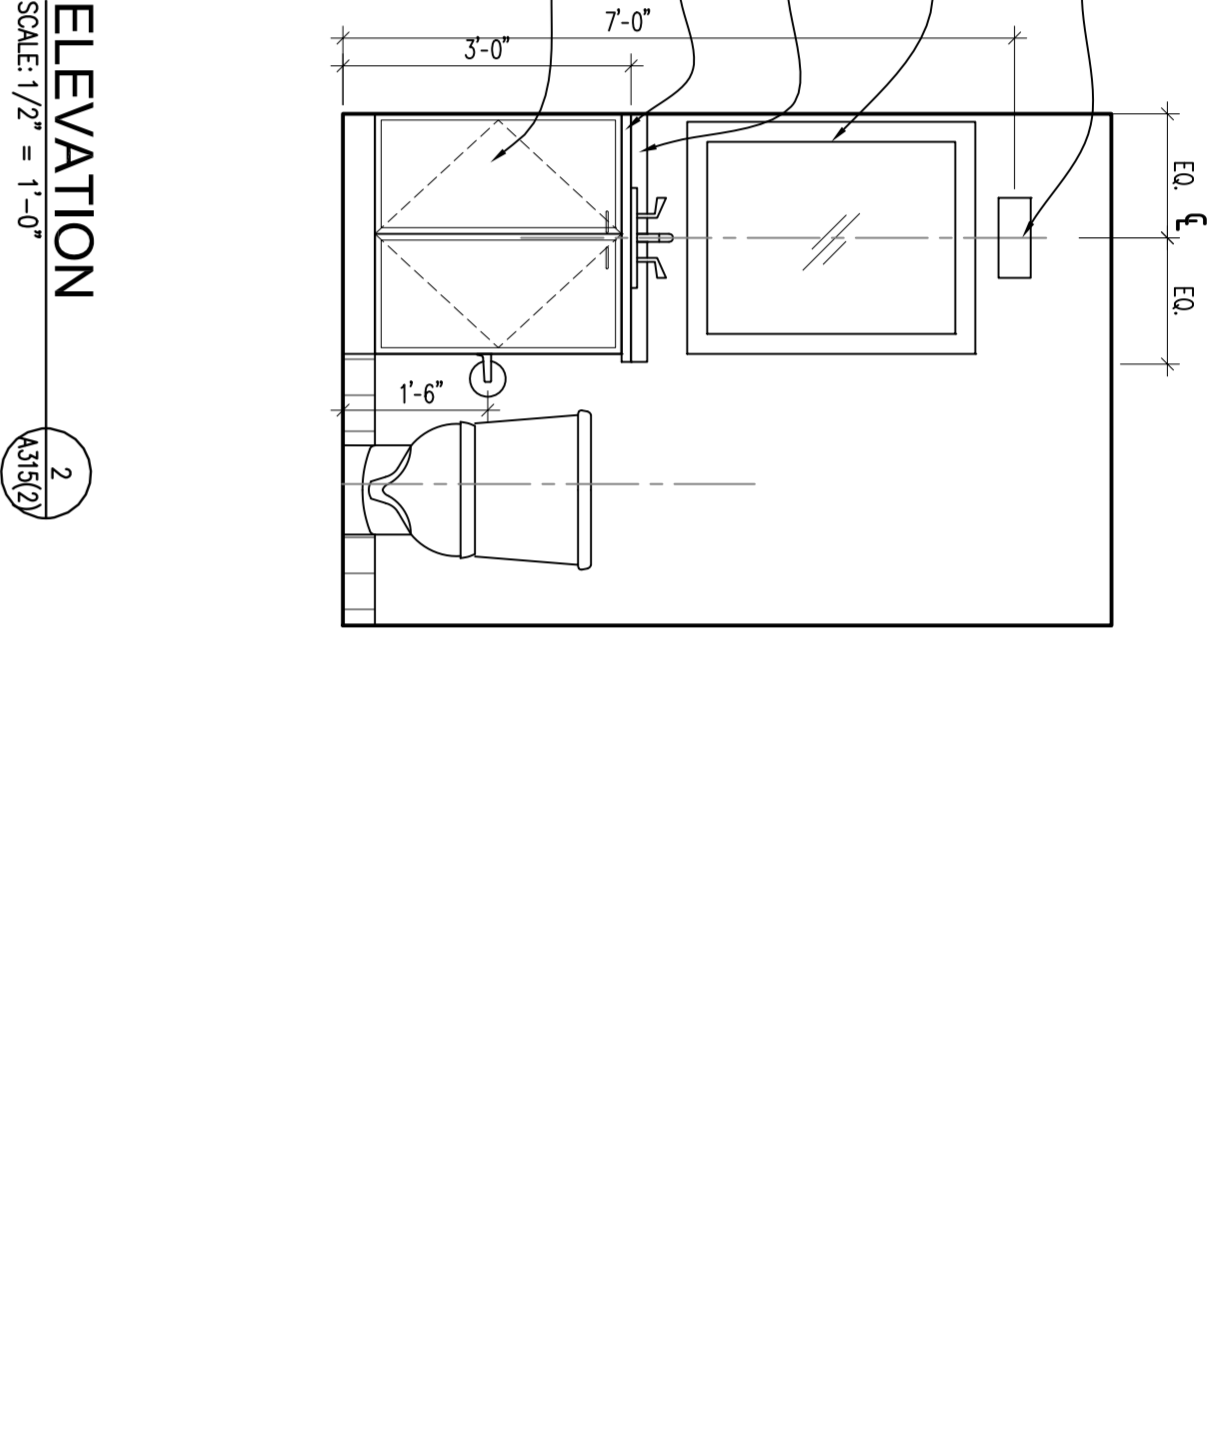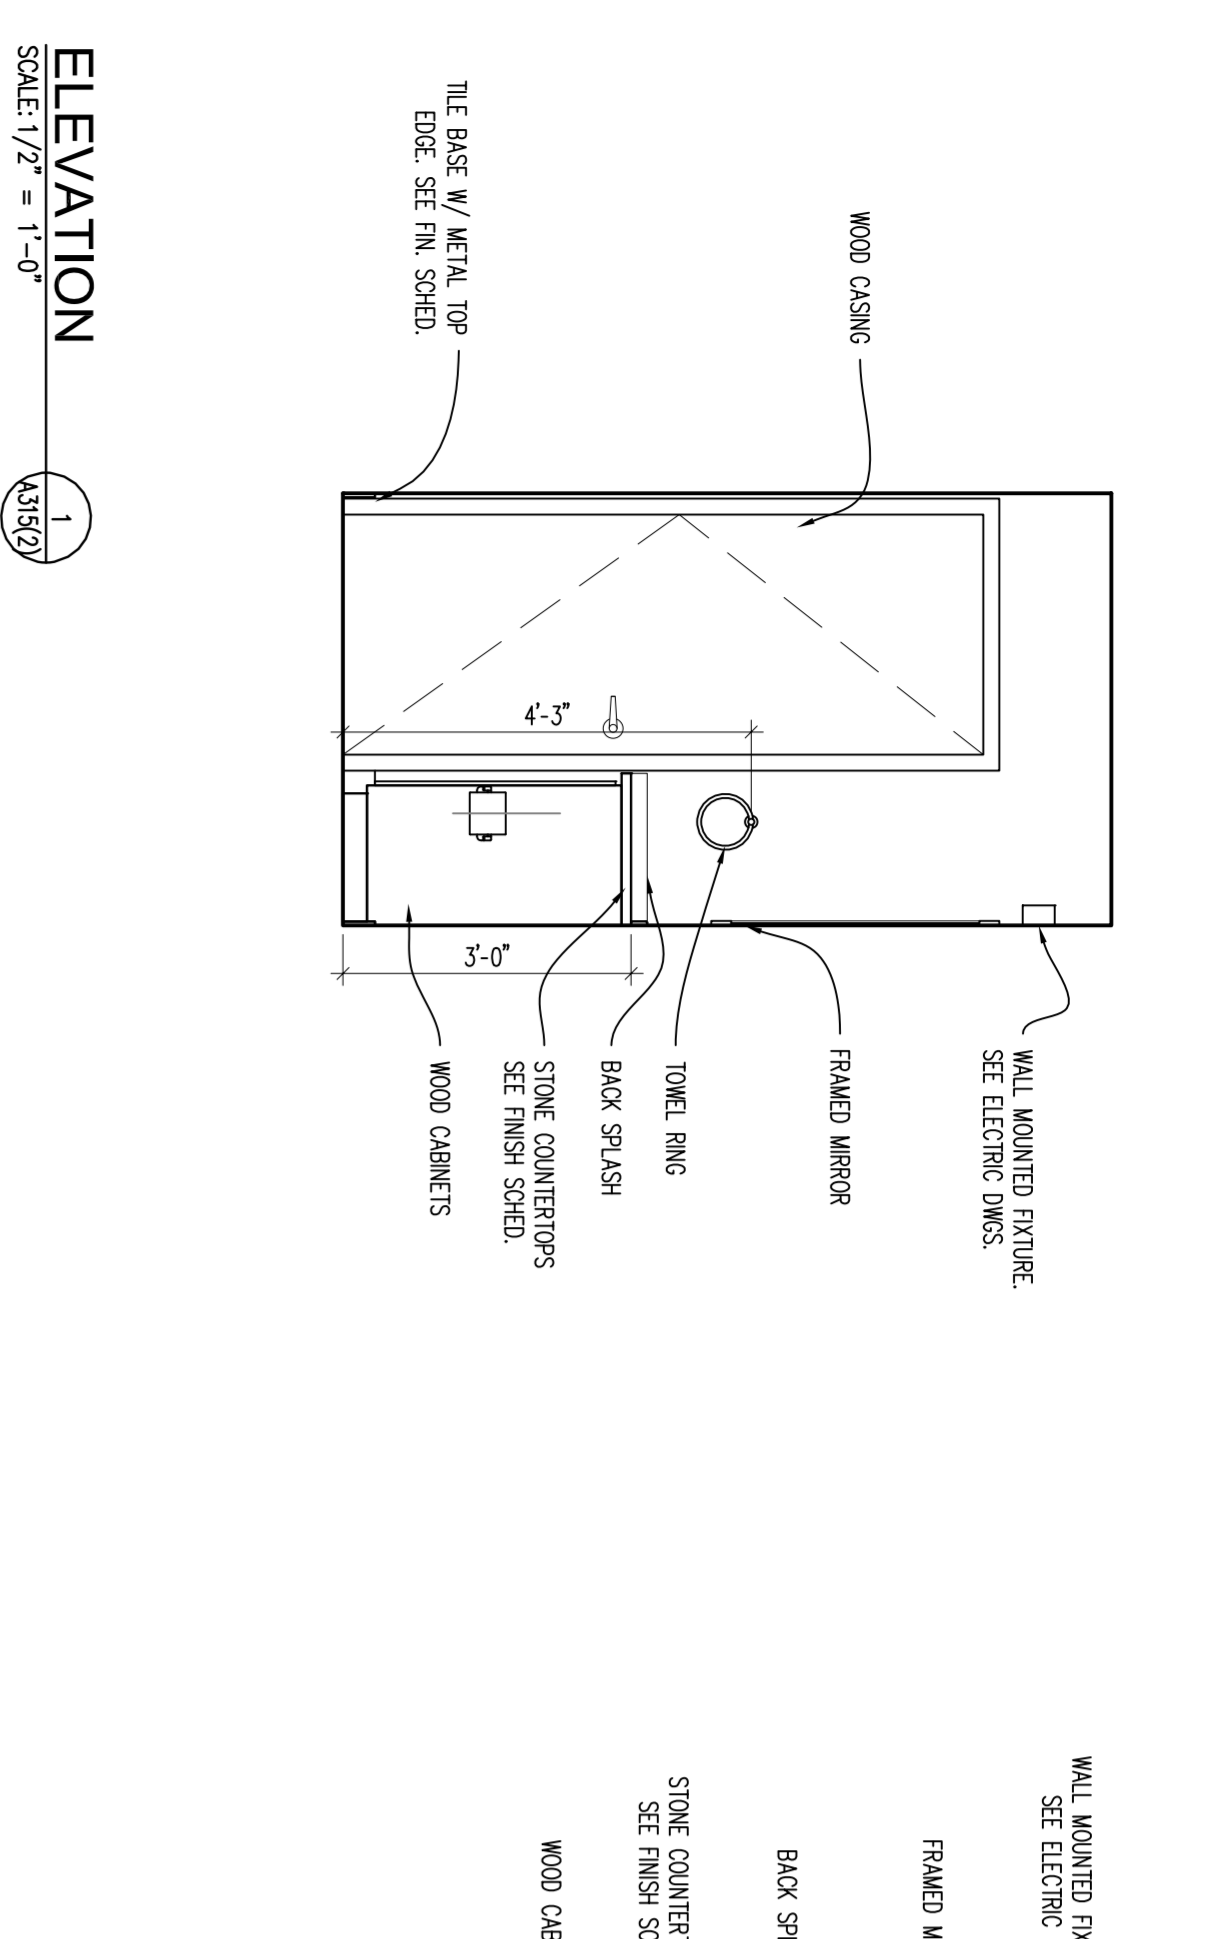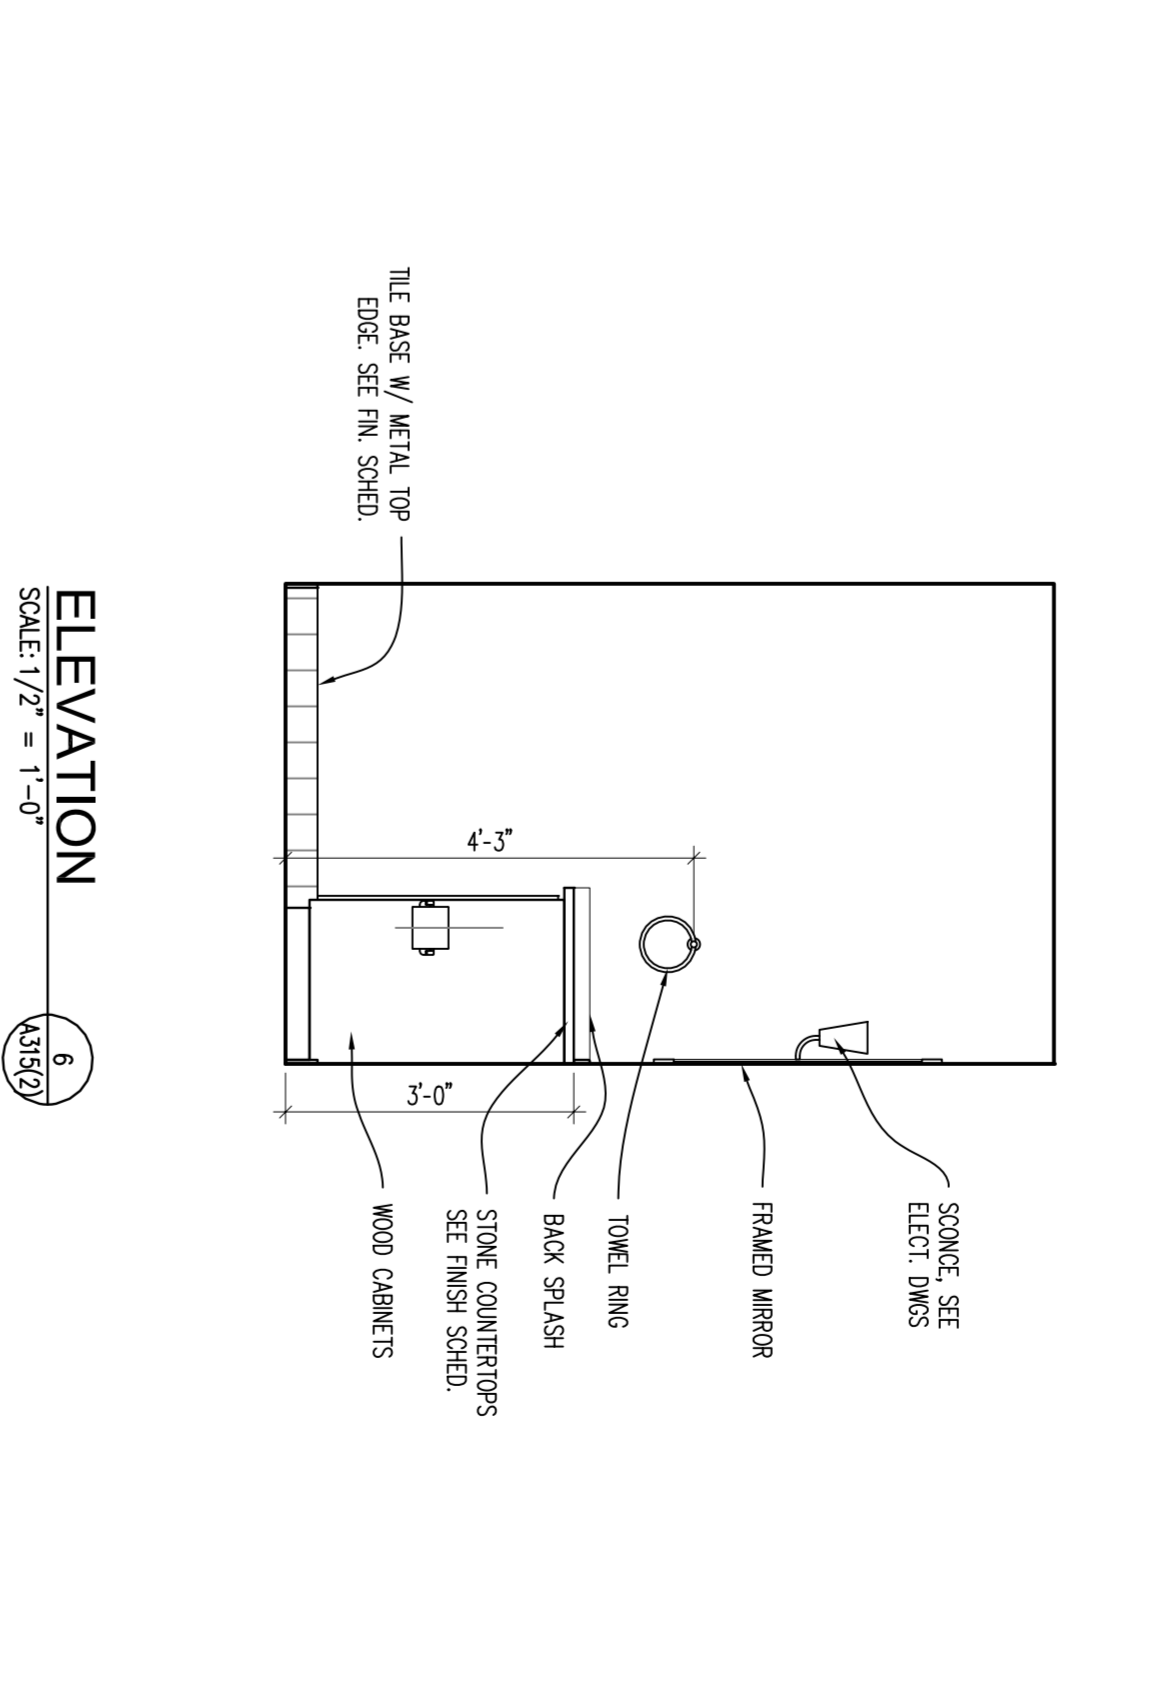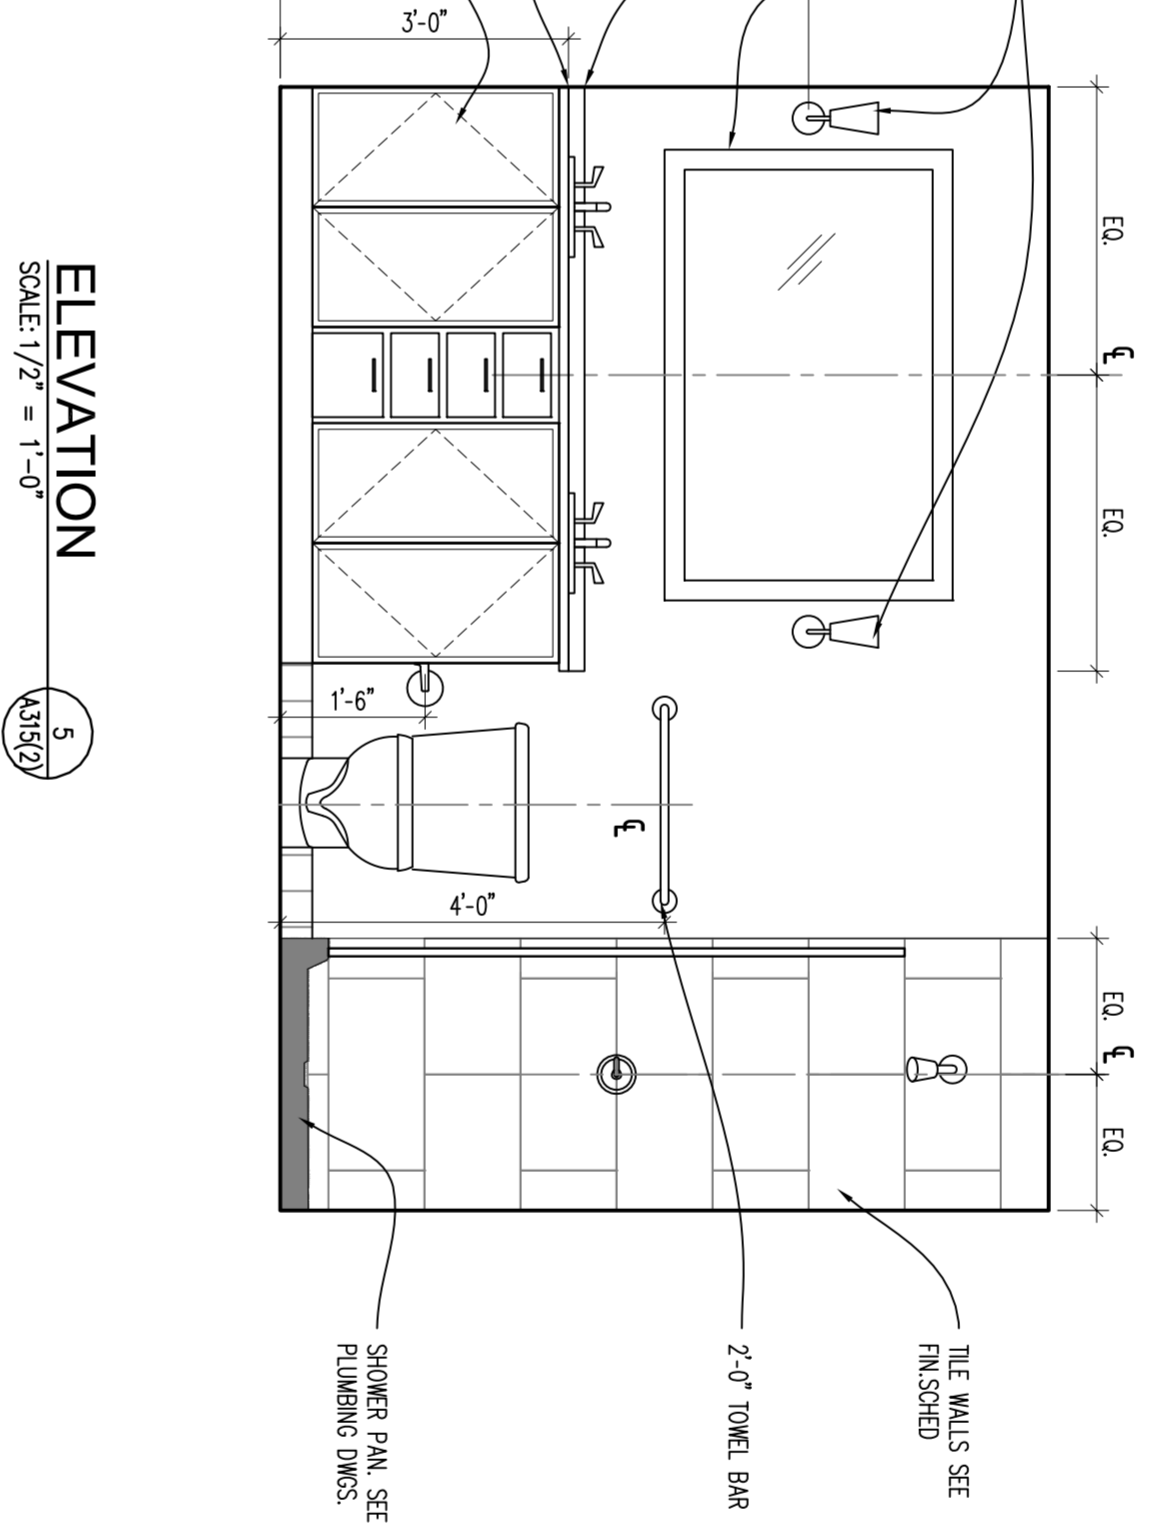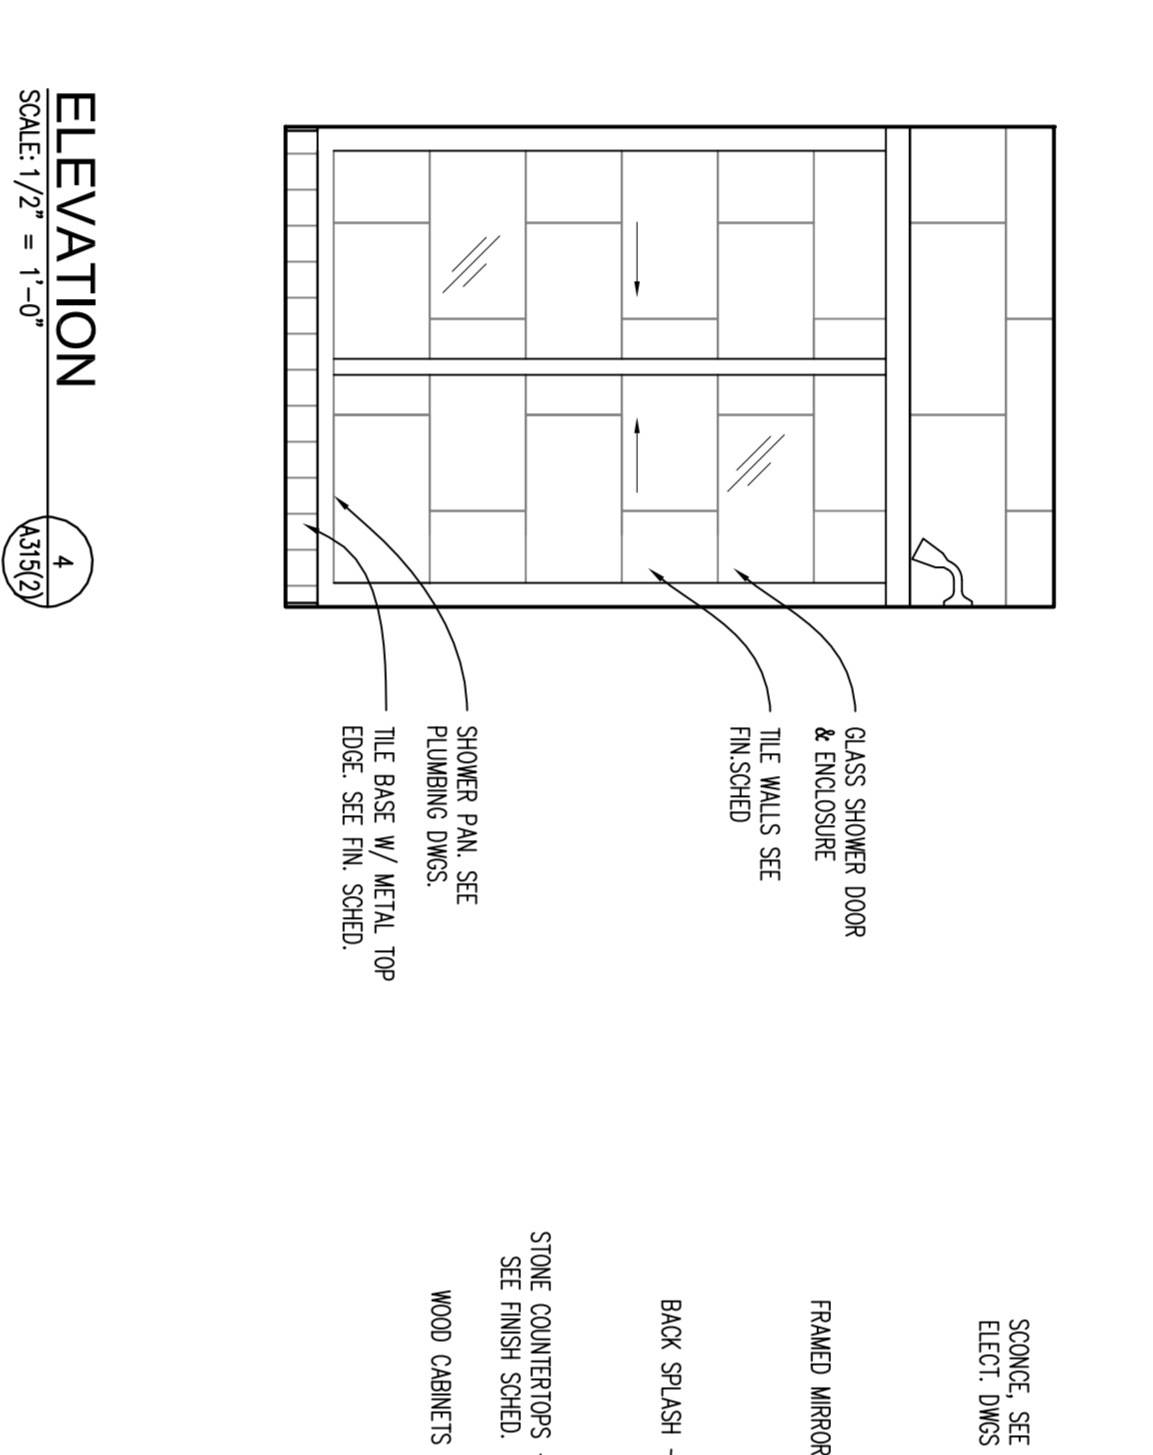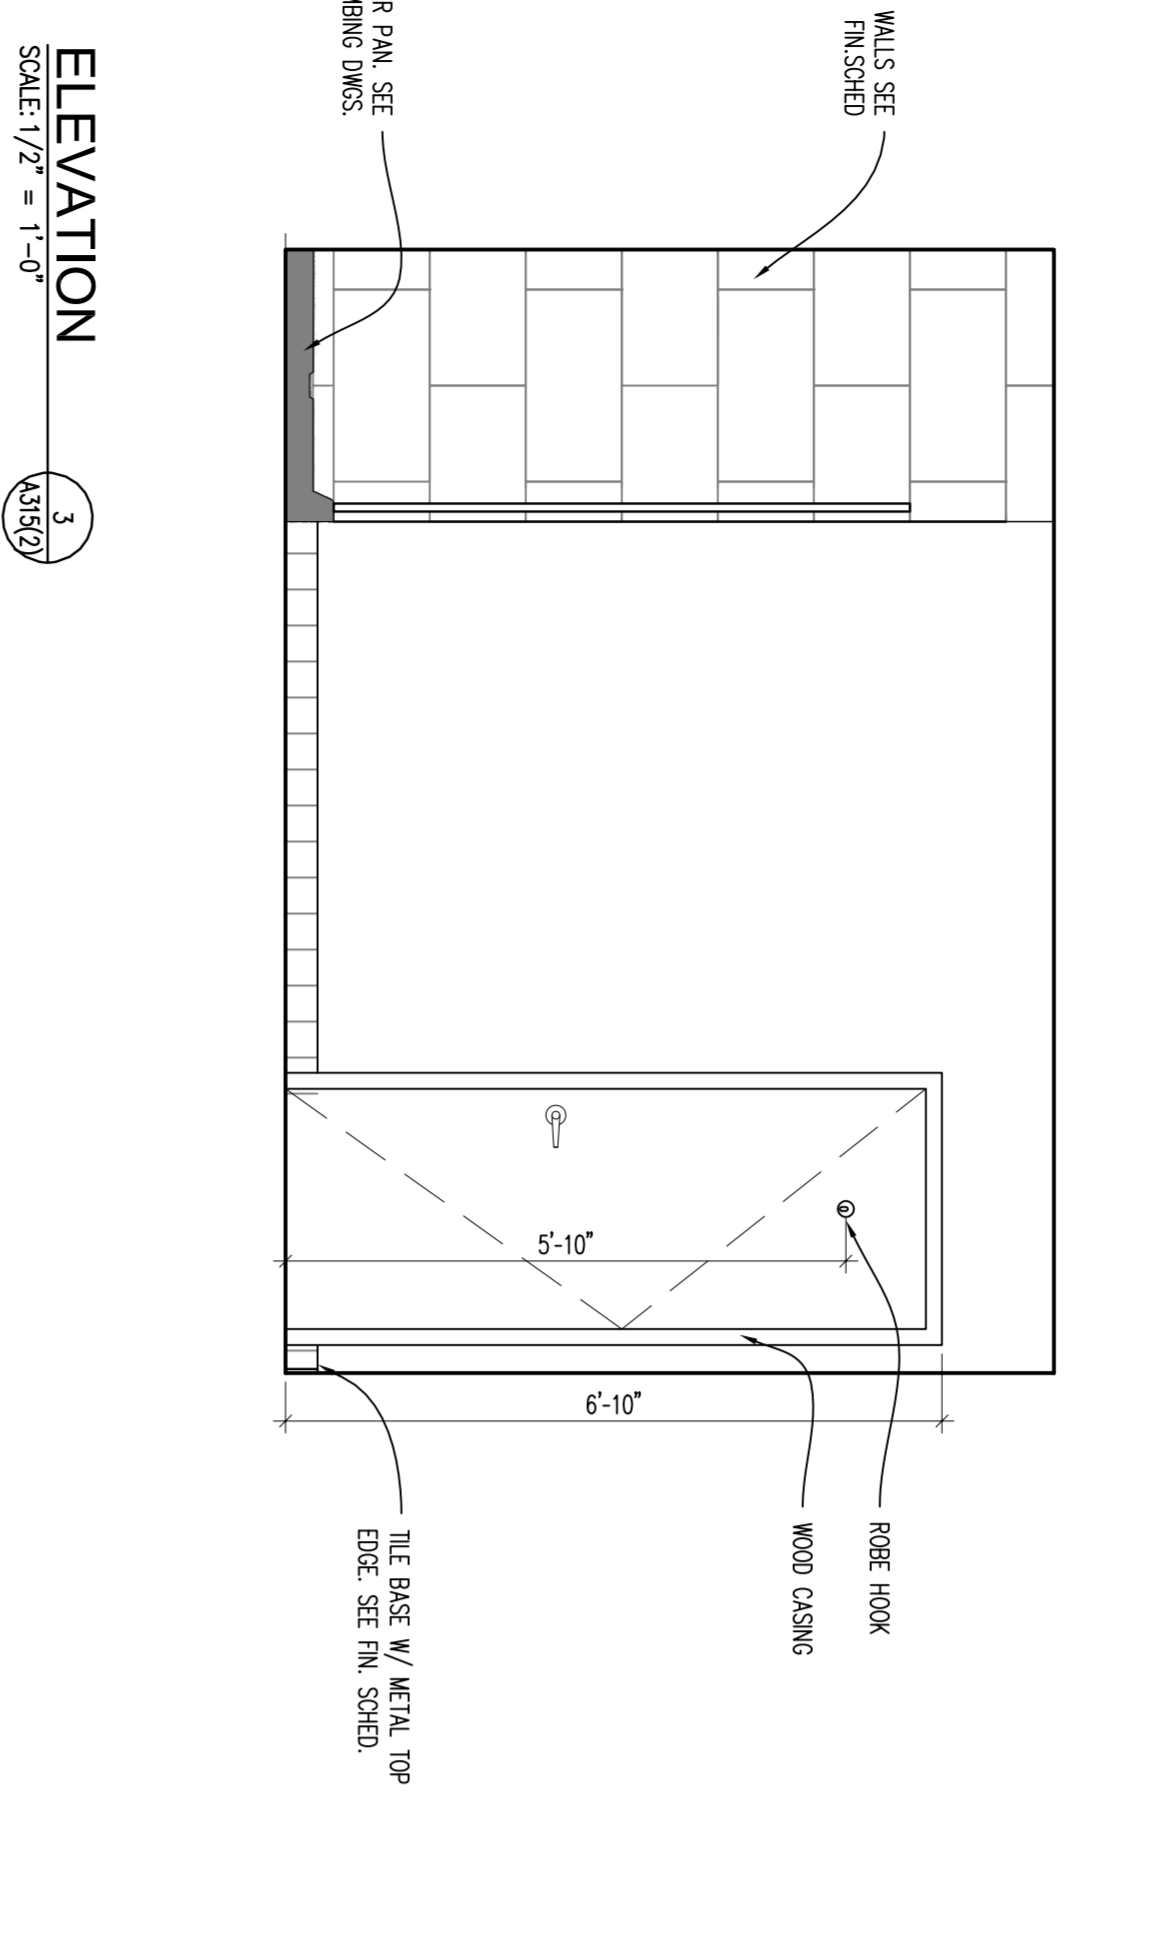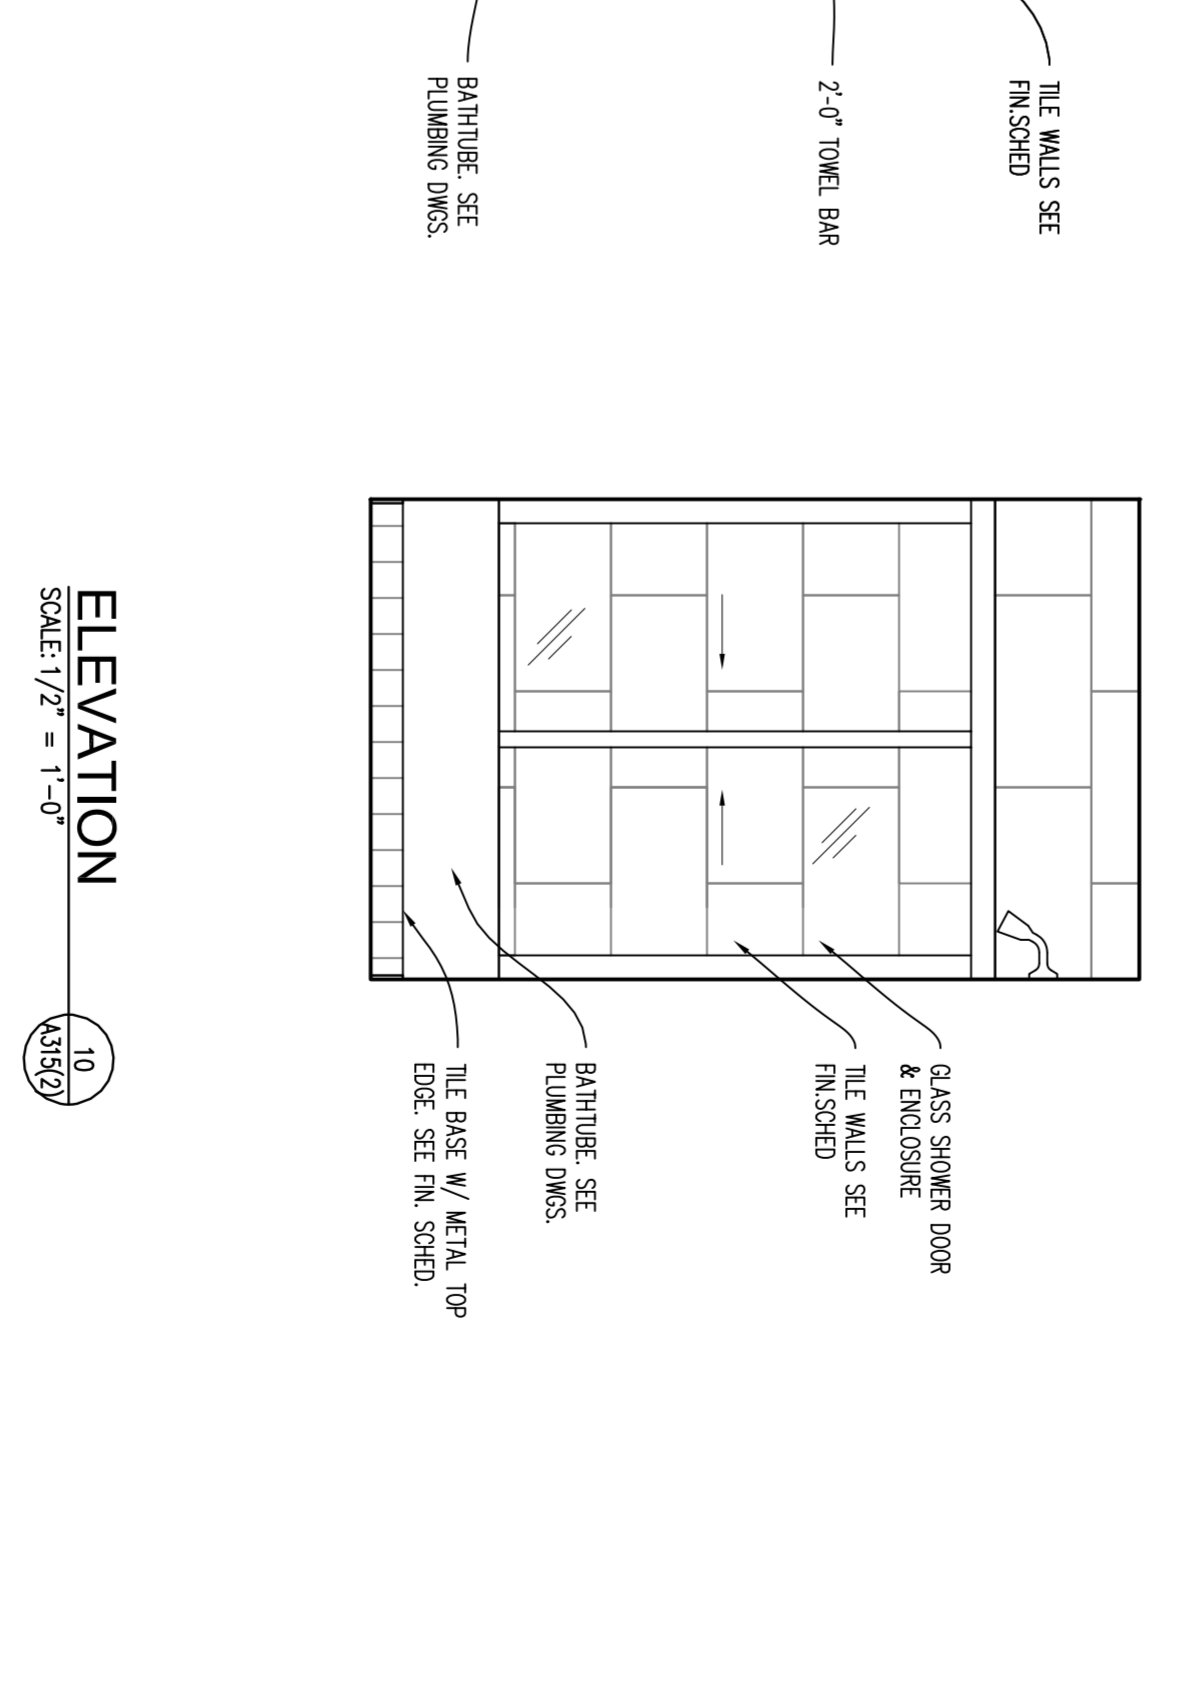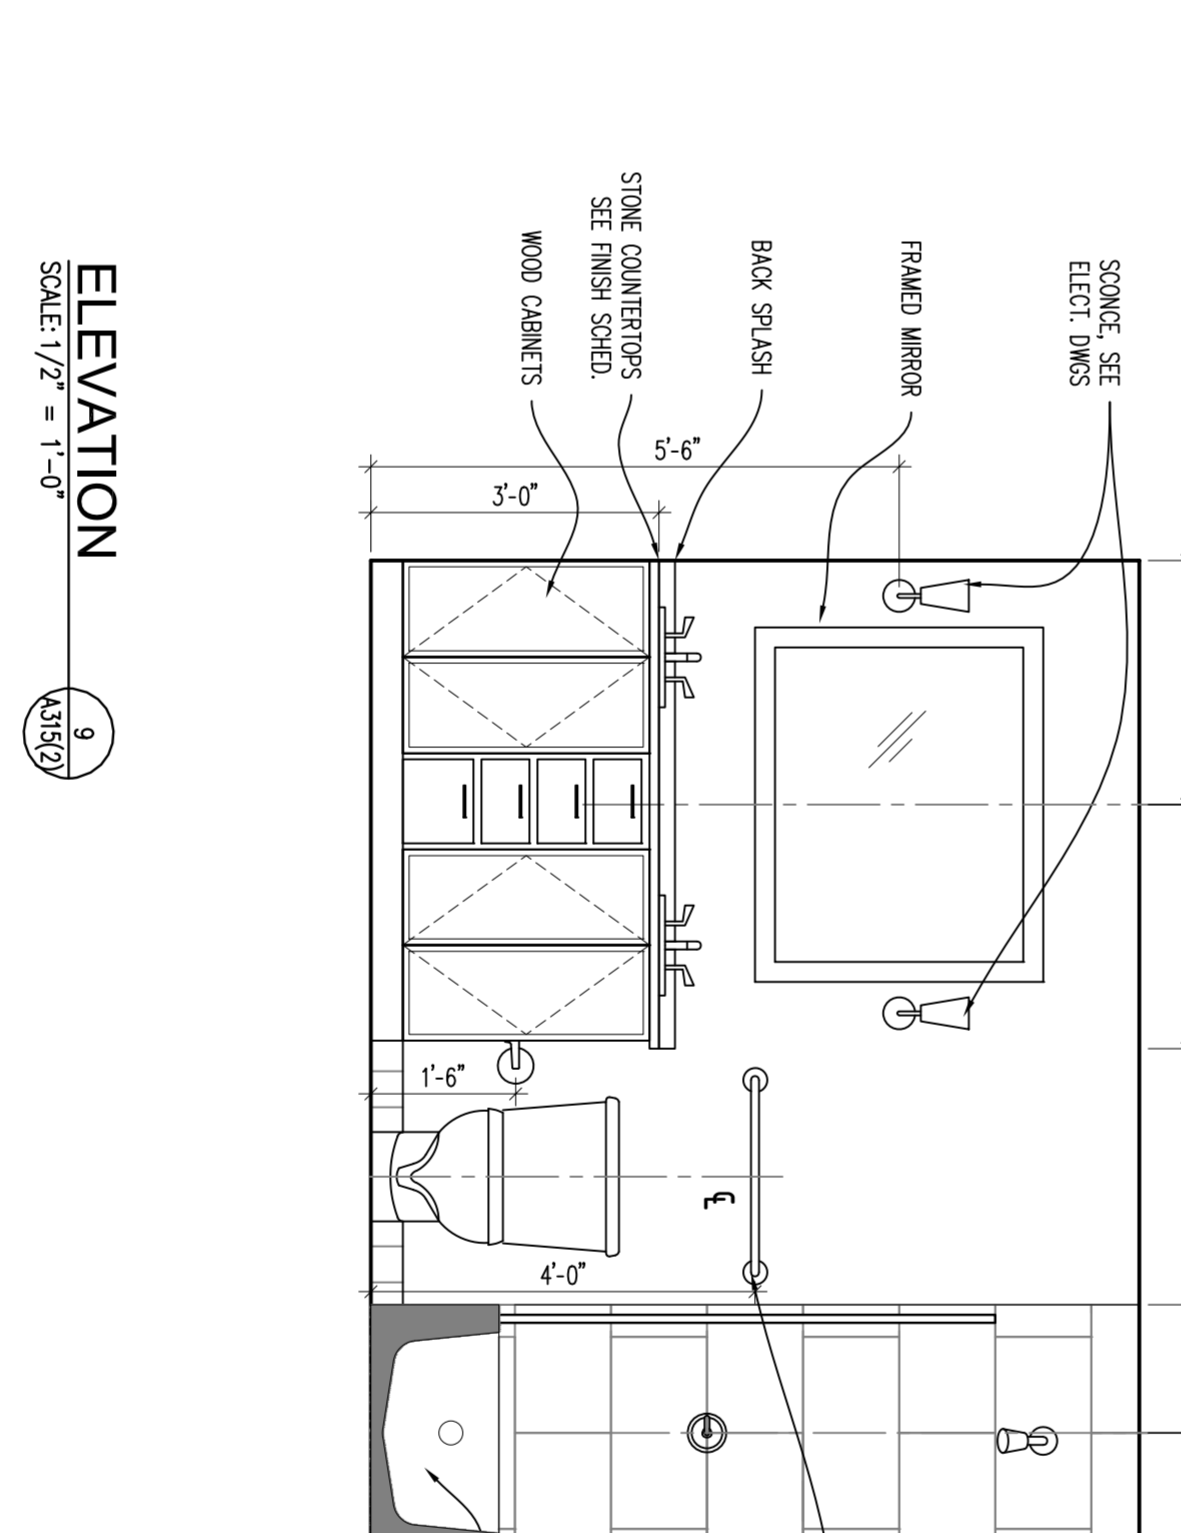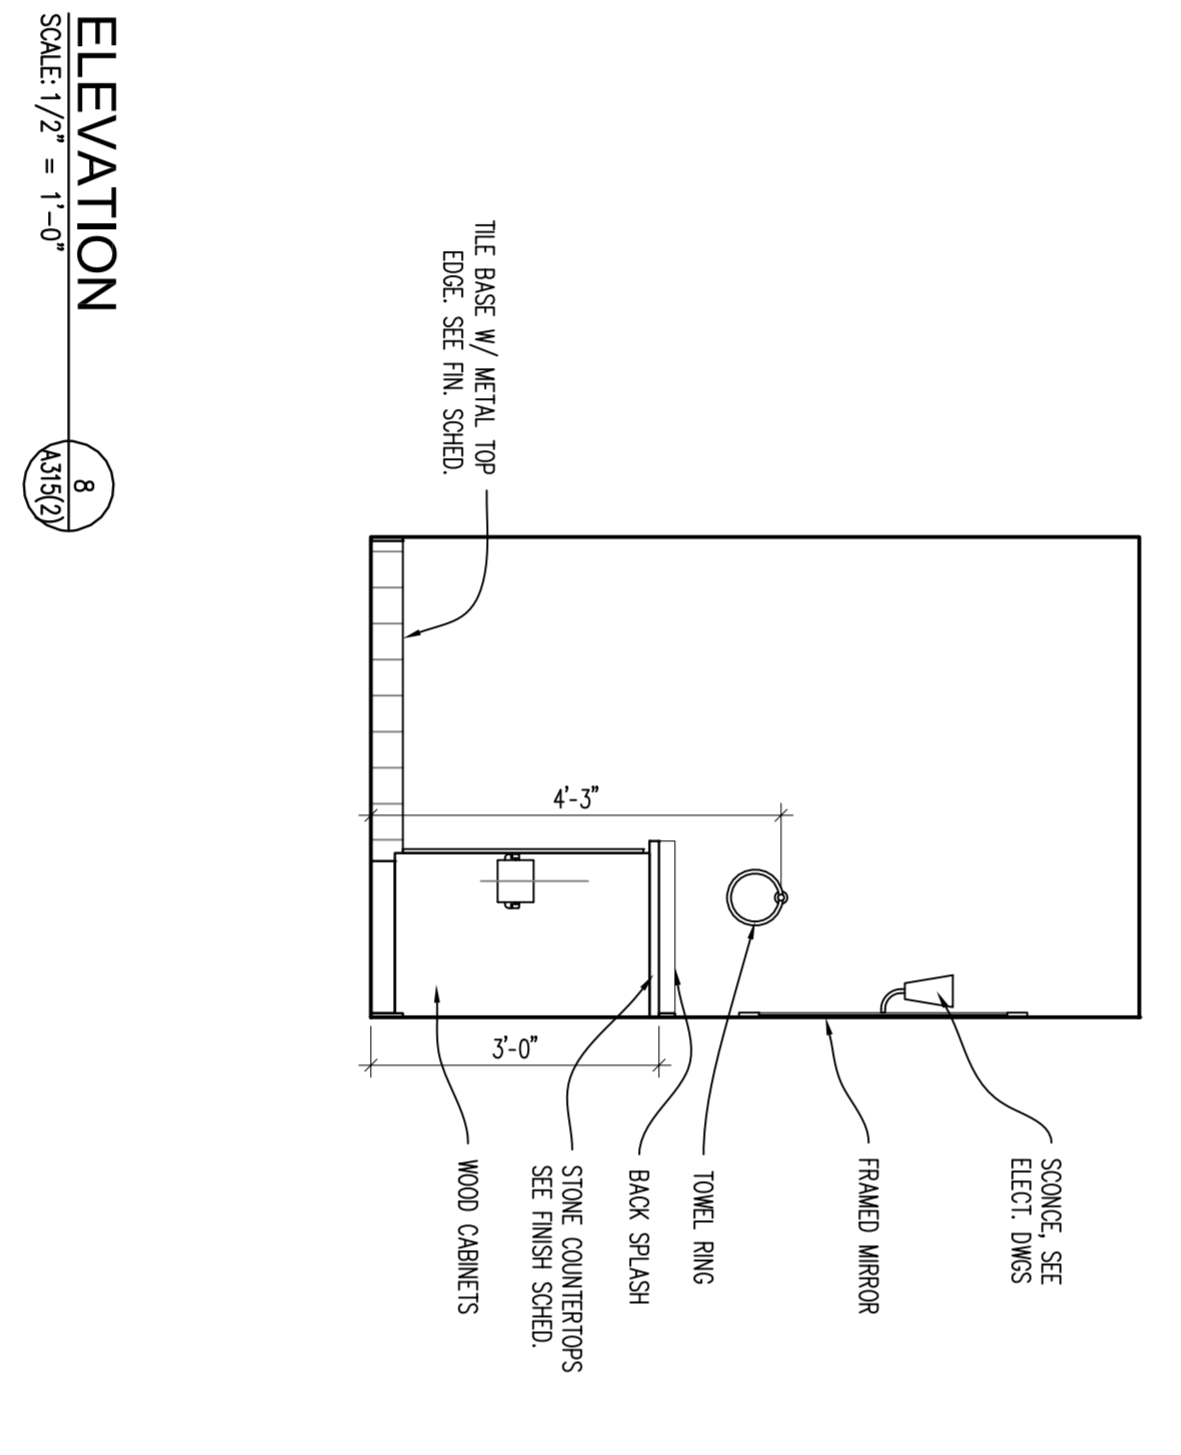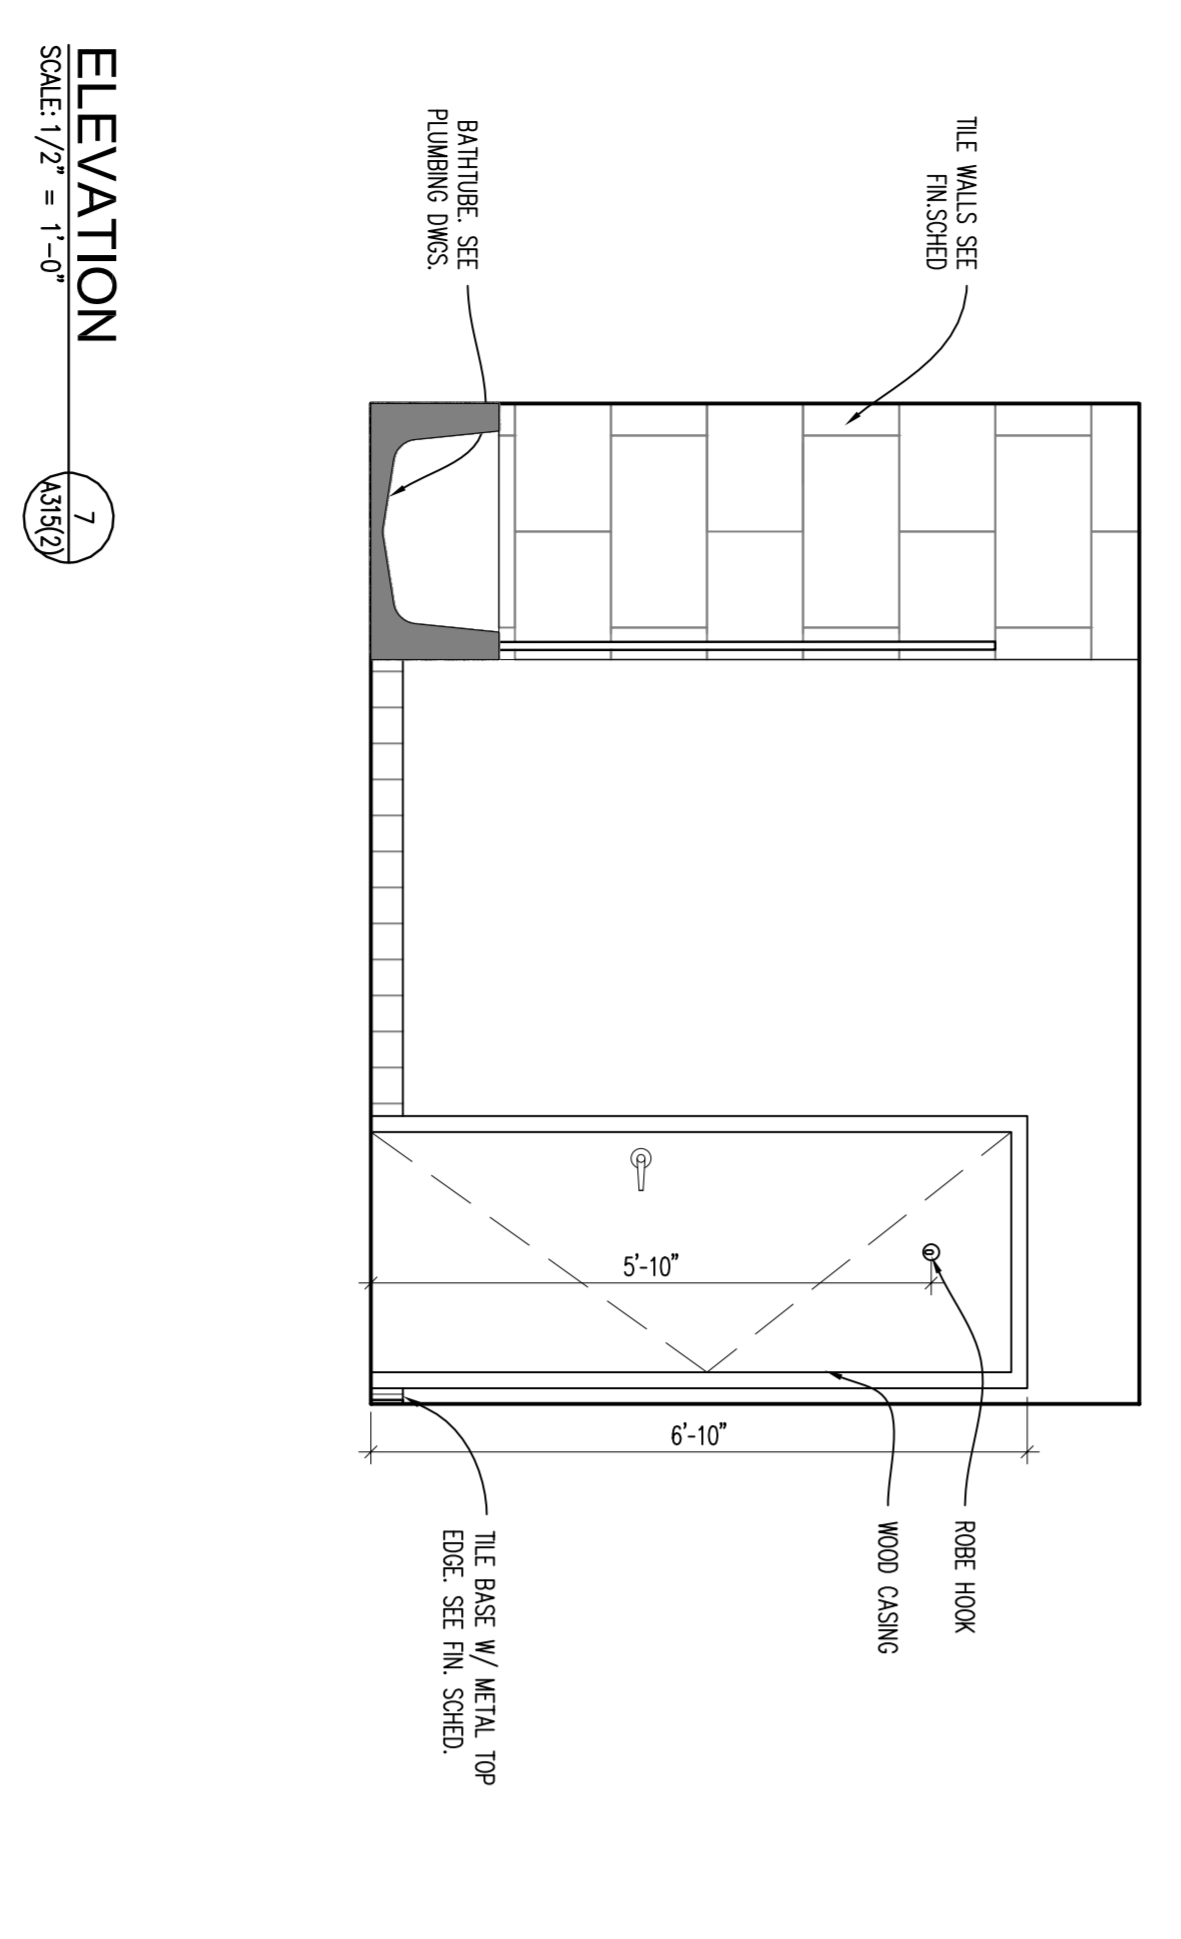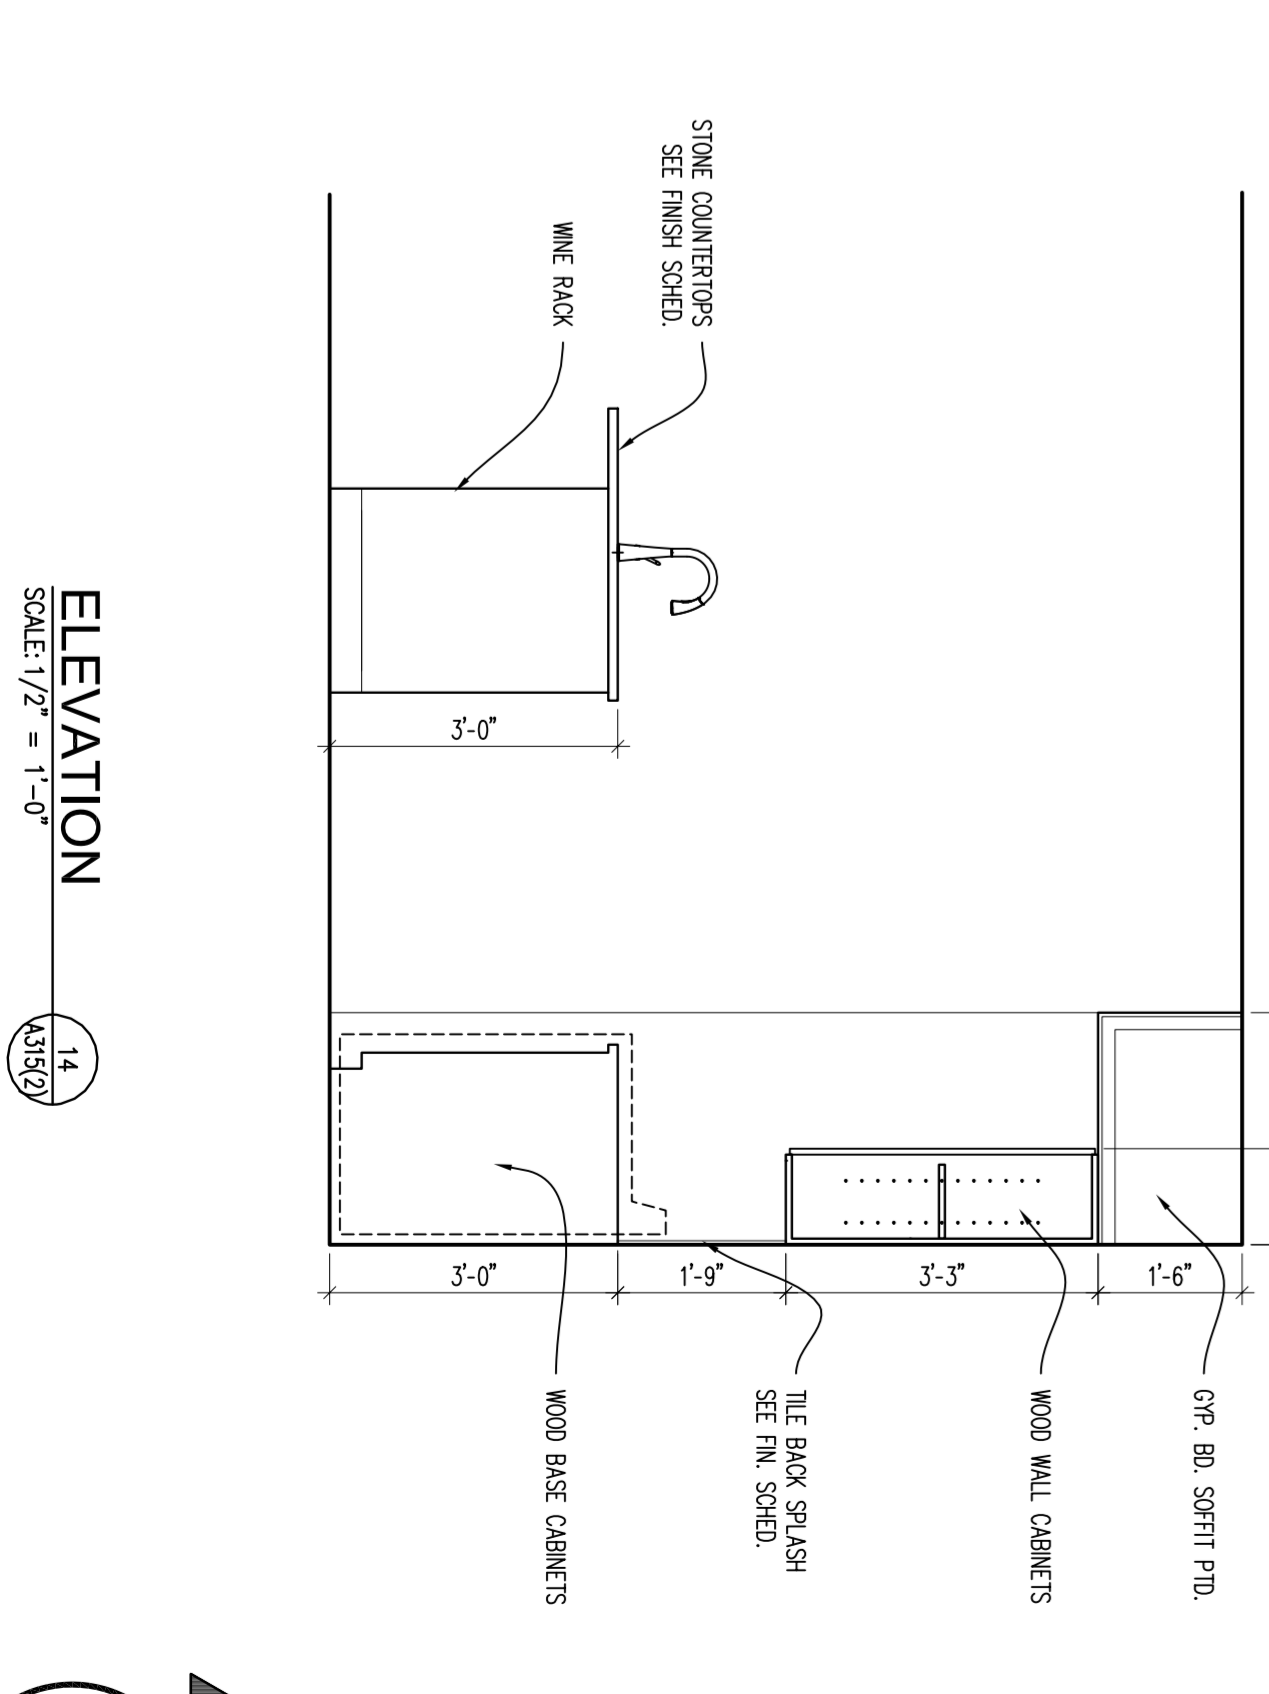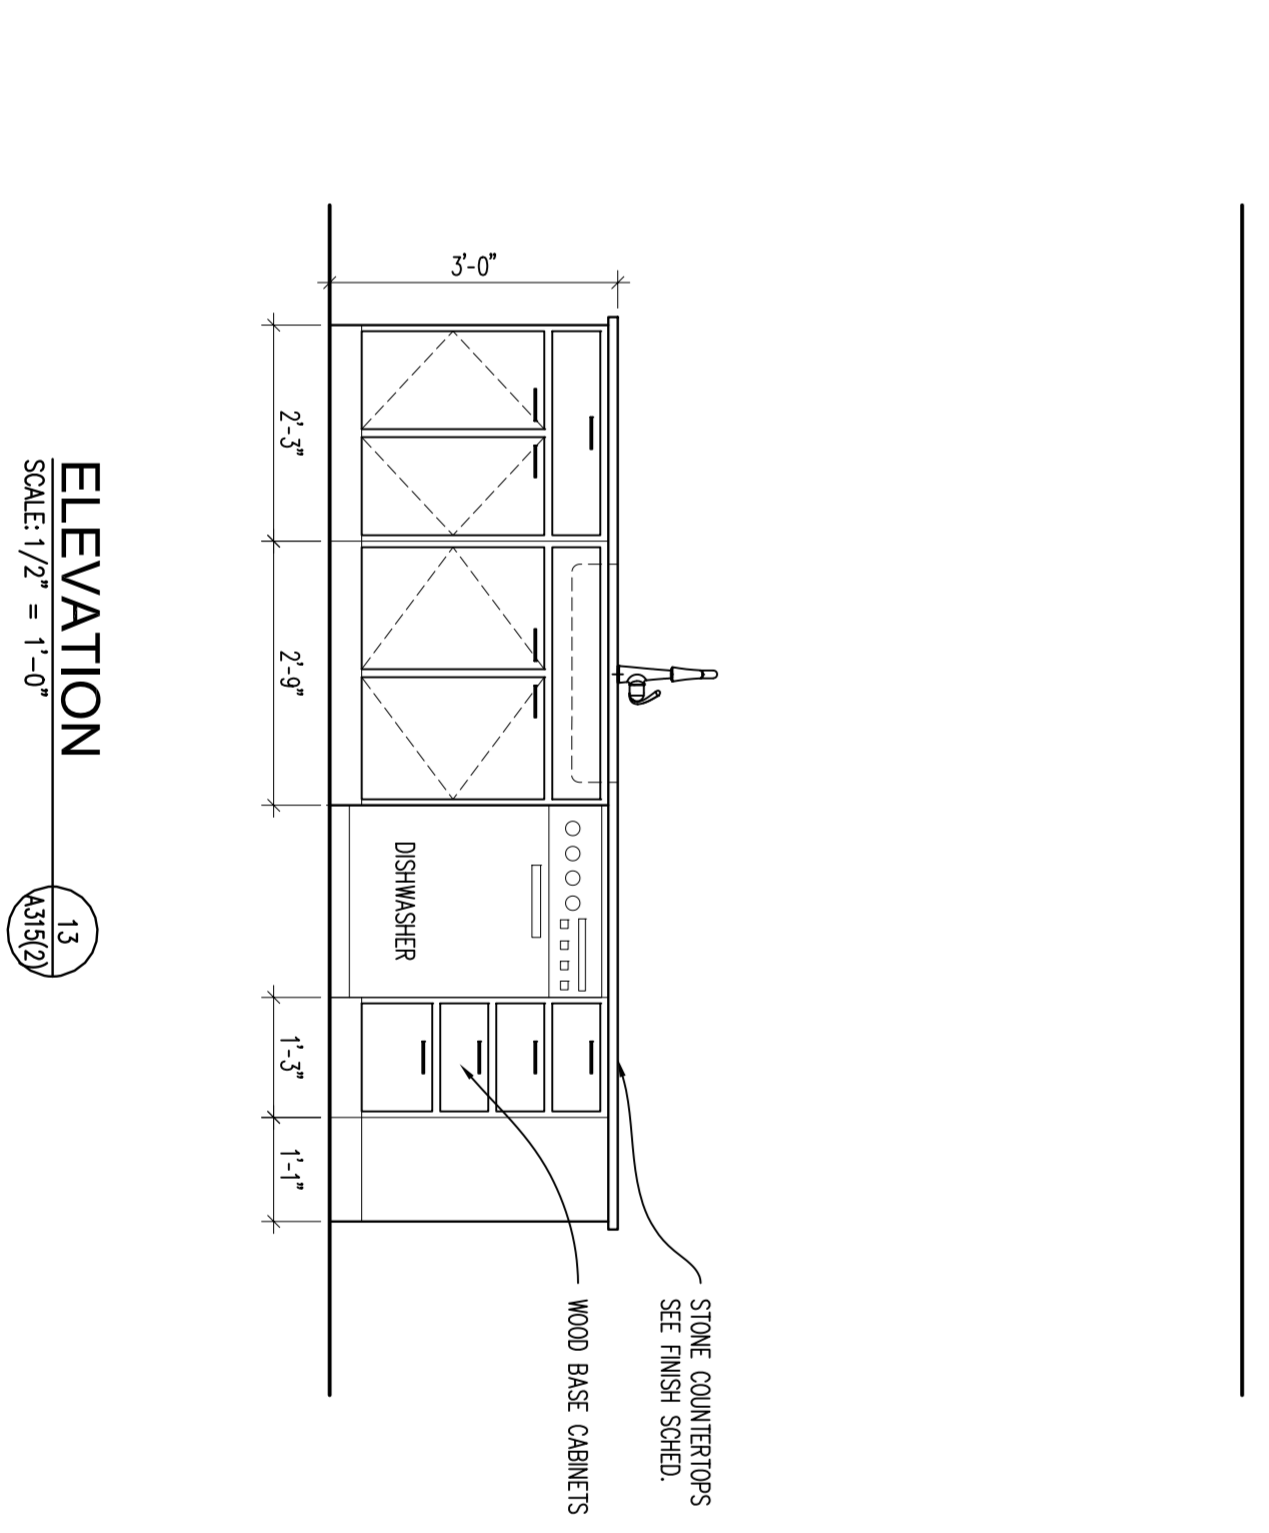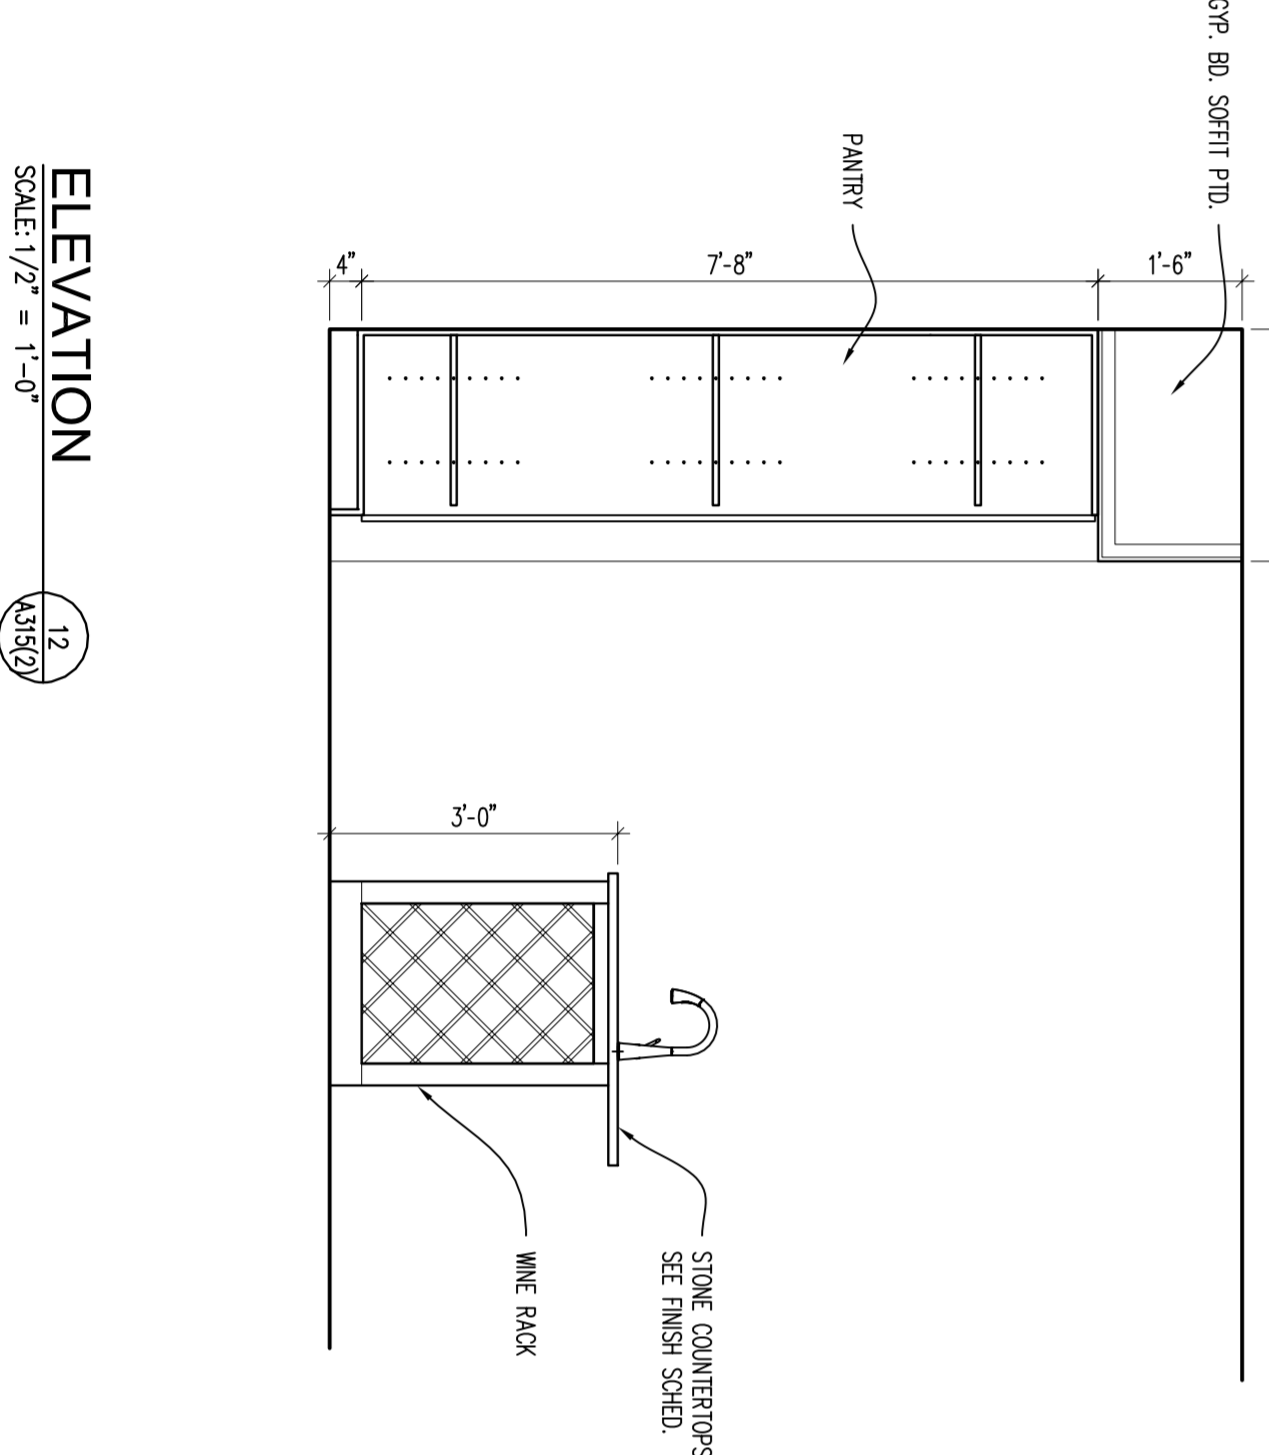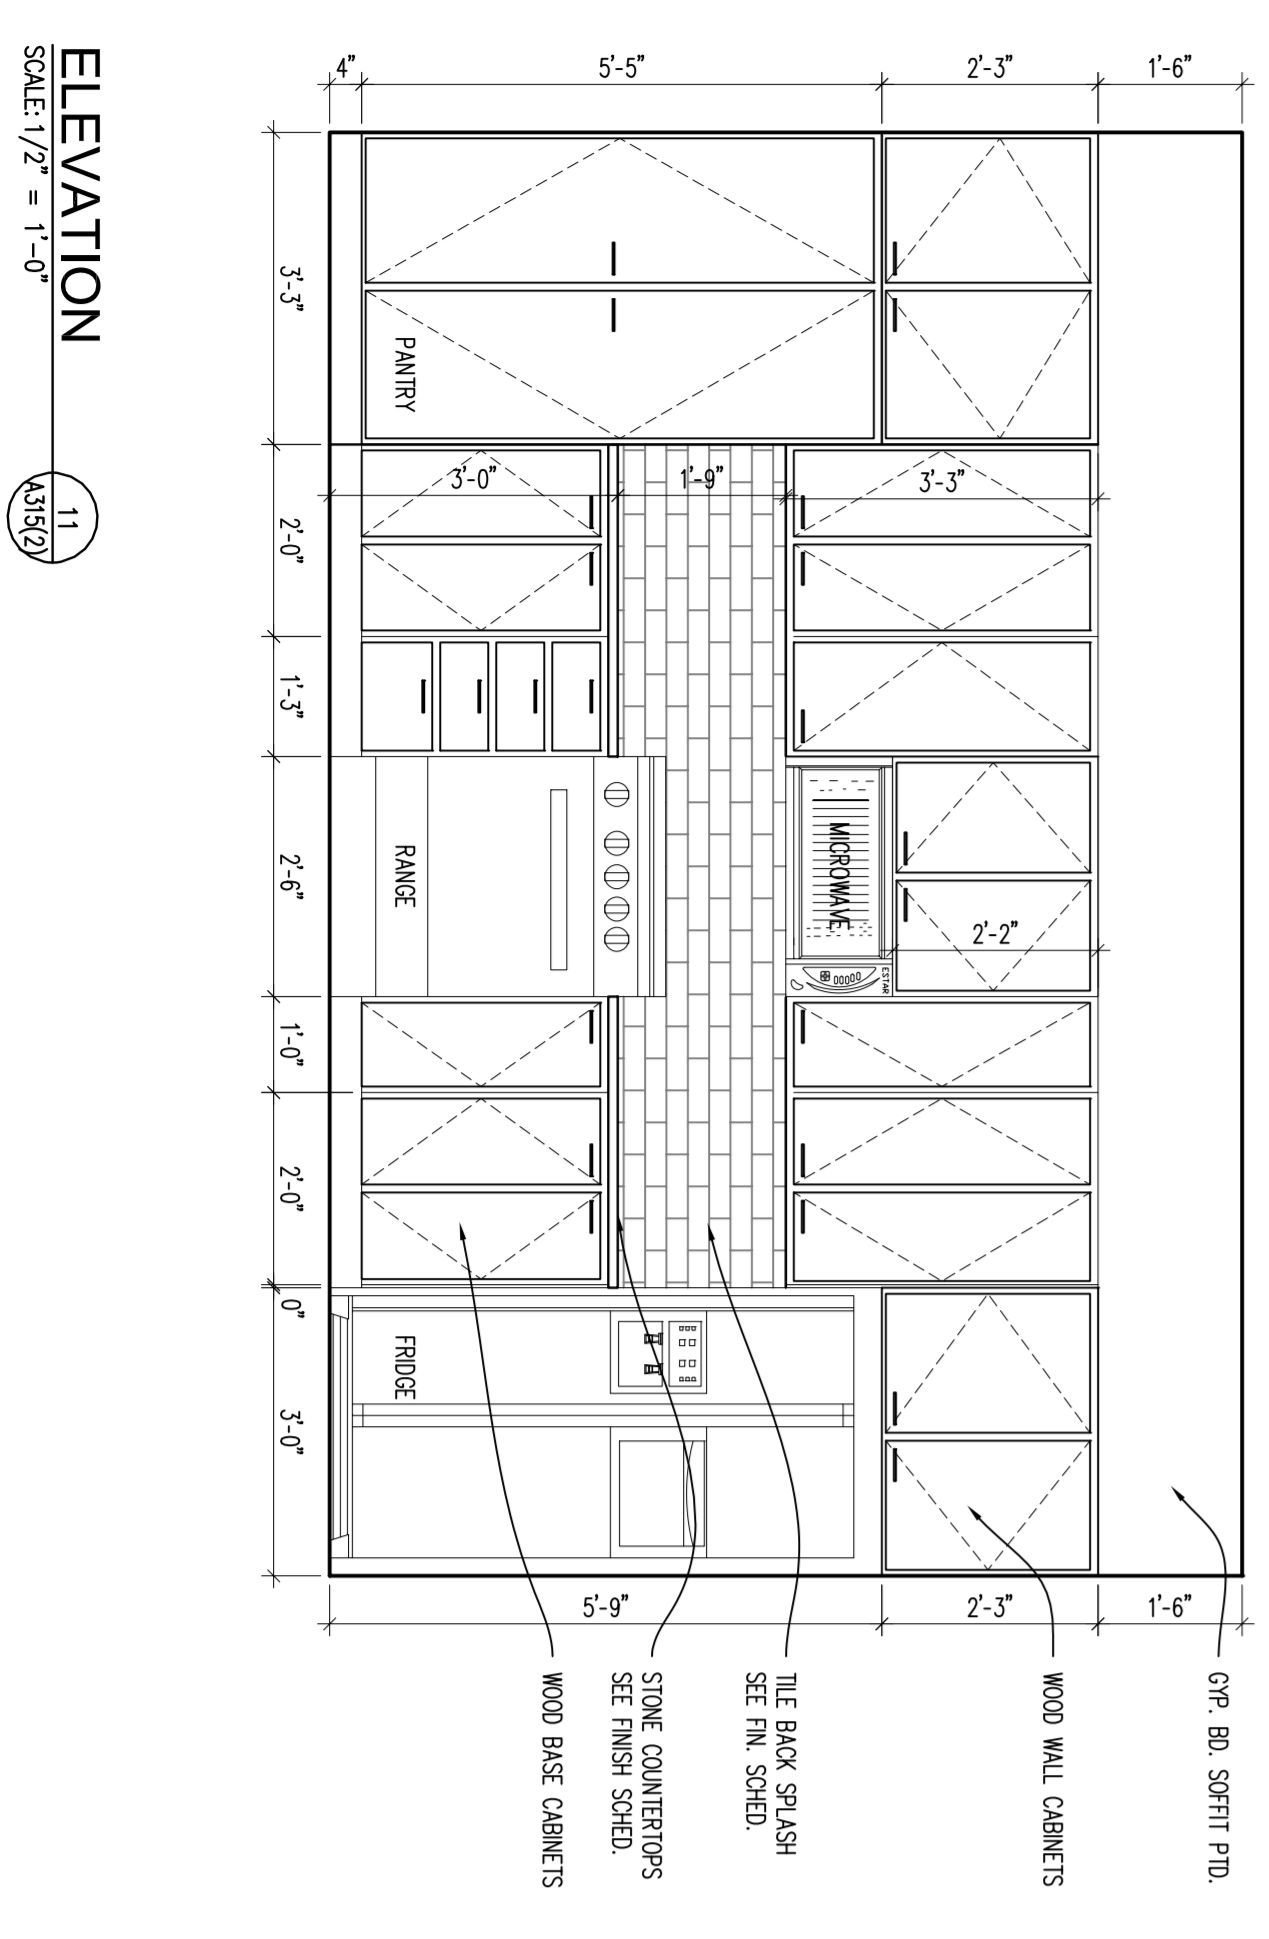


- GENERAL APARTMENT NOTES**
- DOOR FRAME SHALL BE 4" FROM FACE OF WALL TO
 - ALL NEW UNIT PARTITIONS ARE TYPE 3 UNDO.
 - DIMENSIONS ARE FROM FINISH FACE OF WALL TO FINISH CENTER OF DOOR.
 - ALL LIGHTING FOR REFERENCE ONLY.
 - ALL LIGHTING FOR REFERENCE ONLY.
 - REVIEW BASIS OF DESIGN AND SMART CABINETS. THIS INCLUDES CABINETS THAT ARE UP AGAINST THE BATHROOMS AND APPLIANCES IN THE APARTMENT UNITS WILL BE NEW ENERGY STAR APPLIANCES.
 - ALL PAINT AND LINEN CLOSET TO RECEIVE FINE (B) FINISH.
 - ALL CLOSETS TO RECEIVE ONE (1) KEYPAD SHELF AND EACH SHOWER TO BE PROVIDED W/ GLASS SHOWER DOOR.
 - BATHS: (1) TOILET PAPER HOLDER (1) ROBE HOOK.



A315 (2)

Project: Formica Building	No. Revisions	Date
115 E 5th Street	ENG CHG #1	11.14.2022
Cincinnati, Ohio 45202		
Sheet: 0		
Light Construction		
Project No: 2022_259	Issue Date	
Scale: As Noted	Drawn	Checked


Formica Building
Office/Apartments
Auditor Address: 115 E. 5th Street, Actual Address: 120 E. 4th Street
Cincinnati OH 45202

modelgroup
DEVELOPMENT • CONSTRUCTION • MANAGEMENT
1826 Race Street
Cincinnati, Ohio 45202
513.559.0048

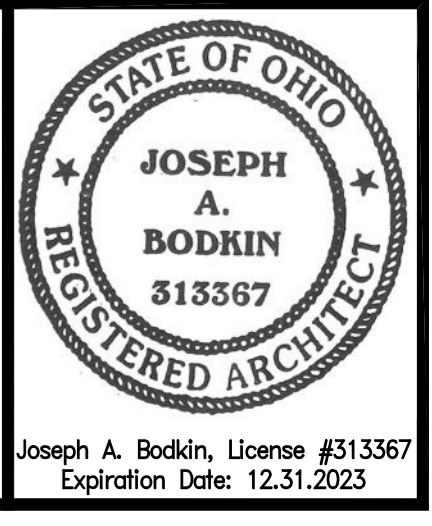

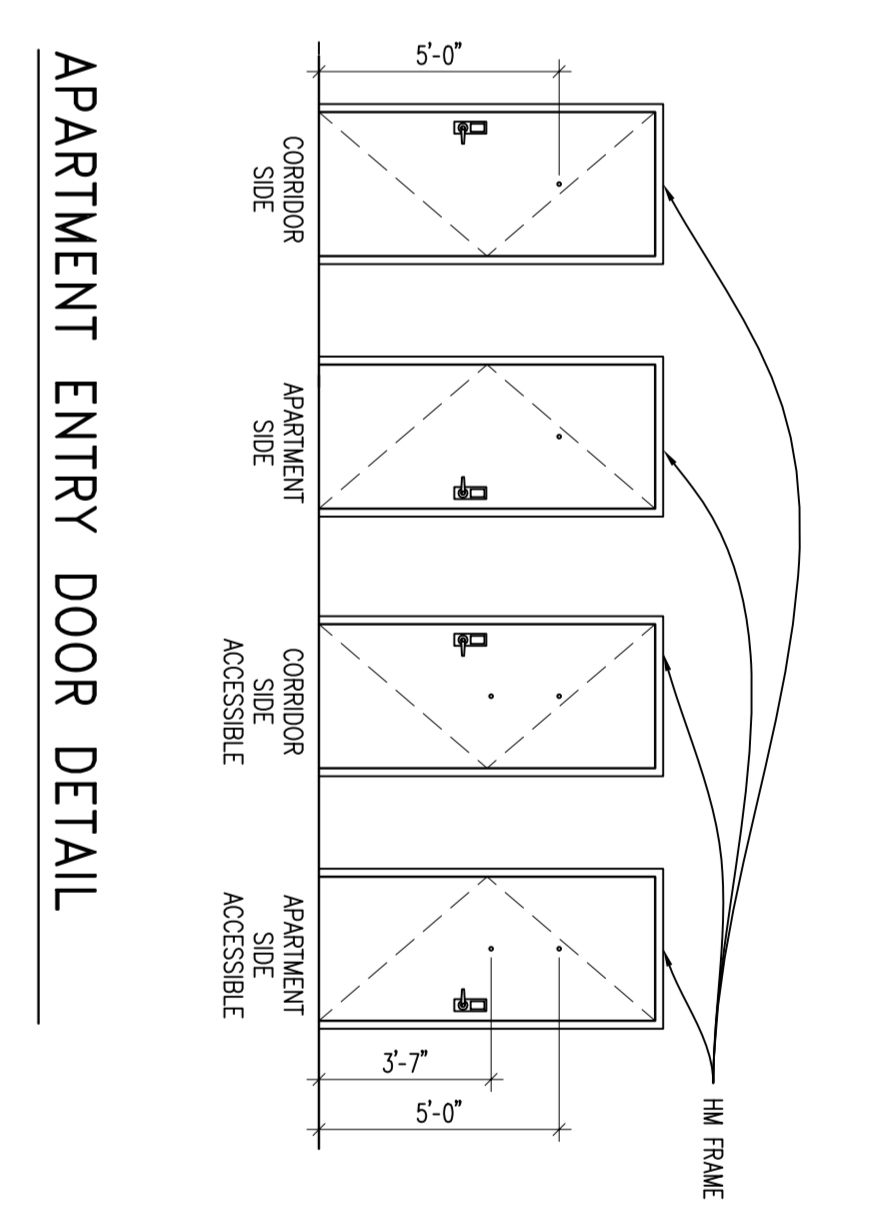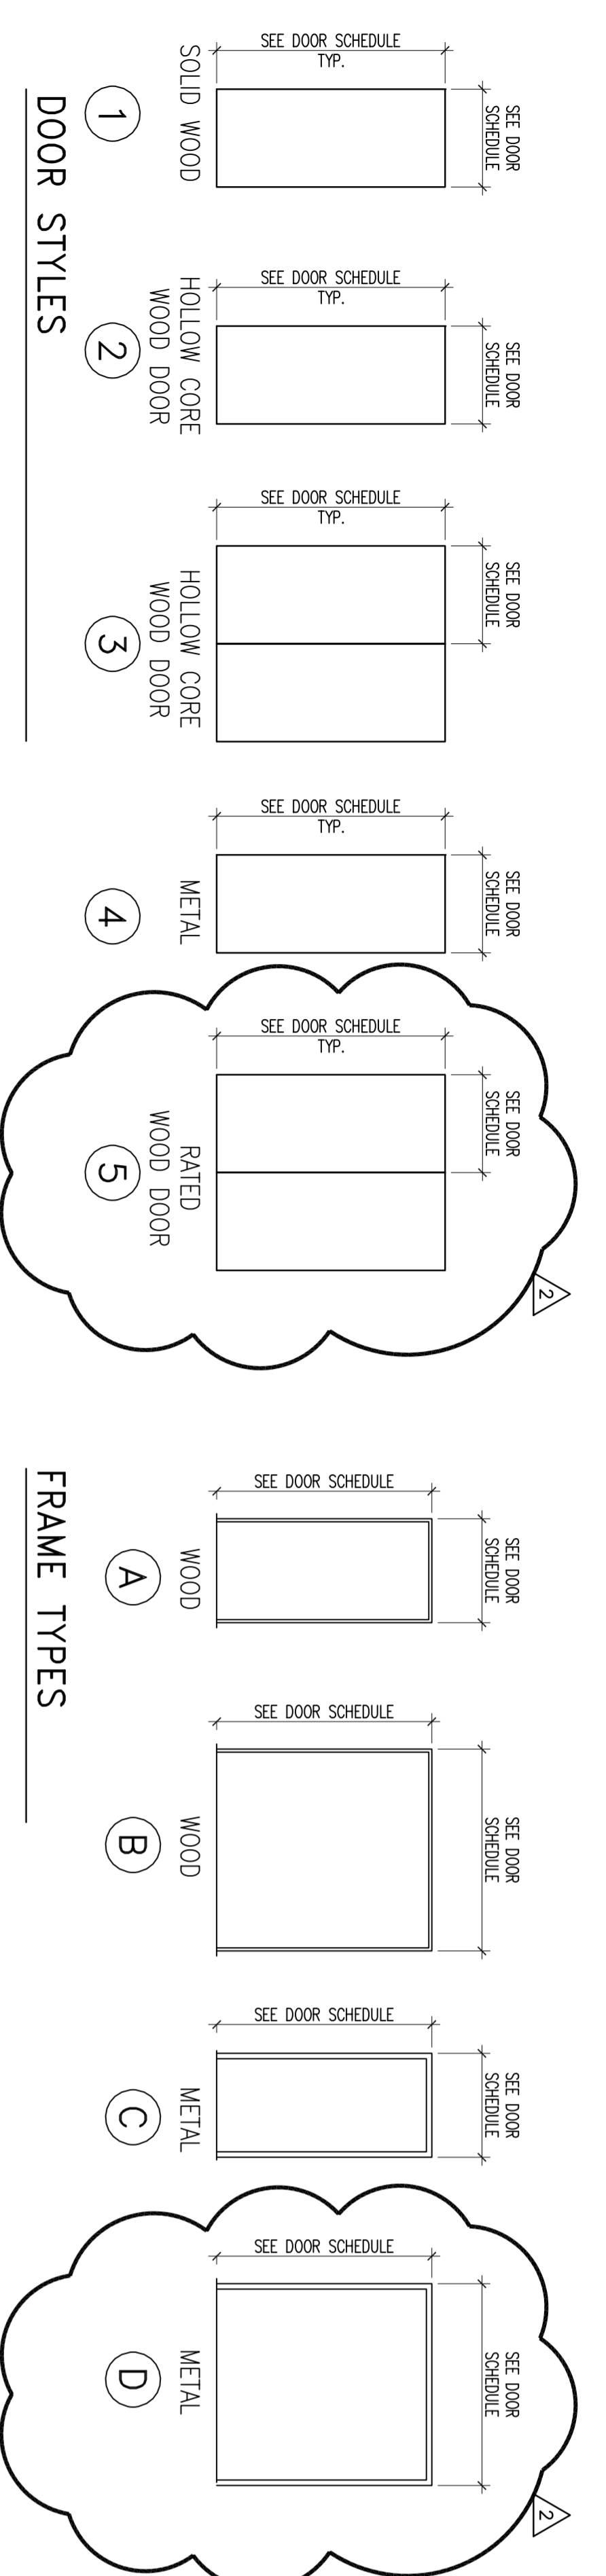

DOOR MARK	DOOR INFORMATION			FRAME INFORMATION			DETAIL	HW. SET	FIRE RATING	REMARKS
	WIDTH	HEIGHT	THICK	DOOR MATERIAL	TYPE	FRAME MATERIAL				
EX	3'-0"	7'-0"	1-3/4"	WD	EX	1/2" ALUM	1/2" ALUM	EX	20 MIN	REPAIR DOOR AS REQ'D, REPLACE ALL HARDWARE EXCEPT HINGES UNLESS THEY ARE DAMAGED. ALL HARDWARE SHALL BE NEW UNLESS OTHERWISE NOTED.
100	3'-0"	7'-0"	1-3/4"	WD	EX	1/2" ALUM	1/2" ALUM	EX	20 MIN	REPAIR DOOR AS REQ'D, REPLACE ALL HARDWARE EXCEPT HINGES UNLESS THEY ARE DAMAGED. ALL HARDWARE SHALL BE NEW UNLESS OTHERWISE NOTED.
101	3'-0"	7'-0"	1-3/4"	WD	EX	1/2" ALUM	1/2" ALUM	EX	20 MIN	REPAIR DOOR AS REQ'D, REPLACE ALL HARDWARE EXCEPT HINGES UNLESS THEY ARE DAMAGED. ALL HARDWARE SHALL BE NEW UNLESS OTHERWISE NOTED.
102	(2) 3'-0"	7'-0"	1-3/4"	WD	EX	1/2" ALUM	1/2" ALUM	EX	20 MIN	REPAIR DOOR AS REQ'D, REPLACE ALL HARDWARE EXCEPT HINGES UNLESS THEY ARE DAMAGED. ALL HARDWARE SHALL BE NEW UNLESS OTHERWISE NOTED.
103	3'-0"	7'-0"	1-3/4"	WD	EX	1/2" ALUM	1/2" ALUM	EX	20 MIN	REPAIR DOOR AS REQ'D, REPLACE ALL HARDWARE EXCEPT HINGES UNLESS THEY ARE DAMAGED. ALL HARDWARE SHALL BE NEW UNLESS OTHERWISE NOTED.

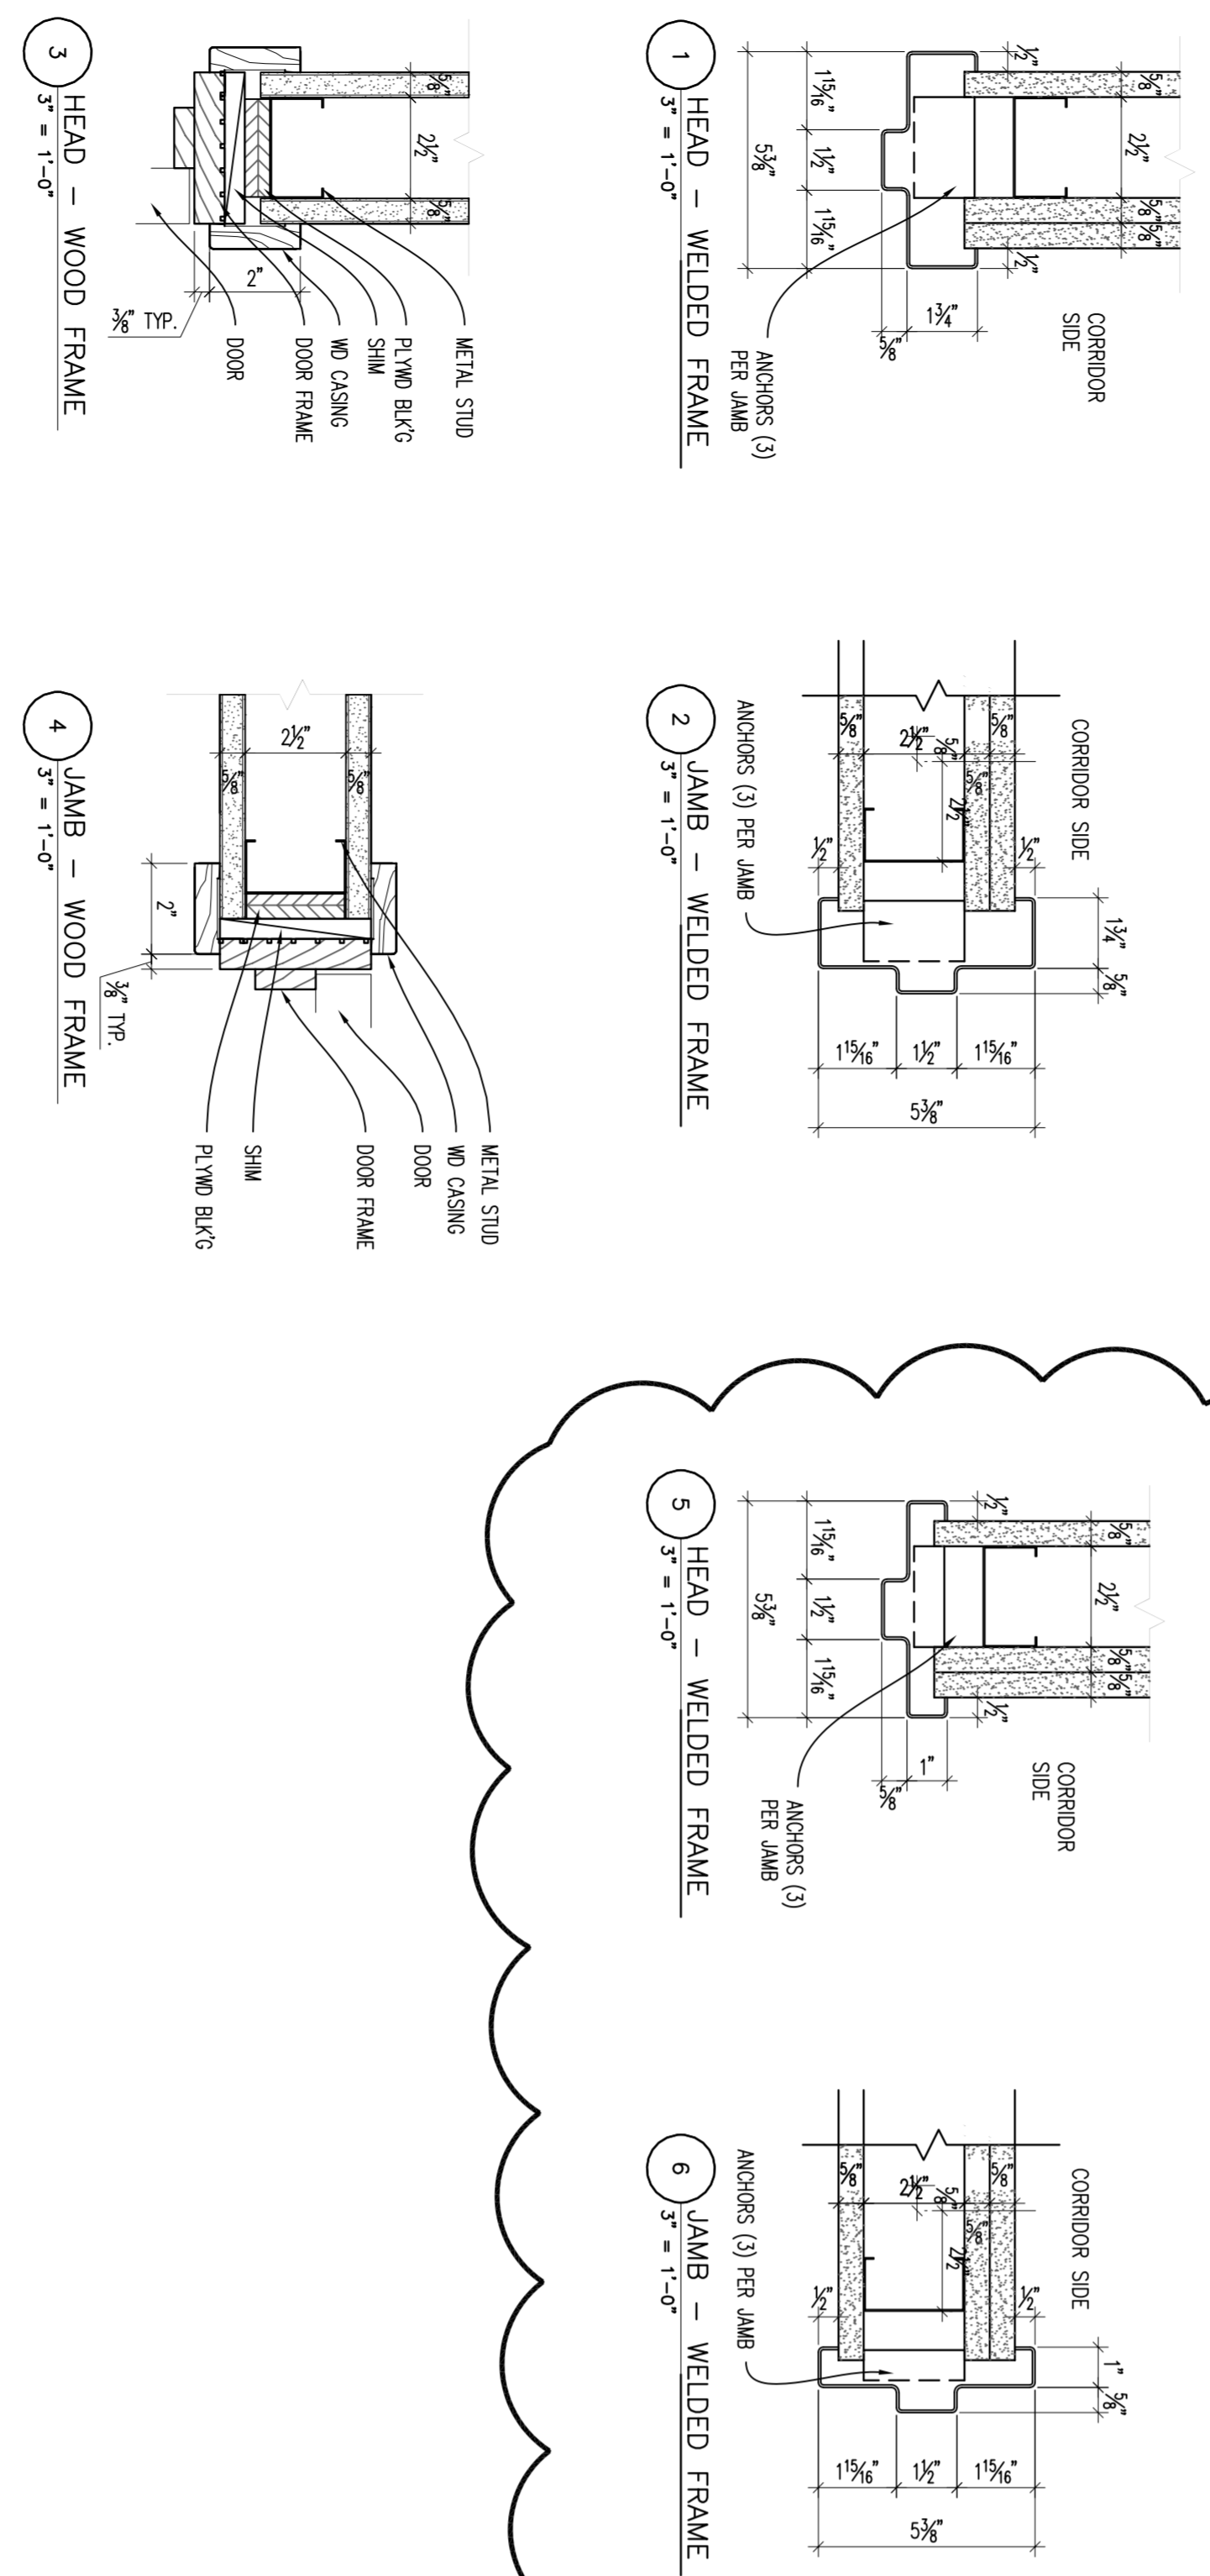

ITEMS	DOOR HARDWARE SCHEDULE							
	1	2	3	4	5	6	7	8
RATED HARDWARE								
(3) HINGES								
(6) HINGES								
ENTRANCE LOCKSET								
PRIVATE LOCKSET								
EXIT LOCKSET								
PASSAGE LOCKSET								
CLOSET LOCKSET								
STORAGE LOCKSET								
OFFICE LOCKSET								
PULL, PUSH PLATE, KICK PLATE								
ELECTRIC STRIKE								
ACCESS ENTRY (KEY FOB)								
ELECTRONIC KEY CARD DELEGATE								
DEAD BOLT								
SPRING CLOSER								
CLOSER								
PAIR CLOSER								
SMOKE SEAL								
WING ANGLE VENER								
DRAG WALL / FLOOR STOP								
WALL / FLOOR STOP								
MAGNETIC HOLD OPEN								
PANIC HARDWARE								
PANIC HARDWARE - CONCEALED								
THRESHOLD								
RUBBER THRESHOLD - LOW PROFILE								
WEATHER STAYS								
DOOR SWEEP								
SWEEP								

HARDWARE SCHEDULE NOTES:


APARTMENT ENTRY	HARDWARE SET							
	1	2	3	4	5	6	7	8
BED/BATH								
CLOSET								
DBL CLOSET								
JANITOR/MECHANICAL								
EGRESS DOOR								
ELEVATOR LOBBY DOOR								
EGRESS DOOR								

- GENERAL NOTES**
- If a door is NOT DAMAGED OR NOT CENTERED IN A ROOM, THE MINIMUM (ON STUD WALLS) SO THAT THE FACE OF THE FRAME IS 4" FROM THE CENTER OF THE DOOR SHOULD BE AN EQUAL DISTANCE BETWEEN ADJACENT WALLS.
 - ALL DOORS TO BE PAINTED TO MATCH ADJACENT WALLS, SEMI-GLOSS UNLESS OTHERWISE NOTED.
 - REFER TO APARTMENT PLANS FOR APARTMENT INTERIOR DOOR SCHEDULE.
 - ALL EXISTING HARDWARE TO BE REMAIN ON EXISTING HINGED DOORS.
 - ALL NEW DOOR HANDLES TO BE ADA COMPLIANT.
 - COORDINATE KENING OF ALL DOORS WITH OWNER. THIS INCLUDES ALL KEY PINS, KEY FIBERS, SECURED ACCESS POINTS, ETC.
 - ALL NEW AND EXISTING RATED DOORS ARE TO RECEIVE NEW CLOSERS.
 - EGRESS DOORS WILL BE REMOVED FROM THE EGRESS SIZE WITHOUT THE USE OF A KEY, SPECIAL KNOWLEDGE OR EFFORT.

A600	Project	Formica Building	
	115 E 5th Street		
	Cincinnati, Ohio 45202		
	Sheet Title	SCHEDULE: DOOR	
Project No.	2022_259	Issue Date	11.14.2022
Scale	As Noted	Drawn	Checked

Formica Building
 Office/Apartments
 Auditor Address: 115 E. 5th Street, Actual Address: 120 E. 4th Street
 Cincinnati OH 45202

modelgroup
 DEVELOPMENT • CONSTRUCTION • MANAGEMENT
 1826 Race Street
 Cincinnati, Ohio 45202
 513.559.0048

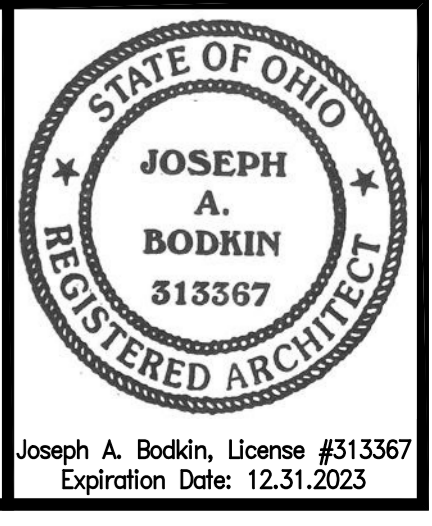

PARTITION CONFIGURATION:		PARTITION WALL MODIFICATIONS:		GENERAL NOTES:	
		<p>◇ PARTITION TYPE - NO MODIFICATION</p> <p>◇ THERMAL INSULATION BATTES REMOVE AND INSTALL THERMAL INSULATION BATTES AT STUD PARTITIONS.</p> <p>◇ ACUSTIC INSULATION REMOVE AND INSTALL ACUSTIC INSULATION BATTES AT STUD PARTITIONS. ACUSTIC SEALANT AROUND ALL PENETRATIONS.</p>		<p>A. THE PARTITION TYPE DESIGNATION INCLUDES THE PARTITION TYPE, A FIRE PARTITION CONFIGURATION, AND PARTITION WALL MODIFIERS (WHERE APPLICABLE).</p> <p>B. THE ASSSEMBLY RATING (RHS) IS SHOWN IN THE PARTITION CONFIGURATION.</p> <p>C. PARTITION TYPE NUMBERS ARE NOT SEQUENTIAL AND CERTAIN NUMBERS MAY NOT BE USED.</p> <p>D. ALL PARTITION TYPE DETAILS ARE PLAN VIEW, UNLESS NOTED OTHERWISE.</p>	
<p>TYPICAL END CONDITION DETAILS:</p> <p>1 DEEP LEGS BEGINNING TOP TRACK - NON RATED HEAD DETAIL SCALE: 1-1/2" = 1'-0"</p> <p>2 TYPICAL RATED AND ACUSTICAL METAL STUD PARTITIONS BASE DETAIL SCALE: 1-1/2" = 1'-0"</p> <p>3 PARTITION PERPENDICULAR TO DECKING RATED AND ACUSTICAL METAL STUD PARTITIONS HEAD DETAIL SCALE: 1-1/2" = 1'-0"</p> <p>4 RATED AND ACUSTICAL METAL STUD PARTITIONS HEAD DETAIL SCALE: 1-1/2" = 1'-0"</p> <p>5 RATED AND ACUSTICAL METAL STUD PARTITIONS HEAD DETAIL SCALE: 1-1/2" = 1'-0"</p> <p>6 RATED AND NON-RATED CUI PARTITIONS HEAD DETAIL SCALE: 1-1/2" = 1'-0"</p> <p>7 TYPICAL BASE OF HALF WALL PARTITION BASE DETAIL SCALE: 1-1/2" = 1'-0"</p> <p>8 RATED PARTITIONS ACUSTICAL INSULATION ACUSTICAL PARTITIONS</p> <p>9 RATED PARTITIONS ACUSTICAL INSULATION ACUSTICAL PARTITIONS</p> <p>10 RATED PARTITIONS ACUSTICAL INSULATION ACUSTICAL PARTITIONS</p> <p>11 WOOD JOIST (2) 3/4" TOP PLATES PARTITION PER PLAN RATED CEILING</p> <p>12 WOOD JOIST STAGGERED JOIST BRACES PARTITION PER PLAN RATED CEILING</p> <p>13 WOOD JOIST PARTITION PER PLAN RATED CEILING</p> <p>14 WOOD JOIST PARTITION PER PLAN RATED CEILING</p> <p>15 WOOD JOIST PARTITION PER PLAN RATED CEILING</p> <p>16 WOOD JOIST PARTITION PER PLAN RATED CEILING</p> <p>17 WOOD JOIST PARTITION PER PLAN RATED CEILING</p> <p>18 WOOD JOIST PARTITION PER PLAN RATED CEILING</p> <p>19 WOOD JOIST PARTITION PER PLAN RATED CEILING</p> <p>20 WOOD JOIST PARTITION PER PLAN RATED CEILING</p> <p>21 FIRE RESISTANCE (IF INDICATED BY TAG ON PLANS)</p> <p>22 FIRE RESISTANCE (IF INDICATED BY TAG ON PLANS)</p> <p>23 FIRE RESISTANCE (IF INDICATED BY TAG ON PLANS)</p> <p>25 FIRE RESISTANCE (IF INDICATED BY TAG ON PLANS)</p> <p>31 FIRE RESISTANCE (IF INDICATED BY TAG ON PLANS)</p> <p>41 FIRE RESISTANCE (IF INDICATED BY TAG ON PLANS)</p> <p>44 FIRE RESISTANCE (IF INDICATED BY TAG ON PLANS)</p>					

Project	Formica Building		
No.	Revisions	Date	
115 E 5th Street	ENG CHG #1	11.14.2022	
Cincinnati, Ohio 45202			
Sheet Title	PARTITIONS STYLES		
Project No.	2022_259	Issue Date	
Scale	As Noted	Drawn	Checked

Formica Building

Office/Apartments


Auditor Address: 115 E. 5th Street, Actual Address: 120 E. 4th Street
 Cincinnati OH 45202

modelgroup
 DEVELOPMENT • CONSTRUCTION • MANAGEMENT

1826 Race Street
 Cincinnati, Ohio 45202
 513.559.0048

STATE OF OHIO
 JOSEPH A. BODKIN
 315367
 REGISTERED ARCHITECT

Joseph A. Bodkin, License #313367
 Expiration Date: 12.31.2023

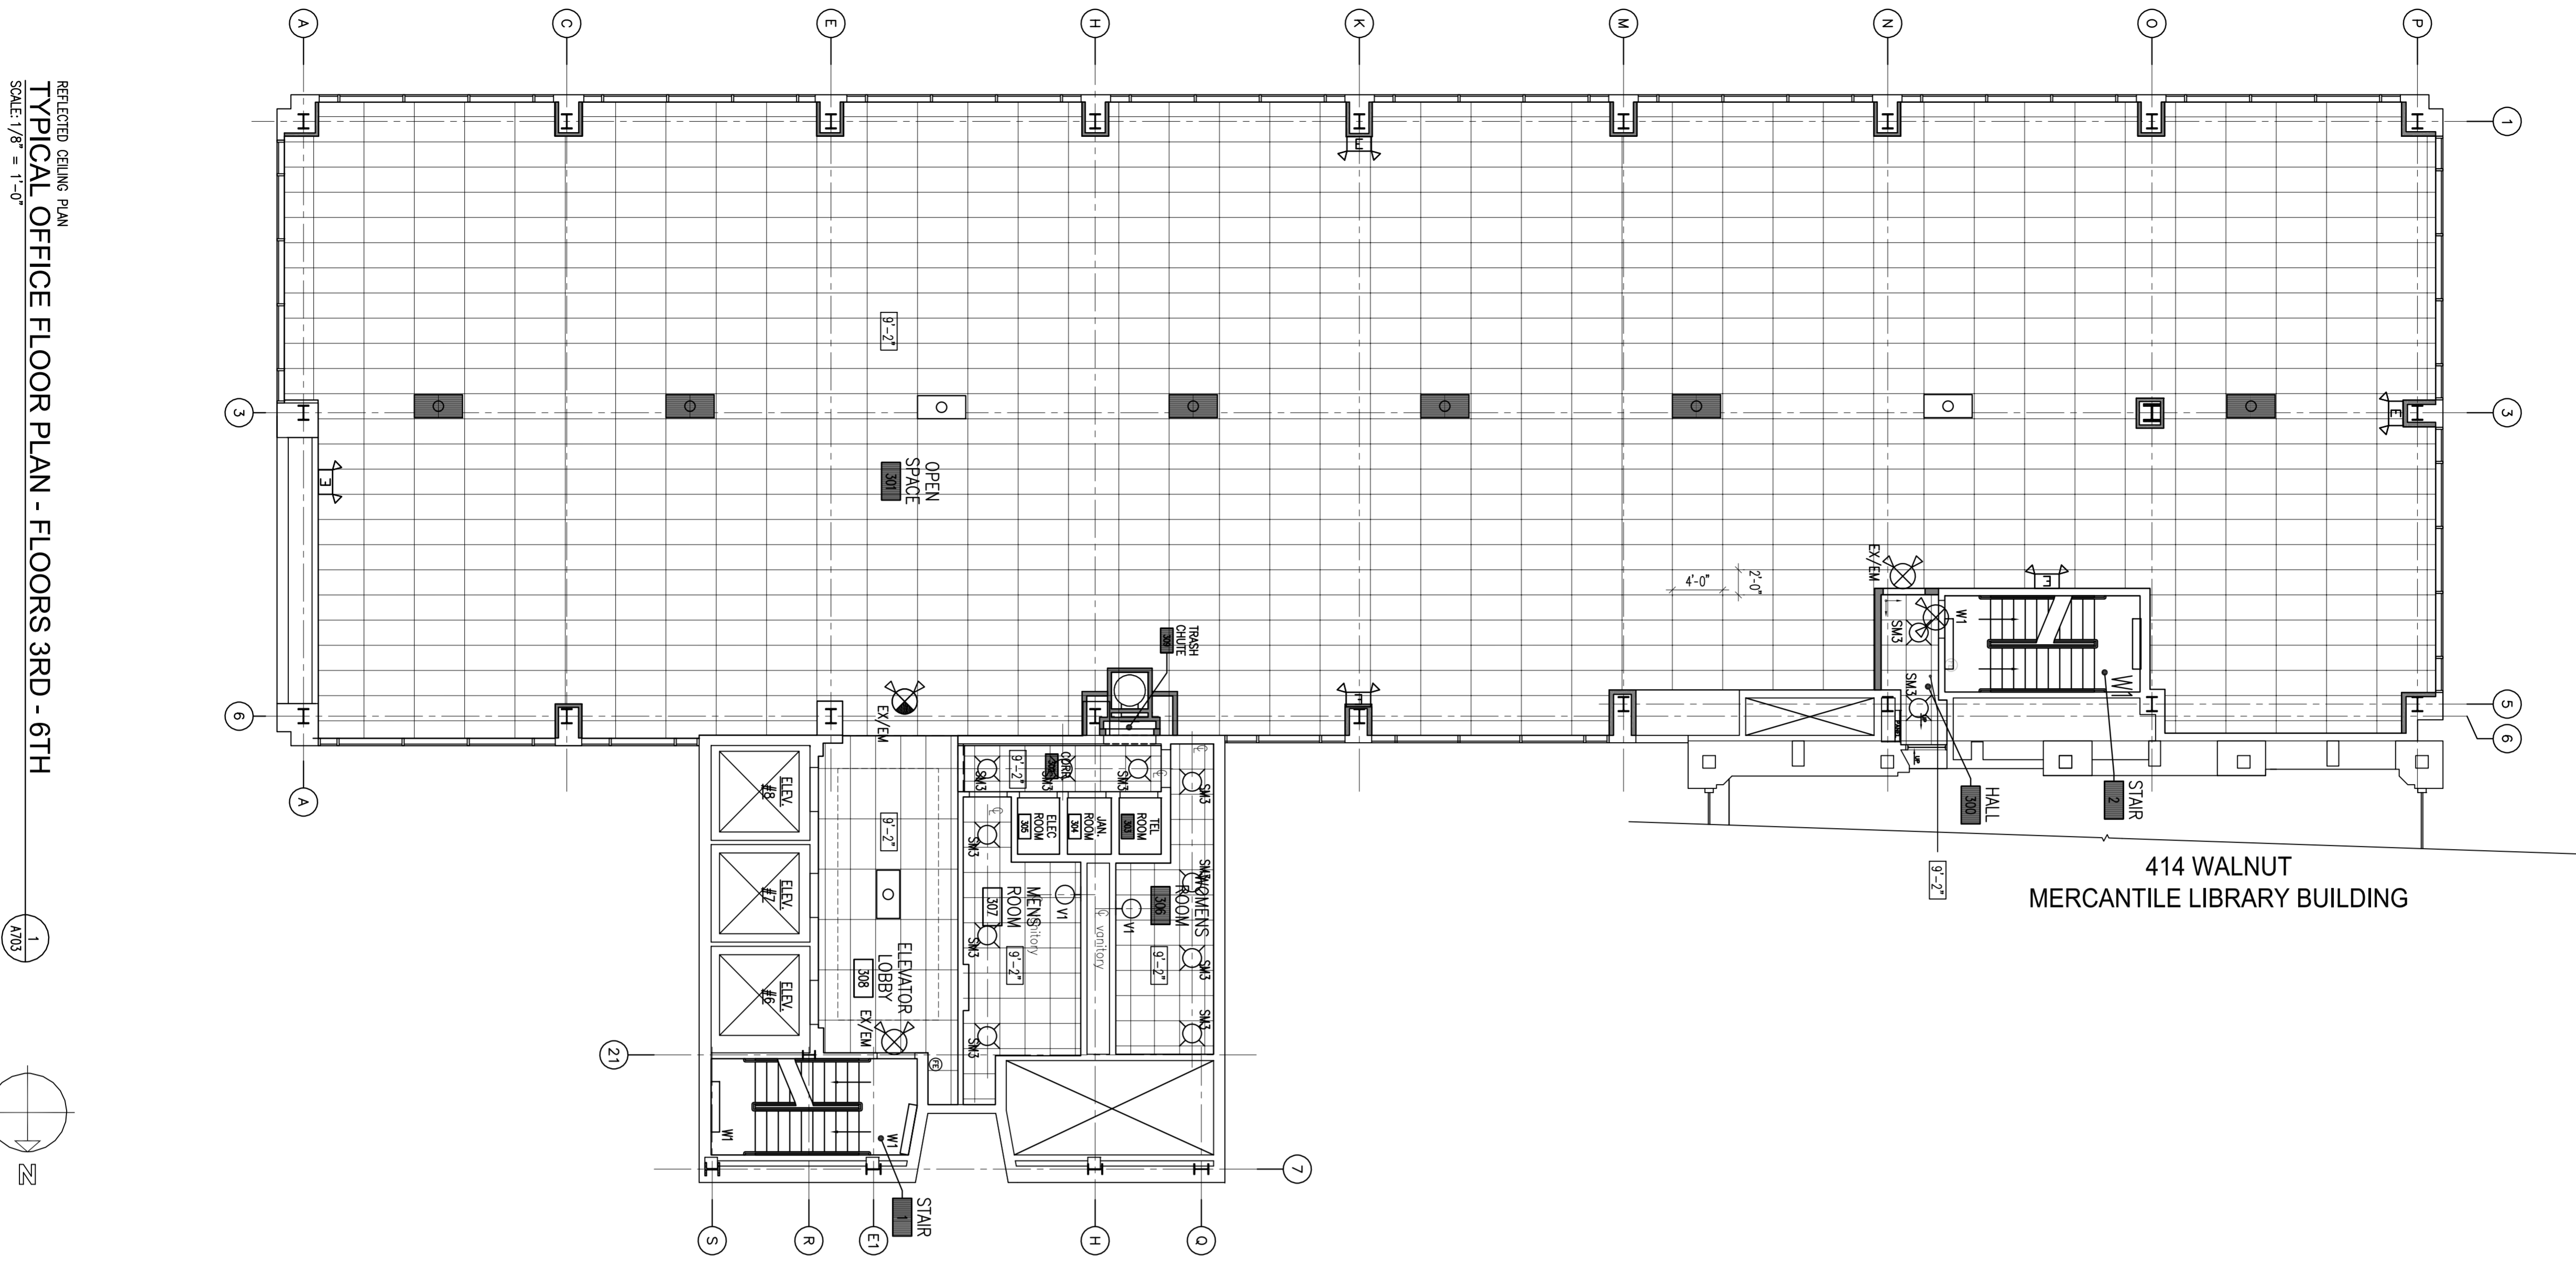

414 WALNUT
 MERCANTILE LIBRARY BUILDING

CODED CEILING NOTES:

1. NEW ACOUSTIC TILE LAY-IN CEILING AND GRID SEE FINISH SCHEDULE.
2. NO WORK IN THIS ROOM.
3. NEW 2'x2' LED IN GRID.
4. CEILING OPEN TO STRUCTURE ABOVE.
5. EXISTING ACFT AND GRID TO REMAIN, REPLACE EXISTING 2'x2' LED IN GRID WITH NEW 2'x2' LED IN GRID.
6. NEW 0'x6' BO. SPLIT, TYP. REPLACE ALL LIGHTS IN MECHANICAL ROOMS WITH NEW LED FIXTURES.

GENERAL CEILING NOTES:

- A. ALL ELECTRIC TO BE DESIGN-BUILD UNDER SEPARATE PERMIT.
- B. REFER TO PERMIT FOR CEILING INFORMATION.

CEILING LEGEND

- FOR ALL USABLE CORRIDORS, LOBBY, WAITING AREA, AND MECHANICAL ROOMS:
- 1p SURFACE TBD
 - 2p SURFACE TBD
 - 2r SURFACE R ROUND
 - 2s SURFACE S ROUND
 - 2t SURFACE T ROUND
 - R1 2'x4' LED IN GRID
 - R2 2'x2' LED IN GRID
 - SD10 DECORATIVE SURFACE MOUNTED
 - VI VANTIL LIGHT
 - WI WALL / CEILING MOUNTED
 - EW EMERGENCY LIGHTS
 - EW/BU EXIT W/ EMERGENCY LIGHTS
 - EX WALL MOUNTED EXIT
 - EX WALL MOUNTED EXIT
 - EX EXIT DIRECTIONAL - CEILING MOUNTED
 - ST1 WALL / CEILING MOUNTED - 4'
 - ST2 WALL / CEILING MOUNTED - 2'
- NOTE: ELECTRICAL IS TO PROVIDE APPROPRIATE WIRING AND CORRECT PHASERS FOR ALL LIGHTS SCHEDULED TO BE ON DIMMERS.

A703	Project		
	Formica Building	No. Revisions	Date
	120 E 4th Street	2	11.14.2022
	Cincinnati, Ohio 45202	ENG. CHG. #1	
	Sheet Title		
TYPICAL OFFICE FLOOR REFLECTED CEILING PLAN			
Project No. 2022_259		Issue Date	
Scale	Drawn	Checked	
As Noted			


Formica Building
 Office/Apartments
 Auditor Address: 115 E. 5th Street, Actual Address: 120 E. 4th Street
 Cincinnati OH 45202

modelgroup
 DEVELOPMENT • CONSTRUCTION • MANAGEMENT



1826 Race Street
 Cincinnati, Ohio 45202
 513.559.0048

STATE OF OHIO
JOSEPH A. BODKIN
 313367
 REGISTERED ARCHITECT


Joseph A. Bodkin, License #313367
 Expiration Date: 12-31-2023

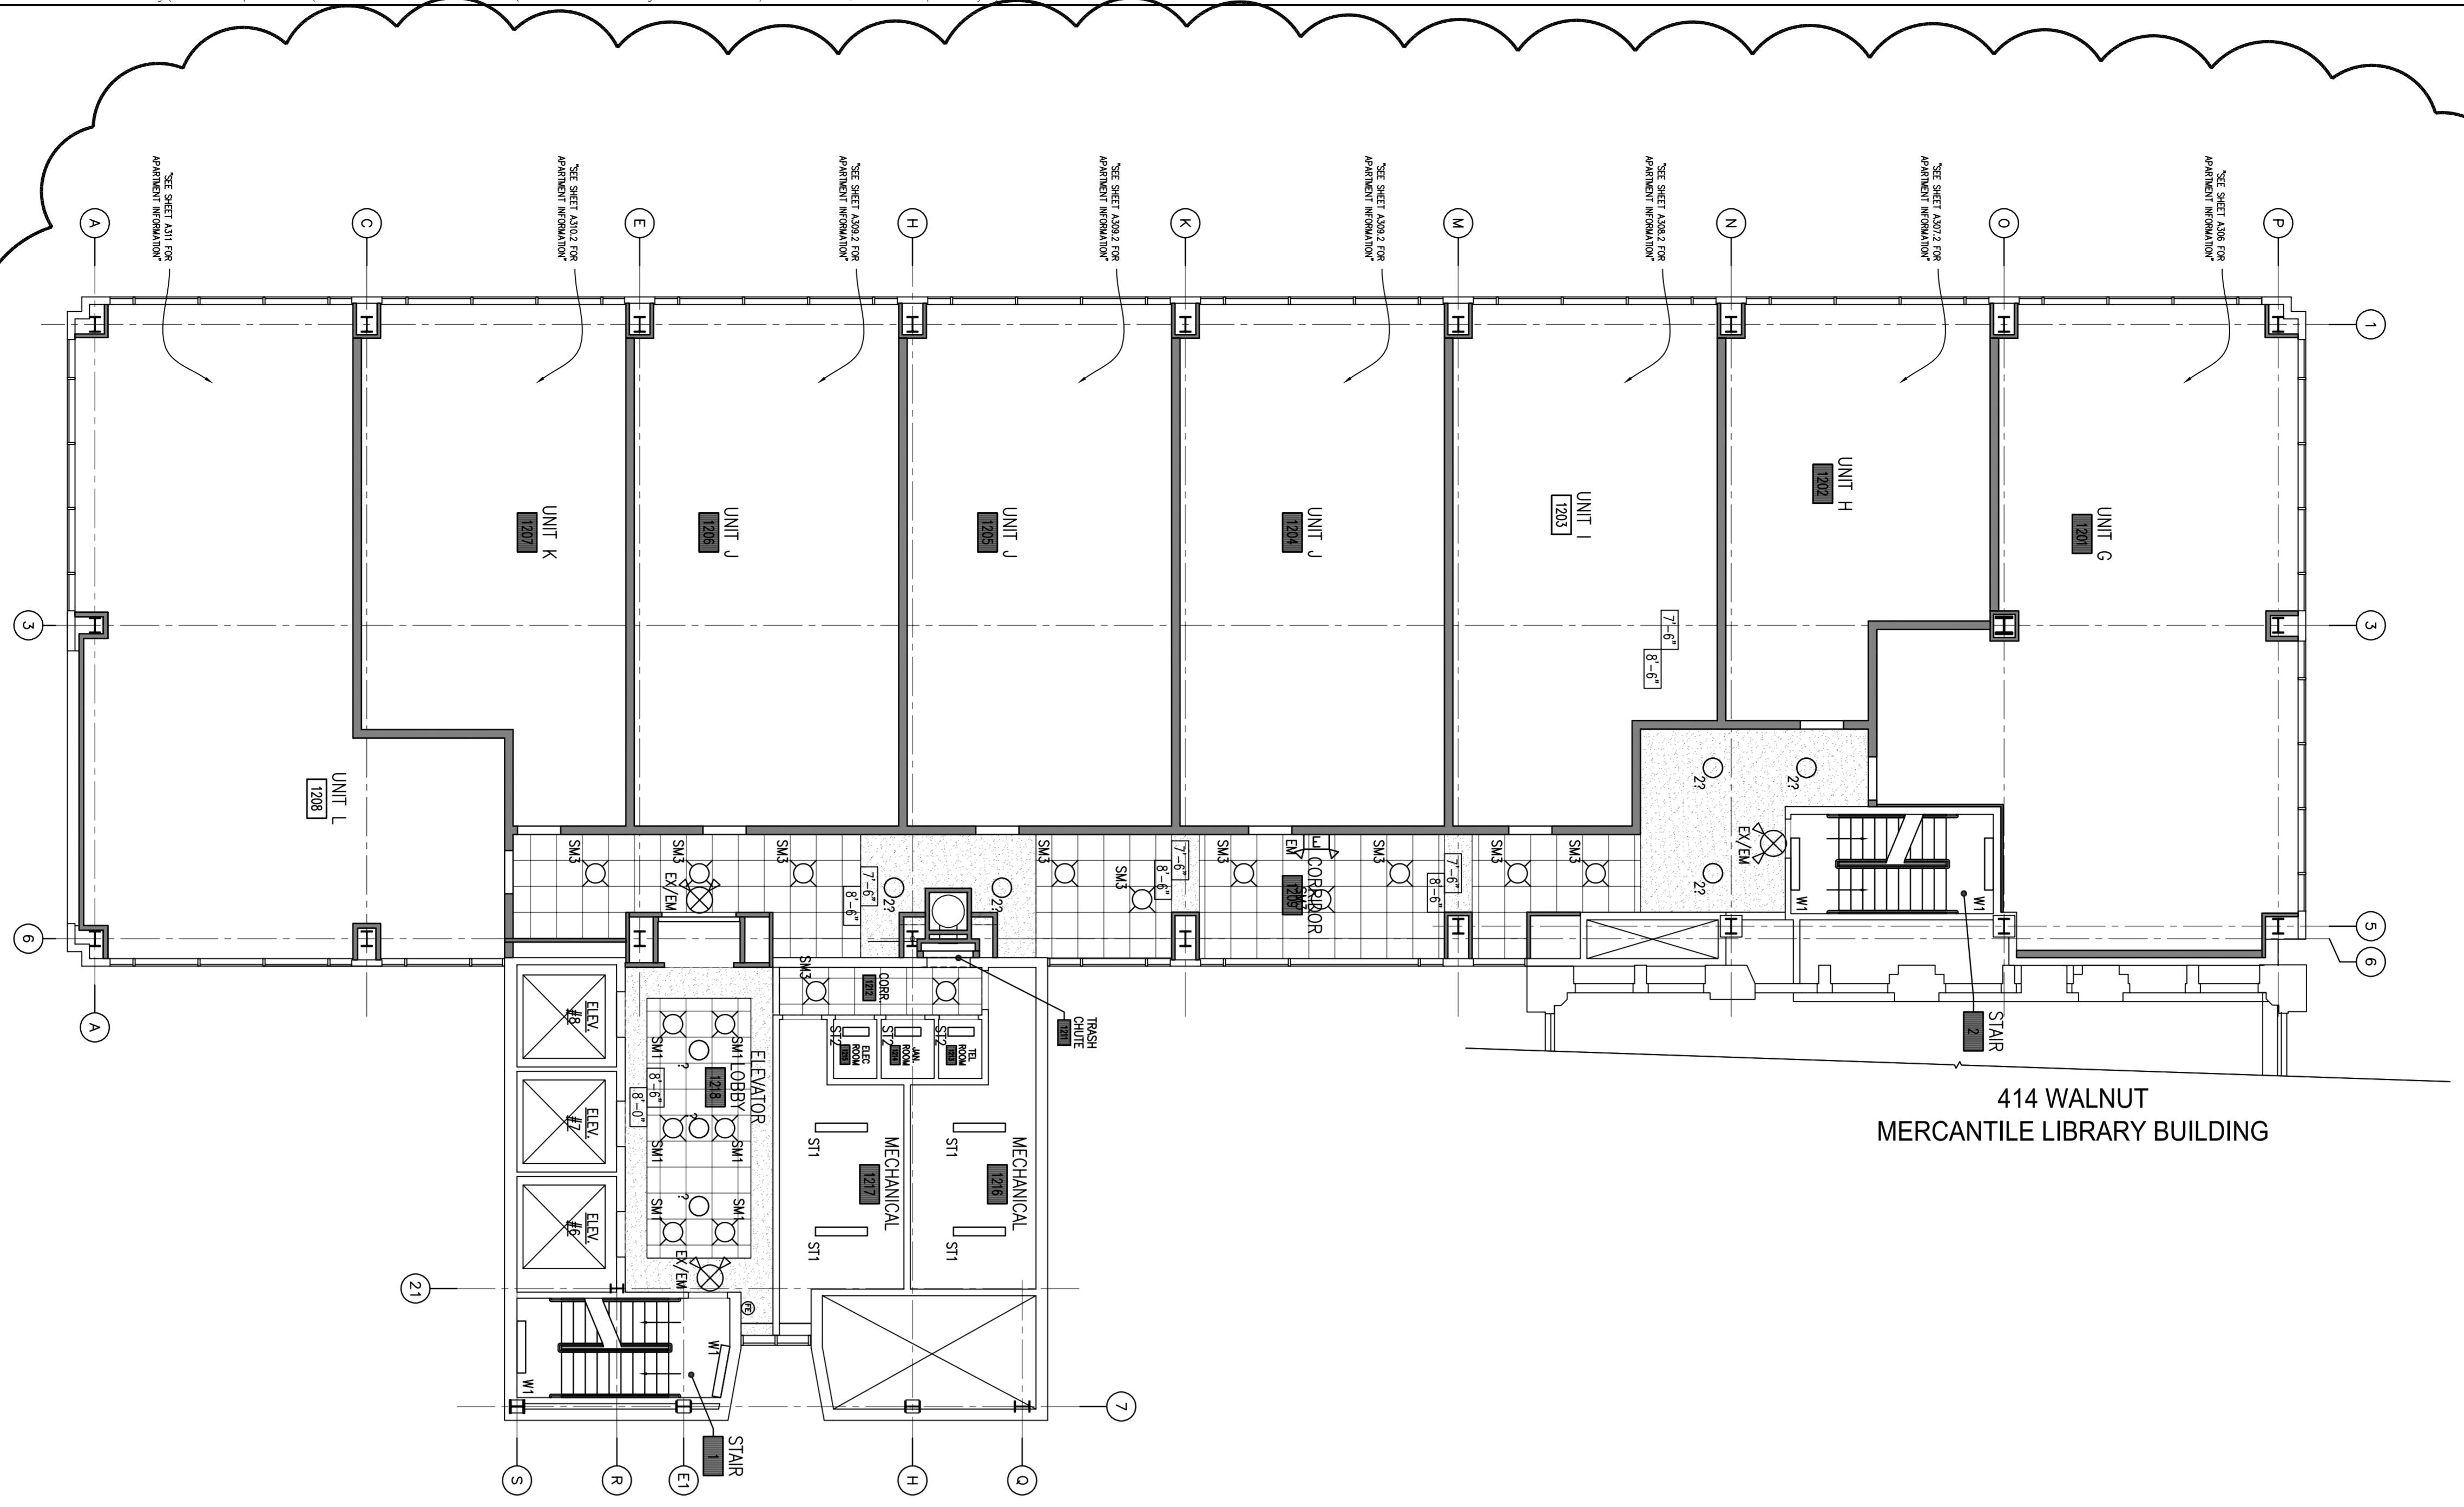

REGISTERED DESIGN PLAN
 TYPICAL RESIDENTIAL FLOOR PLAN - FLOOR 12
 SCALE: 1/8" = 1'-0"

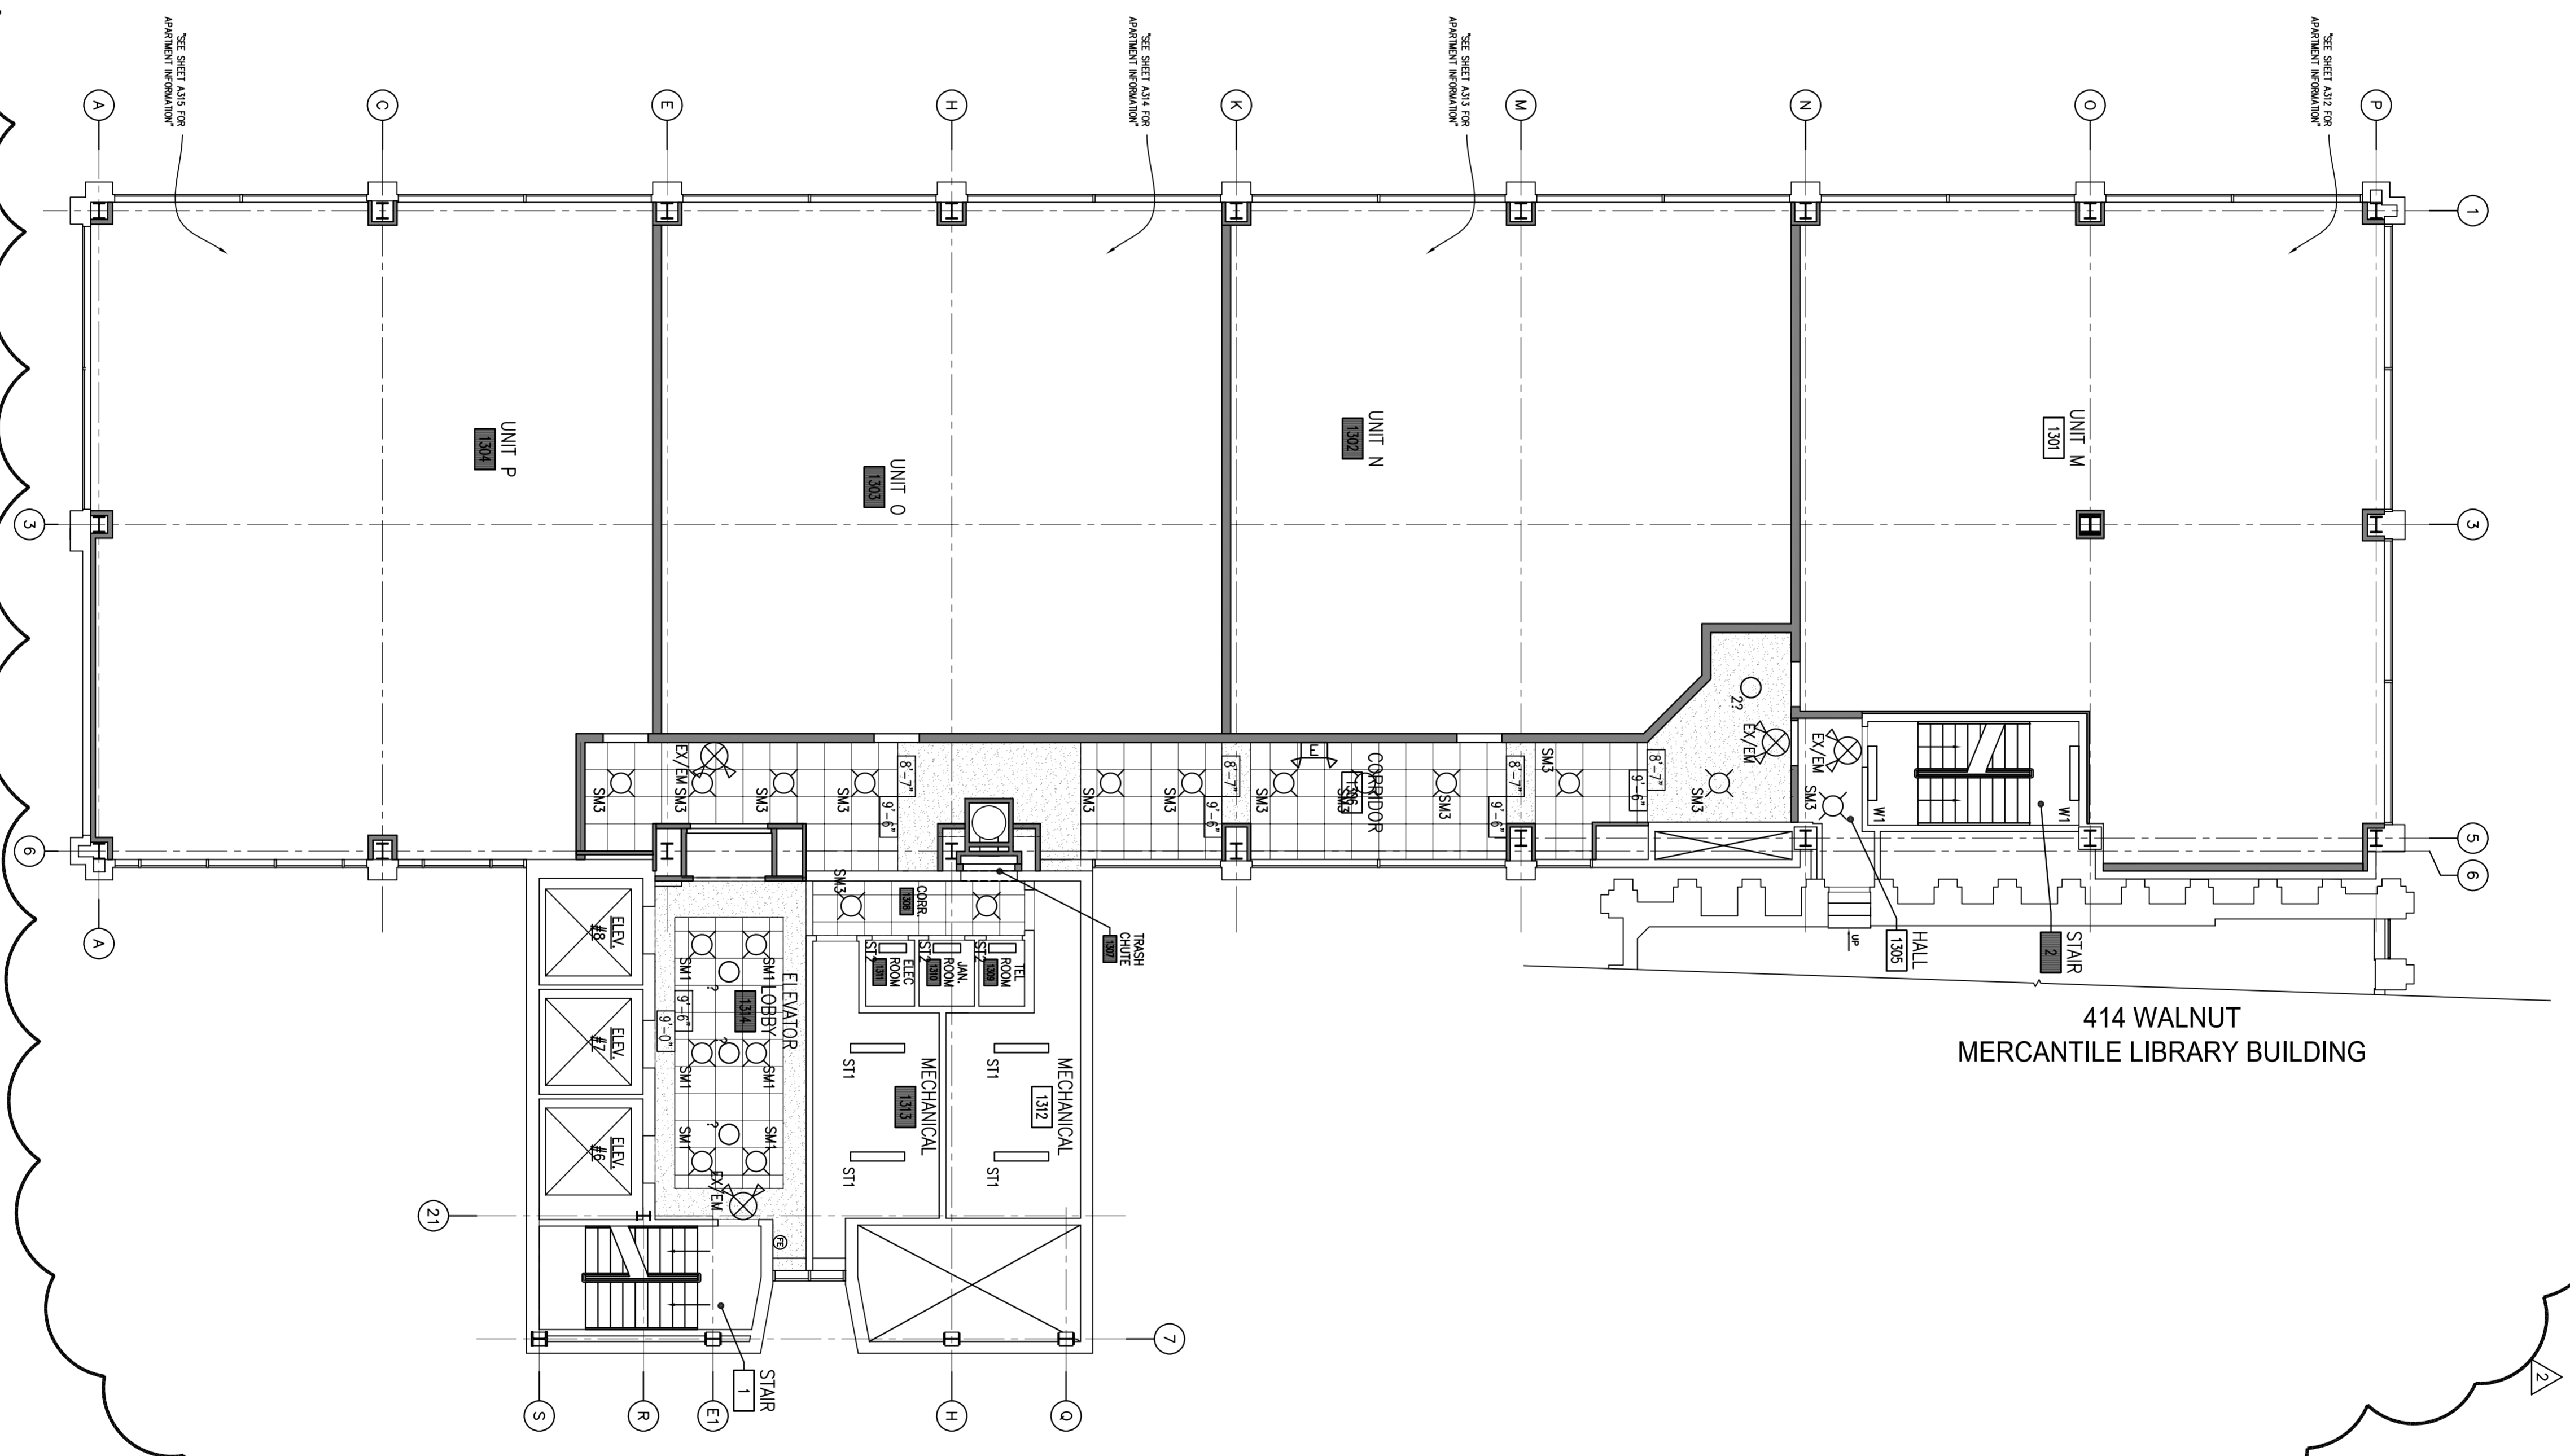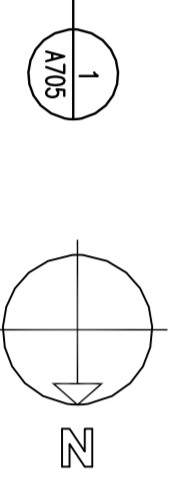

REGISTERED DESIGN PLAN
 RESIDENTIAL FLOOR PLAN - FLOOR 13TH
 SCALE: 1/8" = 1'-0"

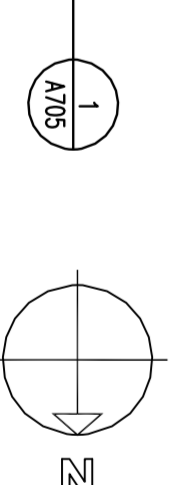

- GENERAL CEILING NOTES:**
1. NEW APERTURE, TILE LAY-IN CEILING AND GRID, SEE FINISH SCHEDULE.
 2. NO WORK IN THIS ROOM.
 3. NEW OR R/O CEILING LIGHTS ABOVE.
 4. EXISTING LIGHTS TO REMAIN, REPLACE EXISTING LIGHTS WITH NEW LED FIXTURES.
 5. EXISTING LIGHTS WITH NEW LED FIXTURES.
 6. REPLACE ALL LIGHTS IN MECHANICAL ROOMS WITH NEW LED FIXTURES.

- CEILING LEGEND**
- 1" SURFACE T80
 - 2" SURFACE T80
 - 3" SURFACE 6" ROUND
 - 3" SURFACE 4" ROUND
 - 2x4 LED IN GRID
 - 2x2 LED IN GRID
 - 2x4 LED IN GRID
 - DECORATIVE SURFACE MOUNTED
 - WALL MOUNTED
 - EMERGENCY LIGHTS
 - EXIT W/ EMERGENCY LIGHTS
 - WALL MOUNTED EXIT
 - EXIT DIRECTIONAL - CEILING MOUNTED
 - WALL / CEILING MOUNTED - 4"
 - WALL / CEILING MOUNTED - 2"

NOTE: O/R ELECTRICAL IS TO PROVIDE APPROPRIATE FINISH AND MATERIALS FOR ALL LIGHTS TO BE ON DIMMERS TO BE ON DIMMERS.


A705	Project	Formica Building	No. Revisions	Date
		120 E 4th Street	2	11.11.2022
	Sheet Title	RESIDENTIAL FLOORS REFLECTED CEILING PLANS	ENG CHG #1	
	Project No.	2022_259	Issue Date	
Scale	As Noted	Drawn	Checked	

Formica Building


Office/Apartments
 Auditor Address: 115 E. 5th Street, Actual Address: 120 E. 4th Street
 Cincinnati OH 45202

modelgroup
 DEVELOPMENT • CONSTRUCTION • MANAGEMENT


1826 Race Street
 Cincinnati, Ohio 45202
 513.559.0048

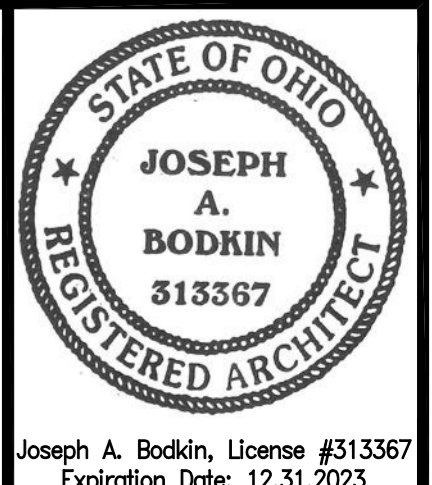


C:\Users\jboekin\Dropbox\01_NBDG_Projects\2022\2022P03573\2022P03573.dwg - Plot Date/Time: Nov 14, 2022 - 3:50pm - By: jboekin

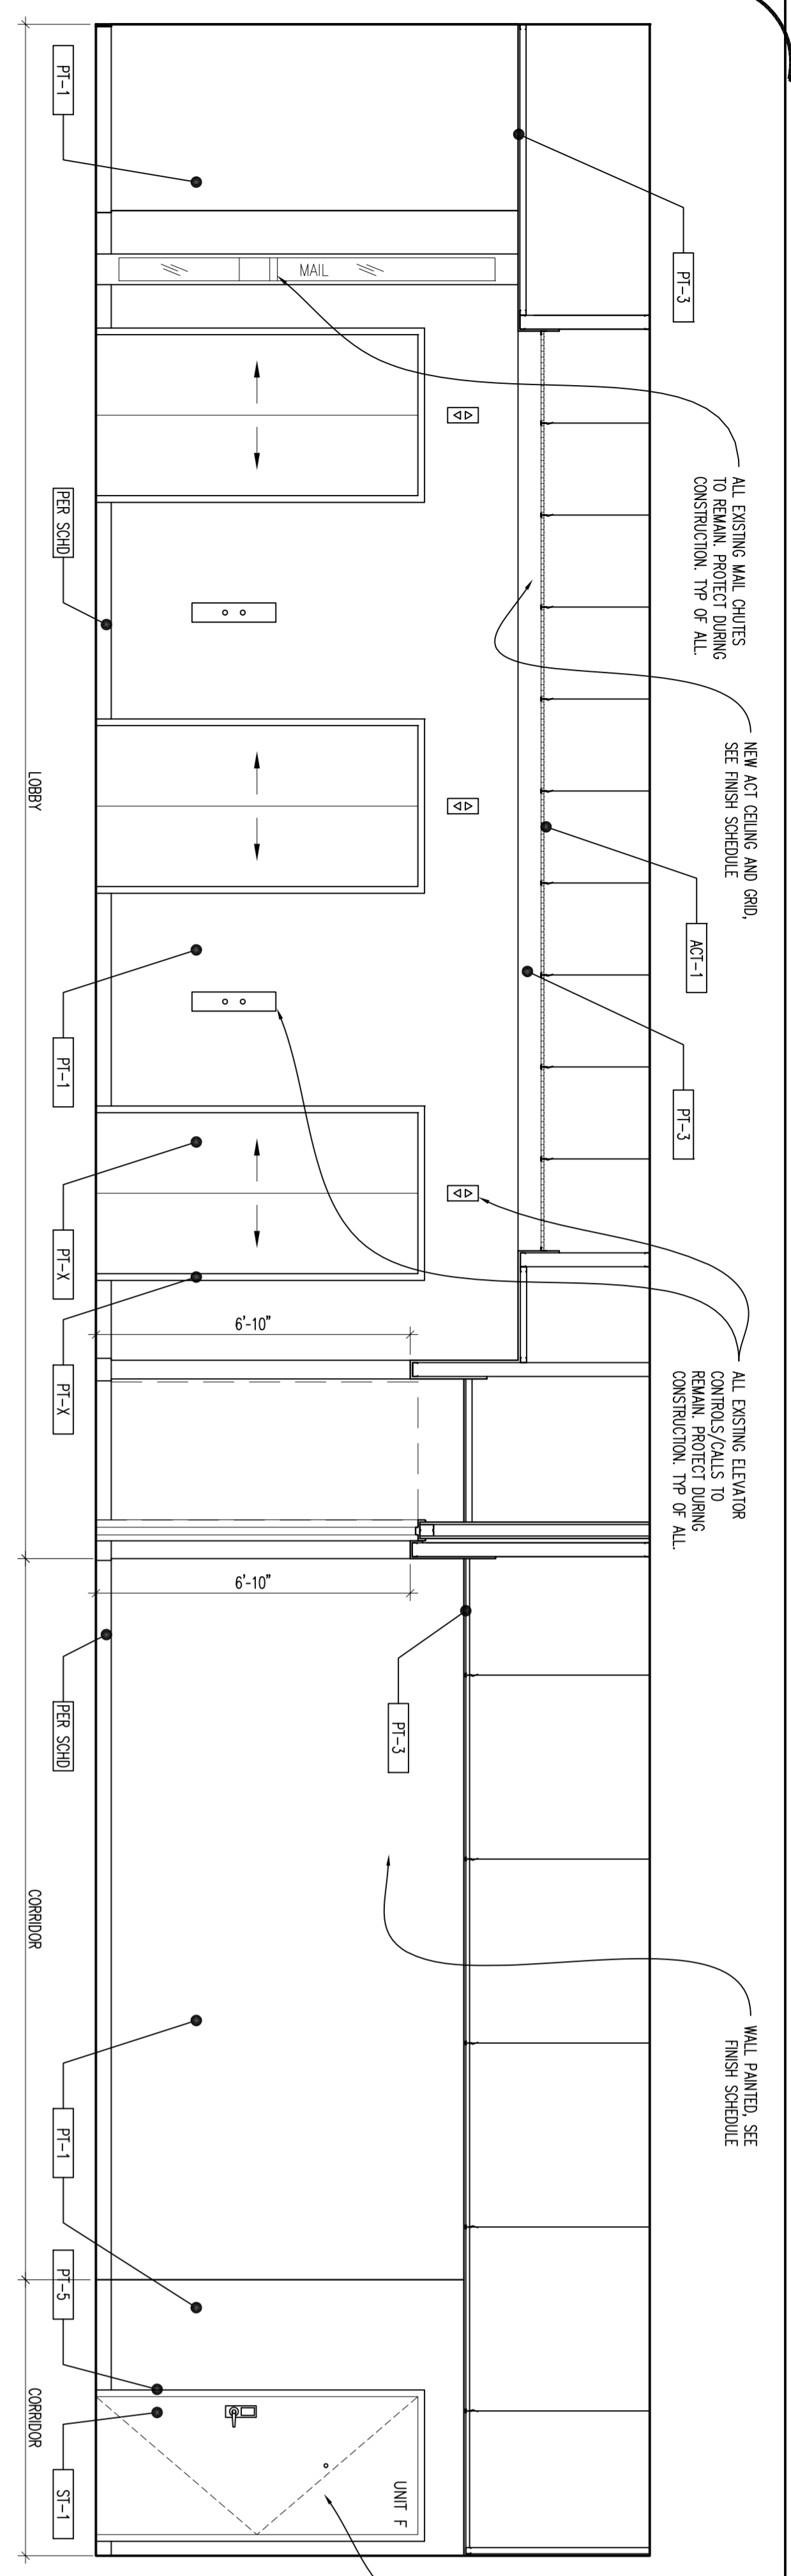


TYPICAL LOBBY - 7TH TO 10TH FLOOR
 ELEVATION
 SCALE: 3/8" = 1'-0"

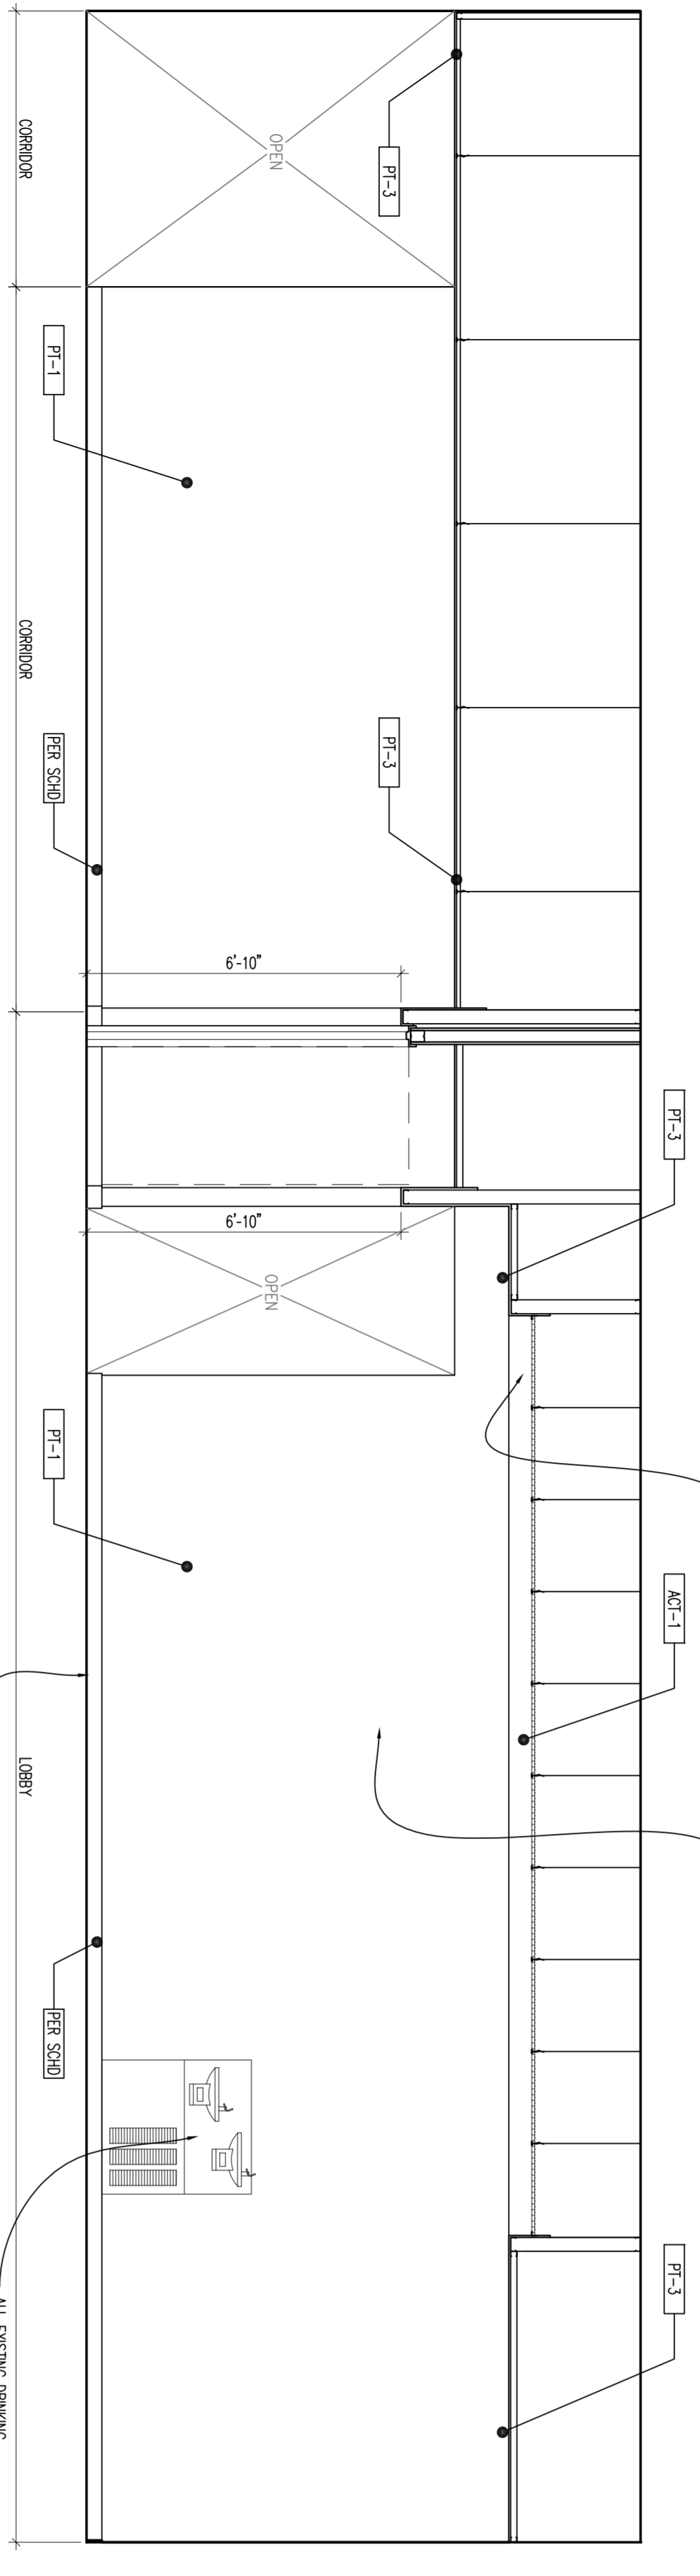


TYPICAL LOBBY - 7TH TO 10TH FLOOR
 ELEVATION
 SCALE: 3/8" = 1'-0"

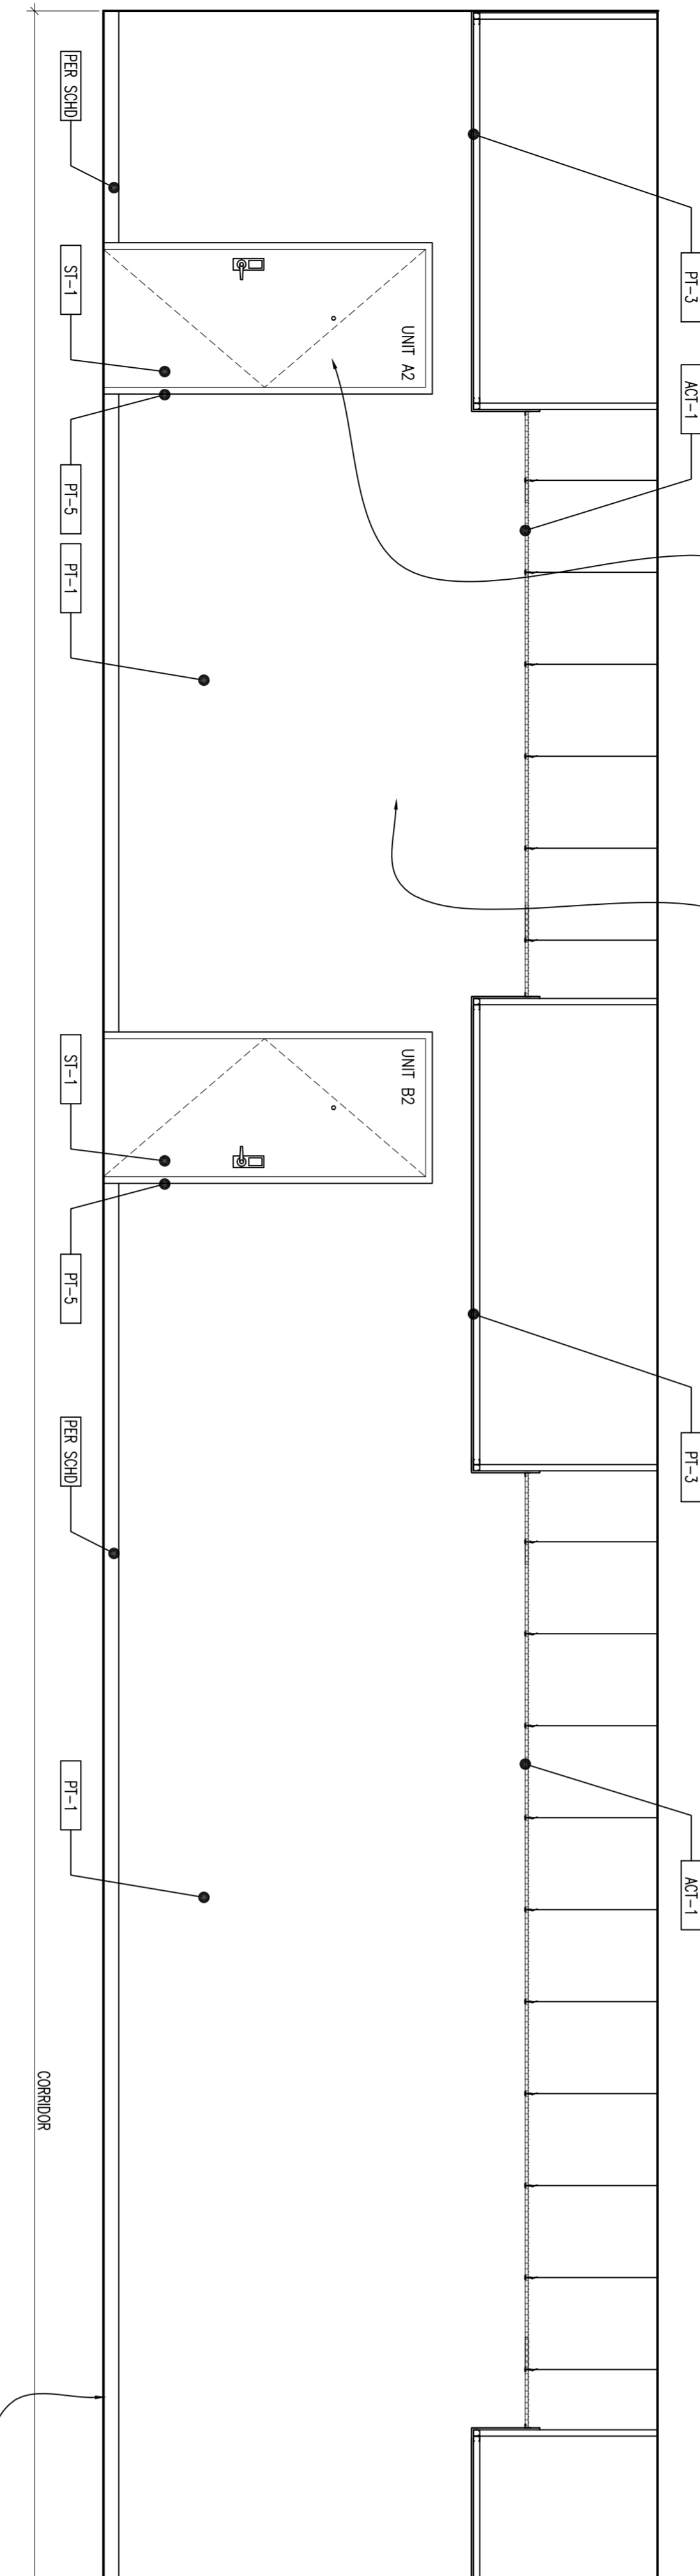


TYPICAL CORRIDOR - 7TH TO 10TH FLOOR
 ELEVATION
 SCALE: 3/8" = 1'-0"

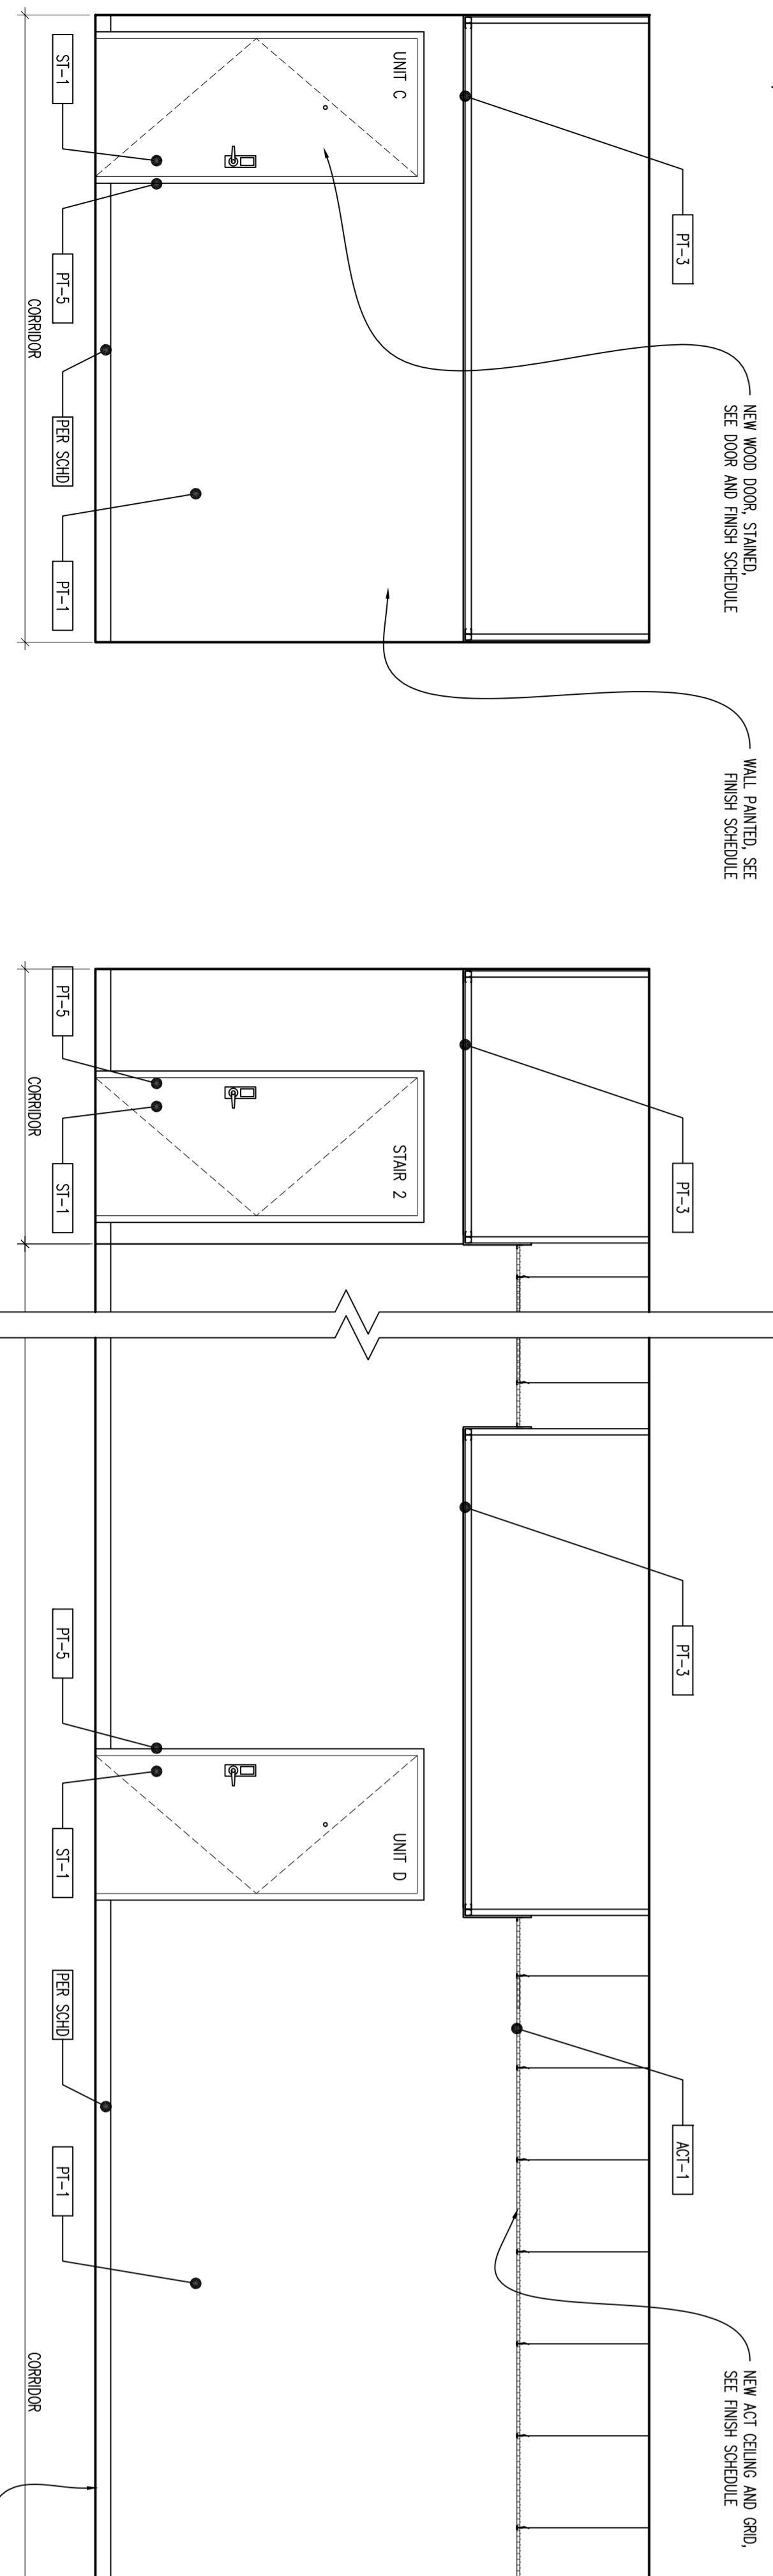


TYPICAL CORRIDOR - 7TH TO 10TH FLOOR
 ELEVATION
 SCALE: 3/8" = 1'-0"

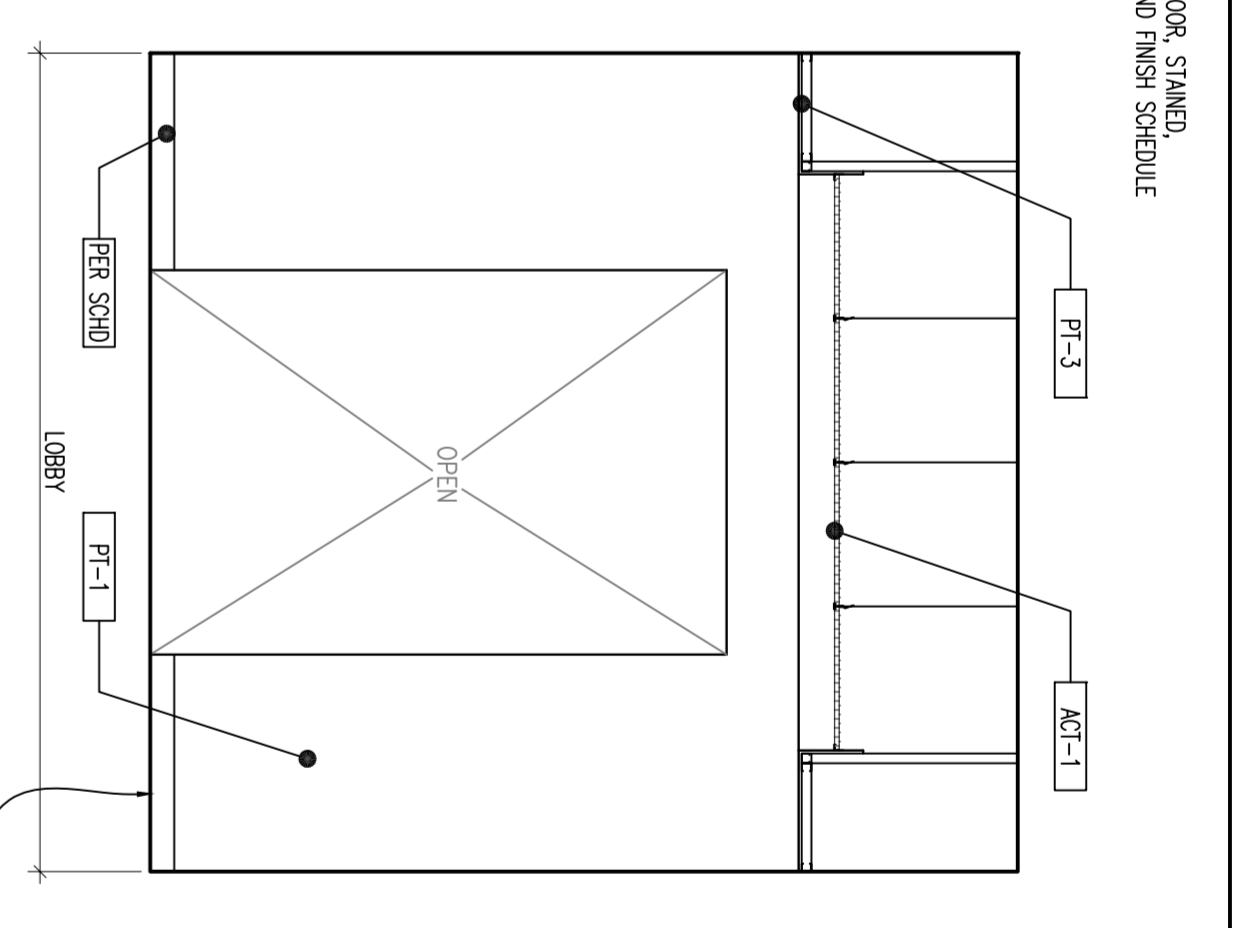


TYPICAL LOBBY - 7TH TO 10TH FLOOR
 ELEVATION
 SCALE: 3/8" = 1'-0"

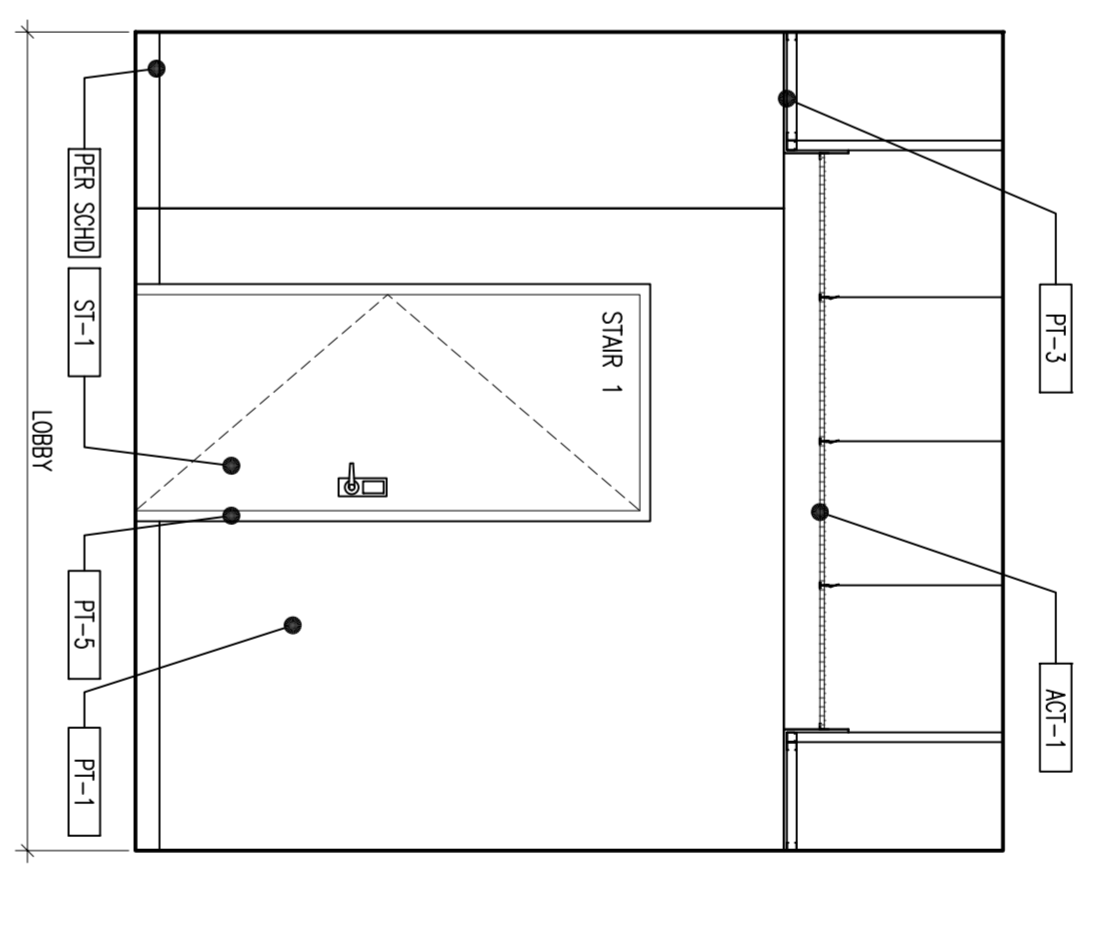

TYPICAL LOBBY - 7TH TO 10TH FLOOR
 ELEVATION
 SCALE: 3/8" = 1'-0"

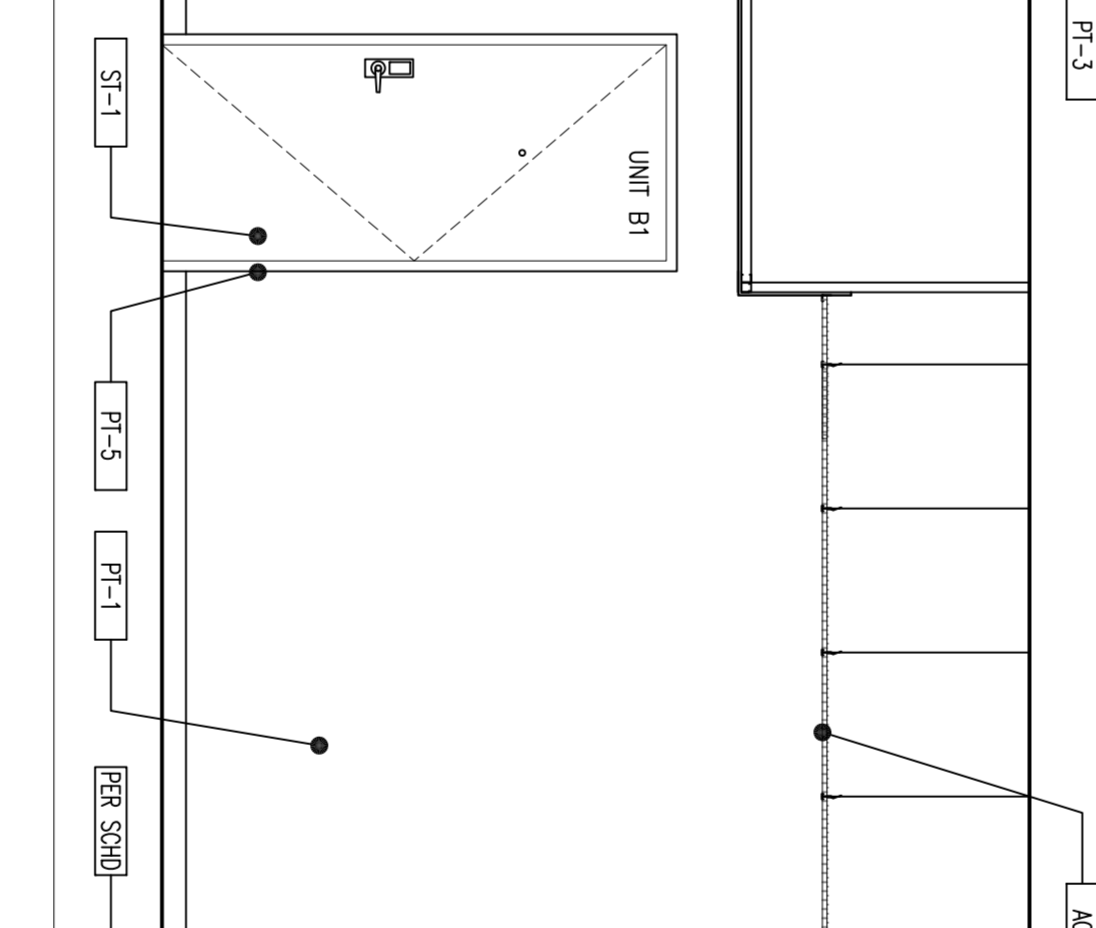

TYPICAL CORRIDOR - 7TH TO 10TH FLOOR
 ELEVATION
 SCALE: 3/8" = 1'-0"

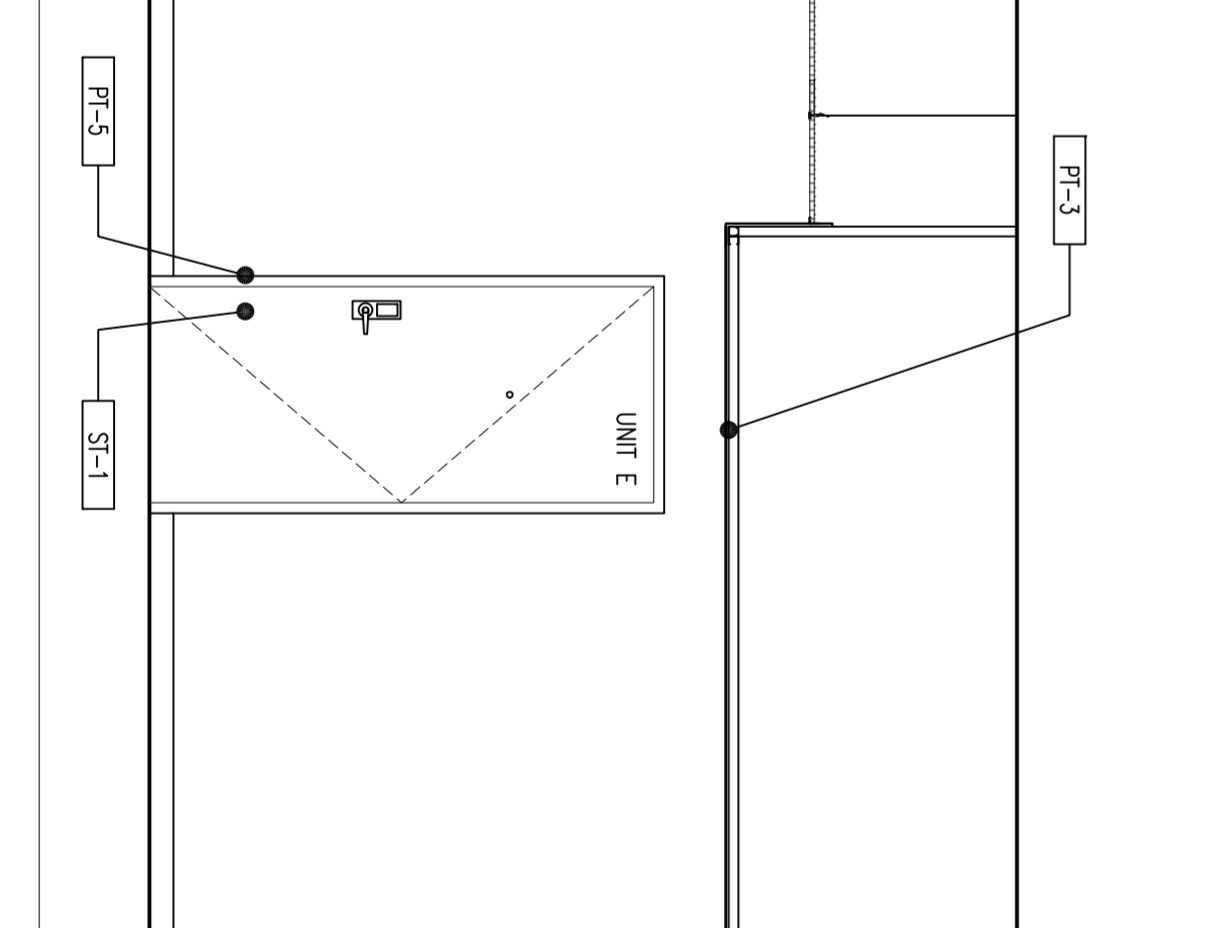

TYPICAL CORRIDOR - 7TH TO 10TH FLOOR
 ELEVATION
 SCALE: 3/8" = 1'-0"

- GENERAL ELEVATION NOTES:**
- SEE FINISH SCHEDULE FOR ALL FINISHES.
 - ALL ELEVATOR DOOR BUTTONS AND SIGNALS ARE TO REMAIN.
 - ALL WALL CHUTES ARE TO REMAIN. PROTECT DURING CONSTRUCTION.
 - ALL EXISTING PROTOTYPING CABINETS ARE TO REMAIN. PROTECT DURING CONSTRUCTION.
 - ALL EXISTING WINDOW FRAMES AND GLASS ARE TO REMAIN. PROTECT DURING CONSTRUCTION.

A800	Project		
	Formica Building		
	115. E 5th Street		
	Cincinnati, Ohio 45202	No. Revisions	Date
	2	ENG CHG #1	11.14.2022
Sheet Title			
INTERIOR ELEVATIONS - Common Apartment Hallways			
Construction			
Project No. 2022_259	Issue Date		
Scale	As Noted	Drawn	Checked


Formica Building

Office/Apartments


Auditor Address: 115 E. 5th Street, Actual Address: 120 E. 4th Street
 Cincinnati OH 45202




1826 Race Street
 Cincinnati, Ohio 45202
 513.559.0048

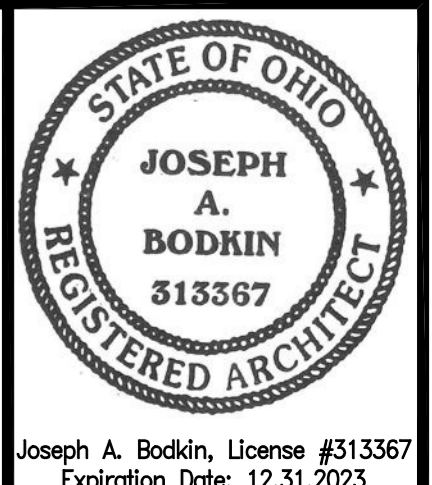


Joseph A. Bodkin, License #313367
 Expiration Date: 12.31.2023

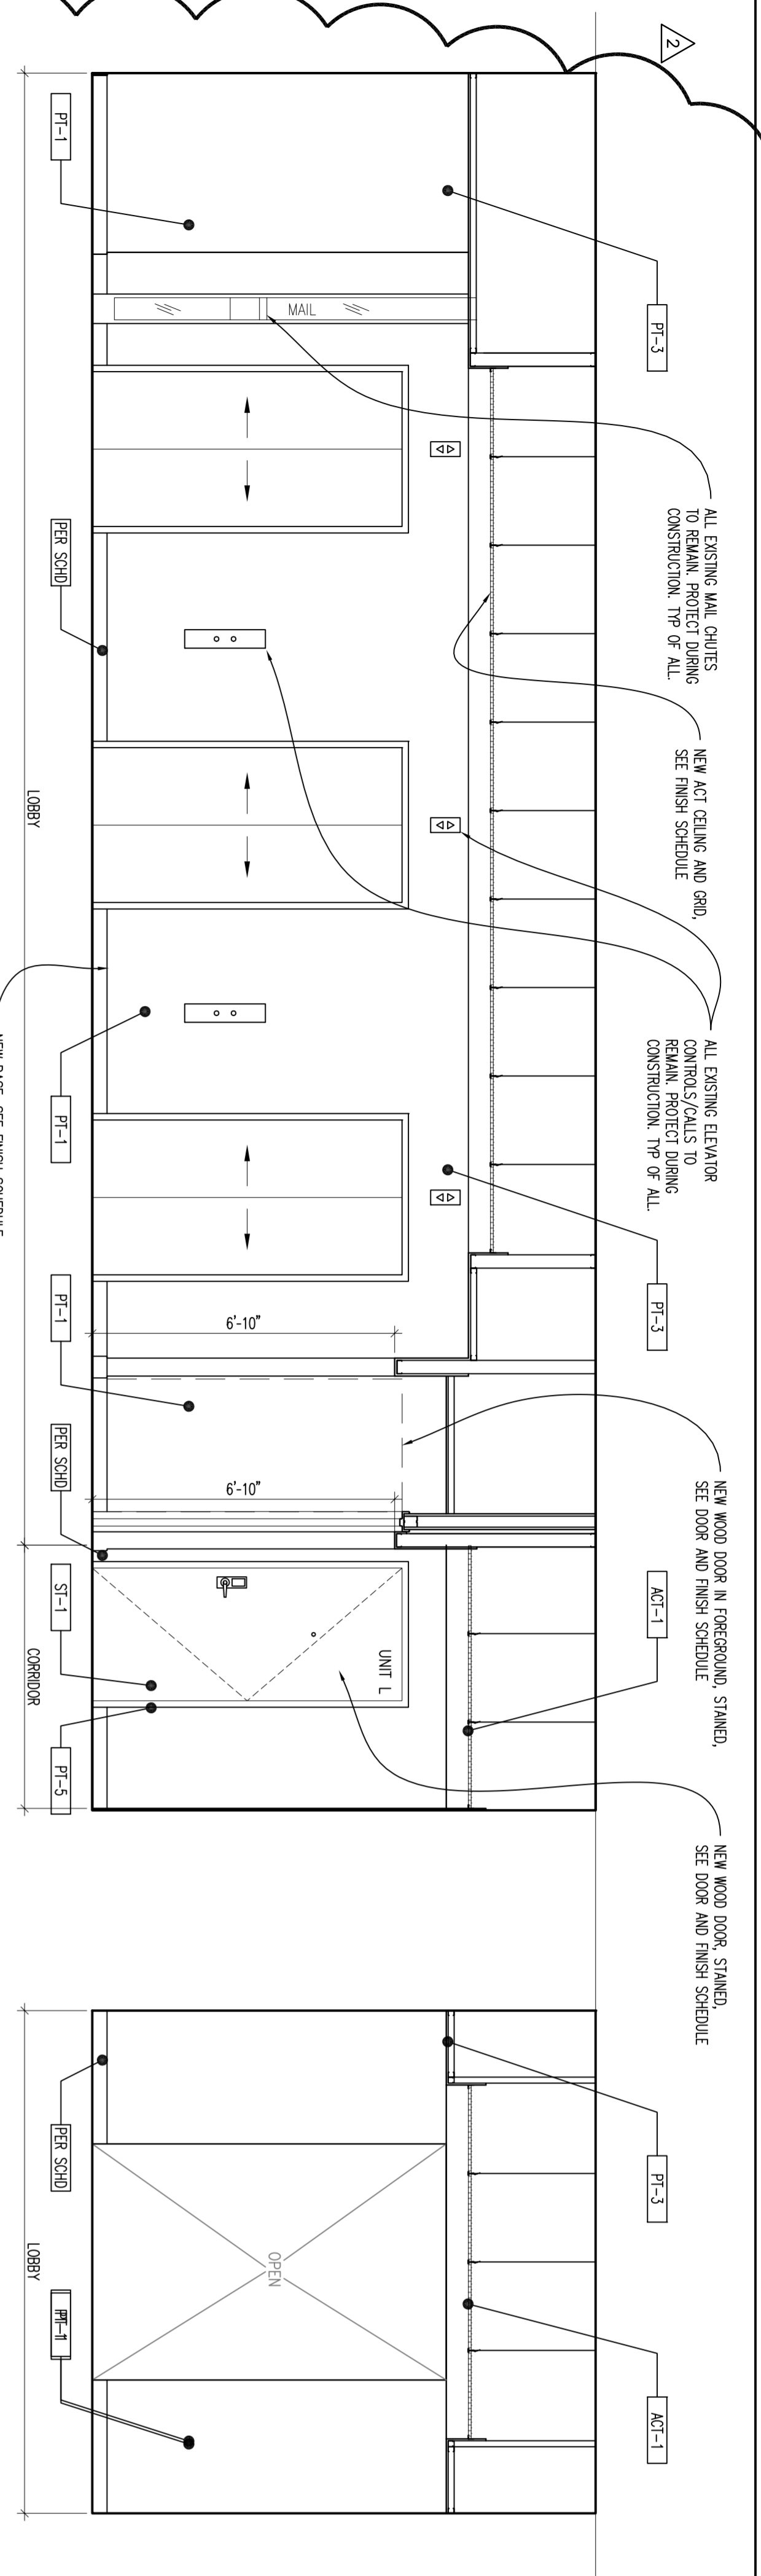


TYPICAL LOBBY - 12TH FLOOR
 ELEVATION
 SCALE: 3/8" = 1'-0"

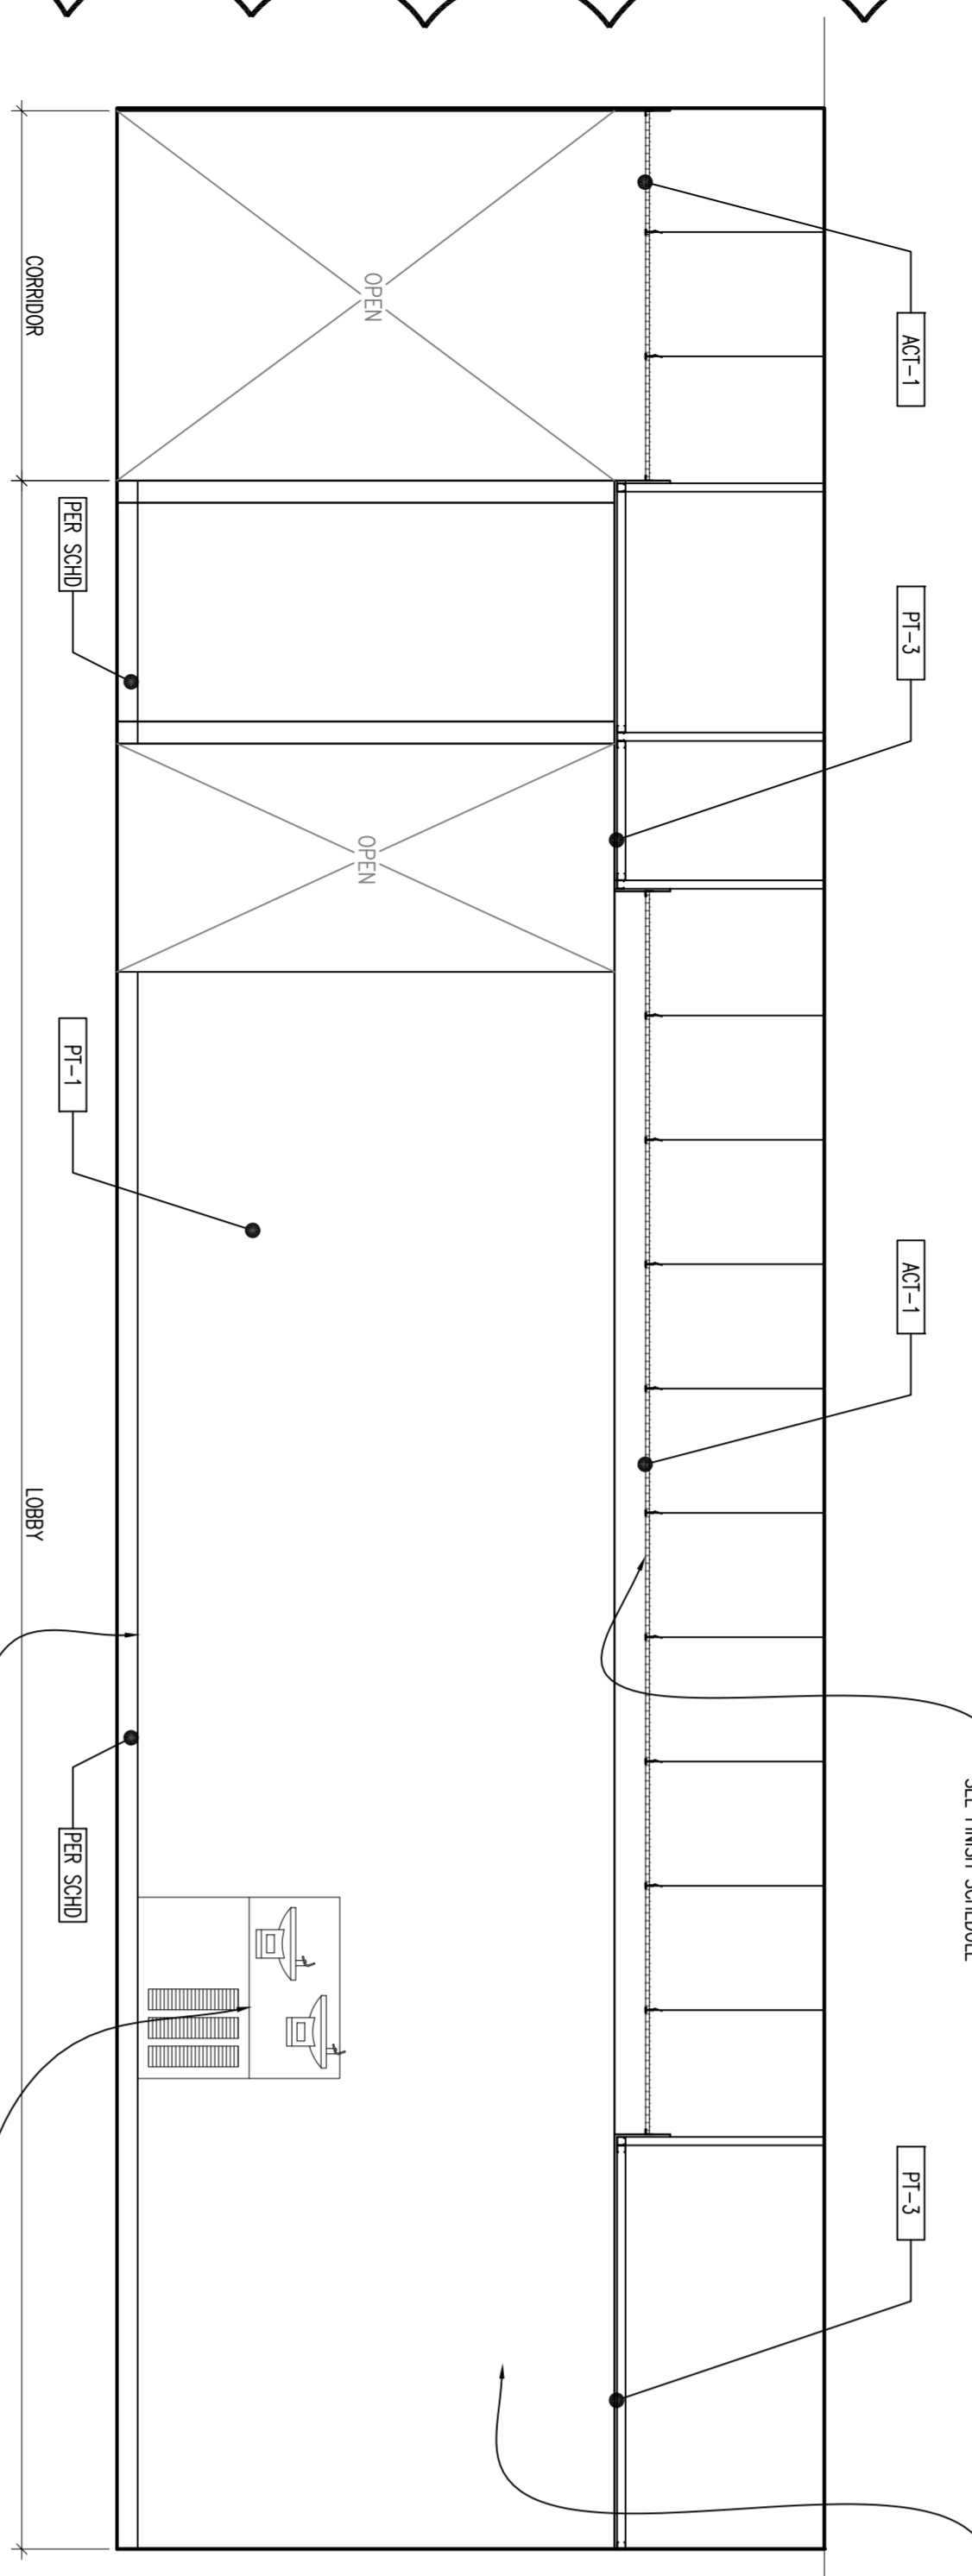


TYPICAL LOBBY - 12TH FLOOR
 ELEVATION
 SCALE: 3/8" = 1'-0"

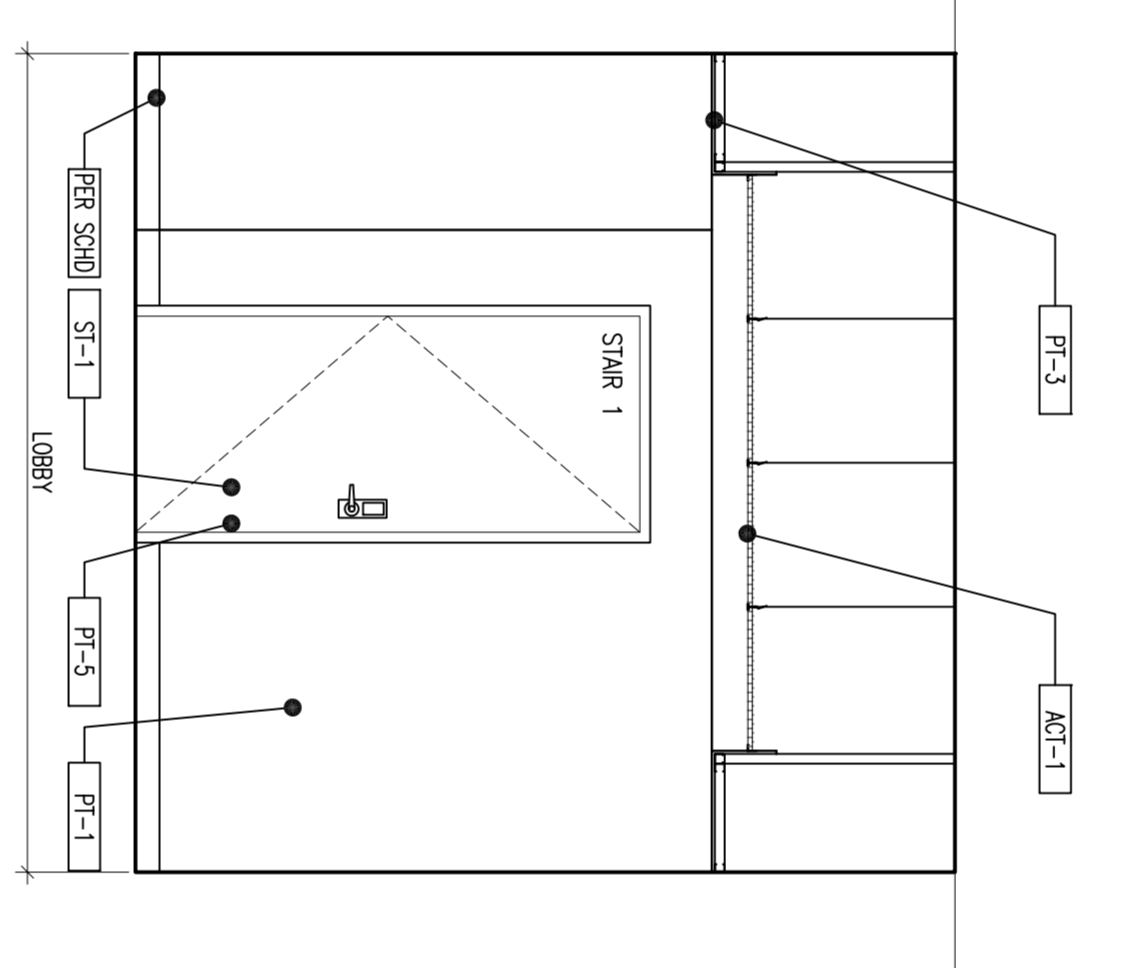


TYPICAL LOBBY - 12TH FLOOR
 ELEVATION
 SCALE: 3/8" = 1'-0"

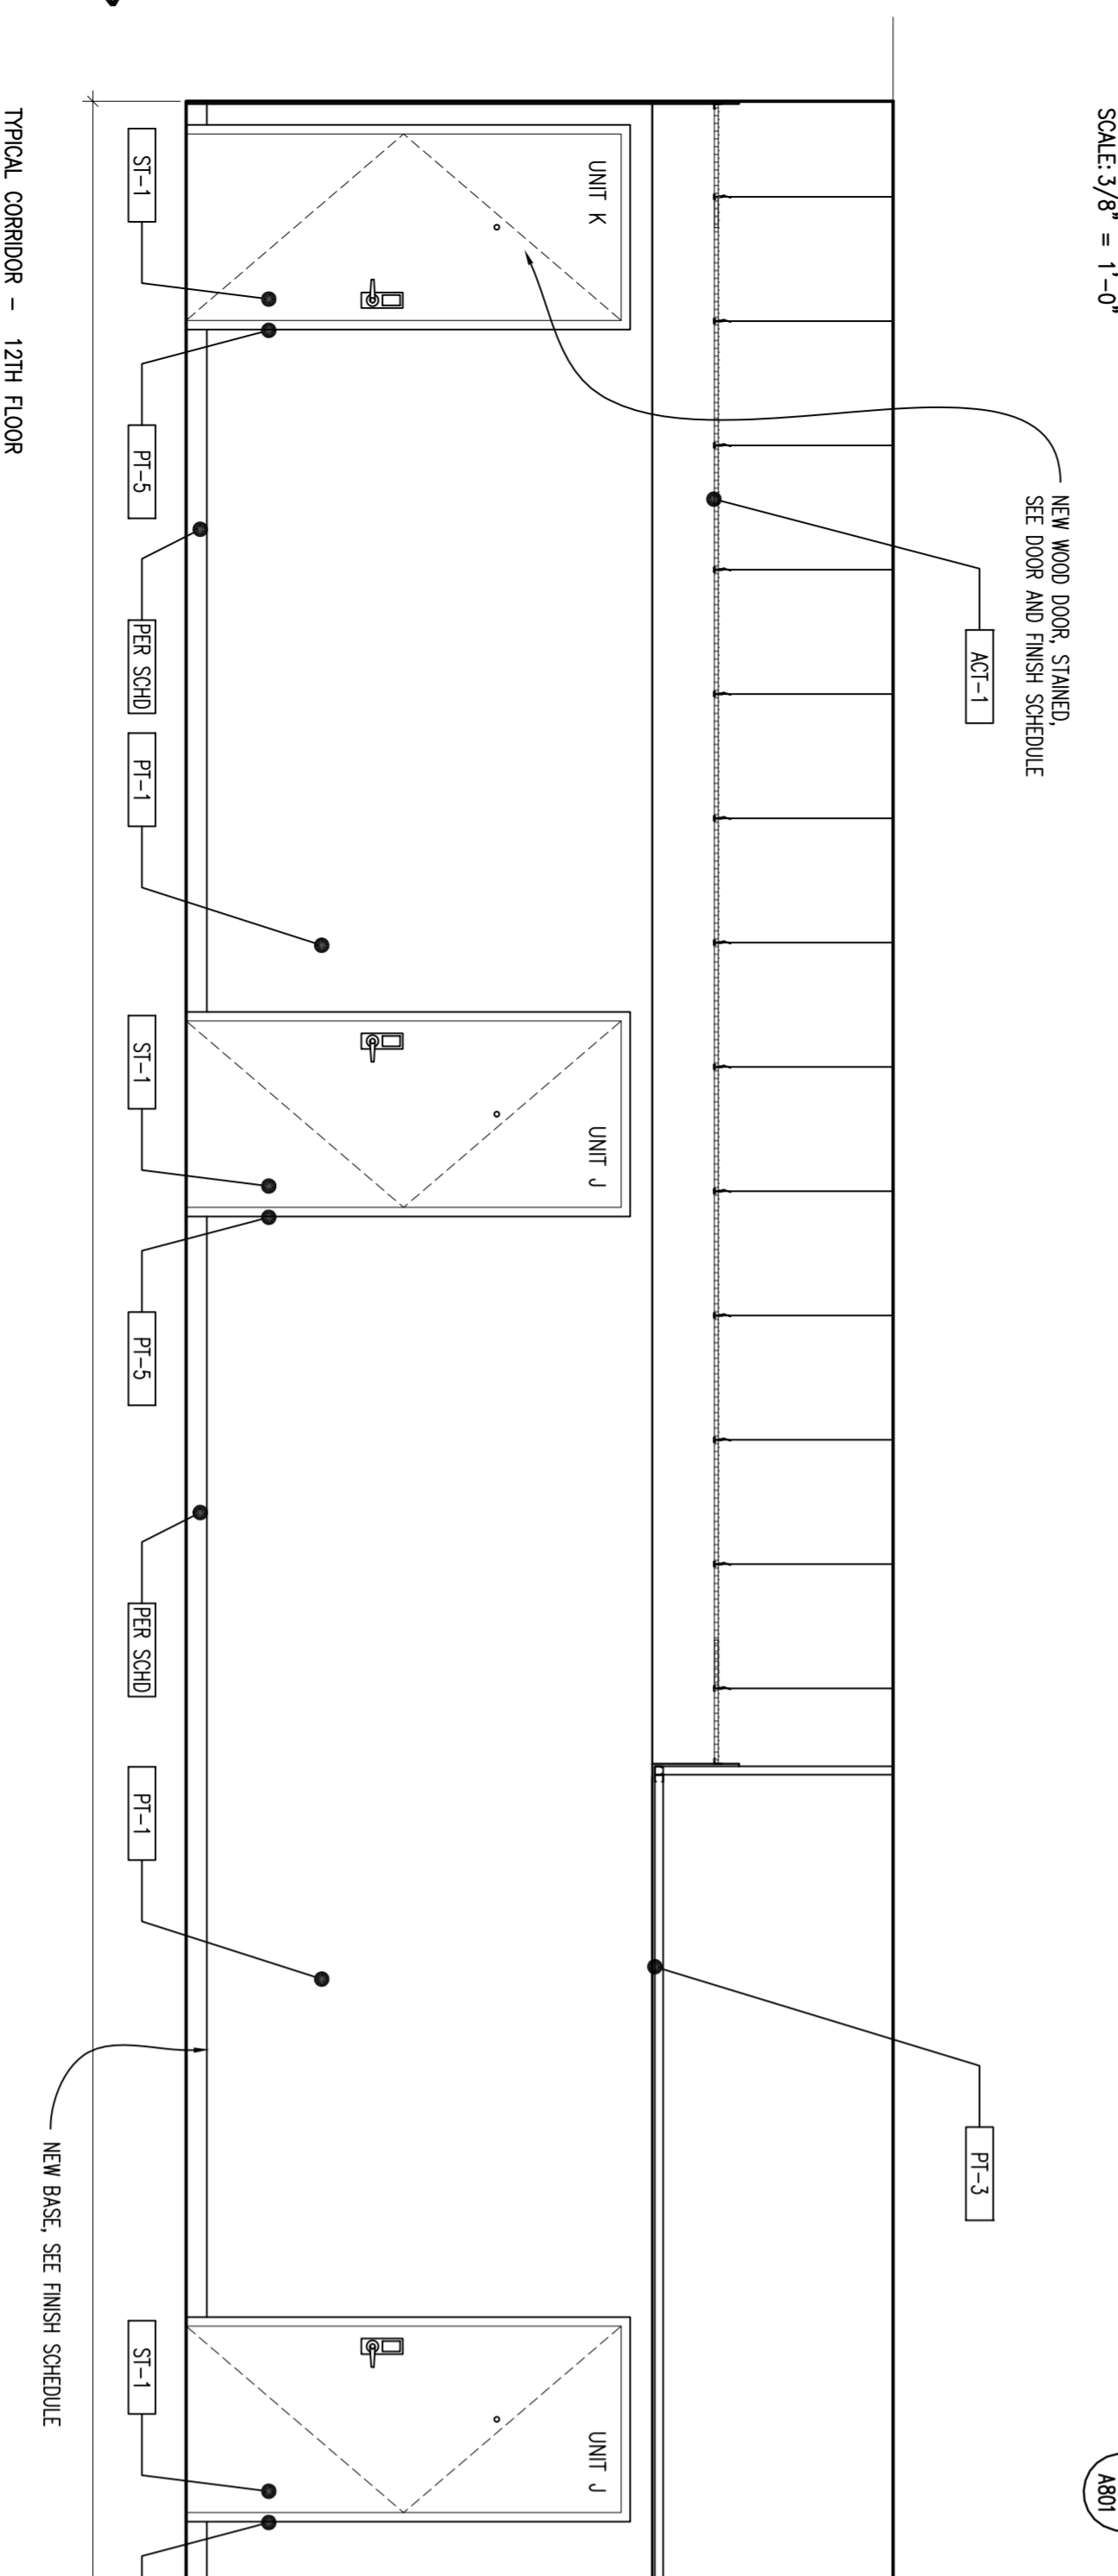


TYPICAL CORRIDOR - 12TH FLOOR
 ELEVATION
 SCALE: 3/8" = 1'-0"

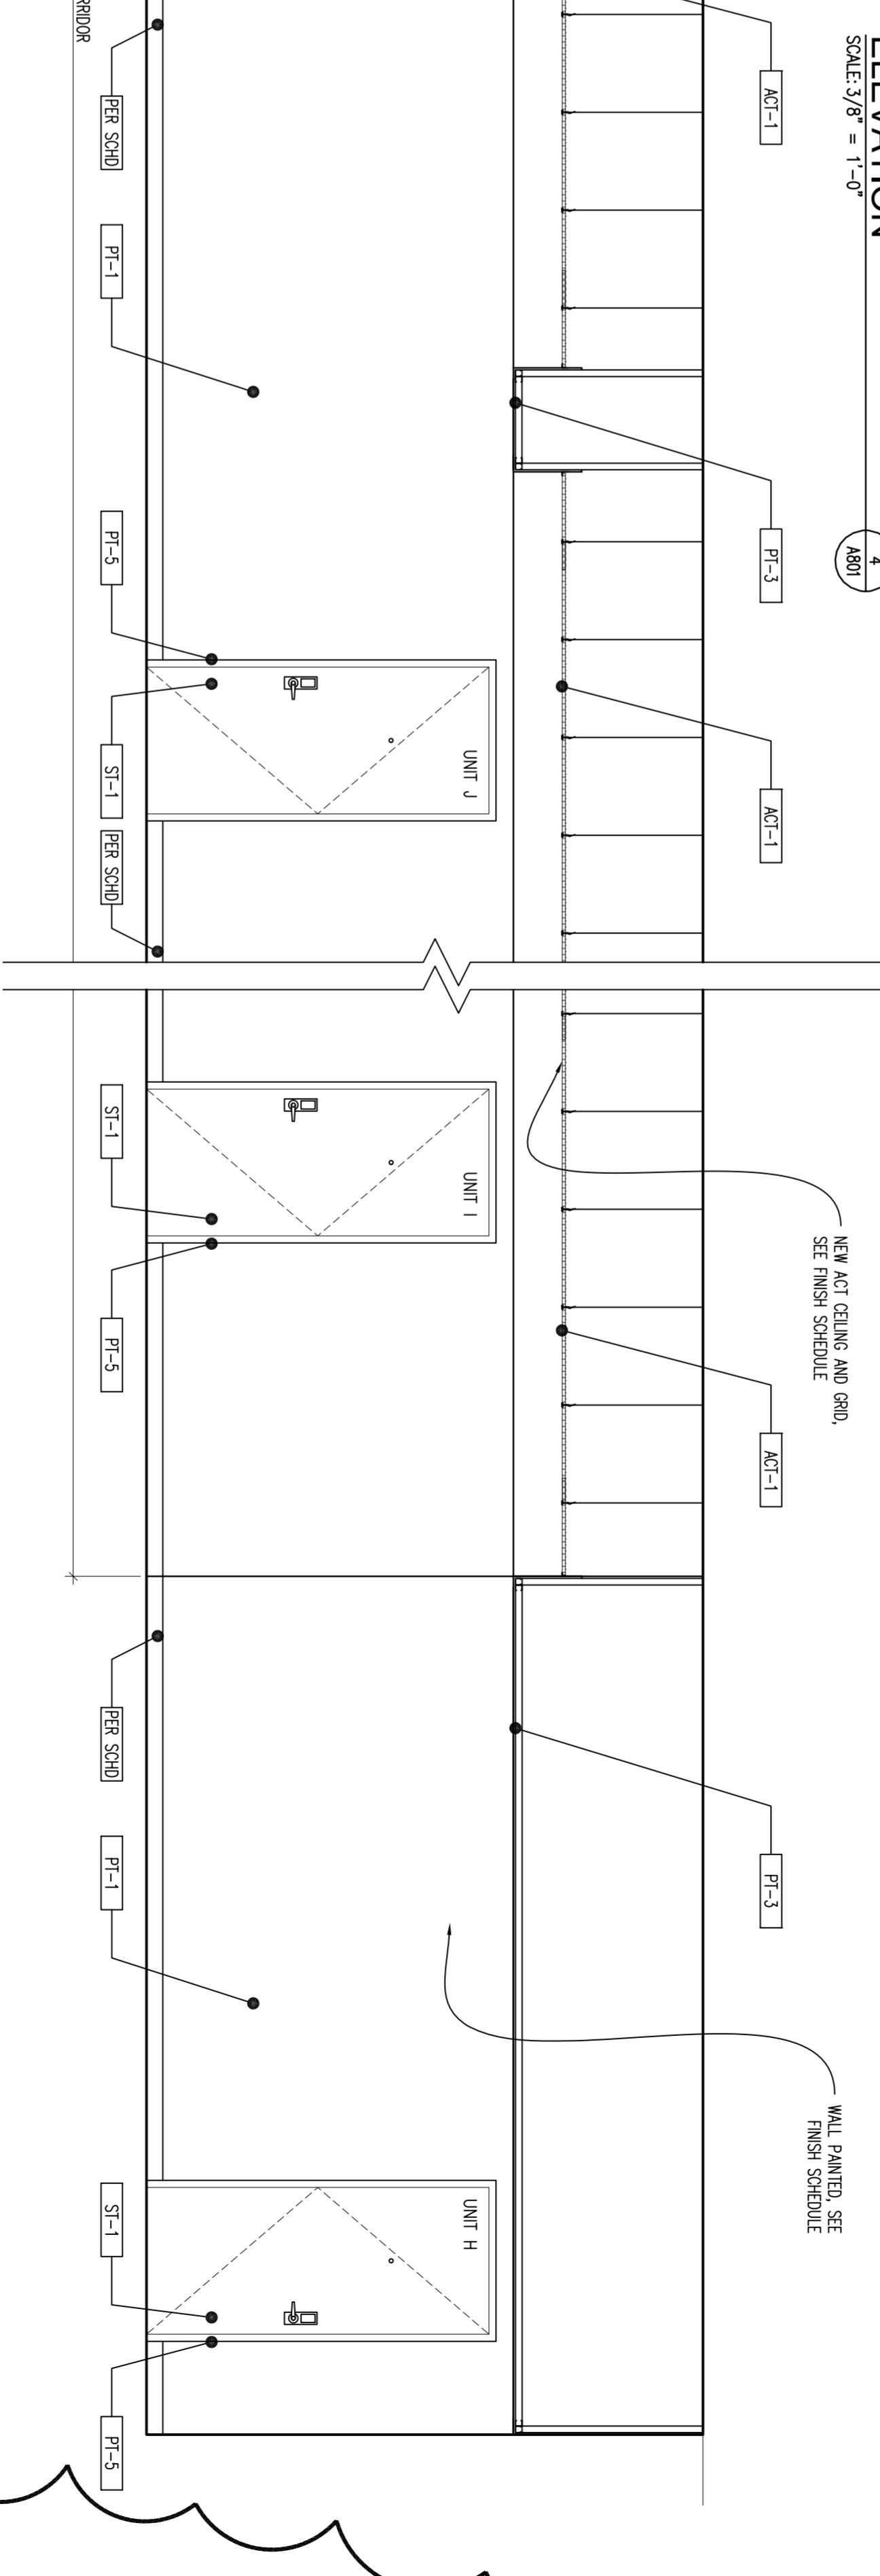

TYPICAL CORRIDOR - 12TH FLOOR
 ELEVATION
 SCALE: 3/8" = 1'-0"

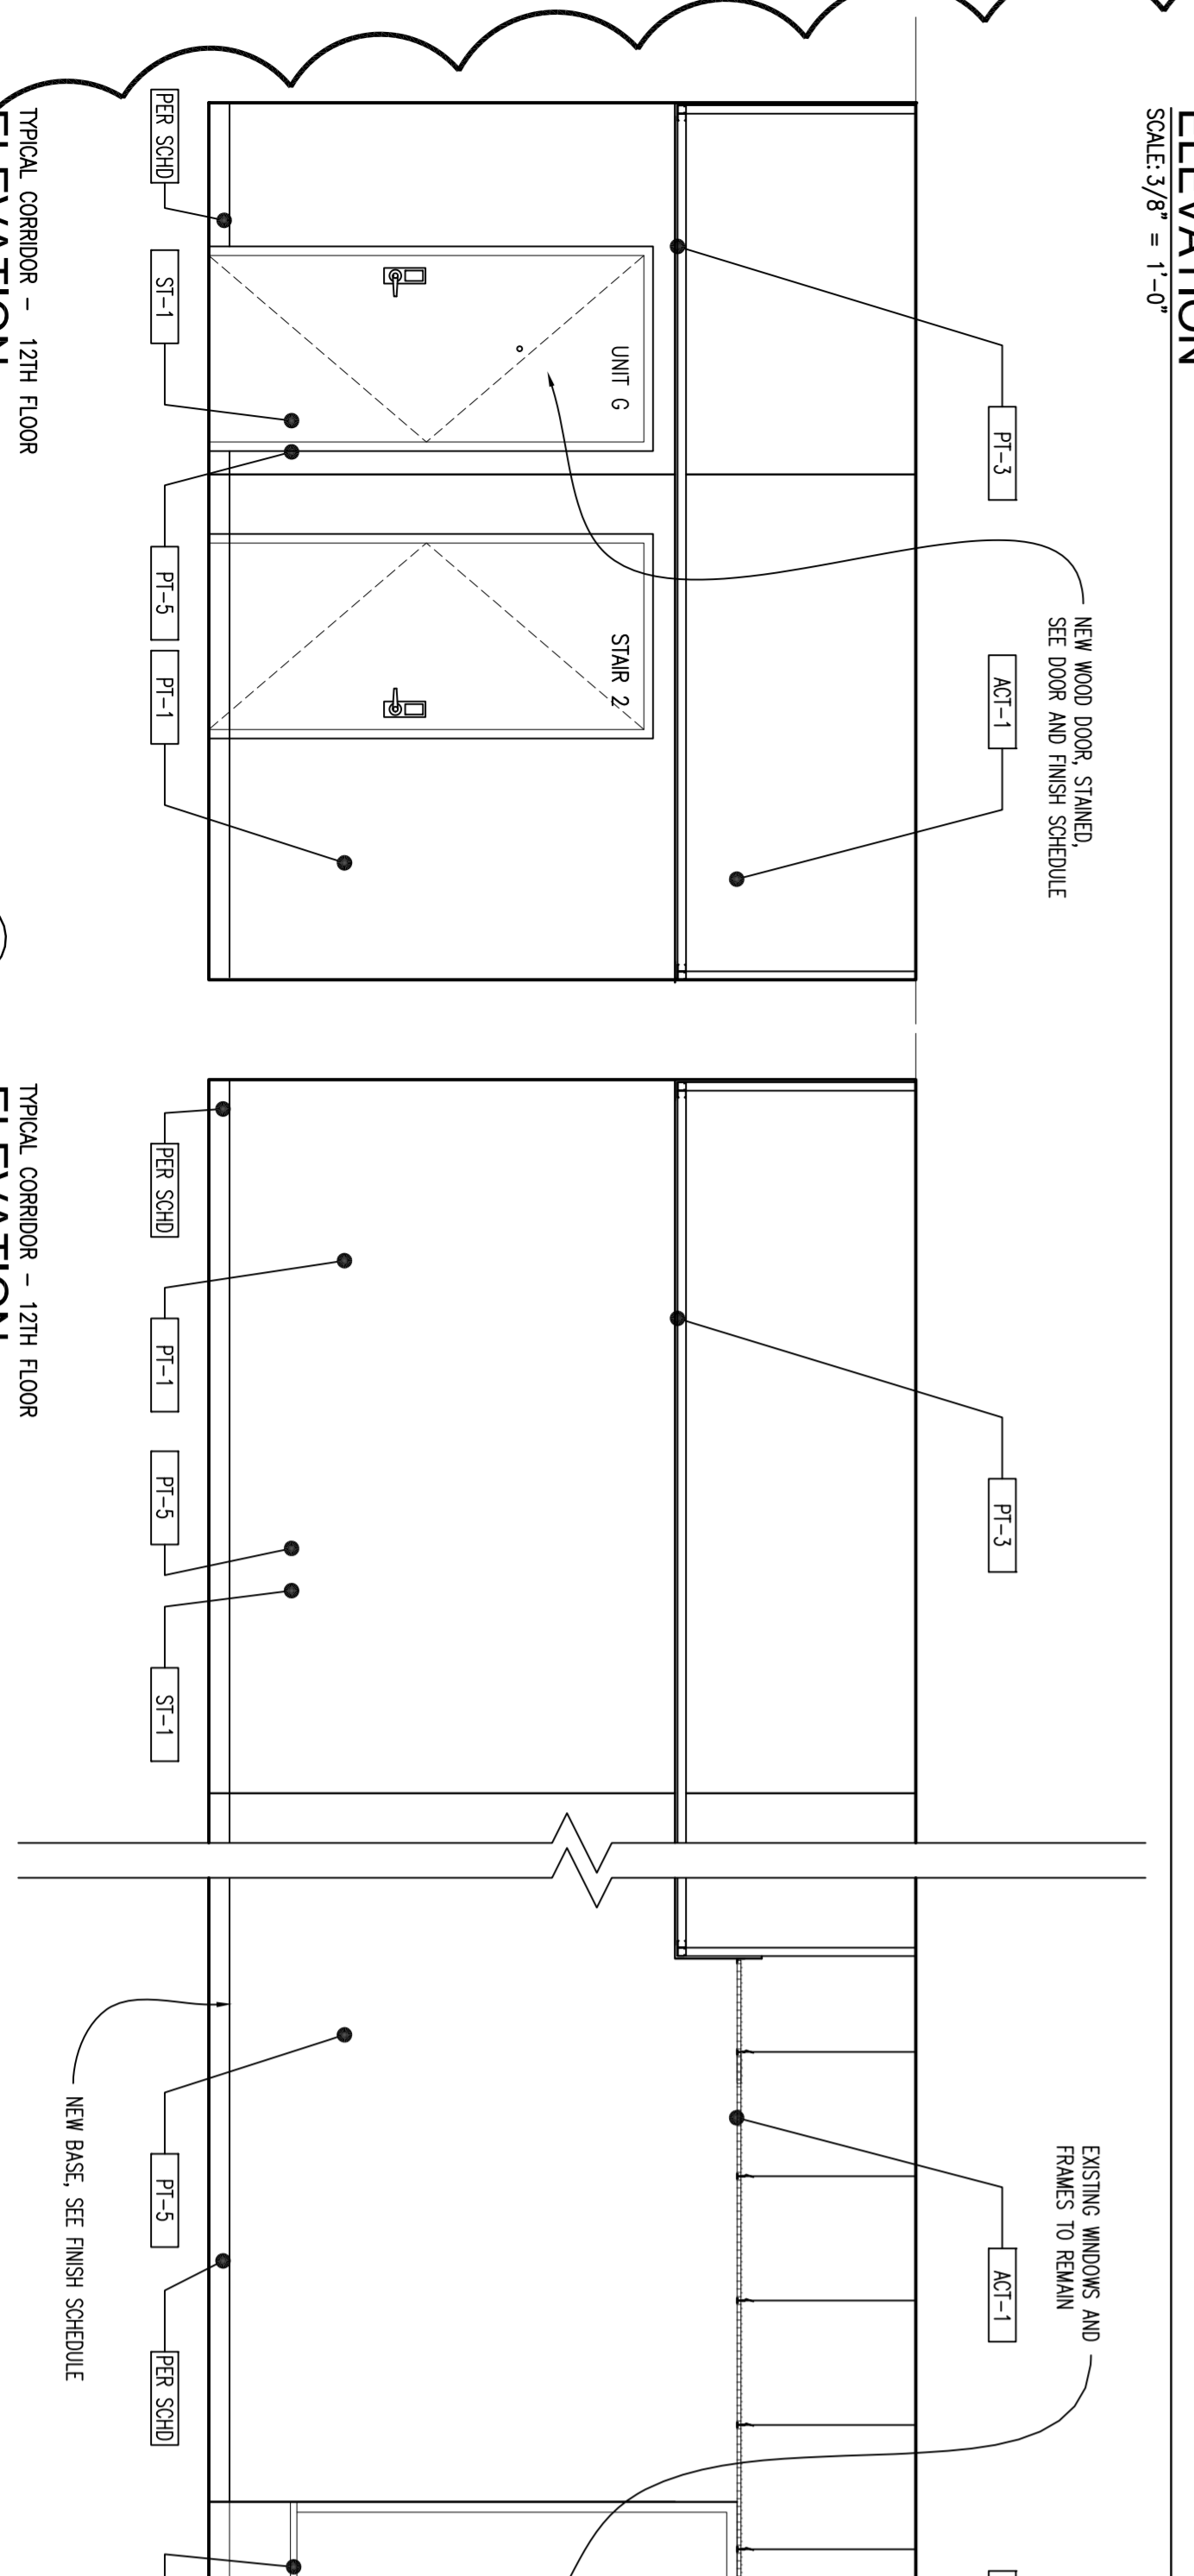

TYPICAL CORRIDOR - 12TH FLOOR
 ELEVATION
 SCALE: 3/8" = 1'-0"

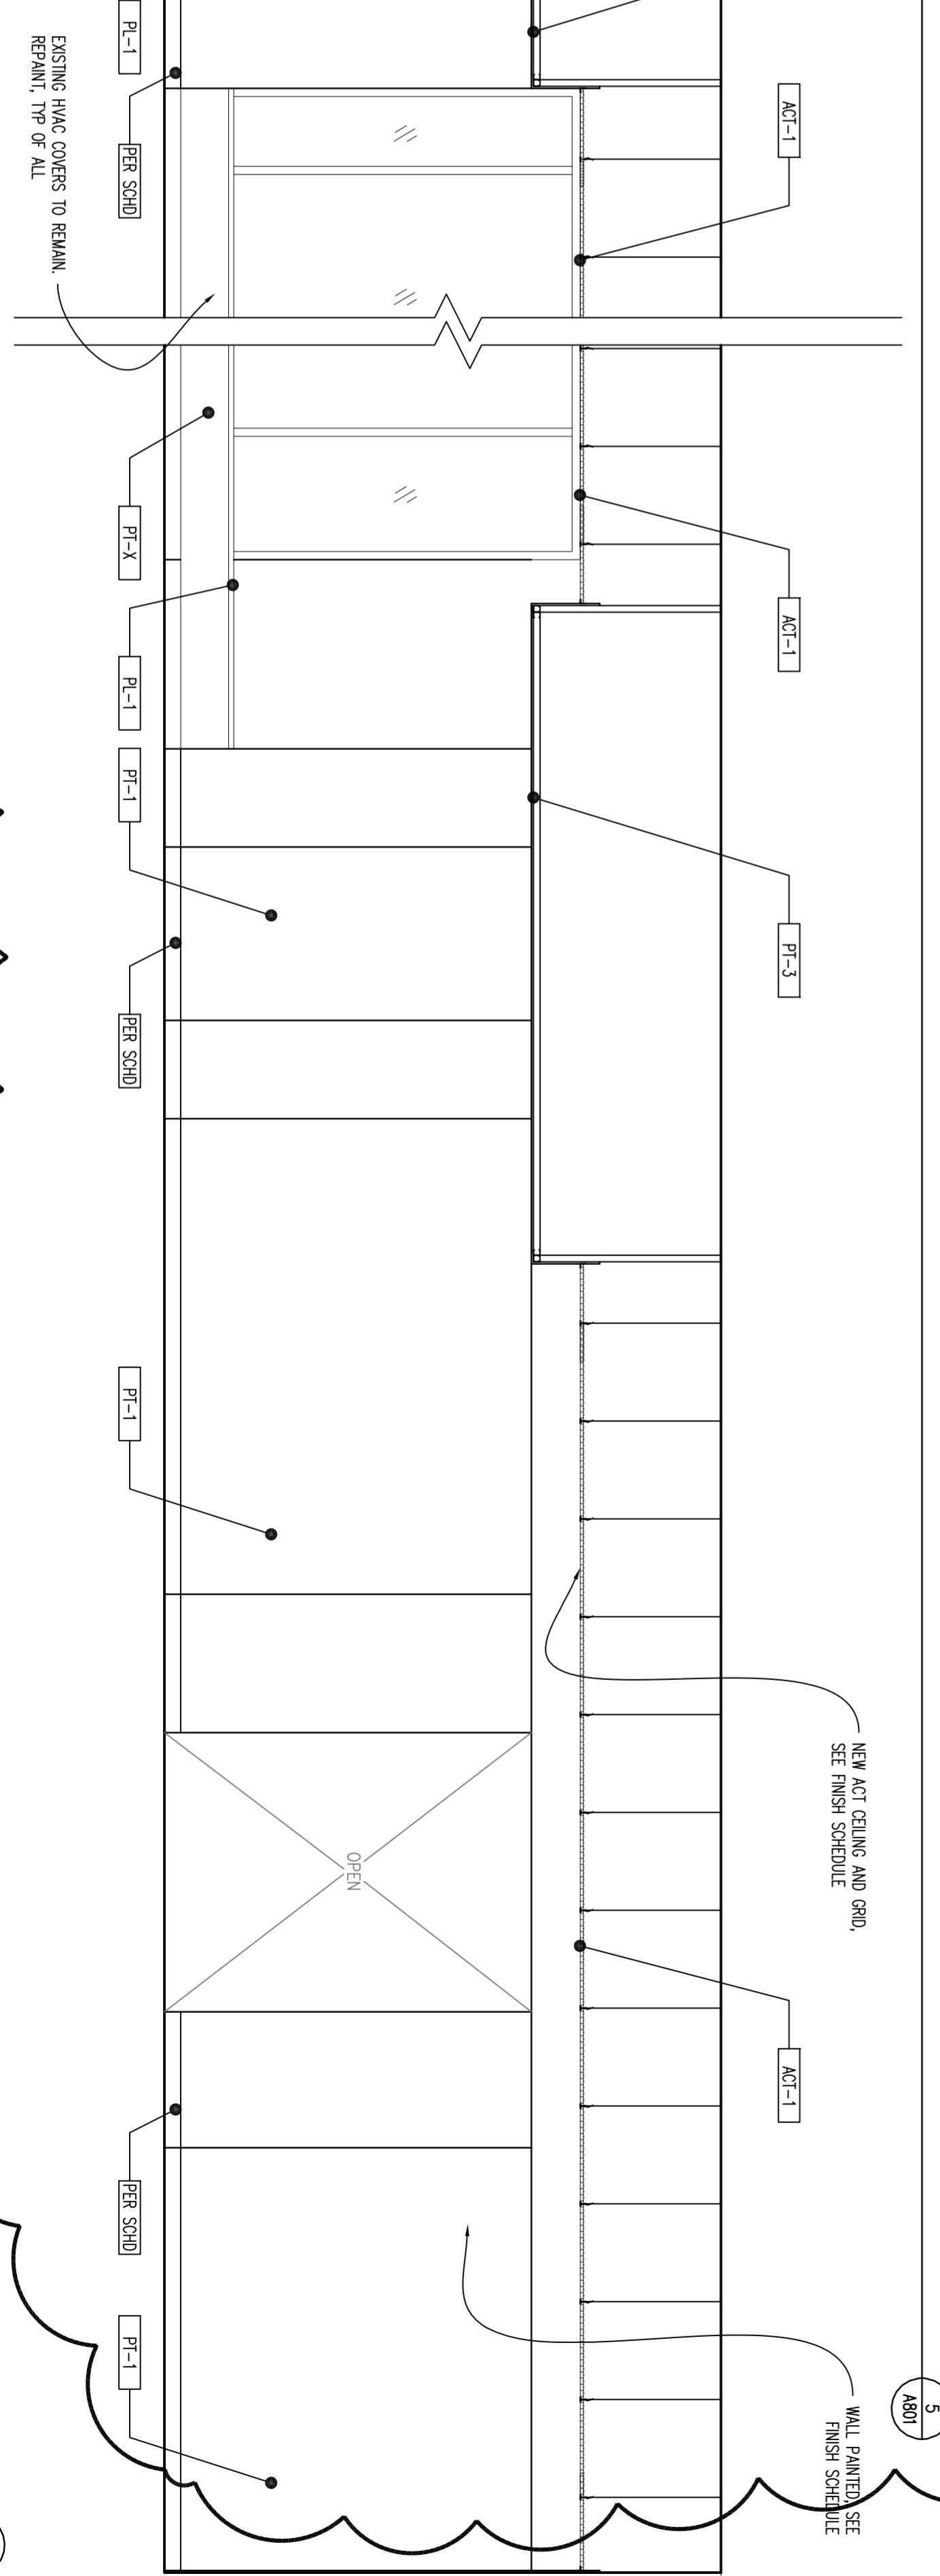


TYPICAL CORRIDOR - 12TH FLOOR
 ELEVATION
 SCALE: 3/8" = 1'-0"


- GENERAL ELEVATION NOTES:**
- SEE FINISH SCHEDULE FOR ALL FINISHES.
 - ALL EXISTING WALL CHUTES TO REMAIN, PROTECT DURING CONSTRUCTION.
 - ALL EXISTING ELEVATOR CABS/STAIRS TO REMAIN, PROTECT DURING CONSTRUCTION.
 - ALL EXISTING WINDOW FRAMES AND GLASS ARE TO REMAIN, PROTECT DURING CONSTRUCTION.
 - ALL EXISTING WINDOW FRAMES AND GLASS ARE TO REMAIN, PROTECT DURING CONSTRUCTION.

A802	Project	Formica Building	
	115. E 5th Street	No. Revisions	Date
	Cincinnati, Ohio 45202	2	ENG CHG #1 11.14.2022
	Sheet Title	INTERIOR ELEVATIONS - Common Apartment Hallways Construction	
	Project No. 2022_259	Issue Date	
	Scale: As Noted	Drawn	Checked



Formica Building
 Office/Apartments
 Auditor Address: 115 E. 5th Street, Actual Address: 120 E. 4th Street
 Cincinnati OH 45202

modelgroup
 DEVELOPMENT • CONSTRUCTION • MANAGEMENT
 1826 Race Street
 Cincinnati, Ohio 45202
 513.559.0048

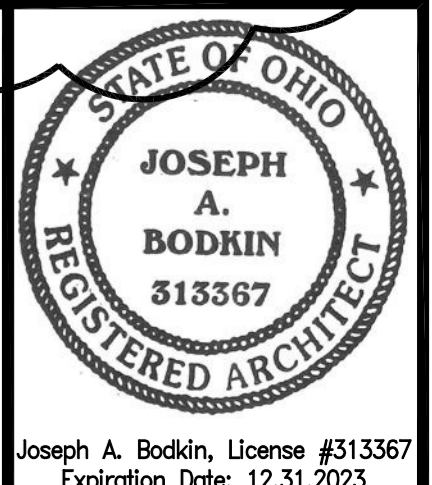

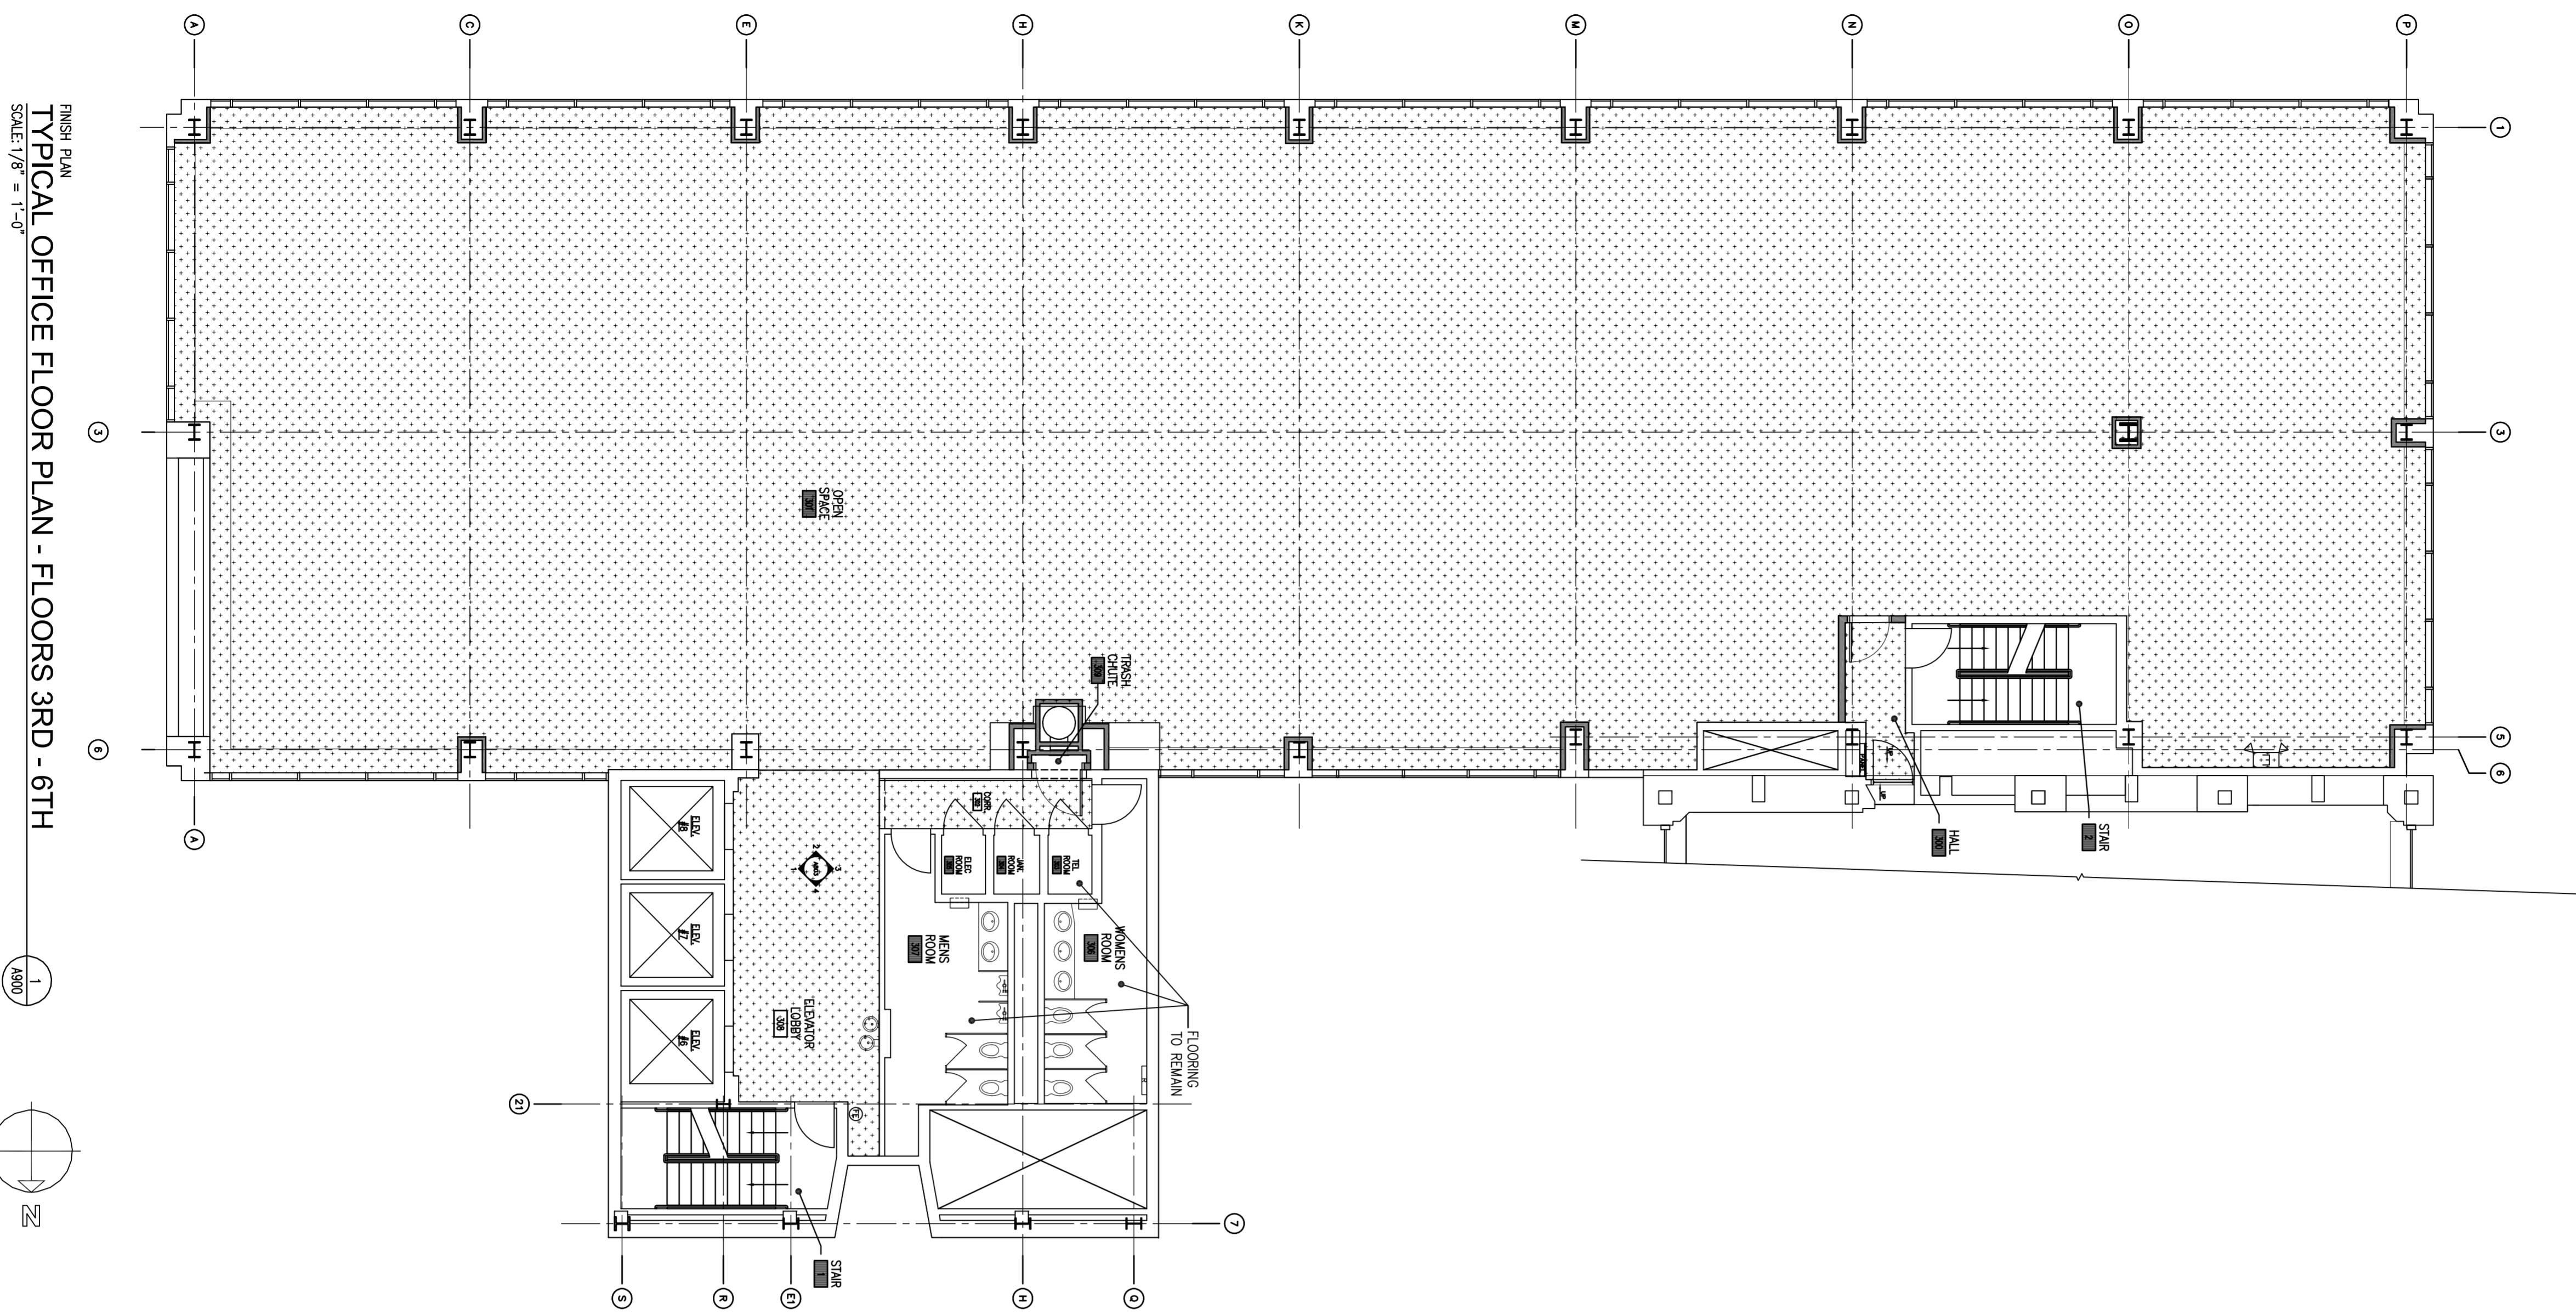

FINISH PLAN
TYPICAL OFFICE FLOOR PLAN - FLOORS 3RD - 6TH
 SCALE: 1/8" = 1'-0"

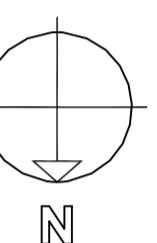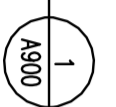

- GENERAL FINISH NOTES:**
- A. IN ALL STAIRWELLS CLEAN, SCRUB, PRIME AND PAINT ALL HANDRAILS, STRINGER, RISERS & TREAD NOSING. COLOR TBD
 - B. IN ALL STAIRWELLS CLEAN, SCRUB, PRIME AND PAINT ALL TREADS W/ ANTI SLIP PAINT. COLOR TBD
 - C. ALL EXISTING CONCRETE FLOORS ARE TO BE CLEANED OF ALL ADHESIVES DOWN TO ORIGINAL CONCRETE SURFACE.

TYPICAL OFFICE FLOOR (3-6) COMMON AREA - FINISH SCHEDULE

ROOM MARK	ROOM NAME	FLOOR	BASE	WALLS				CEILING	REMARKS	REV. NO.
				NORTH	SOUTH	EAST	WEST			
300	HALL (STAR #2)	EX	EX	PT-1	PT-1	PT-1	PT-1	PT-3		
301	OFFICE-SPACE	CONC.	RB-1	PT-1	PT-1	PT-1	PT-1	ACT-2		
302	CORRIDOR	CONC.	RB-1	PT-1	PT-1	PT-1	PT-1	PT-3 / ACT-1		
303	TEL ROOM	CONC.	RB-2	PT-1	PT-1	PT-1	PT-1	PT-3		
304	JANITOR ROOM	CONC.	RB-2	PT-1	PT-1	PT-1	PT-1	---		
305	ELECTRIC ROOM	CONC.	RB-2	PT-1	PT-1	PT-1	PT-1	---		
306	WOMEN'S ROOM	EX	EX	PT-1	PT-1	PT-1	PT-1	---		
307	MEN'S ROOM	EX	EX	PT-1	PT-1	PT-1	PT-1	---		
308	ELEVATOR LOBBY	CONC.	RB-1	PT-1	PT-1	PT-1	PT-1	PT-3 / ACT-1		
	STAR #2	EX	EX	PT-1	PT-1	PT-1	PT-1	PT-3		


MATERIALS SCHEDULE

CODE	MATERIAL	MANUF.	NUMBER	DESCRIPTION	SIZE	REMARKS	LOCATION
ACT-1	ACOUSTICAL CEILING TILE	ARMSTRONG	266	BRIGHTON	24" X 24" 15/16" GRID		PER DWGS
ACT-2	ACOUSTICAL CEILING TILE	ARMSTRONG	266	BRIGHTON	24" X 48" 15/16" GRID		PER DWGS
LVT-1	VINYL TILE	LG HAUSTIS	TBD	PIKES PEAK	12" X 24"	RAIN IN DIRECTION SHOWN ON DWGS	PER DWGS
CT-1	CERAMIC TILE	DAL-TILE	TBD	DAL-TILE	12" X 12"	GROUP: TBD	PER DWGS
CTB-1	CERAMIC TILE	DAL-TILE	TBD	DAL-TILE	12" X 12"	GROUP: TBD	PER DWGS
CONC	CONCRETE			POLISHED & SEALED CONCRETE		CLEAN ALL ADHESIVES TO BARE SURFACE	PER DWGS
RB-1	RUBBER BASE	FLEXCO	TBD	FLEXCO	4-1/2" H		PER DWGS
RB-2	RUBBER BASE	FLEXCO	TBD	FLEXCO	4-1/2" H		PER DWGS
PT-1	PAINT	SHERWIN WILLIAMS	TBD	SHERWIN WILLIAMS	N/A		PER DWGS
PT-2	PAINT	SHERWIN WILLIAMS	TBD	SHERWIN WILLIAMS	N/A		PER DWGS
PT-3	PAINT	SHERWIN WILLIAMS	SW 7000	SHERWIN WILLIAMS	FINISH: FLAT		PER DWGS
ST-1	STAIN	SHERWIN WILLIAMS	SW	SHERWIN WILLIAMS	N/A		DOORS
VCT-1	VINYL COMPOSITION TILE	ARMSTRONG	51839	FORTESS WHITE	12" X 12"		SUPPORT SPACES
QTZ-1	QUARTZ	TBD	TBD	TBD	V.I.F.		APARTMENT KITCHENS & BATHS COUNTERTOPS
PL-1	PLASTIC LAMINATE	FORMICA	TBD	TBD	V.I.F.		RADIATOR COVERS, TYP OF ALL U.N.O.


A900	Project	Formica Building		
		115 E. 5th Street		
		Cincinnati, Ohio 45202	No. Revisions	Date
		2	ENG CHG #1	11.14.2022
	Sheet Title	TYPICAL OFFICE FLOOR (3 - 6)		
	FINISH PLAN			
Project No.	2022_259	Issue Date		
Scale	As Noted	Drawn	Checked	

Formica Building
 Office/Apartments
 Auditor Address: 115 E. 5th Street, Actual Address: 120 E. 4th Street
 Cincinnati OH 45202




modelgroup
 DEVELOPMENT • CONSTRUCTION • MANAGEMENT
 1826 Race Street
 Cincinnati, Ohio 45202
 513.559.0048

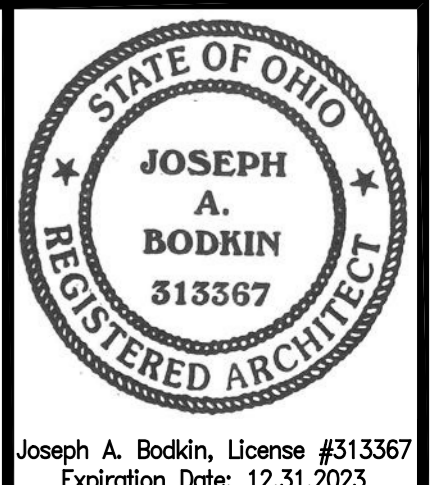

FINISH PLAN
TYPICAL RESIDENTIAL FLOOR PLAN - FLOORS 7TH - 10TH
 SCALE: 1/8" = 1'-0"

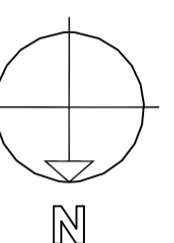

TYPICAL OF ALL
ENLARGED CORRIDOR FINISH PLAN
 SCALE: 1/4" = 1'-0"

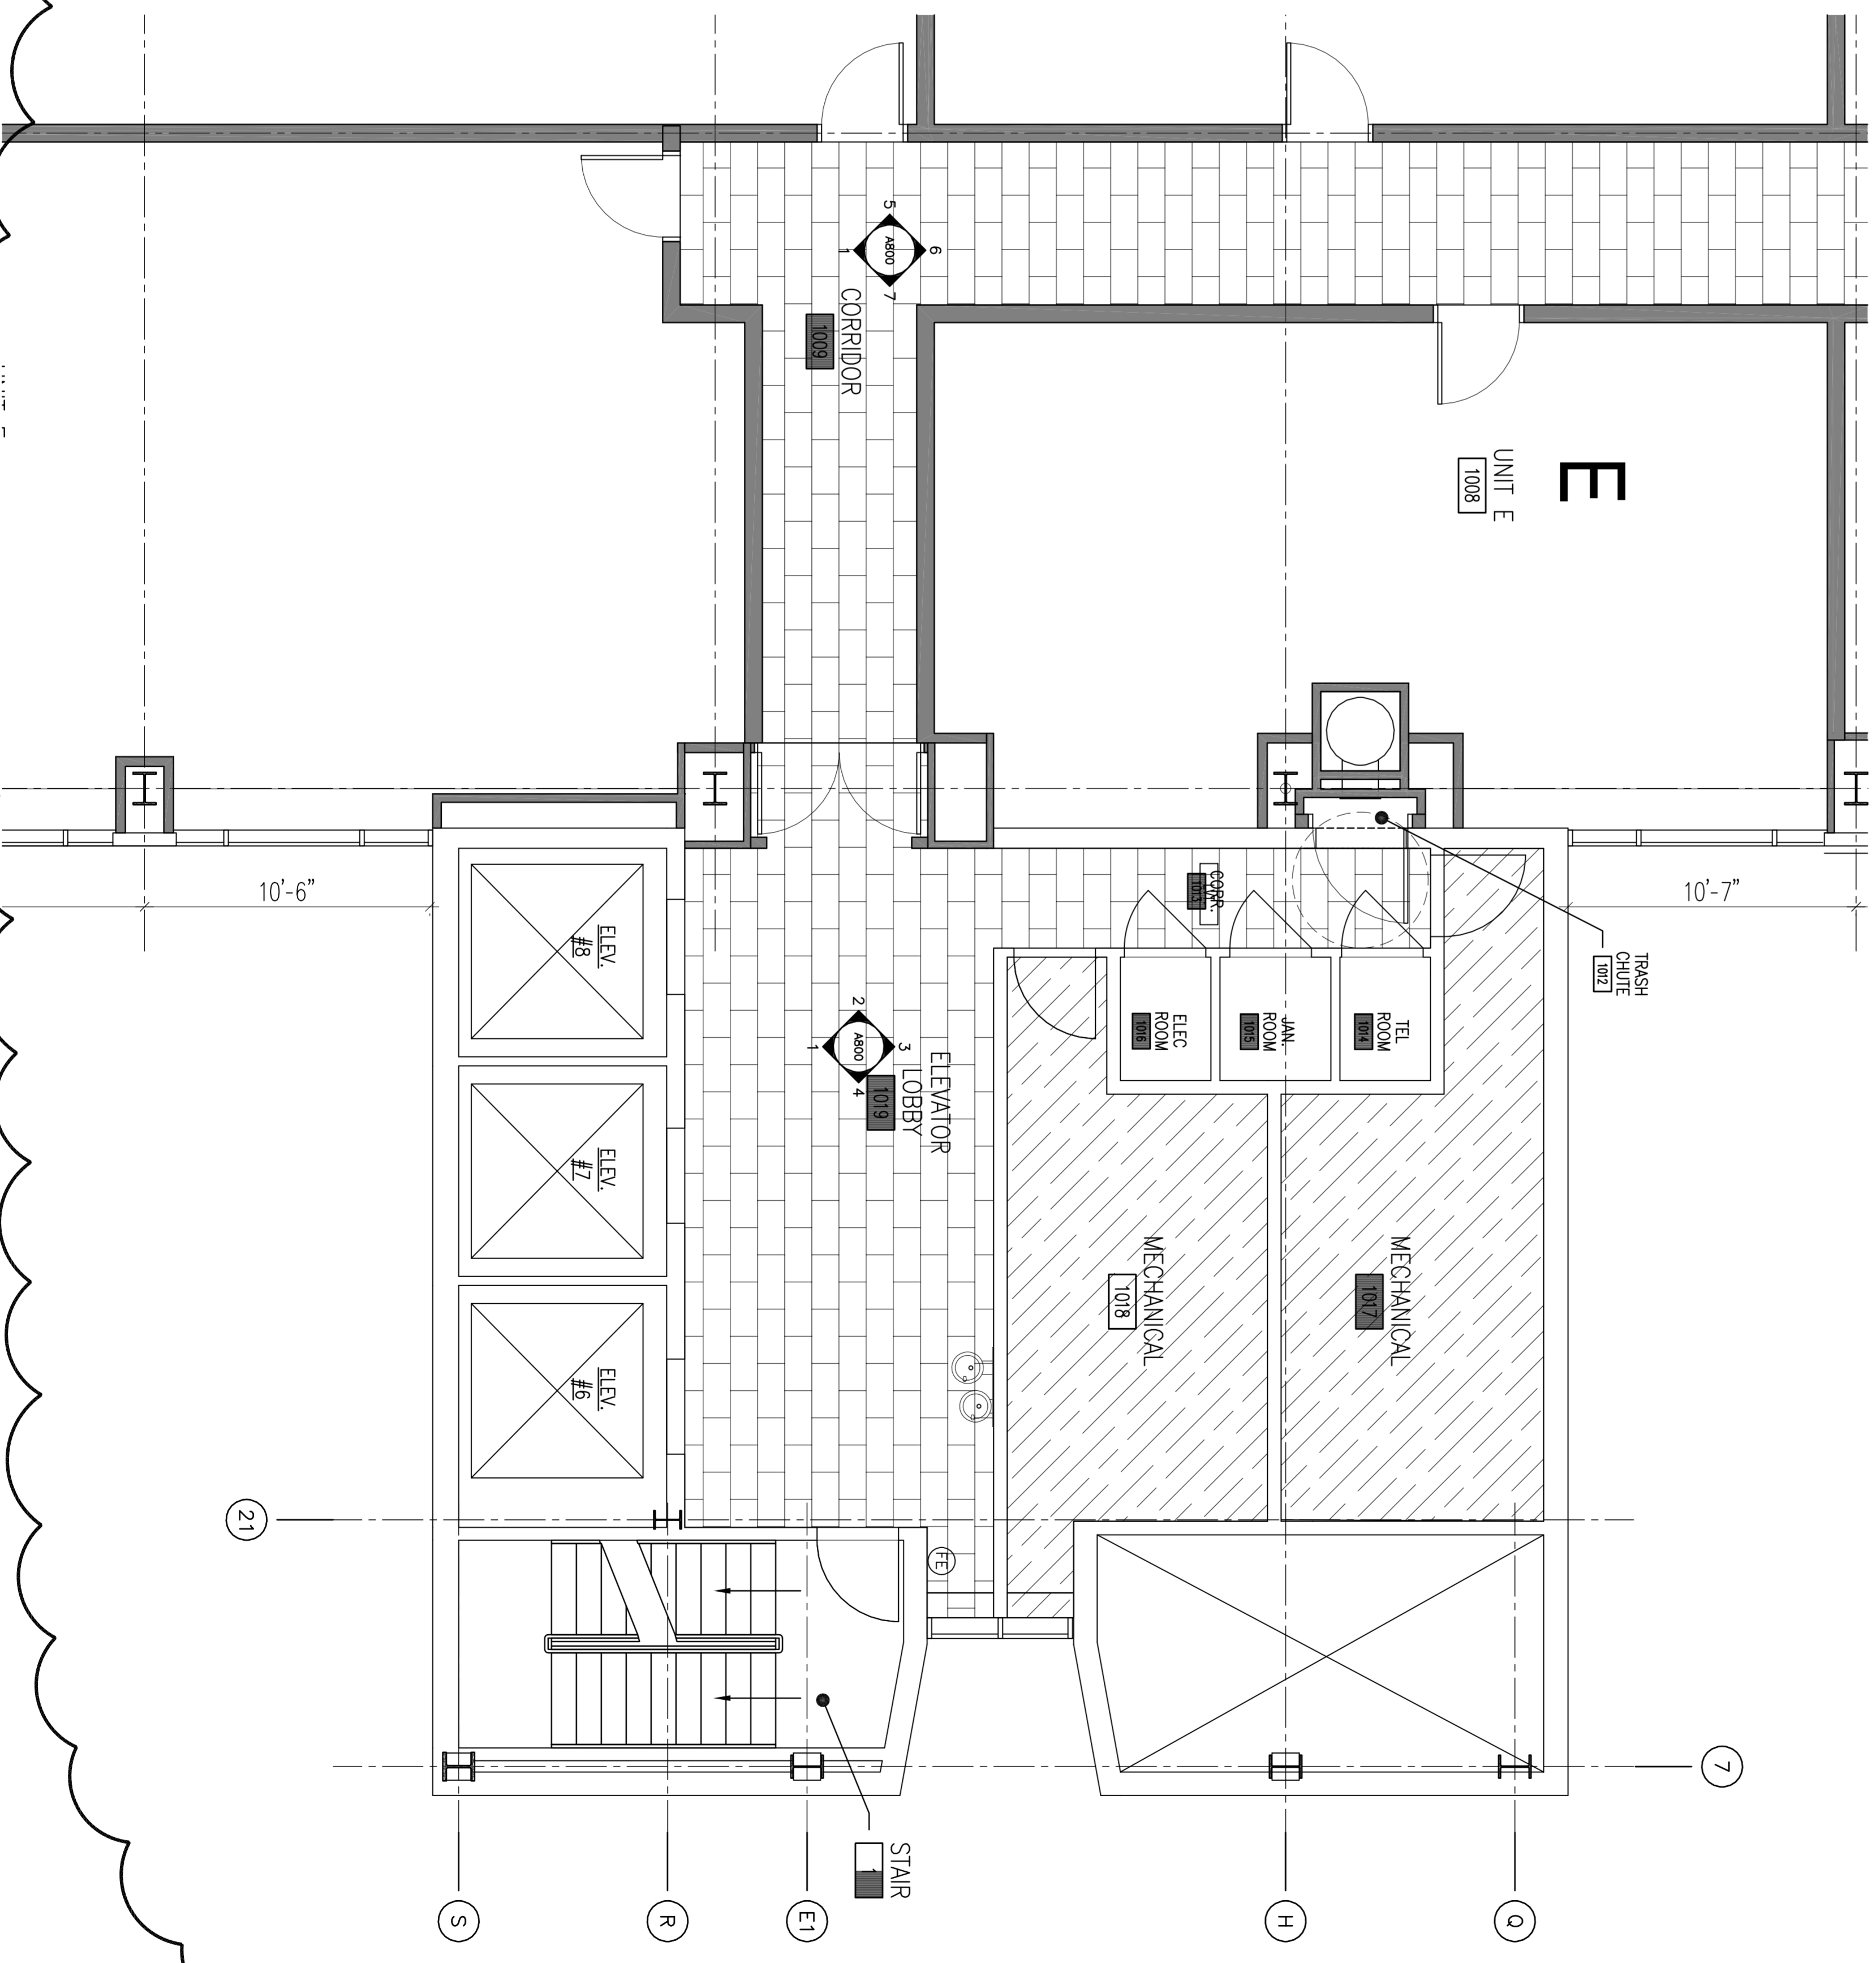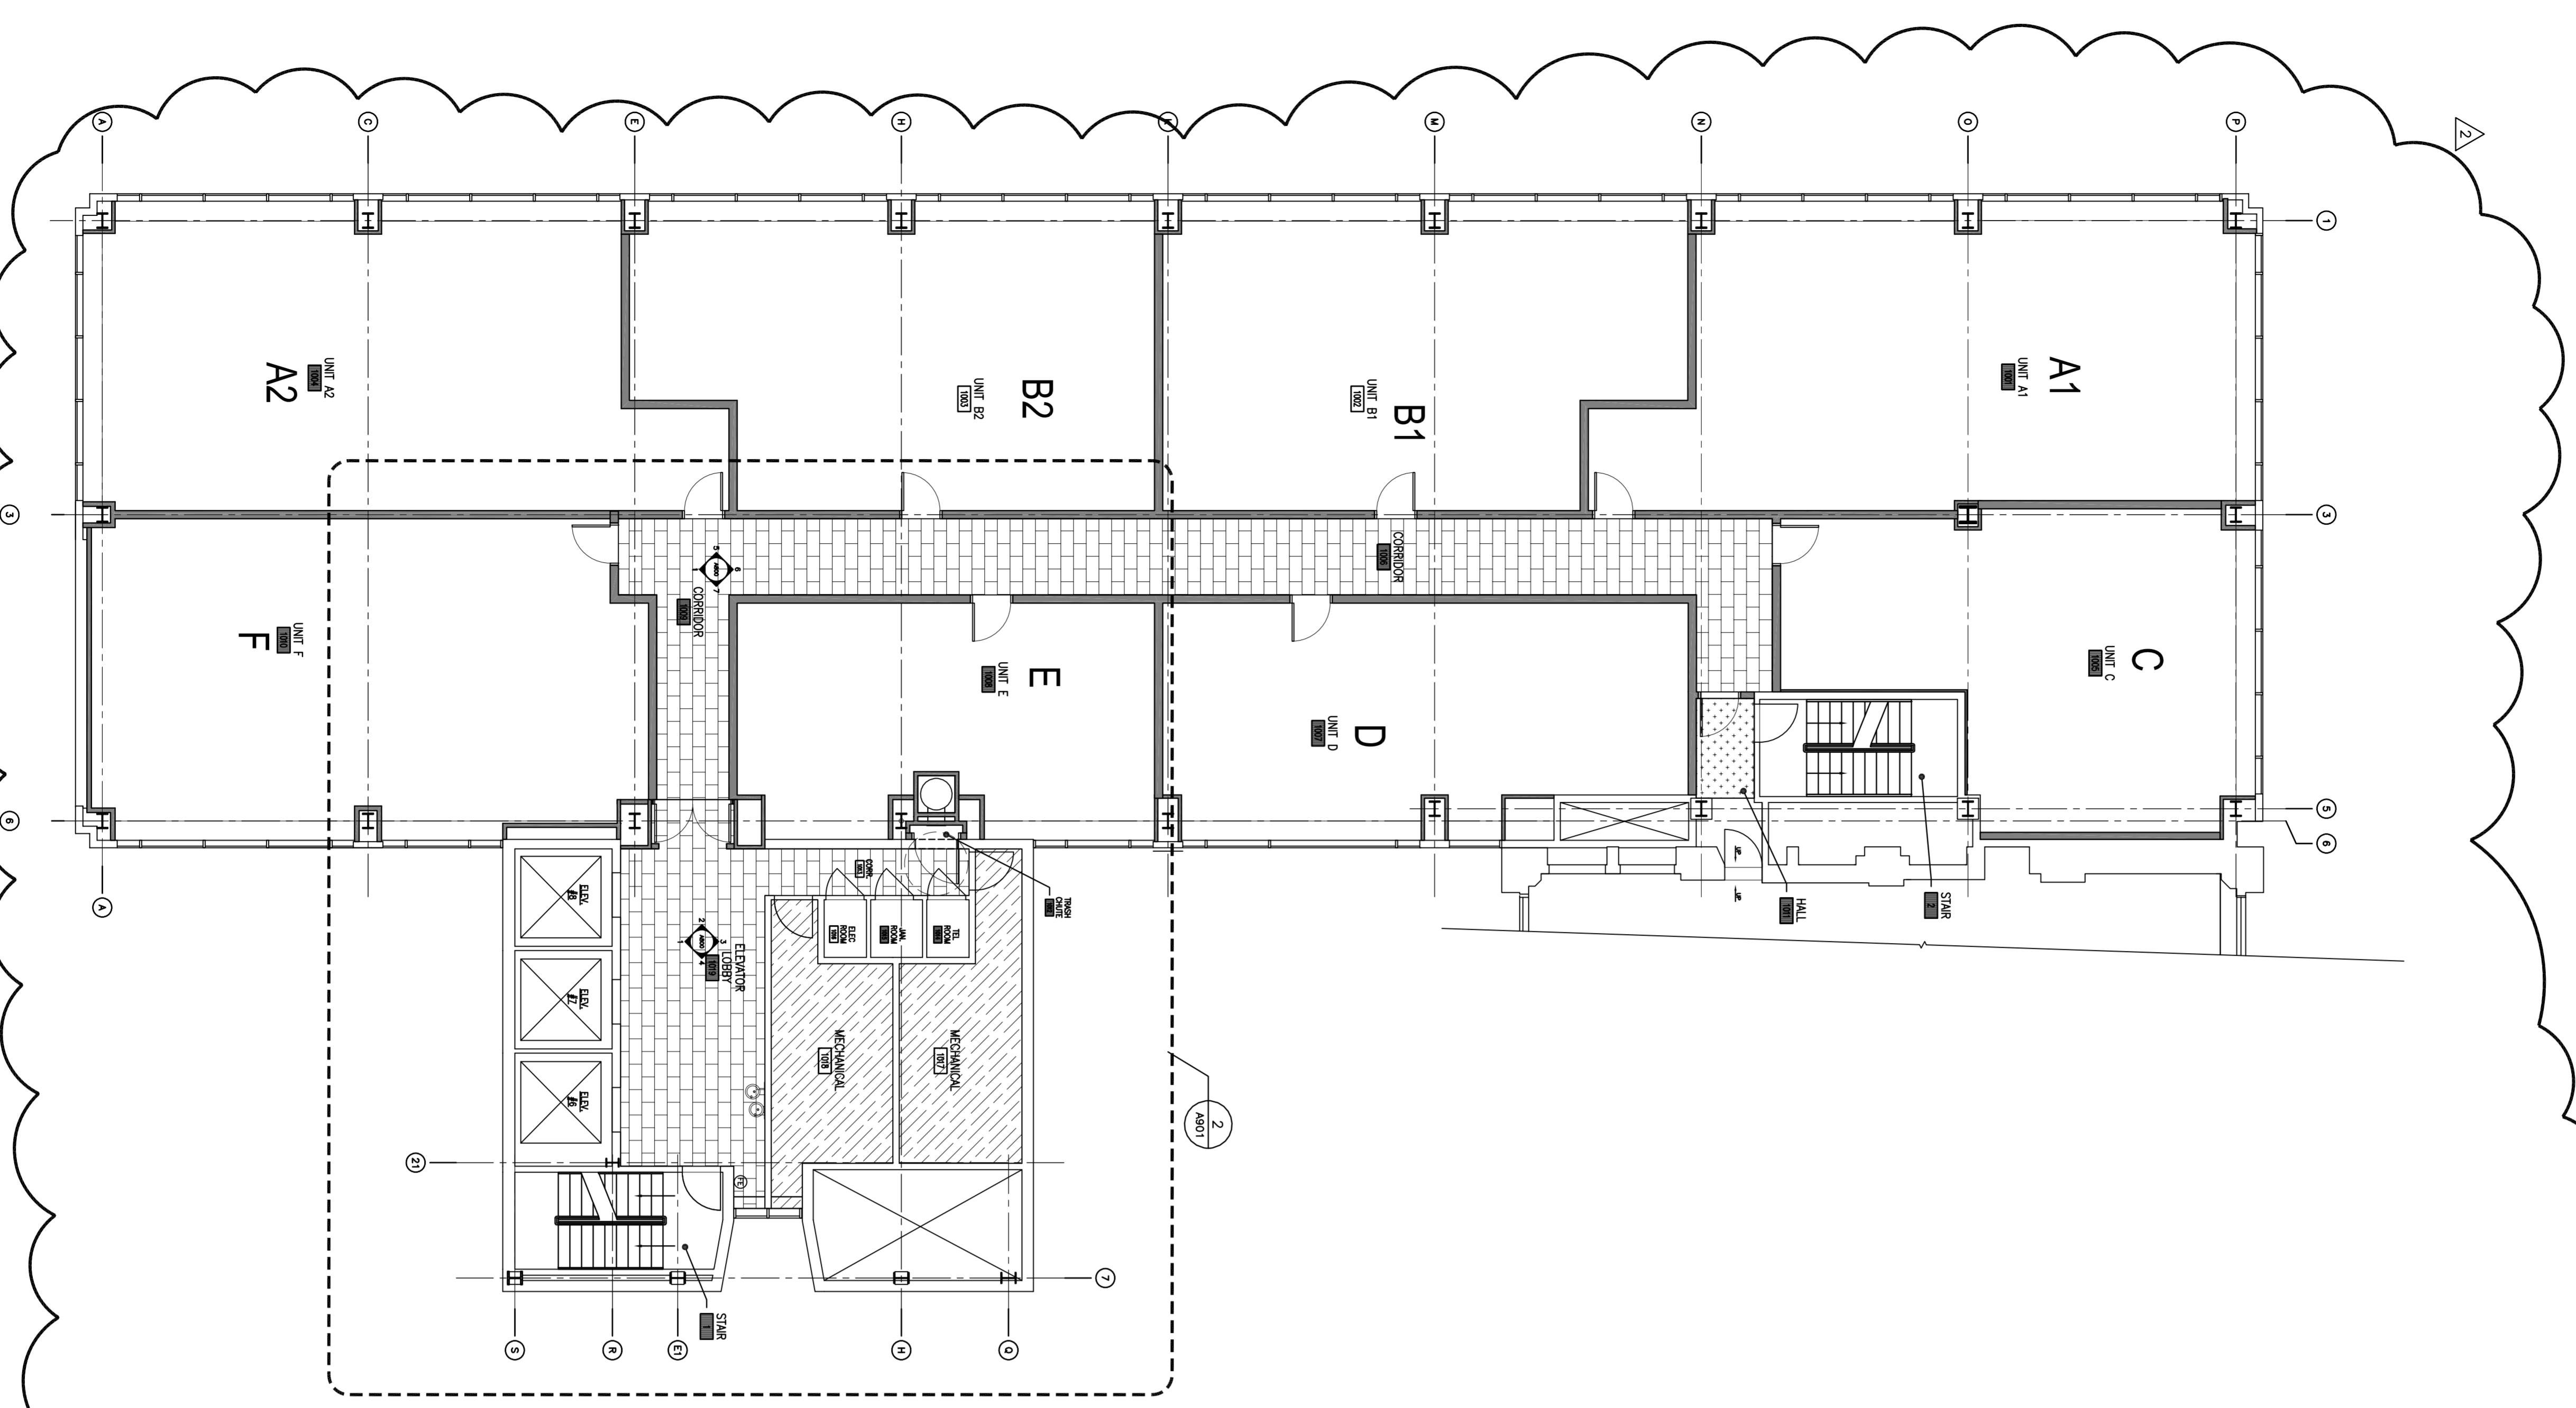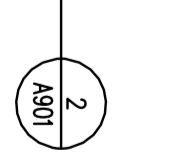

TYPICAL RESIDENTIAL FLOOR (6-10) COMMON AREA - FINISH SCHEDULE


ROOM MARK	ROOM NAME	FLOOR	BASE	WALLS				CEILING	REMARKS	REV. NO.
				NORTH	SOUTH	EAST	WEST			
1006	CORRIDOR	LVF-1	RB-1	PF-1	PF-1	PF-1	PF-1	PF-3 / ACI-1		
1009	STAIR #1	EX	EX	PF-1	PF-1	PF-1	PF-3			
1011	HALL (STAIR #2)	CONC.	RB-1	PF-1	PF-1	PF-1	PF-3			
1012	TRASH CHUTE	CONC.	RB-2	PF-1	PF-1	PF-1	PF-3			
1013	CORRIDOR	LVF-1	RB-1	PF-1	PF-1	PF-1	PF-3 / ACI-1			
1014	TEL. ROOM	CONC.	RB-2	PF-1	PF-1	PF-1	PF-3			
1015	JANITOR ROOM	CONC.	RB-2	PF-1	PF-1	PF-1	PF-3			
1016	ELECTRIC ROOM	EX	EX	PF-1	PF-1	PF-1	EXPOSED			
1017	MECHANICAL	EX	EX	PF-1	PF-1	PF-1	EXPOSED			
1018	ELEVATOR LOBBY	LVF-1	RB-1	PF-1	PF-1	PF-1	PF-3 / ACI-1			
1019	STAIR #2	EX	EX	PF-1	PF-1	PF-1	PF-3			

- GENERAL FINISH NOTES:**
- IN ALL STAIRWELLS CLEAN, SCRAPE, PRIME AND PAINT COLOR TREADS, STRINGERS, RISERS & TREAD NOSING.
 - IN ALL STAIRWELLS CLEAN, SCRAPE, PRIME AND PAINT ALL TREADS W/ ANTI-SLIP PAINT. COLOR TREADS.
 - ALL EXISTING CONCRETE FLOORS ARE TO BE CLEANED OF ALL ADHESIVES DOWN TO ORIGINAL CONCRETE SURFACE.


A901	Project	Formica Building	No. Revisions	Date
		115 E. 5th Street	2	11.14.2022
		Cincinnati, Ohio 45202	ENG CHG #1	
	Sheet Title	TYPICAL RESIDENTIAL FLOOR (7-10) FINISH PLAN		
Project No.	2022_259	Issue Date		
Scale	As Noted	Drawn	Checked	

Formica Building
 Office/Apartments
 Auditor Address: 115 E. 5th Street, Actual Address: 120 E. 4th Street
 Cincinnati OH 45202


modelgroup
 DEVELOPMENT • CONSTRUCTION • MANAGEMENT
 1826 Race Street
 Cincinnati, Ohio 45202
 513.559.0048

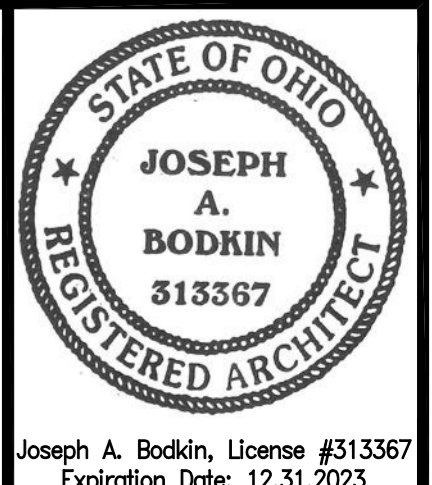

FINISH PLAN
TYPICAL RESIDENTIAL FLOOR PLAN - FLOORS 11TH - 12TH
 SCALE: 1/8" = 1'-0"

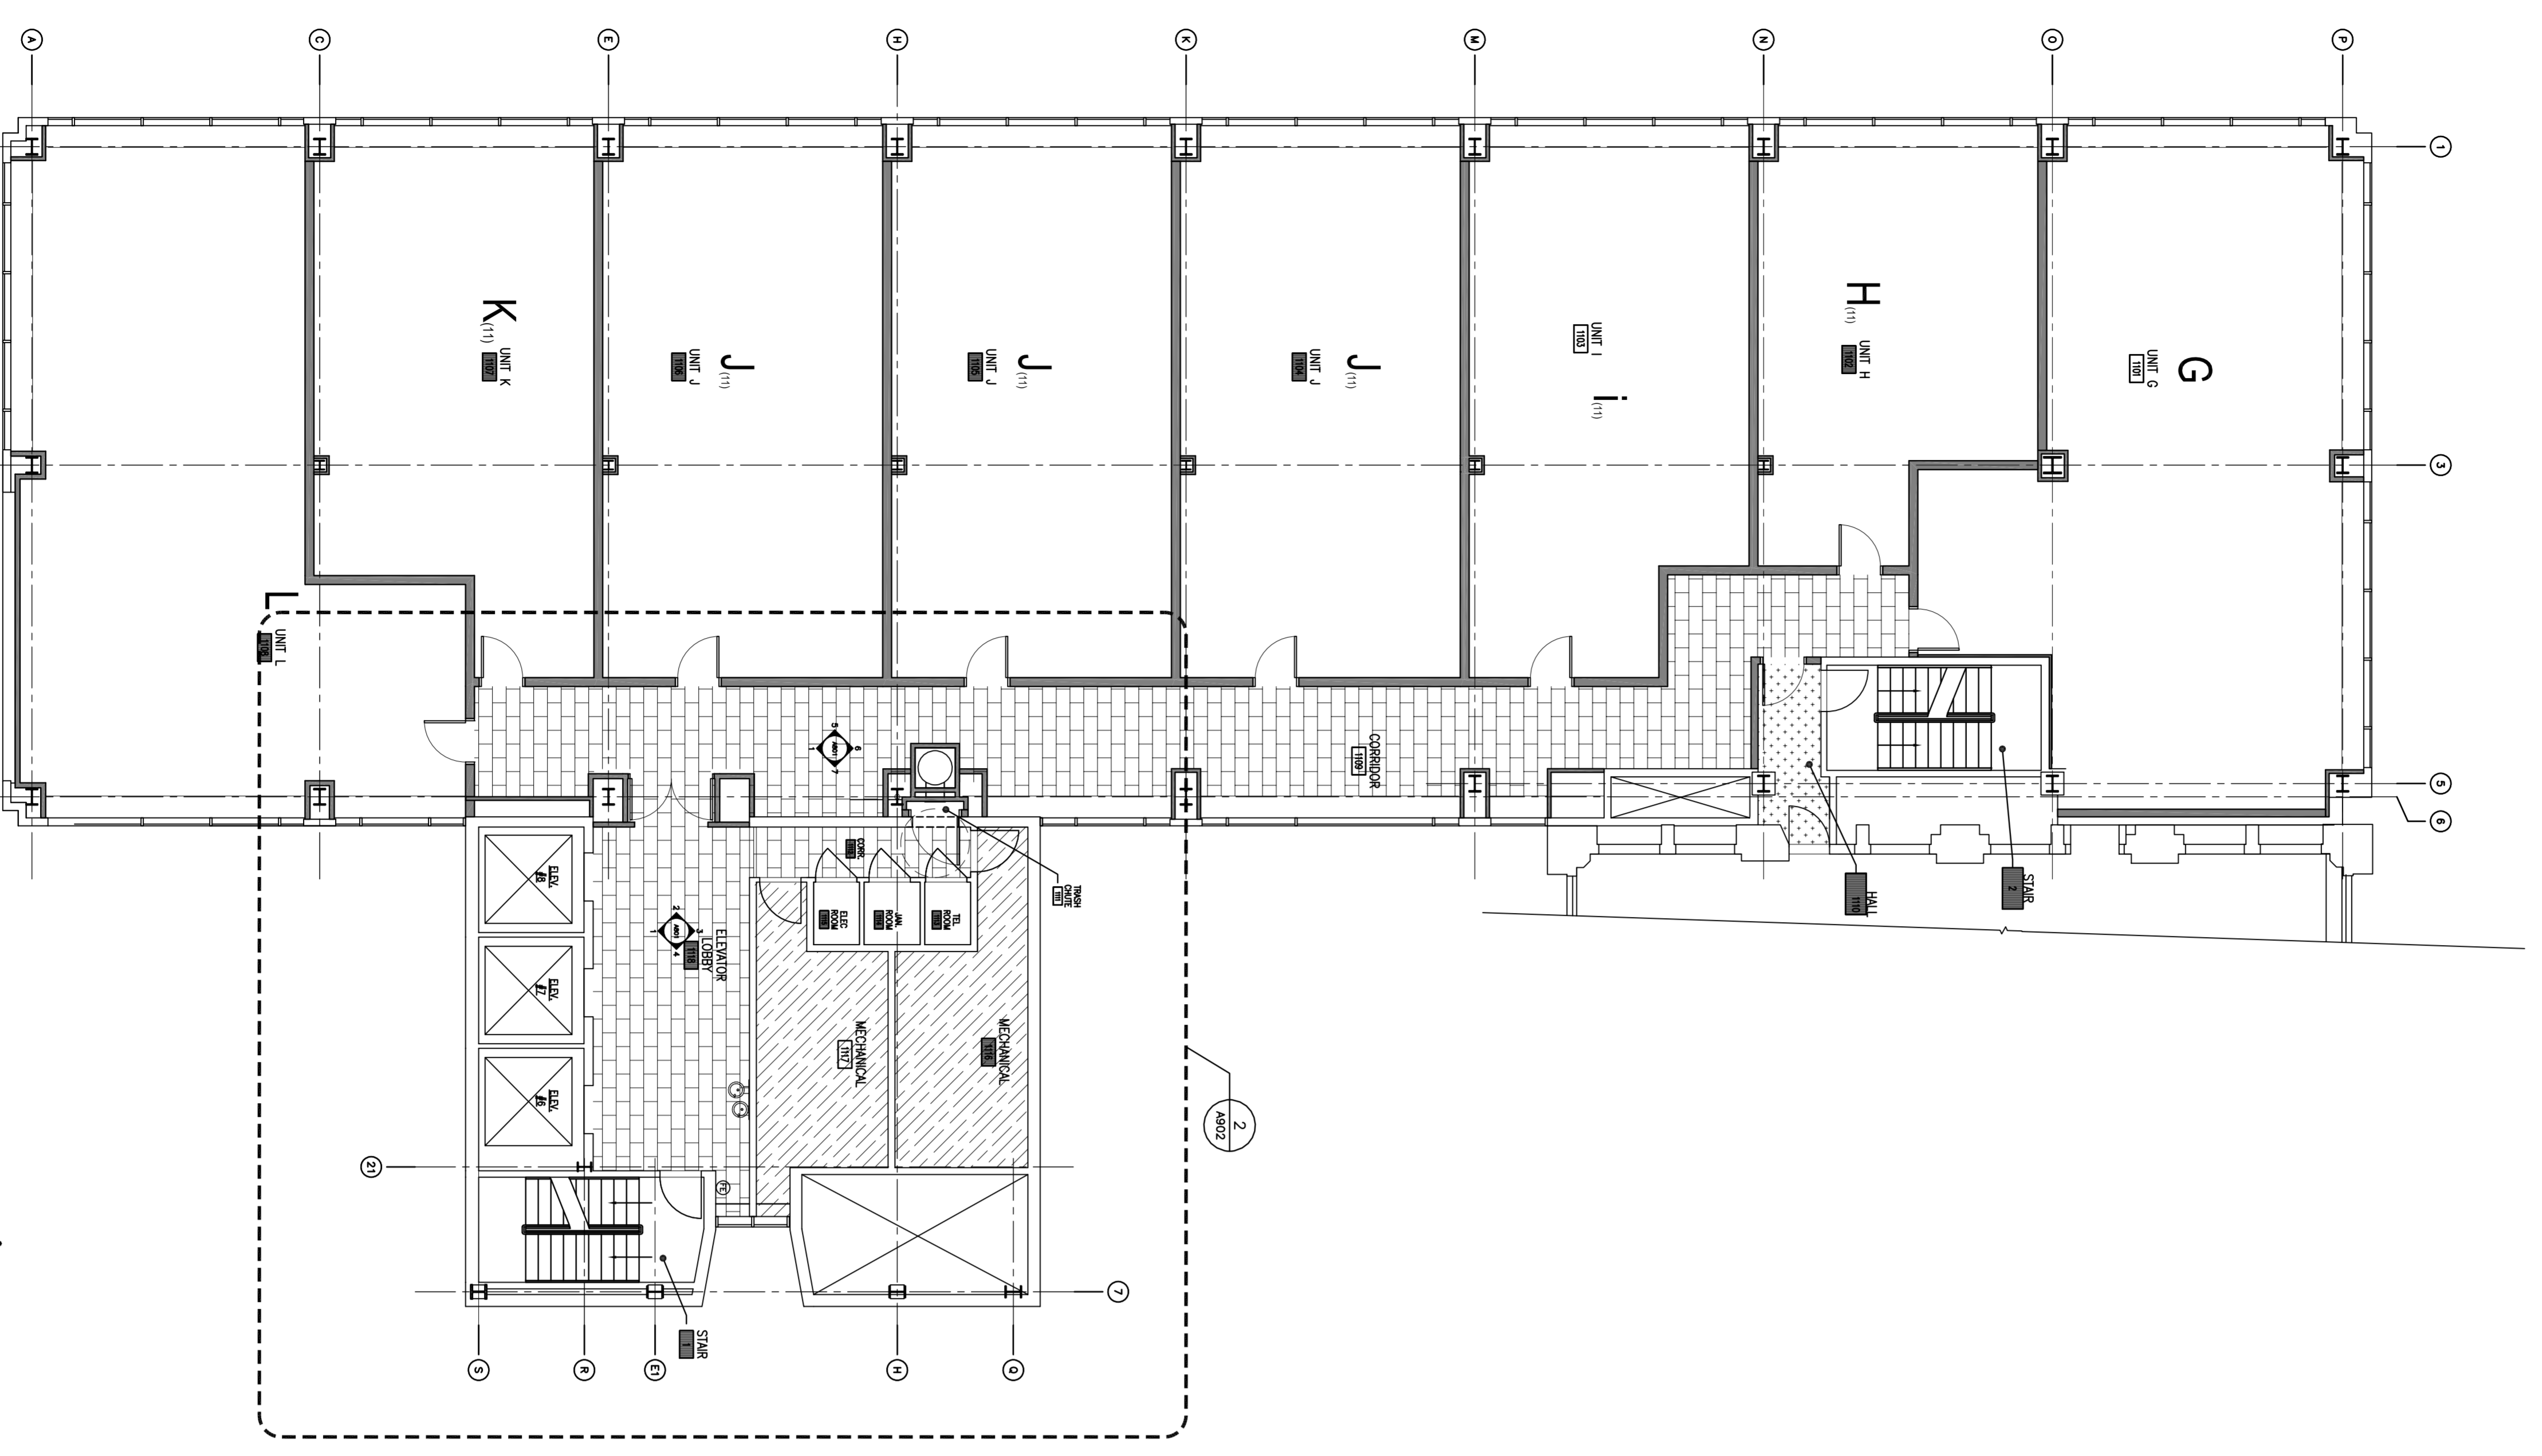

FINISH PLAN
TYPICAL CORRIDOR FINISH PLAN
 SCALE: 1/4" = 1'-0"

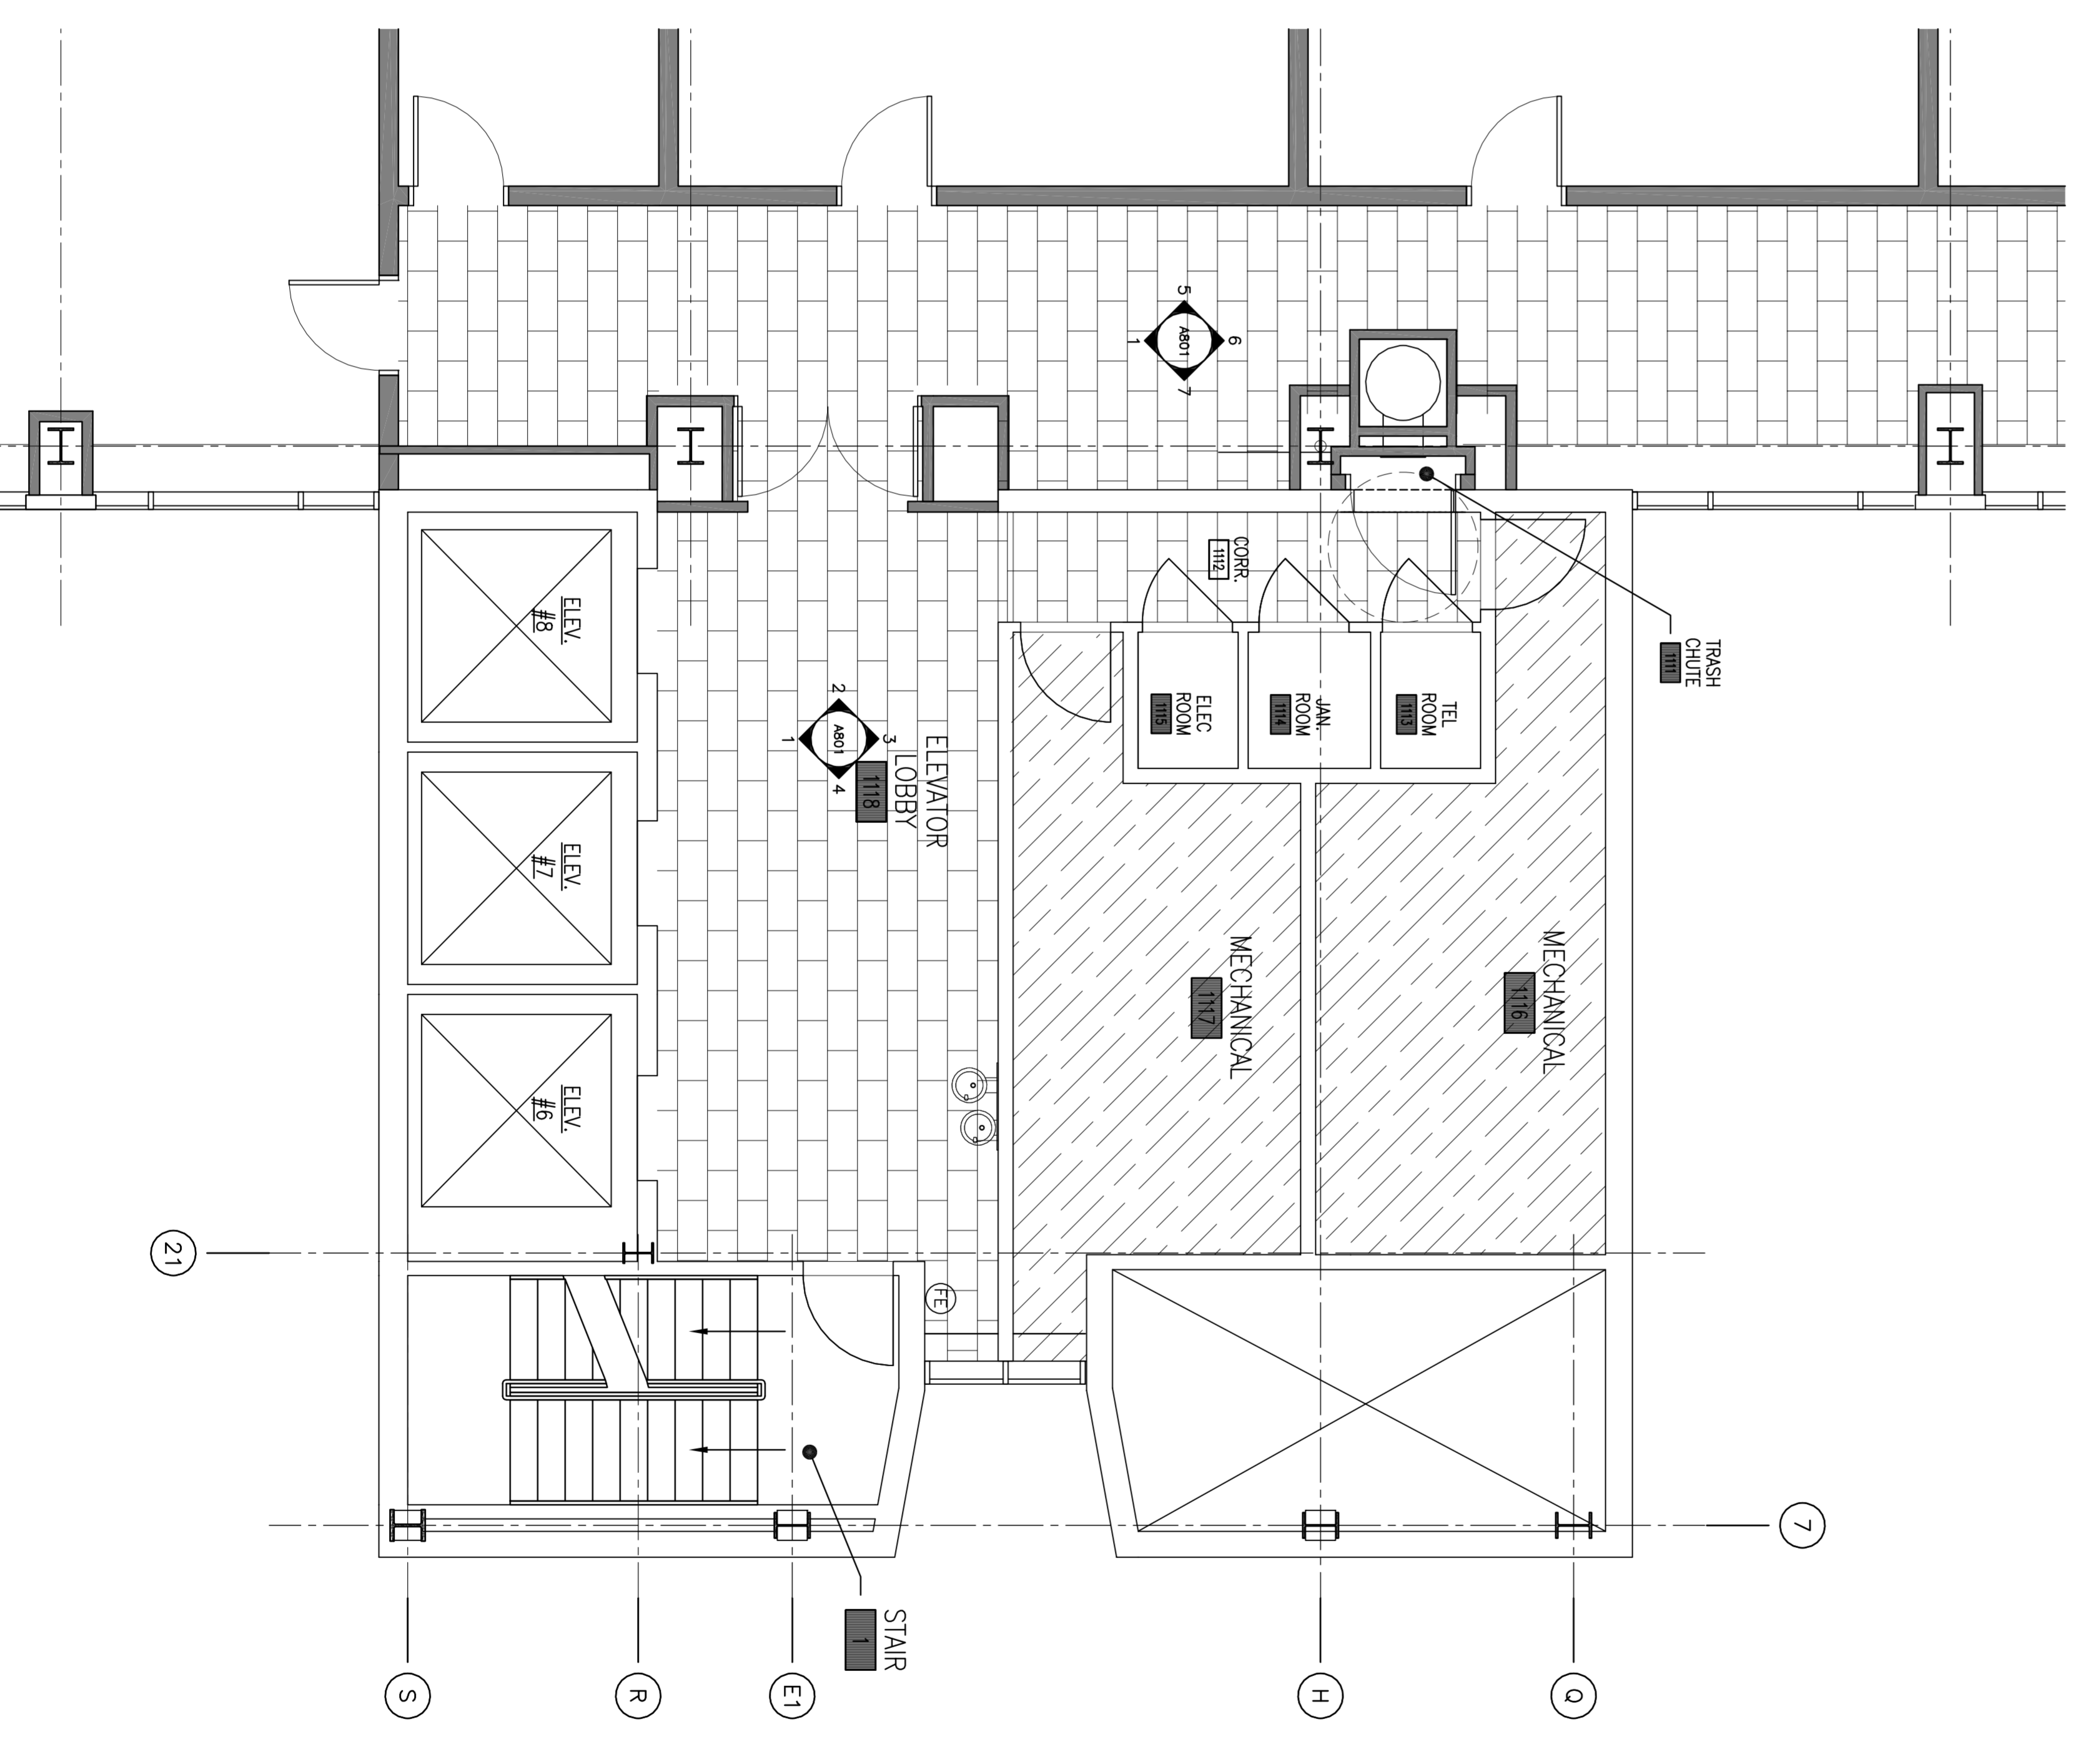

TYPICAL RESIDENTIAL FLOOR (11-12) COMMON AREA - FINISH SCHEDULE


ROOM MARK	ROOM NAME	FLOOR	BASE	WALLS				CEILING	REMARKS	REV. NO.
				NORTH	SOUTH	EAST	WEST			
1109	CORRIDOR	LV-1	RB-1	PT-1	PT-1	PT-1	PT-1	PT-3 / Act-1		
1110	HALL (STAIR #2)	EX	RB-1	PT-1	PT-1	PT-1	PT-3			
1111	TOSSEL OFFICE	CONC.	RB-2	PT-1	PT-1	PT-1	PT-3			
1112	CORRIDOR	CONC.	RB-1	PT-1	PT-1	PT-1	PT-3			
1113	TEL ROOM	LV-1	RB-1	PT-1	PT-1	PT-1	PT-3 / Act-1			
1114	JANITOR ROOM	CONC.	RB-2	PT-1	PT-1	PT-1	PT-3			
1115	ELECTRIC ROOM	CONC.	RB-2	PT-1	PT-1	PT-1	PT-3			
1116	MECHANICAL	EX	RB-2	PT-1	PT-1	PT-1	EXPOSED			
1117	MECHANICAL	EX	RB-1	PT-1	PT-1	PT-1	EXPOSED			
1118	ELEVATOR LOBBY	LV-1	RB-1	PT-1	PT-1	PT-1	PT-3 / Act-1			
	STAIR #2	EX		PT-1	PT-1	PT-1	PT-3			

GENERAL FINISH NOTES:
 A. IN ALL STAIRWELLS CLEAN, SCRAPE, PRIME AND PAINT COLOR TREADS, STRINGER, RISERS & TREAD NOSING.
 B. IN ALL STAIRWELLS CLEAN, SCRAPE, PRIME AND PAINT ALL TREADS W/ ANTI-SLIP PAINT. COLOR TREAD.
 C. ALL EXISTING CONCRETE FLOORS ARE TO BE CLEANED OF ALL ADHESIVES DOWN TO ORIGINAL CONCRETE SURFACE.


A902	Project	Formica Building		
		115 E. 5th Street	No. Revisions	Date
		Cincinnati, Ohio 45202	2	ENG CHG #1 11.14.2022
	Sheet Title	TYPICAL RESIDENTIAL FLOOR (11-12) FINISH PLAN		
Project No.	2022_259	Issue Date		
Scale	As Noted	Drawn	Checked	

Formica Building
 Office/Apartments
 Auditor Address: 115 E. 5th Street, Actual Address: 120 E. 4th Street
 Cincinnati OH 45202




modelgroup
 DEVELOPMENT • CONSTRUCTION • MANAGEMENT
 1826 Race Street
 Cincinnati, Ohio 45202
 513.559.0048

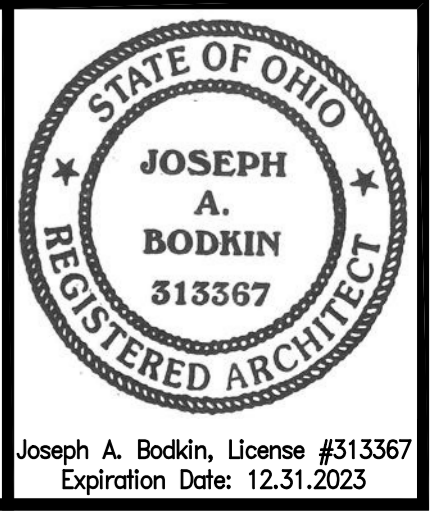

FINISH PLAN
TYPICAL RESIDENTIAL FLOOR PLAN - FLOOR 13TH
 SCALE: 1/8" = 1'-0"

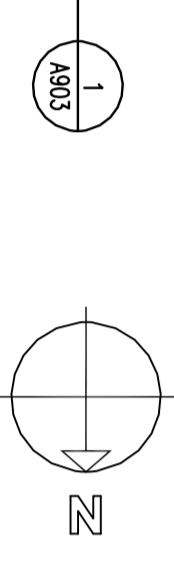

FINISH PLAN
TYPICAL CORRIDOR FINISH PLAN
 SCALE: 1/4" = 1'-0"

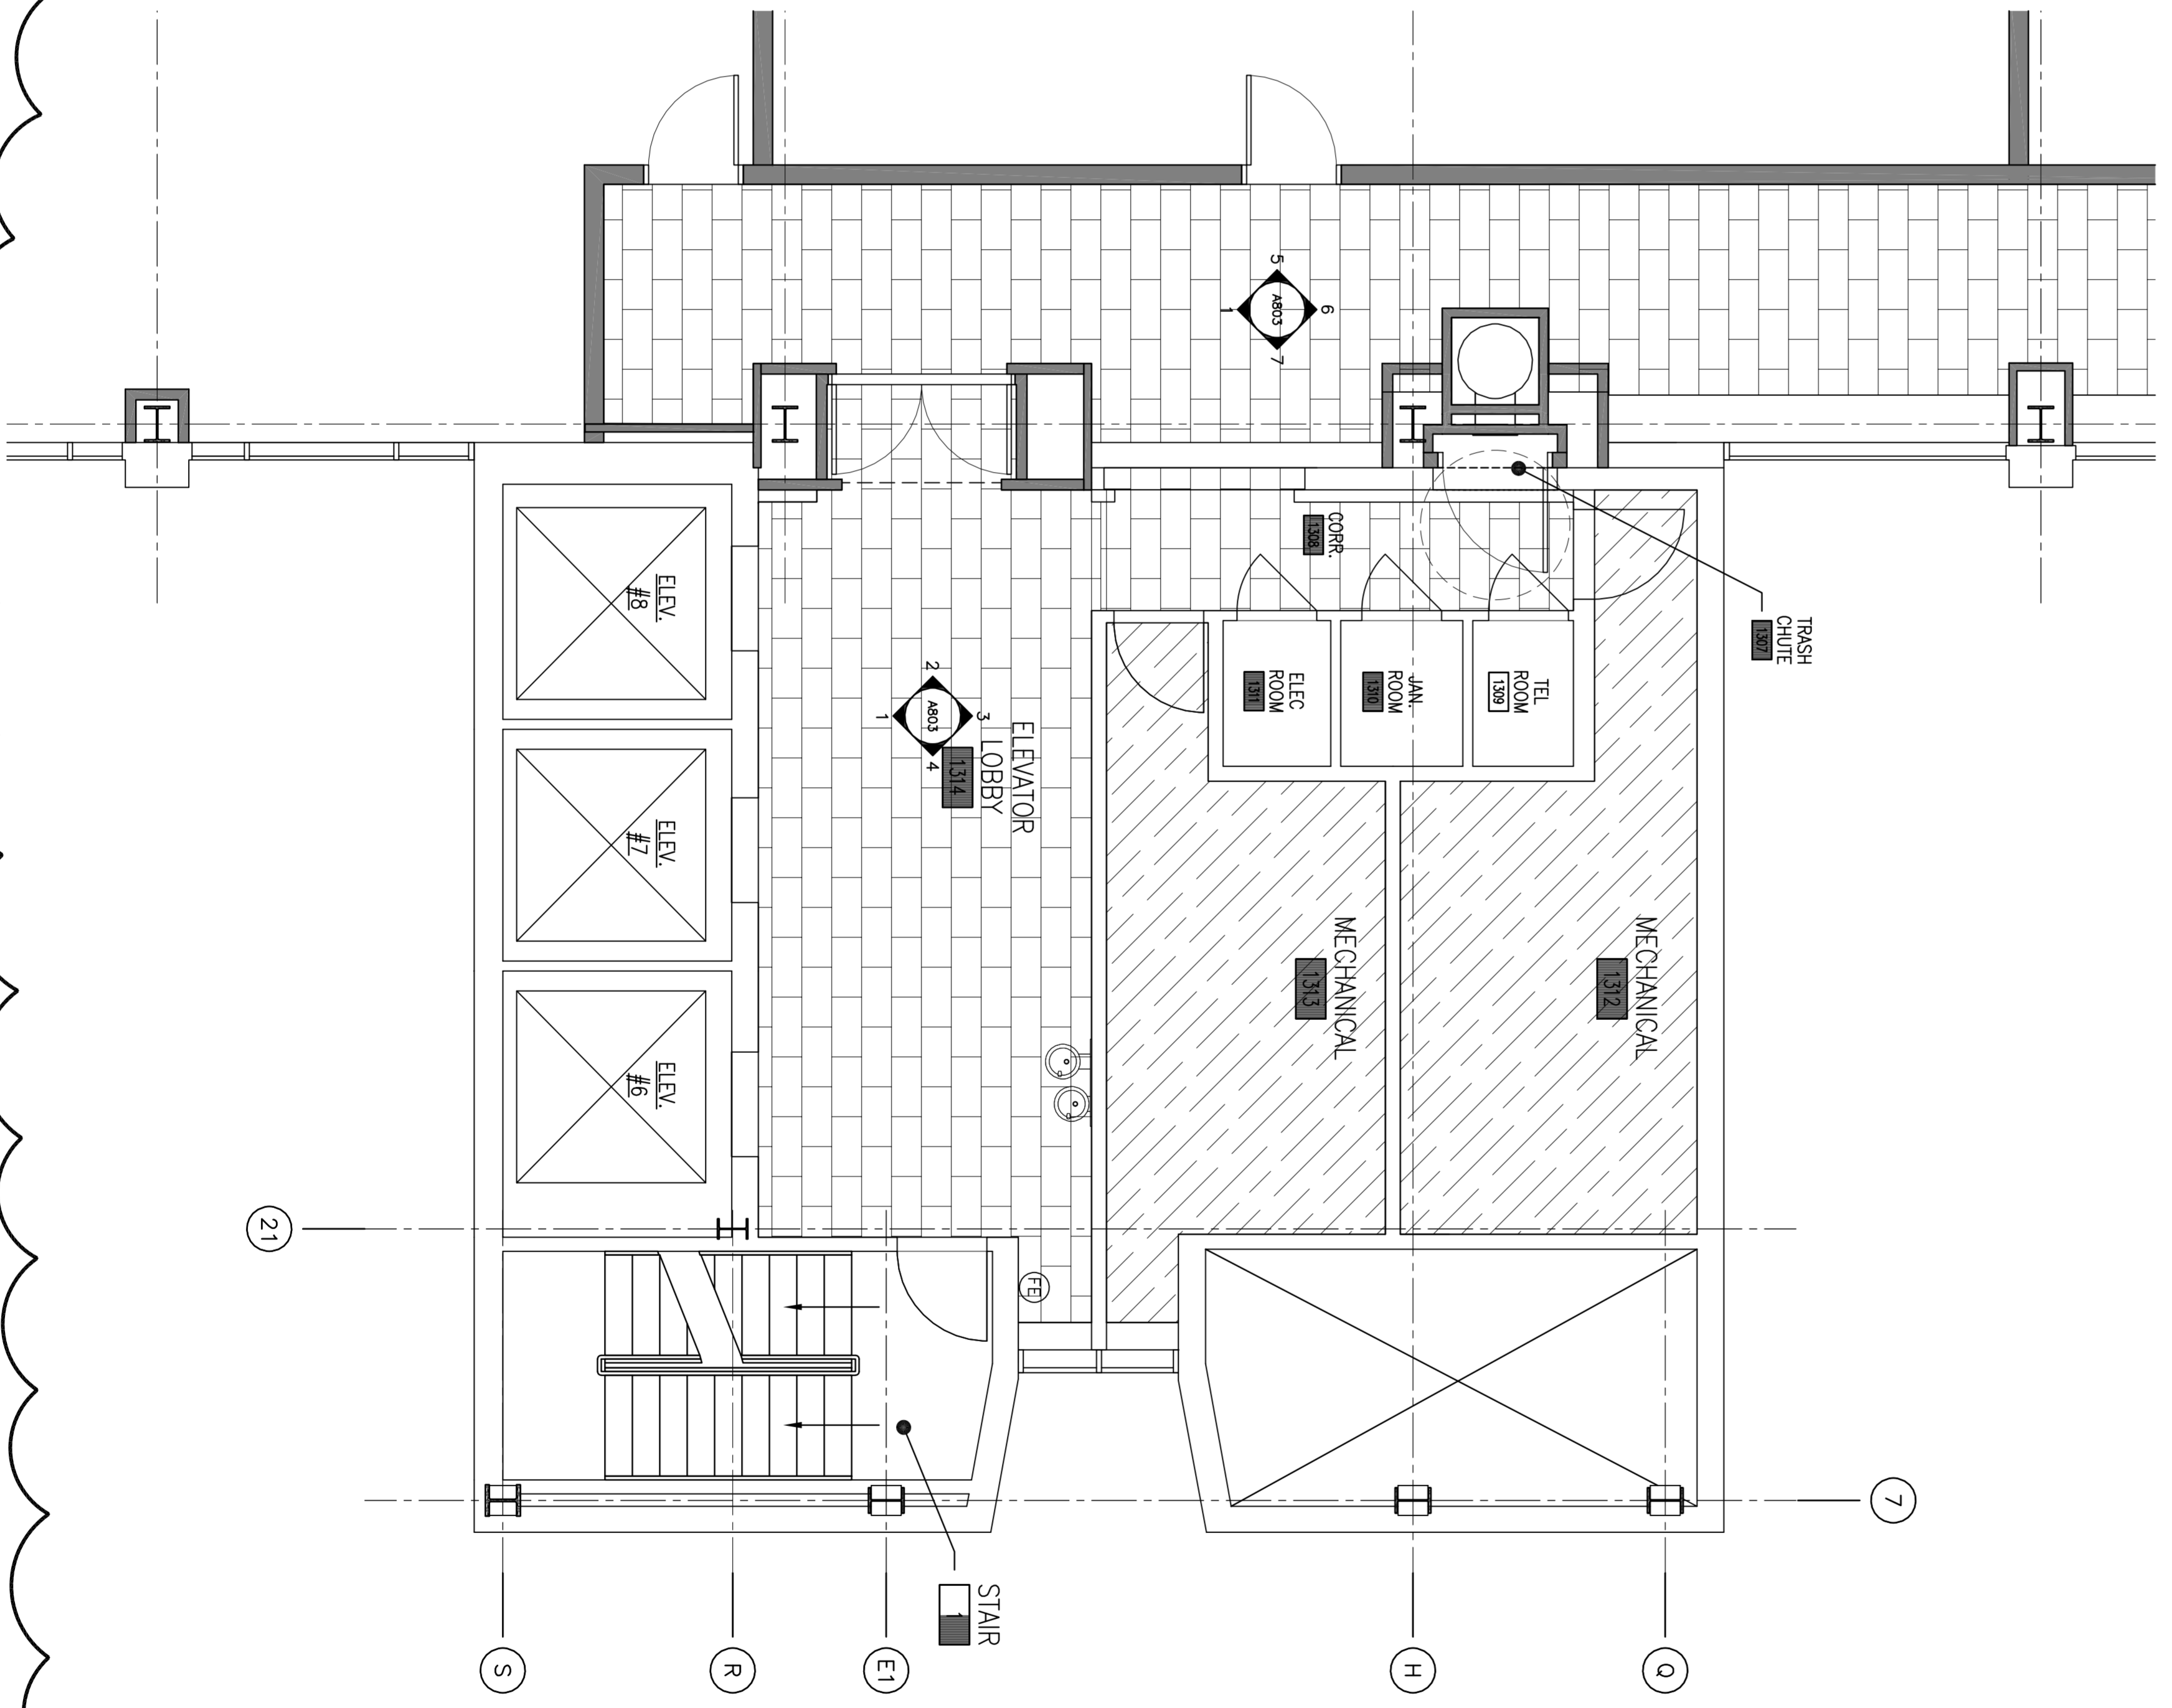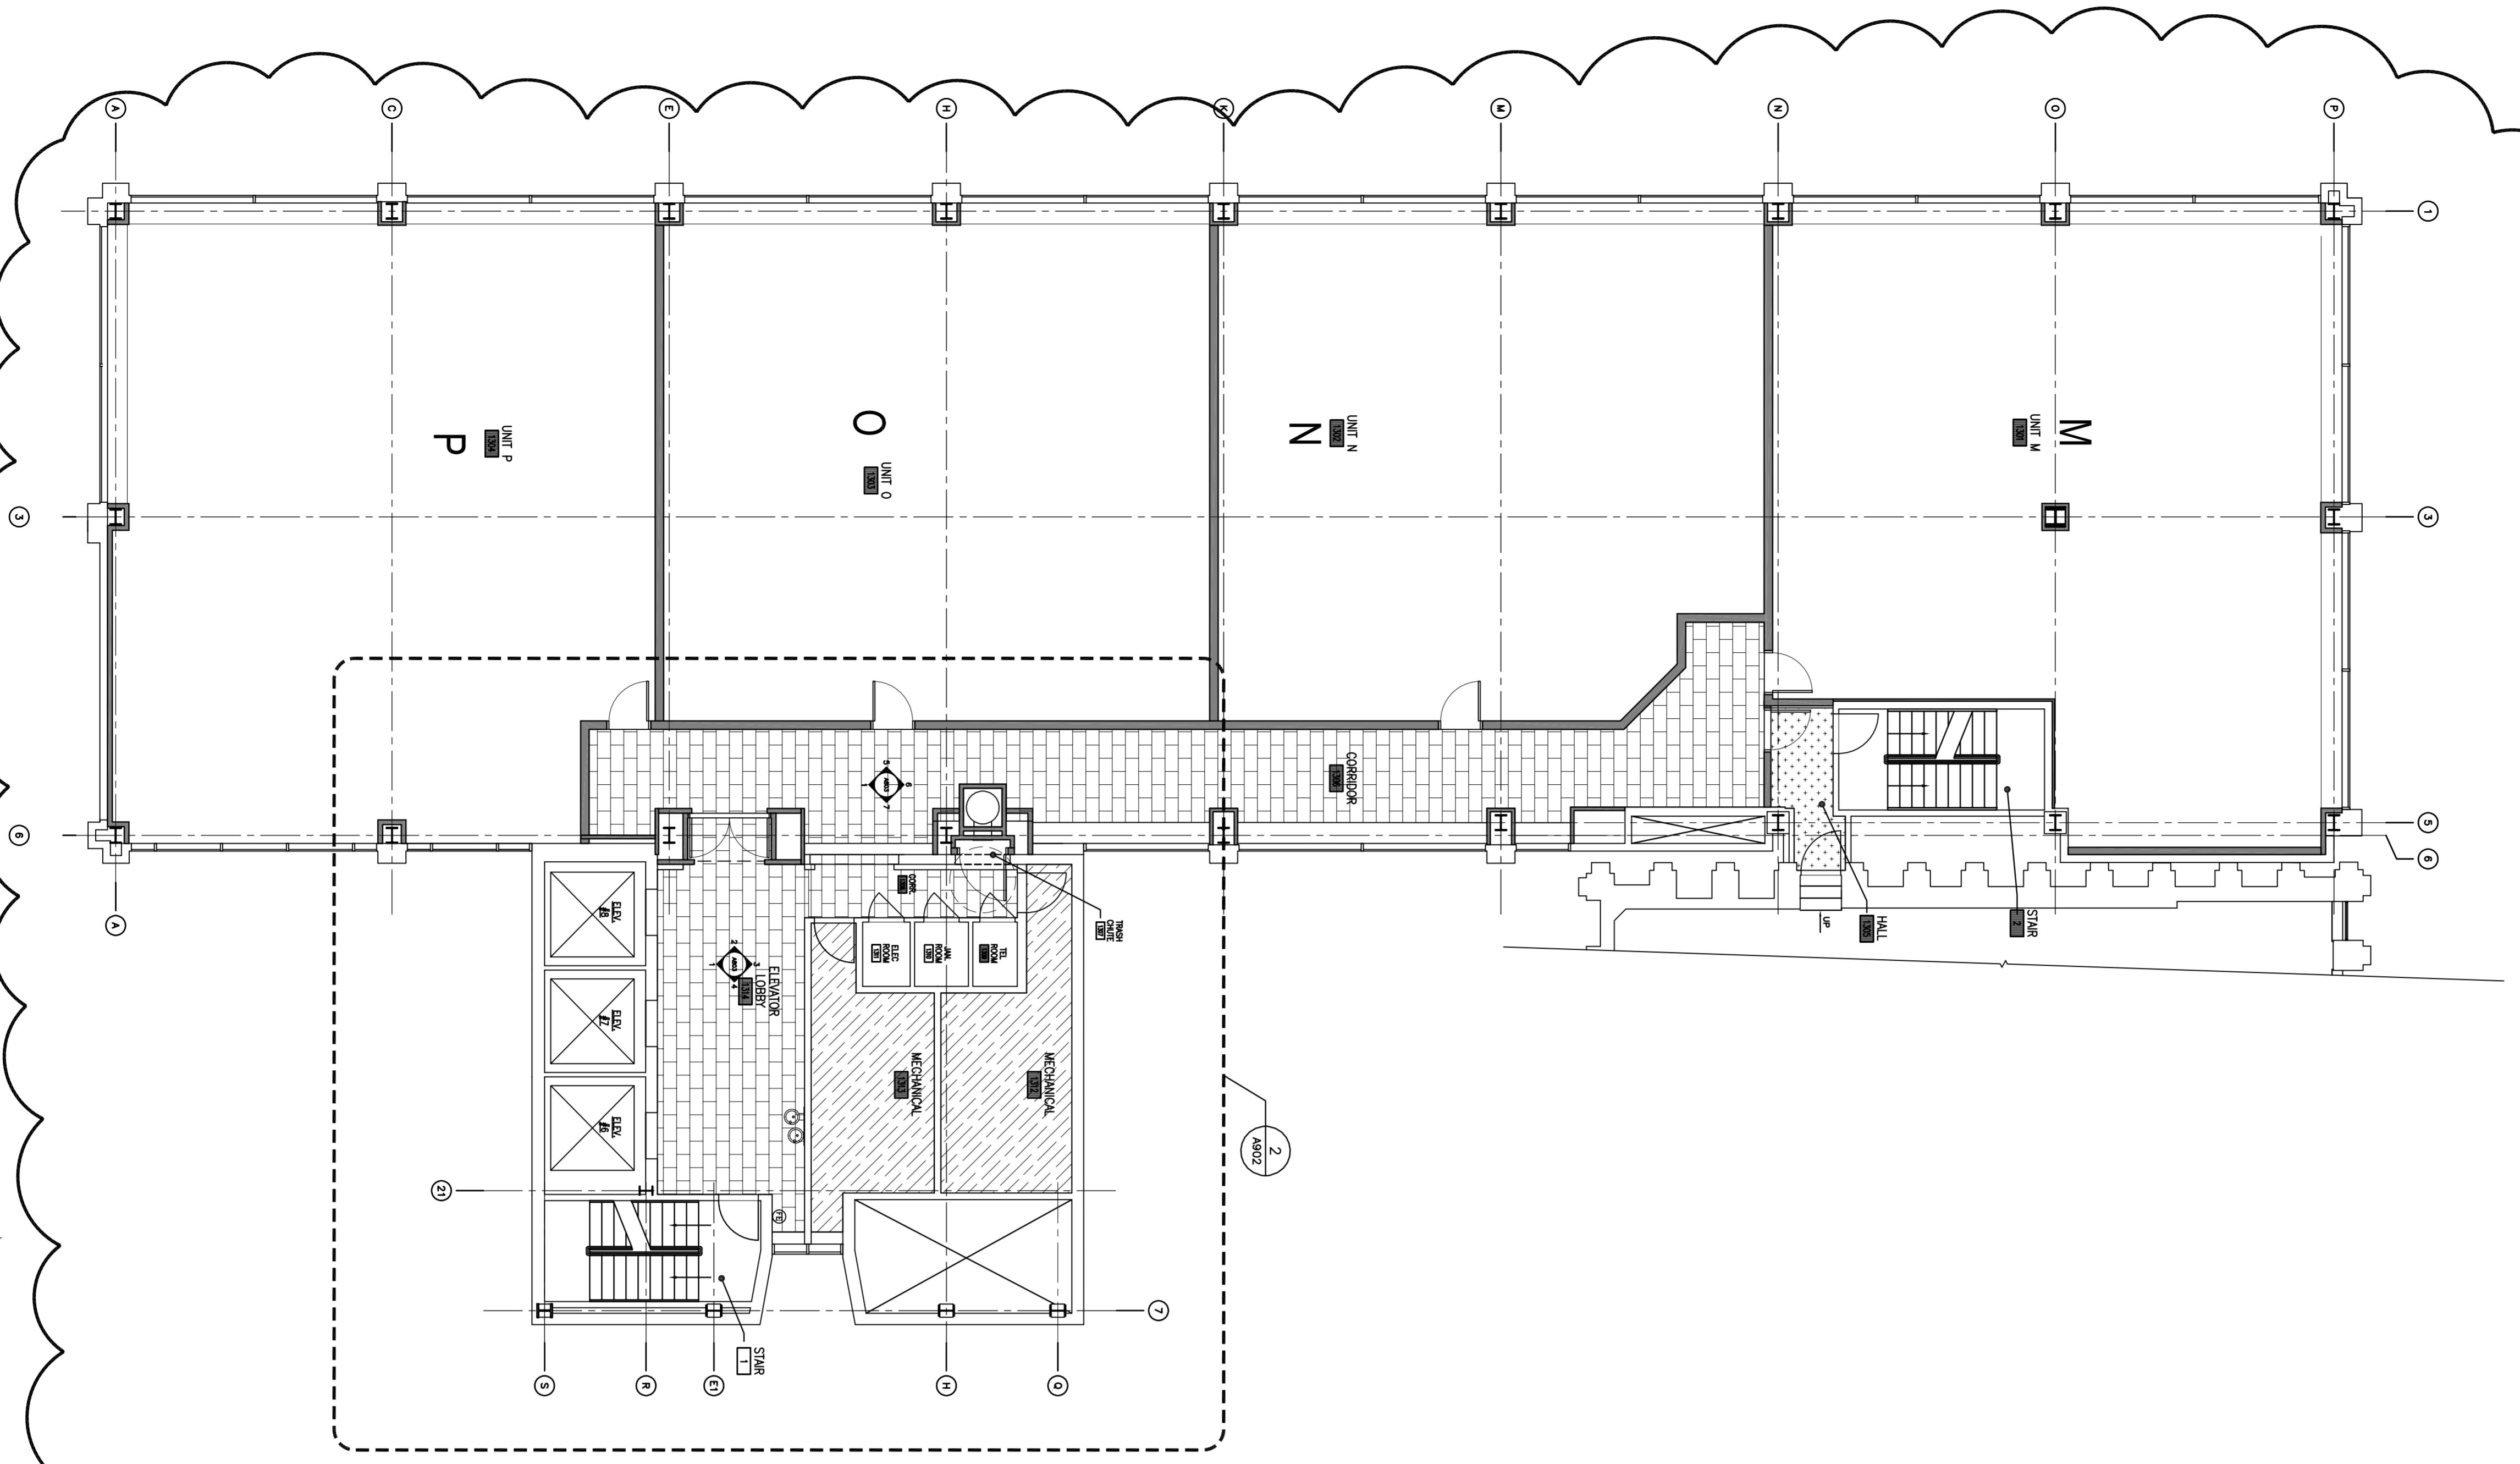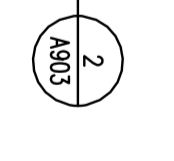

TYPICAL RESIDENTIAL FLOOR (13) COMMON AREA - FINISH SCHEDULE

ROOM MARK	ROOM NAME	FLOOR	BASE	WALLS				CEILING	REMARKS	REV. NO.
				NORTH	SOUTH	EAST	WEST			
1306	HALL (STAIR #2)	EX	EX	PT-1	PT-1	PT-1	PT-1	PT-3		
1306	CORRIDOR	CONC.	BB-1	PT-1	PT-1	PT-1	PT-3 / ACI-1			
1307	TRASH CHUTE	CONC.	BB-2	PT-1	PT-1	PT-1	PT-3			
1308	CORRIDOR	CONC.	BB-1	PT-1	PT-1	PT-1	PT-3 / ACI-1			
1309	TEL ROOM	CONC.	BB-2	PT-1	PT-1	PT-1	PT-3			
1310	JANITOR ROOM	CONC.	BB-2	PT-1	PT-1	PT-1	PT-3			
1311	ELECTRIC ROOM	CONC.	BB-2	PT-1	PT-1	PT-1	PT-3			
1312	MECHANICAL	EX	BB-1	PT-1	PT-1	PT-1	EXPOSED			
1313	MECHANICAL	EX	BB-1	PT-1	PT-1	PT-1	EXPOSED			
1314	ELEVATOR LOBBY	EX	BB-1	PT-1	PT-1	PT-1	PT-3 / ACI-1			
	STAIR #2	EX	EX	PT-1	PT-1	PT-1	PT-3			

GENERAL FINISH NOTES:
 A. IN ALL STAIRWELLS CLEAN, SCRAPE, PRIME AND PAINT ALL HANDRAILS, STRINGER, RISERS & TREAD NOSING. COLOR TBD.
 B. IN ALL STAIRWELLS CLEAN, SCRAPE, PRIME AND PAINT ALL TREADS W/ ANTI-SLIP PAINT. COLOR TBD.
 C. ALL EXISTING CONCRETE FLOORS ARE TO BE CLEANED OF ALL ADHESIVES DOWN TO ORIGINAL CONCRETE SURFACE.

A903	Project	Formica Building	
		115 E. 5th Street	
		Cincinnati, Ohio 45202	
	Sheet Title	TYPICAL RESIDENTIAL FLOOR (13) FINISH PLAN	
	Project No.	2022_259	Issue Date
Scale	As Noted	Drawn	Checked

Formica Building
 Office/Apartments
 Auditor Address: 115 E. 5th Street, Actual Address: 120 E. 4th Street
 Cincinnati OH 45202

modelgroup
 DEVELOPMENT • CONSTRUCTION • MANAGEMENT
 1826 Race Street
 Cincinnati, Ohio 45202
 513.559.0048

